


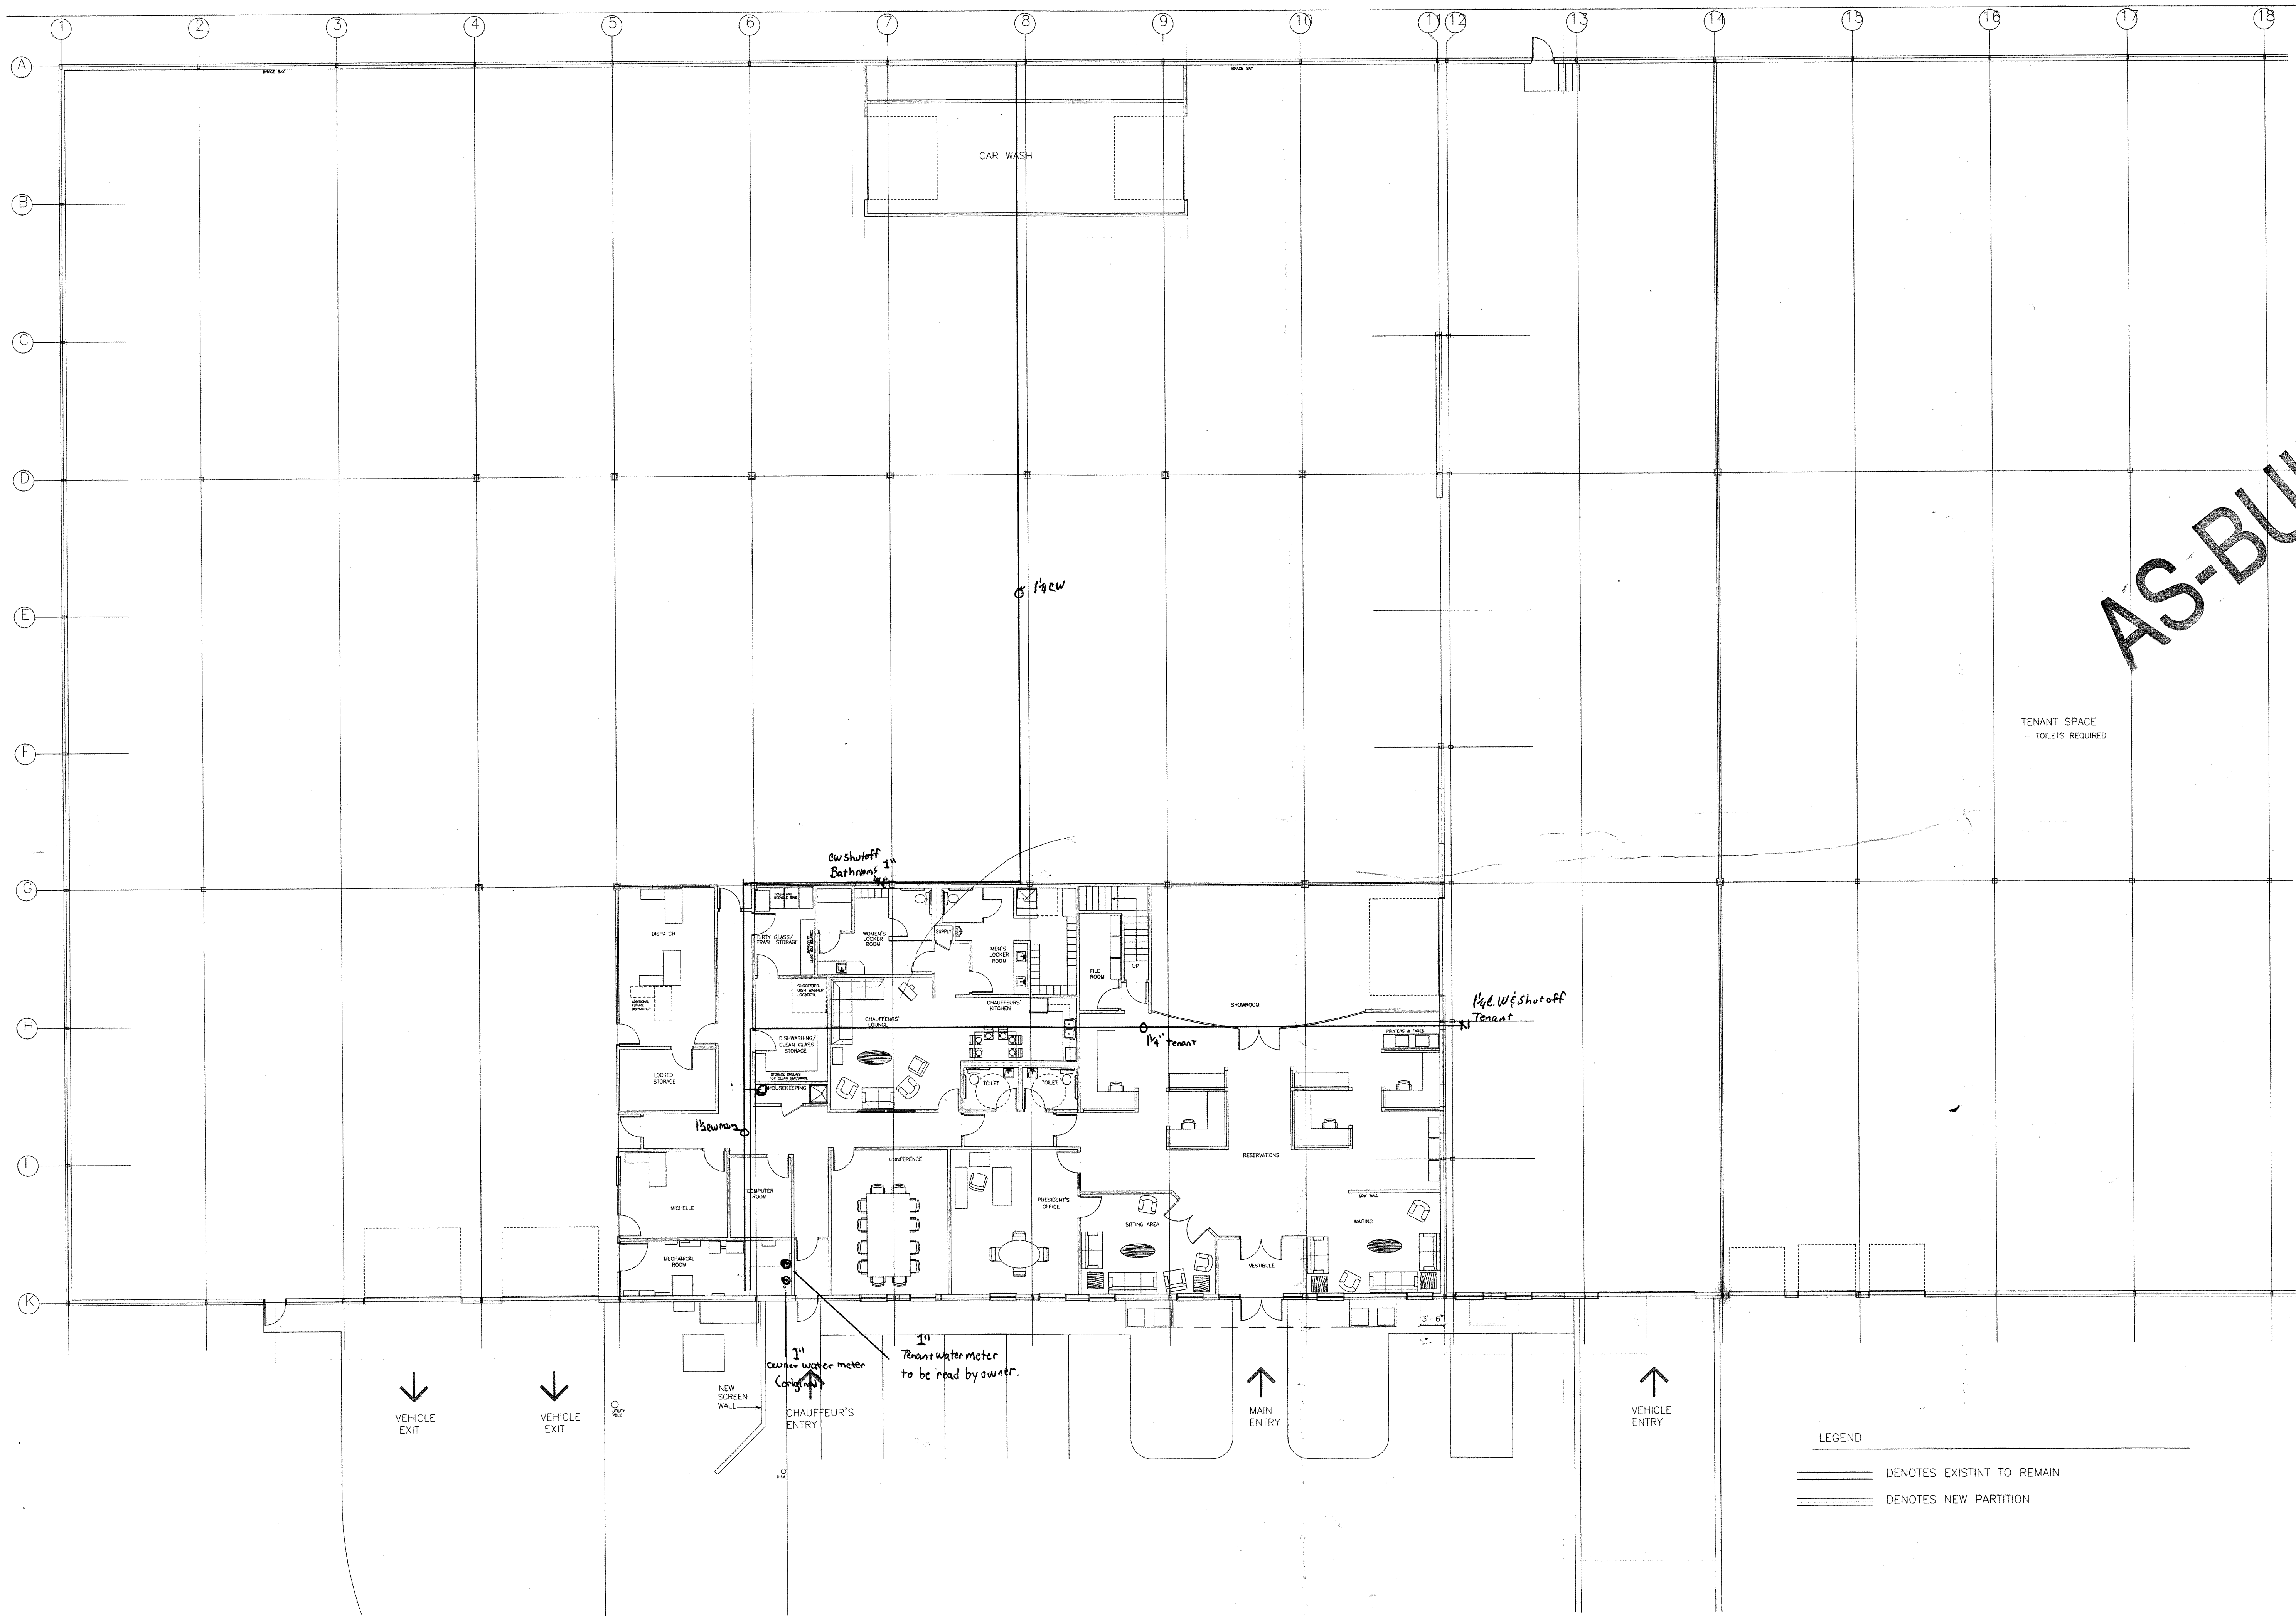

CALDAROLA DESIGN
ASSOCIATES P.C.

4 birch street
derry, new hampshire
03038
tel: (603) 432-8404
fax: (603) 432-2706


AS-BUILT

TENANT SPACE
- TOILETS REQUIRED

Black Tie Limousine
25 Bond Street
Haverhill, MA
01835

NEW PLAN

ACTION/REVISIONS:		
NO.	DATE	DESCRIPTION

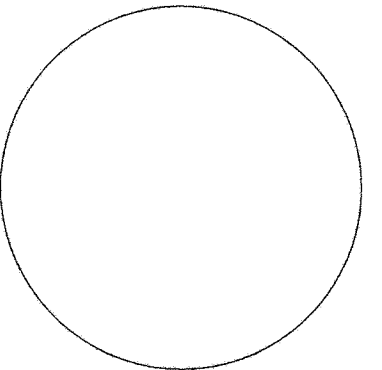

DATE: 5/1/05
SCALE: 3/32 = 1'-0"
PROJECT #: 5104

DRAWING NO.
A102

LEGEND

- ===== DENOTES EXISTENT TO REMAIN
- ===== DENOTES NEW PARTITION