

# DBKO

DESIGN BUILD

## RECEIVED

DEC 16 2021


## WHITE



[PARTNERS]

MAR 01 2022

CITY OF MADISON BUILDING DEPARTMENT	
DATE	REVISION
11/17/2021	<div style="display: flex; justify-content: space-between;"> <span>2</span> <span>PLAN CHECK RESPONSE</span> </div>

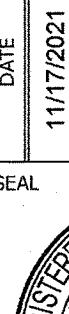ANY INFORMATION OF DATA ON THIS DRAWING IS NOT INTENDED TO BE SUITABLE FOR REUSE BY ANY PERSON, FIRM, CORPORATION, OR ANY OTHERS ON EXTENSIONS OF THIS PROJECT OR FOR ANY USE ON ANY OTHER PROJECT. ANY REUSE WITHOUT WRITTEN VERIFICATION AND ADAPTATION BY THE ENGINEER FOR THE SPECIFIC PROJECT INTENDED WILL BE AT THE USER'S SOLE RISK AND WITHOUT LIABILITY OR LEGAL EXPOSURE TO THE ENGINEER.



JOB NUMBER	21107	
DESIGNED BY	RT	
DRAWN BY	LM	
DATE	9/17/2021	
SHEET NUMBER	CS1.0	

By: [Signature]  
Date: MAR 03 2022



# CITY OF MADERA CONSTRUCTION PLANS FOR SPR 2021-24: SOUTH SCHNOOR AVENUE AND WEST ALMOND AVENUE



Know what's below.  
Call before you dig.

## GENERAL NOTES:

1. THE WORK ENRAGED HEREIN SHALL BE DONE IN ACCORDANCE WITH THE APPROPRIATE PROVISION OF THE SPECIFICATIONS ENTITLED BY CITY OF MADERA STANDARD PLANS AND SPECIFICATIONS LATEST REVISION.
2. THE CONTRACTOR SHALL SECURE AN ENCROACHMENT PERMIT FOR ANY OFF-SITE CONSTRUCTION.
3. ALL PERMITS INCLUDING ENCROACHMENT AND BARRICADE PLANS SHALL BE KEPT ON-SITE AT ALL TIMES.
4. APPLICATION FOR INSPECTION BY THE CITY OF MADERA SHALL BE MADE BY CONTRACTOR AT LEAST 24 HOURS BEFORE THE INSPECTION SERVICES WILL BE REQUIRED. 559-661-5418.
5. TWO WORKING DAYS PRIOR TO COMMENCING UTILITY EXCAVATION, THE CONTRACTOR SHALL NOTIFY UNDERGROUND SERVICES ALERT, TOLL FREE, AT 1-800-227-2600.
6. PRIOR TO ACCEPTANCE, BOND RELEASES AND A CERTIFICATE OF OCCUPANCY, A CERTIFIED LEGIBLE AS-BUILT DRAWING MUST BE SUBMITTED TO THE CITY OF MADERA. AS-BUILT MUST SHOW ALL CHANGES AND ACTUAL FIELD CONDITIONS. IN THE ABSENCE OF CHANGES, A COPY OF APPROVED DRAWINGS WILL BE REQUIRED STATING "INSTALLED AS PER DRAWINGS" AND CERTIFIED AS SUCH BY THE DEVELOPER'S ENGINEER.
7. ALL CONSTRUCTION EQUIPMENT SHALL BE TUNED AND MAINTAINED IN ACCORDANCE WITH THE MANUFACTURER'S SPECIFICATIONS.
8. CONTRACTOR'S WORK CREWS SHALL SHUT OFF CONSTRUCTION EQUIPMENT WHEN NOT IN USE.

## LIABILITIES

9. ANY EXISTING SECTION CORNER, QUARTER SECTION CORNER, PROPERTY CORNER, STREET CENTERLINE MONUMENT, OR ANY OFFICIAL BENCHMARK DAMAGED BY THE CONTRACTOR IN THE COURSE OF THESE CONSTRUCTION PLANS, SHALL BE RESET TO THE SATISFACTION OF THE CITY ENGINEER. A LICENSED LAND SURVEYOR OR CIVIL ENGINEER LICENSED TO PERFORM LAND SURVEYING SHALL CERTIFY THE PLACEMENT OR REPLACEMENT OF ALL MONUMENTS AND BENCHMARKS IN ACCORDANCE WITH ALL LAWS, RULES AND REGULATIONS GOVERNING SUCH PLACEMENTS OR REPLACEMENTS. PLACEMENT/REPLACEMENT AND CERTIFICATION SHALL BE COMPLETED BEFORE FINAL ACCEPTANCE OF THE PROJECT/WORK BY THE CITY. BRONZE CAPS REQUIRED FOR THE INSTALLATION OF NEW OR REPLACEMENT MONUMENTS SHALL BE FURNISHED BY THE CONTRACTOR PER CITY STANDARD DRAWING NO. E-1, AND APPROVED BY THE CITY PRIOR TO INSTALLATION.
10. ANY EXISTING SIGNING, STRIPING, STENCILING, AND/OR IMPROVEMENT SHOWN ON THE PLANS TO REMAIN BUT ARE DAMAGED, DISTURBED OR FADED BY CONSTRUCTION ACTIVITIES SHALL BE REPLACED IN-KIND ACCORDANCE WITH THE CITY OF MADERA STANDARDS AND AS DIRECTED BY THE CITY ENGINEER.
11. THE CONTRACTOR SHALL NOTIFY THE CITY ENGINEERING DEPARTMENT AT (559)661-5418 AT LEAST FORTY-EIGHT (48) HOURS PRIOR TO INSTALLING OR REINSTALLING ANY SIGNS, MARKINGS, STRIPING OR STENCILING SUCH AS DIRECTIONAL ARROWS, STOPS, CROSS WALKS, ETC. DAMAGED OR FADED BY THE WORK. THE CITY ENGINEERING DEPARTMENT SHALL BE INFORMED OF ALL LOCATIONS, TYPES, DATES AND SCHEDULE OF WORK (SEE "STRIPING").

## GRADING

12. ALL UTILITY POLES IN THE STREET RIGHT-OF-WAY ARE TO BE REMOVED OR RELOCATED PRIOR TO ANY PAVING.
13. ANY WELLS LOCATED IN AREAS TO BE GRADED, UNLESS OTHERWISE DIRECTED BY PLANS, ARE TO BE ABANDONED PER CITY STANDARD W-17. A CITY BUILDING PERMIT WILL BE REQUIRED FOR THIS WORK AND FEES THEREFORE SHALL BE PAID FOR BY THE CONTRACTOR.
14. ANY SEPTIC TANK, LEACH FIELD OR RELATED FACILITIES LOCATED IN AREAS TO BE GRADED, UNLESS OTHERWISE DIRECTED BY THE PLANS, SHALL BE ABANDONED PER COUNTY OF MADERA HEALTH DEPARTMENT STANDARDS. A BUILDING PERMIT WILL BE REQUIRED FOR THIS WORK AND FEES THEREFORE SHALL BE PAID FOR BY THE CONTRACTOR.
15. THE CONTRACTOR SHALL PROVIDE SOIL COMPACTION TEST REPORTS PREPARED BY AN APPROVED TESTING AGENCY FOR ALL AREAS WHERE FILL IS PLACED.
16. ALL GRADING SHALL CONFORM TO THE SOILS REPORT:  
ENGINEER: SALEM ENGINEERING GROUP, INC.  
DATE: APRIL 28, 2021  
JOB NUMBER: 1-221-0369
17. THE DEVELOPER SHALL MEET ALL REGULATIONS OF THE SAN JOAQUIN VALLEY AIR POLLUTION CONTROL DISTRICT (REGULATION VII) CONCERNING DUST SUPPRESSION DURING CONSTRUCTION OF THE PROJECT. METHODS INCLUDE, BUT ARE NOT LIMITED TO: USE OF WATER OR CHEMICAL STABILIZERS/SUPPRESSANTS TO CONTROL DUST EMISSIONS FROM DISTURBED AREA, STOCK PILES, AND ACCESS WAYS; COVERING OR WETTING MATERIALS THAT ARE TRANSPORTED OFF-SITE; LIMIT CONSTRUCTION RELATED SPEEDS TO 15 MPH ON ALL UNPAVED AREAS; USE OF A STABILIZED CONSTRUCTION ENTRY/EXIT (E.G. 3-6 INCH AGGREGATE OR GRATES) TO MINIMIZE CHURNING/TRUCKOUT FROM CONSTRUCTION VEHICLES ENTERING PUBLIC STREETS; AND CEASE GRADING AND EARTH MOVING DURING PERIODS OF HIGH WINDS (20 MPH OR MORE).

## GRADING/BUILDINGS ON SITE

18. ALL GRADING SHALL COMPLY WITH CALIFORNIA BUILDING CODE, CURRENT EDITION.
19. THE CONTRACTOR SHALL OBTAIN A GRADING PERMIT FROM THE CITY BUILDING DEPARTMENT PRIOR TO ANY WORK, ABIDE BY ALL CONDITIONS THEREOF AND PAY PERMIT FEES FOR PERMIT PURPOSES ONLY:  
ESTIMATED GRADING AREA: 9 ACRES(S)  
ESTIMATED EXCAVATION: 7,279 CY  
ESTIMATED EMBANKMENT: 7,088 CY  
ESTIMATED TOTAL: 191 (CUT) CY

NOTE: ESTIMATED GRADING QUANTITIES ARE "IN PLACE" NO SHRINKAGE HAS BEEN TAKEN INTO ACCOUNT.

20. A LETTER FROM THE RESPONSIBLE CIVIL ENGINEER OR LAND SURVEYOR SHALL ALSO BE SUBMITTED CERTIFYING THAT GRADING CONFORMED TO THE APPROVED GRADING PLAN.
21. THE CONTRACTOR SHALL HAVE THE COMPACTION REPORT FILED WITH THE CITY OF MADERA BUILDING DEPARTMENT FOR ANY LOT WITH SIX (6) INCHES OF FILL OR OF A BUILDING FOUNDATION.
22. ALL FOR HYDRAULICS ARE TO BE IN PLACE AND WORKING BEFORE BUILDING CONSTRUCTION BEGINS.
23. ALL FILL USED TO SUPPORT THE FOUNDATIONS OF ANY BUILDING OR STRUCTURE SHALL BE PLACED UNDER THE DIRECTION OF A GEO-TECHNICAL ENGINEER OR HIS QUALIFIED REPRESENTATIVE.
24. IN THE EVENT ARCHAEOLOGICAL RESOURCES ARE UNEXPECTED OR DISCOVERED DURING ANY CONSTRUCTION ACTIVITIES ON SITE, CONSTRUCTION ACTIVITIES SHALL CEASE AND THE COMMUNITY DEVELOPMENT DIRECTOR OR CITY ENGINEER SHALL BE NOTIFIED SO THAT PROCEDURES REQUIRED BY STATE LAW CAN BE IMPLEMENTED.
25. TEMPORARY SIGNS, PRIOR TO COMMENCING WORK ON ANY HOMES BEYOND THE TRACT MODELS, OR AS SOON AS AGGREGATE BASE (BASE ROCK) IS PLACED, STRIPES, WHICHEVER COMES FIRST, AT ALL INTERSECTIONS THE DEVELOPER/CONTRACTOR SHALL INSTALL TEMPORARY STREET NAME SIGNS TO THE FOLLOWING SPECIFICATIONS:  
a. TEMPORARY SIGNS SHALL BE OF STEEL OR ALUMINUM BACKING, WITH THICKNESS BETWEEN 0.060" AND 0.125".  
b. SIGN BACKING MATERIAL SHALL BE 8" IN HEIGHT.  
c. SIGNS SHALL BE REFLECTORIZED WITH BLACK LETTERS ON WHITE BACKGROUND.  
d. SIGNS SHALL INCLUDE THE STREET NAME AND BLOCK NUMBER. LETTER HEIGHT SHALL BE 4" MINIMUM; BLOCK NUMBERS SHALL BE 2" MINIMUM HEIGHT.

## STREET IMPROVEMENTS

27. ALL STREETS SHALL BE SURFACED IN ACCORDANCE WITH THIS PLAN AND THE FOLLOWING SPECIFICATIONS:  
a. 6-INCH SUB GRADE AND ALL FILLS IN EXCESS OF 6 INCHES SHALL BE COMPACTED IN ACCORDANCE WITH THE STATE OF CALIFORNIA, DEPARTMENT OF TRANSPORTATION, SECTION 19 OF THE STANDARD SPECIFICATIONS APRIL, 2018.  
b. AGGREGATE BASE AND SUB-BASE SHALL CONFORM TO AND BE PLACED IN ACCORDANCE WITH SECTION 12 OF THE CITY STANDARD USING CLASS 2 AGGREGATE BASE MATERIAL (MINIMUM 50 R-VALUE).  
c. ASPHALT CONCRETE, AGGREGATE BASE, AND EARTH WORK SHALL CONFORM TO SECTIONS 39, 26, AND 19 OF THE STATE STANDARD SPECIFICATIONS LATEST EDITION.  
d. ASPHALT CONCRETE SHALL BE TYPE B AND SHALL CONFORM TO THE PROVISIONS IN SECTION 39 OF THE STATE STANDARD SPECIFICATIONS. PERFORMANCE GRADED MODIFIED ASPHALT DESIGNATION CENTRAL VALLEY AND THESE SPECIAL PROVISIONS, EXCEPT THE ASPHALT CONCRETE MIX DESIGN AS OUTLINES IN SECTION 13-8 OF THESE SPECIFICATIONS.  
e. PAINT BINDER WILL BE AS SPECIFIED BY THE CITY ENGINEER AND SHALL CONFORM TO AND BE APPLIED IN ACCORDANCE WITH SECTION 13 OF THE CITY STANDARD SPECIFICATIONS.  
28. EXISTING PAVEMENT SHALL NOT BE REMOVED UNTIL SUCH TIME AS ALL UTILITIES ARE COMPLETED AND PAVING CONTRACTOR IS READY TO REPAIR WITHIN 5 DAYS.  
29. EXACT LOCATION OF ALL SAWCUT LINES SHALL BE DETERMINED IN THE FIELD BY A CITY OF MADERA INSPECTOR.  
30. AT CONTRACTOR'S EXPENSE, FIELD THICKNESS MEASUREMENTS SHALL BE MADE AT A RATE OF 1 PER EVERY 300 LINEAL FEET OF ROADWAY. THE LOCATION OF FIELD TESTS SHALL BE CHOSEN BY THE INSPECTOR ON A RANDOM BASIS. THE PAVEMENT THICKNESS CRITERIA ARE LISTED BELOW:  
• IF THE AVERAGE OF ALL MEASUREMENTS MEETS OR EXCEEDS THE DESIGN THICKNESS, WITH NO MORE MORE THAN TEN (10) PERCENT LESS THAN THE DESIGN THICKNESS, THE PLACEMENT IS ACCEPTABLE.  
• IF THERE IS ONLY AN ISOLATED THIN AREA (CORE MORE THAN TEN (10) PERCENT OUT), THE LIMITS OF THE AREA SHOULD BE IDENTIFIED TO DETERMINE IF A CONSTRUCTION RESOLUTION IS NECESSARY.  
• IF THE CORE RESULTS INDICATE A CONSISTENTLY THIN SECTION, WITH NO MORE MORE THAN FIFTEEN (15) PERCENT LESS THAN THE DESIGN THICKNESS, THE CONTRACTOR SHALL PROPOSE A CONSTRUCTION RESOLUTION.  
• IF THE CORE RESULTS YIELD AN AVERAGE THICKNESS GREATER THAN THE DESIGN THICKNESS, BUT ARE ALTERNATIVELY VERY HIGH AND VERY LOW (MORE THAN TEN (10) PERCENT OUT), THE CITY ENGINEER SHALL REJECT THE PLACEMENT.  
31. FOR CITY OF DEVELOPER PROJECTS ON ROADWAY STREETS (ARTERIALS, COLLECTORS, EXPRESSWAYS), WHETHER NEW OR RECONSTRUCTION, THE CONTRACTOR OR THE DEVELOPER SHALL BE RESPONSIBLE TO SET MONUMENTS AT CENTERLINE INTERSECTION POINTS, ANGLE POINTS, AND BEGINNING AND END OF CURVES (BC & EC), WHERE MANHOLES OR OTHER OBSTRUCTIONS PREVENT THE INSTALLATION OF MONUMENTS AT THE PRESCRIBED LOCATIONS, MONUMENT TIES SHALL BE FURNISHED SUFFICIENT IN NUMBER TO RE-CREATE THE APPROPRIATE POINT.  
32. FOR NEW DEVELOPMENT PROJECTS INVOLVING THE CONSTRUCTION OF NEW INTERIOR MINOR STREETS AND/OR BORDERING MAJOR STREETS, IN ADDITION TO THE ABOVE REQUIREMENTS, THE DEVELOPER SHALL SET MONUMENTS AT ALL PROPERTY CORNERS.  
33. FOR ALL OF THE ABOVE, A LICENSED LAND SURVEYOR OR CIVIL ENGINEER LICENSED TO PERFORM LAND SURVEYING SHALL CERTIFY THE PLACEMENT OF ALL MONUMENTS IN ACCORDANCE WITH ALL LAWS, RULES AND REGULATIONS GOVERNING SUCH PLACEMENTS OR REPLACEMENTS.  
34. STORM DRAINAGE FACILITIES, SANITARY SYSTEM AND HOUSE BRANCHES, TOGETHER WITH WATER MAIN, GAS MAINS AND THEIR RESPECTIVE SERVICE CONNECTIONS SHALL BE COMPLETED IN THE STREET BEFORE INSTALLATION OF THE STREET SURFACING.  
35. ALL CURB AND GUTTER AND ALL OUTLETS SHALL BE WATER TESTED UNDER THE DIRECTION AND IN THE PRESENCE OF THE CITY INSPECTOR PRIOR TO ANY STREET OPERATION. ALL SAGS OR HUMPS SHALL BE REMOVED AND REPLACED TO THE SATISFACTION OF THE CITY.

## WATER

36. WATER MAINS ARE TO BE INSTALLED AND TESTED PER CITY OF MADERA STANDARD SPECIFICATIONS SECTION 22, "WATER FACILITIES."
37. NO WATER MAIN VALVES SHALL BE CLOSED BY THE CONTRACTOR EXCEPT IN THE CASE OF AN EMERGENCY SUCH AS A BROKEN

- MAIN. THE CONTRACTOR SHALL NOTIFY CITY ENGINEERING DEPARTMENT AND THE CITY PUBLIC WORKS DEPARTMENT IMMEDIATELY WHENEVER A VALVE IS CLOSED OR AFTER A LINE IS BROKEN. IN ALL OTHER CASES, SUCH AS MAKING CONNECTIONS TO EXISTING MAINS, ARRANGEMENTS SHALL BE MADE A MINIMUM OF 24 HOURS IN ADVANCE WITH CITY ENGINEERING DEPARTMENT AND THE CITY PUBLIC WORKS DEPARTMENT FOR CLOSURE OF ANY VALVES.
38. TRACER WIRE SHALL BE INSTALLED WITH ALL WATER MAINS AND FIRE HYDRANT RUNS. TRACER WIRE SHALL BE BARE COPPER WIRE, TYPE TW, SIZE AND/TO BE INSTALLED PER SECTION 22-3.3.
39. CONNECTIONS MADE TO EXISTING WATER MAINS SHALL BE PERFORMED BY WET TAP METHOD.
40. WHEN POLYVINYL CHLORIDE (PVC) CS90 PIPE IS USED FOR WATER MAINS, A CORING CUTTER IS REQUIRED FOR EACH WET TAP. A CITY PUBLIC WORKS DEPARTMENT REPRESENTATIVE OR ENGINEERING DEPARTMENT INSPECTOR MUST BE ON SITE DURING ALL WORK ON EXISTING CITY WATER MAINS.
41. ALL 1-INCH TO 2-INCH WATER SERVICES AND METER BOXES SHALL BE LOCATED OUTSIDE OF DRIVEWAY AREAS AND INSTALLED PER MADERA STANDARD DRAWING W-9 OR W-10.
42. ALL VALVES SHALL BE LOCATED OUTSIDE OF DRIVEWAYS, VALLEY AND CURB GUTTERS.
43. PHYSICAL SEPARATION/CAPS BETWEEN WATER MAINS WILL BE REQUIRED ON NEW WATER MAINS AT CONNECTIONS TO EXISTING MAINS UNTIL THE NEW WATER MAIN IS TESTED AND APPROVED FOR CONNECTION TO ANY EXISTING WATER MAINS PER MADERA STANDARD DRAWING W-12. A CITY PUBLIC WORKS DEPARTMENT REPRESENTATIVE OR ENGINEERING DEPARTMENT INSPECTOR SHALL BE PRESENT AT ALL WATER MAIN TIE-INS.
44. ALL DEAD ENDS SHALL HAVE WATER MAIN BLOW-OFFS INSTALLED PER CITY OF MADERA STANDARD DRAWING W-28, "BLOW-OFF ASSEMBLY TYPE B."
45. ALL FLANGED DUCTILE IRON FITTINGS TO BE COATED WITH EC-244 AND WRAPPED WITH 120 MIL THICK POLYETHYLENE.
46. ALL FIRE HYDRANTS REQUIRED FOR THIS PROJECT SHALL BE IDENTIFIED AND INSTALLED PER CITY OF MADERA STANDARD W-28, "FIRE HYDRANT INSTALLATION". INSTALL BLUE REFLECTIVE MARKER PER SAME STANDARD DRAWING. FIRE SERVICE LINES WITHOUT HYDRANTS AT THE END SHALL BE EQUIPPED WITH BLOW-OFFS.
47. WATER METERS SHALL BE INSTALLED PER MADERA STANDARD DRAWING W-9, W-10, W-24, OR W-25 AS REQUIRED BY PUBLIC WORKS AND SHALL READ IN CUBIC FEET AND BE LOCATED WITHIN CITY RIGHT-OF-WAY.
48. ANY BACKFLOW PREVENTION ASSEMBLY INSTALLED SHALL BE OF AN APPROVED TYPE AND BE INSTALLED ON PRIVATE PROPERTY DOWNSTREAM AND ADJACENT TO WATER METERS BE INSTALLED PER MADERA STANDARD DRAWING W-14, W-15, OR W-16 AS REQUIRED BY PUBLIC WORKS. WATER QUALITY DIVISION. THE BACKFLOW PREVENTION ASSEMBLY SHALL BE TESTED AND APPROVED BY THE CITY OF MADERA APPROVED AWWA CERTIFIED TESTER WITHIN FIVE (5) DAYS OF INSTALLATION WITH THE RESULTS SENT TO THE CITY PUBLIC WORKS DEPARTMENT.
49. A SEPARATE BUILDING PERMIT IS REQUIRED FOR THE INSTALLATION OF FIRE SPRINKLER SYSTEMS IN BUILDINGS. SUCH INSTALLATIONS ARE NOT A PART OF THE CONSTRUCTION WORKS WITH FIRE DEPARTMENT'S (FDC'S) SHALL HAVE APCA BACKFLOW PREVENTERS PER MADERA STANDARD DRAWINGS W-15.
50. BACTERIA TEST COST SHALL BE PAID BY DEVELOPER PRIOR TO ACCEPTANCE OF IMPROVEMENTS.

## SEWER MAINS

51. SEWER MAINS AND LATERALS ARE TO BE INSTALLED AND TESTED PER CITY OF MADERA STANDARD SPECIFICATIONS SECTION 17, "SANITARY SEWER PIPE AND APPURTENANCES."
52. PRIOR TO THE INSTALLATION AND/OR CONNECTION TO, ANY SEWERS, THE CONTRACTOR SHALL FIELD VERIFY AND COMPARE ALL EXISTING FLOWLINES WITH THOSE INDICATED ON THE APPROVED CONSTRUCTION PLANS PRIOR TO CONNECTING TO ANY EXISTING SEWER MAINS. ANY DISCREPANCIES AND/OR CONFLICTS WITH THE APPROVED PLANS SHALL IMMEDIATELY BE BROUGHT TO THE ATTENTION OF THE CITY AND THE DESIGN ENGINEER. AN ALTERNATE DESIGN SHALL BE PREPARED AND SUBMITTED TO THE CITY FOR APPROVAL PRIOR TO COMMENCEMENT OF WORK.
53. EXCEPT WHERE OTHERWISE NOTED OR APPROVED IN WRITING BY THE CITY ENGINEER, TRENCHES SHALL BE EXCAVATED ONLY AS FAR IN ADVANCE OF PIPE LAYING AS CAN BE BACKFILLED IN THE SAME DAY.
54. THE MAXIMUM TOTAL LENGTH OF OPEN TRENCH SHALL BE 500 FEET, EXCEPT WHERE APPROVED IN WRITING BY THE CITY ENGINEER.
55. EXCAVATIONS SHALL BE CONSIDERED OPEN TRENCH UNTIL ALL AGGREGATE SUB-BASE MATERIAL FOR PAVEMENT REPLACEMENT HAS BEEN PLACED AND COMPACTED.
56. WHEN A WATER LINE IS LESS THAN 12-INCHES ABOVE A SEWER MAIN, BELOW A SEWER MAIN, ABOVE OR BELOW A FORCE MAIN OR WITHIN 10 FEET HORIZONTALLY OF A SEWER MAIN, PROTECTION OF THE WATER LINE MUST BE CONSIDERED IN ACCORDANCE WITH SECTION 21-9 OF THE CITY OF MADERA STANDARD SPECIFICATIONS.
57. SAND AND GREASE INTERCEPTOR PER CITY STANDARD DRAWING S-11 SHALL BE INSTALLED WHEN IN OPINION OF PUBLIC WORKS DEPARTMENT IT IS NECESSARY FOR PROPER SEWER HANDLING. INTERCEPTORS SHALL BE INSTALLED IN TRENCH AND OTHER HARMFUL INGREDIENTS. ALL SAND AND GREASE INTERCEPTORS SHALL BE LOCATED AS TO BE EASILY AND EASILY ACCESSIBLE FOR CLEANING AND INSPECTION. ALL HOUSE LATERALS TO BE LAID TO MINIMUM 2 PERCENT SLOPE AND INSTALLED PER MADERA STANDARD DRAWING S-12.
58. SEWER MAINS ONLY TO BE LAID IN SEWER TRENCHES.
59. ALL CONTRACTORS INSTALLING SEWER MAINS THAT SEWER MAINS THAT WILL BE UNDER THE JURISDICTION OF THE CITY OF MADERA MUST BE CLASS "A", C34 CONTRACTORS.
60. A MECHANICAL PLUG OF ADEQUATE STRENGTH AND SIZE SHALL BE INSTALLED AT FIRST SEWER MANHOLE ON-SITE, UPSTREAM OF CITY SEWER MAIN CONNECTION TO PREVENT INFILTRATION INTO THE PUBLIC SEWER SYSTEM UNTIL SUCH TIME AS THE CITY AUTHORIZED ITS REMOVAL. AIR FILLED BLADDER TYPE PLUGS ARE NOT PERMITTED.

## STRIPING

61. THE CONTRACTOR SHALL NOTIFY THE ENGINEERING DEPARTMENT AT LEAST 48 HOURS IN ADVANCE OF ANY WORK, ANY CHANGES TO THE APPROVED PLAN SHALL BE APPROVED BY THE CITY ENGINEER PRIOR TO ANY WORK THEREON.
62. ANY EXISTING SIGNING AND/OR BARRICADES TO BE REMOVED SHALL BE SALVAGED TO THE CITY PUBLIC WORKS YARD LOCATED AT 1030 S. GATEWAY DRIVE.
63. STOPPING TO BE REMOVED SHALL BE GROUND OFF COMPLETELY AND THE SURFACE SLURRY SEALED WITH A TYPE "F" SLURRY PRIOR TO RE-STRIPING. ANY Voids CREATED BY GROUND OFF SHALL BE REPAIRED.
64. ALL STENCILING (ARROWS INCLUDED) TO BE REMOVED BY GRINDING SHALL BE DONE IN A MANNER TO PROVIDE A RECTANGULAR SHAPE ENCOMPASSING THE AREA TO BE REMOVED. NO GRINDING SHALL "SHADOW" THE SHAPE OF THE STENCILING TO BE REMOVED.
65. CROSSWALKS SHALL BE INSTALLED USING CA SPEC. WATERBORNE PAINT, APPLIED AT A MINIMUM THICKNESS OF 15 MILS.
66. TYPE 1 OR II GLASS BEADS SHALL BE APPLIED IMMEDIATELY AFTER APPLICATION, MINIMUM RATE OF 5 LBS PER GALLON OF PAINT USED.
67. TYPE OF MARKERS SHALL BE AS STATED IN SECTION 85-1.02 "TYPE OF MARKERS" OF THE STATE STANDARD SPECIFICATIONS AND AS SHOWN ON THE STRIPING PLANS(S). ALL PAVEMENT MARKERS AND ROAD SIGNS INSTALLED SHALL CONFORM TO THE PROVISIONS IN THE LATEST EDITION OF THE CALIFORNIA SUPPLEMENT TO THE MANUAL OF UNIFORM TRAFFIC CONTROL DEVICES (MUTCD), SECTION 85 OF THE STATE STANDARD SPECIFICATIONS, STATE STANDARD PLANS, PAGES A20-A THROUGH D AND PAGES A43-A THROUGH C ALONG WITH THE CITY OF MADERA SPECIFICATIONS.
68. ALL CONCRETE MEDIAN NOSE FACES SHALL BE PAINTED FOR A DISTANCE OF THREE (3) FEET ALONG BOTH SIDES WITH REFLECTIVE MATERIAL, NO RESEALERS ARE ALLOWED.
69. THE CONTRACTOR SHALL FURNISH AND INSTALL NEW 0M2-2H MARKERS ON ALL MEDIAN ISLAND NOSES, UNLESS OTHERWISE NOTED ON THE PLANS.
70. SIGNS SHALL BE PLACED A MINIMUM OF FOUR (4) FEET FROM THE EDGE OF PAVEMENT WHEN INSTALLING ALONG STREETS WHERE CURB AND GUTTER ARE NOT PRESENT.
71. SIGN PLACEMENT SHALL ALLOW FOR 5 FEET CLEAR WALKING PATH BETWEEN POST AND BACK OF CURB OR ANY OTHER OBSTRUCTION.
72. WHERE SIGNS ARE TO BE INSTALLED, LIGHT POLES SHOULD BE USED, IN LIEU OF POSTS, WHENEVER POSSIBLE.
73. STREET SIGN INSTALLATION ON METAL STREETLIGHT OR SIGNAL POLES SHALL REQUIRE THE USE OF STAINLESS STEEL BANDING MATERIAL, NO RESEALERS ARE ALLOWED.

## TRAFFIC CONTROL

74. BEFORE ANY WORK IS STARTED IN THE RIGHT-OF-WAY, THE CONTRACTOR SHALL INSTALL ALL ADVANCE WARNING SIGNS FOR THE CONSTRUCTION ZONE. THE CONTRACTOR SHALL INSTALL TEMPORARY STOP SIGNS AT ALL NEW STREET ENCROACHMENTS INTO EXISTING PUBLIC STREETS IMMEDIATELY AFTER THE FIRST GRADING WORK IS ACCOMPLISHED AND SHALL MAINTAIN ROAD SIGNS UNTIL PERMANENT SIGNS ARE INSTALLED. ALL CONSTRUCTION SIGNING, BARRICADEING, AND TRAFFIC DELINEATION SHALL CONFORM TO THE CALIFORNIA SUPPLEMENT TO THE MANUAL OF UNIFORM TRAFFIC CONTROL DEVICES 2014 EDITION WITH REVISION 6, MARCH 2021, ISSUED BY THE STATE OF CALIFORNIA DEPARTMENT OF TRANSPORTATION AND BE APPROVED BY THE CITY OF MADERA BEFORE CONSTRUCTION BEGINS. COMPLIANCE WITH THE REQUIREMENTS OF SAID MANUAL SHALL BE CONSIDERED AS A MINIMUM REQUIREMENT AND IT SHALL BE THE RESPONSIBILITY OF THE CONTRACTOR TO PROVIDE ADDITIONAL SAFETY DEVICES WHEN NECESSARY TO MAINTAIN A SAFE CONDITION.
75. PRIOR TO COMPLETION OF WORK EACH DAY, THE CONTRACTOR SHALL BACKFILL AND PROVIDE TEMPORARY TRENCH RESURFACING BEFORE LEAVING THE SITE.
76. IF PUBLIC STREET SHALL BE CLOSED WITHOUT PRIOR APPROVAL FROM THE CITY ENGINEER.
77. IF THE PROJECT IMPROVEMENTS NECESSITATE TEMPORARY REMOVAL AND OR RELOCATION OF TRAFFIC CONTROL SIGNS, MARKINGS OR ANY OTHER TRAFFIC CONTROL DEVICES, THEY SHALL BE MAINTAINED THROUGHOUT THE ENTIRE DURATION OF THE PROJECT AND SHALL BE RESTORED TO THE SATISFACTION OF THE CITY ENGINEER.
78. ENCROACHMENT PERMITS ISSUED TO ALLOW WORK IN THE PUBLIC RIGHT-OF-WAY SHALL BE REVOKED IF THE ABOVE REQUIREMENTS ARE NOT STRICTLY COMPLIED WITH BY THE DEVELOPER'S FORCES DURING OFF-SITE STREET IMPROVEMENT OPERATIONS. REVOKED PERMITS SHALL NOT BE RE-USED UNTIL SUCH TIME AS THE CITY ENGINEER DETERMINES THAT THE PERMIT HAS NOT BEEN VIOLATED AND WILL PERFORM THEIR OPERATION IN COMPLIANCE WITH THE ABOVE REQUIREMENTS INCLUDING THE CONDITIONS OF THE STREET WORK PERMIT.

## GENERAL FIRE DEPARTMENT NOTES

80. WATER TRUCK MUST BE EQUIPPED WITH AN APPROVED AIR GAP SEPARATION WHICH SHALL BE A MINIMUM OF TWICE THE DIAMETER OF THE SUPPLY LINE ABOVE THE OVERFLOW OF THE WATER TANK. A PLUMBING FOR AIR GAP SHALL BE ATTACHED TO OUTSIDE OF TANK.
81. IF DURING CONSTRUCTION IT BECOMES NECESSARY TO CLOSE ANY CONTROL VALVE OR PLACE A HYDRANT OUT OF SERVICE, THE CITY PUBLIC WORKS DEPARTMENT SHALL BE NOTIFIED.
82. AT ALL TIMES DURING CONSTRUCTION, SUITABLE EMERGENCY VEHICLE ACCESS ROADS MUST BE MAINTAINED. ROADWAYS MUST BE SMOOTH, COMPACTED AND CAPABLE OF SUPPORTING THE IMPOSED LOADS OF ALL EMERGENCY VEHICLES.
83. ALL FIRE HYDRANTS ARE TO BE IN PLACE AND WORKING BEFORE BUILDING CONSTRUCTION BEGINS.
84. IF THE CONTRACTOR DURING CONSTRUCTION, THROUGH THE CITY ENGINEERING DEPARTMENT, CONSTRUCTION SITE WATER METERS WILL BE SET AND RELOCATED ONLY BY PUBLIC WORKS DEPARTMENT. ALL WATER TRUCKS BEING FILLED FROM FIRE HYDRANTS OR FROM ANY OTHER CONNECTION THE CITY WATER SYSTEM MUST HAVE AN AIR GAP BETWEEN THE RECEIVING VESSEL AND DELIVERY PIPE. AIR GAP MUST BE AT LEAST TWO TIMES THE DIAMETER OF THE DELIVERY PIPE. ALL DELIVERY PIPES MUST BE EXTERNALLY MOUNTED ON THE TRUCK TO FACILITATE VISUAL INSPECTION. PRESENCE OF A R.P. ON THE HYDRANT WILL NOT EXEMPT TRUCKS FROM THE AIR GAP REQUIREMENT. NO CONSTRUCTION WATER MAY BE TAKEN FROM THE WATER SYSTEM THROUGH A HOSE UNLESS IT IS DOWNSTREAM OF THE R.P. AND METER.

## MADERA CIVIL IMPROVEMENTS NOTES:

PROJECT REVIEW BY REPRESENTATIVES OF THE CITY OF MADERA IS INTENDED TO COMPLEMENT AND ASSIST THE PROFESSIONAL(S) IN ADVANCING A PROJECT THAT IS IN COMPLIANCE WITH CITY OF MADERA REQUIREMENTS, AND IS CONSIDERED WITH PUBLIC BENEFIT, HEALTH, SAFETY, AND WELFARE. REVIEWER DOES NOT PROVIDE AN ASSURANCE OF PROJECT FEASIBILITY, PROFESSIONAL AND TECHNICAL ACCURACY, OR CONFORMANCE WITH SPECIAL CONDITIONS IMPOSED BY PUBLIC AGENCIES, INCLUDING THE CITY OF MADERA PLANNING COMMISSION.

APPROVAL OF THESE IMPROVEMENT PLANS AND SPECIFICATIONS IS MADE BASED ON THE REPRESENTATIONS MADE BY THE PROFESSIONAL(S) IN RESPONSIBLE CHARGE PURSUANT TO SECTION 8763 AND 8763.1 OF THE BUSINESS AND PROFESSIONS CODE THAT THEY HAVE DISCHARGED THEIR RESPONSIBILITIES AND PREPARED COMPLETE DOCUMENTS WHICH COMPLY WITH CITY OF MADERA REQUIREMENTS FOR CONSTRUCTION OF THE IMPROVEMENTS DEPICTED HEREIN.

THE ENGINEER SHOULD CONTACT THE CALIFORNIA REGIONAL WATER QUALITY CONTROL BOARD REGARDING THE REQUIREMENT TO FILE A NOTICE OF INTENT (NOI) WITH THE STATE WATER RESOURCES CONTROL BOARD IN COMPLIANCE WITH THE NATIONAL POLLUTANT DISCHARGE ELIMINATION SYSTEM (NPDES) PERMIT PRIOR TO CONSTRUCTION. ALL CONSTRUCTION PROJECTS ONE ACRE OR LARGER TYPICALLY MUST APPLY FOR THE PERMIT.

## FEMA NOTE:

THIS SITE IS LOCATED IN FEMA FLOOD ZONE "X" PER COMMUNITY MAP 06039C1155E, EFFECTIVE 9/26/2008

## BENCHMARK:

NATIONAL GEODETIC SURVEY MON  
PBR: 630713

STAMPED: L 549 1957

MARKER/SETTING: BENCH MARK DISK SET IN TOP OF CONCRETE MONUMENT

DESCRIPTION:  
3 MI W. FROM MADERA  
1.0 MI. SOUTHWEST ALONG WEST YOSEMITE AVENUE FROM THE SOUTHERN PACIFIC COMPANY RAILROAD STATION AT MADERA, THENCE 2.0 MILES WEST ALONG AVENUE 14, IN R17E T11S, IN THE SOUTHEAST CORNER OF SECTION 21, AT THE INTERSECTION OF ROAD 24, 104 FEET NORTH OF THE CENTER LINE OF THE AVENUE, 25 FEET WEST OF THE CENTER LINE OF ROAD, 1 1/2 FEET NORTH OF A TELEPHONE POLE WITH TWO GUY WIRES, 1.4 FEET SOUTH OF A WITNESS POST, ABOUT LEVEL WITH THE GROUND, AND SET THE TOP OF A CONCRETE POST PROJECTIONS 0.4 FOOT ABOVE THE GROUND.

ELEVATION: 248.8 (MVD 88 DATUM)

## BASIS OF BEARINGS:

THE EAST LINE OF THE NORTHEAST QUARTER OF SECTION 26, T. 11 S., R. 17 E., M.D.B.M. IS TAKEN TO BE SOUTH 00°04'28" EAST AS SHOWN ON DOCUMENT NO. 14123, RECORDED IN BOOK 20, AT PAGE 56 OF MAPS, MADERA COUNTY RECORDS.

## SPECIAL NOTE

WHERE UNDERGROUND AND SURFACE STRUCTURES ARE SHOWN ON THE PLANS, THE LOCATIONS, DEPTH AND DIMENSIONS OF STRUCTURES ARE BELIEVED TO BE REASONABLY CORRECT, BUT ARE NOT GUARANTEED. SUCH STRUCTURES ARE SHOWN FOR THE INFORMATION OF THE CONTRACTOR, BUT INFORMATION SO GIVEN IS NOT TO BE CONSTRUED AS A REPRESENTATION THAT SUCH STRUCTURES WILL, IN ALL CASES, BE FOUND WHERE SHOWN, OR THAT THEY REPRESENT ALL OF THE STRUCTURES WHICH MAY BE ENCOUNTERED.

CONTRACTOR SHALL NOTIFY "USA" (UNDERGROUND SERVICE ALERT) AT 811, 48 HOURS BEFORE COMMENCING EXCAVATION AND ALL UTILITY AUTHORITIES OR UTILITY COMPANIES HAVING POSSIBLE INTEREST IN THE WORK, OF THE CONTRACTOR'S INTENTION TO EXCAVATE PROXIMATE TO EXISTING FACILITIES, AND CONTRACTOR SHALL VERIFY THE LOCATION OF ANY UTILITIES WITHIN THE WORK AREA.

## SITE INFORMATION:

CROSS STREETS: SOUTH SCHNOOR AVENUE AND WEST ALMOND AVENUE

APN: 009-330-011


SITE AREA: 16.57 ACRES

CIVIL SHEET INDEX	
SHEET DESCRIPTION	SHEET NUMBER
COVER SHEET	C-1
GRADING PLAN	C-2
GRADING PLAN DETAILS	C-3
UTILITY PLAN	C-4
EROSION CONTROL PLAN	C-5

OFF-SITE QUANTITIES	
ITEM	QUANTITY
CONCRETE SIDEWALK	1,602 S.F.
DRIVE APPROACH	1 EA
ADA RAMPS	2 EA
VALLEY GUTTER	1 EA

201908C  
City of Madera  
Building Department  
The approval of these plans does not prevent the City of Madera from requiring the contractor to correct errors or omissions in the plans, specifications, or construction. Subsequent to the approval and approval of the plans.

APPROVED  
MAR 03 2022

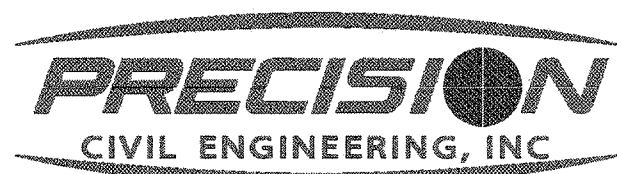


## CONSTRUCTION PLANS FOR SOUTH SCHNOOR AVENUE AND WEST ALMOND AVENUE

## COVER SHEET

CITY OF MADERA ENGINEERING DEPARTMENT 428 W. YOSEMITE AVENUE MADERA, CALIFORNIA 95338		SHEET C-1 OF C-5 SHEETS	
APPROVAL CITY ENGINEER REVIEWED BY FIRE DEPARTMENT: DESIGNED BY: NMG DRAWN BY: CPG CONSTRUCTION DATES CONTRACTOR: PROJECT No. SPR 2021-24		DATE DATE DATE DATE DATE DATE	
INITIAL ISSUE DATE CHANGE DATE APPROVAL		CHECKED BY: INSPECTED BY: DATE COMPLETED	
WORK ORDER No.		WDID# 5F20C395690	



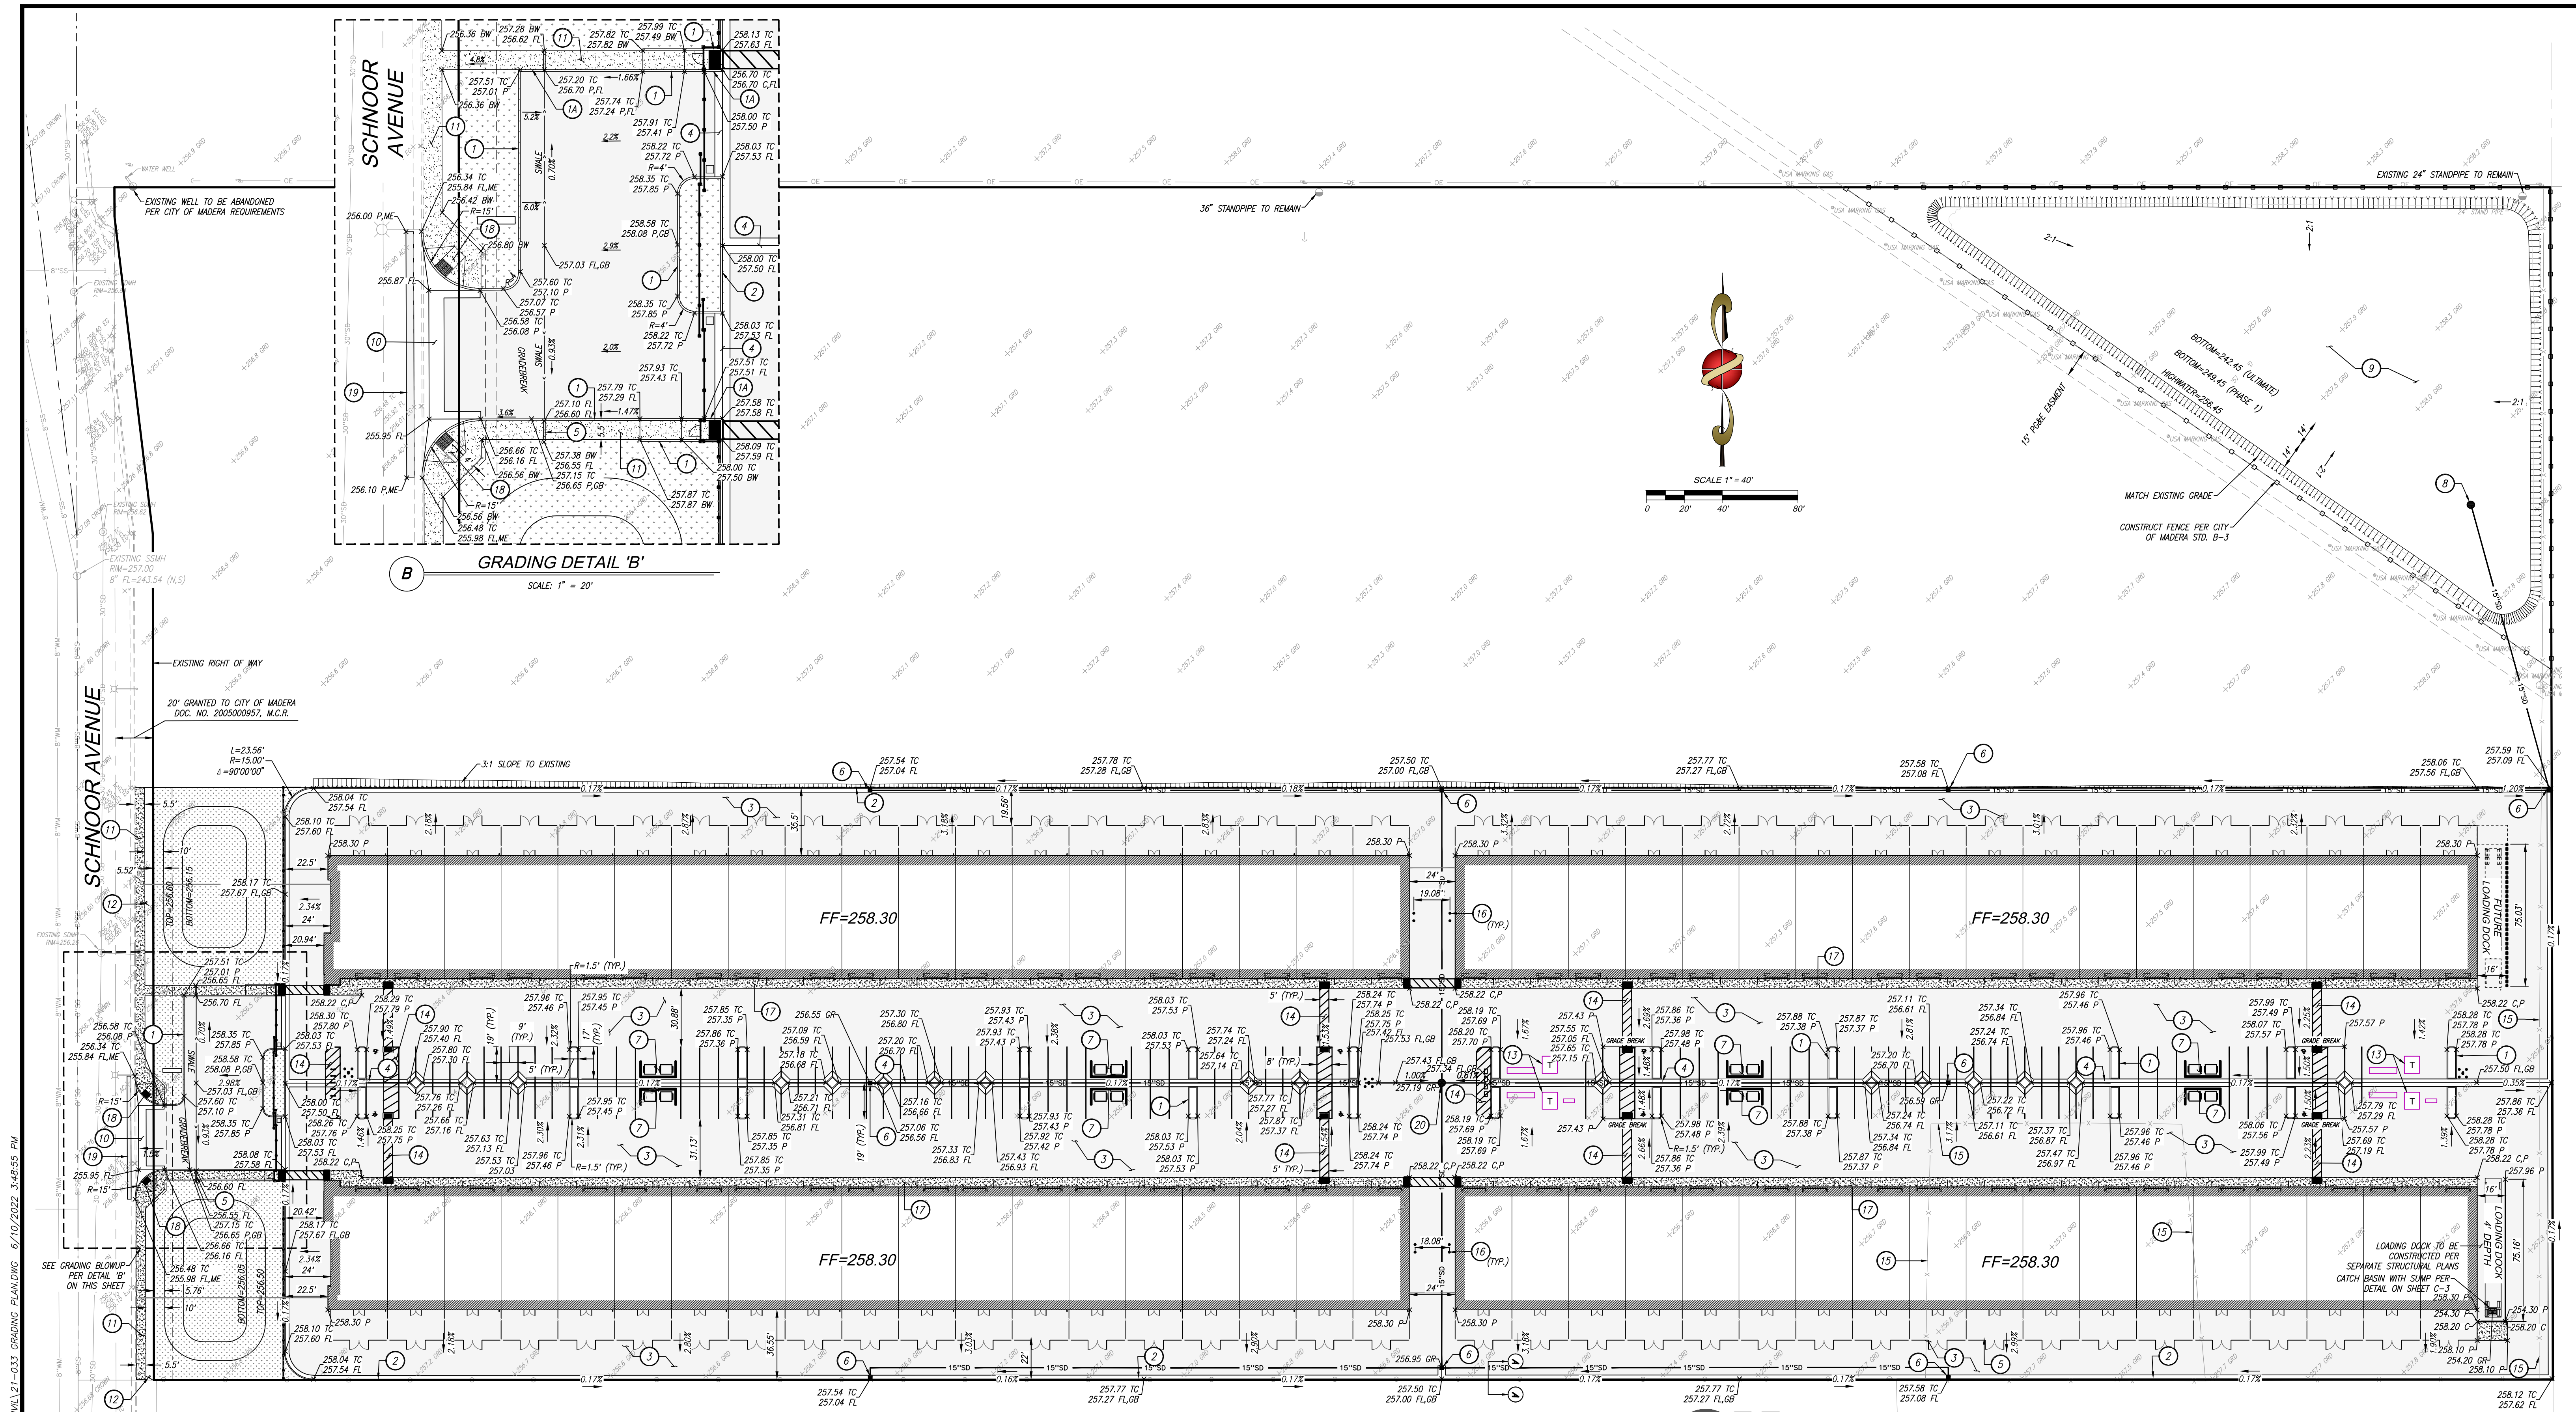


#### CONSTRUCTION KEYNOTES:

- |    |  |    |  |    |   |
|----|--|----|--|----|---|
| 1  | CONSTRUCT 6" CONCRETE CURB PER DETAIL "D" SHEET C-3  | 8  | INSTALL OUTFALL STRUCTURE PER UTILITY PLAN   | 16 | INSTALL BOLLARD   |
| 1A | CONSTRUCT 6" CONCRETE CURB TAPER PER DETAIL "F" SHEET C-3  | 9  | CONSTRUCT STORM DRAIN BASIN PER CITY OF MADERA STD. SD-1                                   | 17 | CONSTRUCT 5' CONCRETE WALK PER DETAIL "E" SHEET C-3                 |
| 2  | CONSTRUCT 6" CONCRETE CURB AND GUTTER PER DETAIL "G" SHEET C-3   | 10 | CONSTRUCT MODIFIED CONCRETE VALLEY GUTTER PER CITY OF MADERA MODIFIED STD. ST-1, SHEET C-3 | 18 | CONSTRUCT CURB ACCESS RAMP PER CITY OF MADERA STD. ST-16            |
| 3  | CONSTRUCT PAVEMENT PER DETAIL "A" SHEET C-3  | 11 | CONSTRUCT CONCRETE SIDEWALK PER CITY OF MADERA STD. ST-13A                                 | 19 | SAWCUT TO A CLEAN, SMOOTH EDGE AND INSTALL 1" WIDE, 7" DEEP AC PLUG |
| 4  | CONSTRUCT 4" CONCRETE VALLEY GUTTER PER DETAIL "B" SHEET C-3   | 12 | INSTALL "NO PARKING" R26 (CA) SIGN AND "BIKE LANE" R81 (CA) SIGN                           | 20 | INSTALL ADS NYLOPLAST MANHOLE WITH SLOTTED TRAFFIC RATED LID        |
| 5  | INSTALL SIDEWALK DRAIN (1) 3"x6" RECTANGULAR TUBE PER DETAIL "C", SHEET C-3                                    | 13 | PROPOSED ELECTRICAL CABINET AND TRANSFORMER PER ELECTRICAL PLANS                           |    |   |
| 6  | INSTALL CHRISTY U-23 CATCH BASIN WITH H-20 TRAFFIC RATED LID PER DETAIL ON SHEET C-3                           | 14 | PROPOSED STRIPING  |    |   |
| 7  | CONSTRUCT TRASH ENCLOSURE PER CITY OF MADERA STD. E-7 WITH SCUPPERS FOR DRAINAGE. SEE DETAIL "H" PER SHEET C-3 | 15 | EXISTING FENCE TO BE REMOVED   |    |   |

#### EARTHWORK QUANTITIES (PHASE 1):

DISTURBED AREA (ACRES)	CUT VOLUME (CUBIC YARDS)	FILL VOLUME (CUBIC YARDS)	NET VOLUME (CUBIC YARDS) CUT/FILL
9	7,279	7,088	191 (CUT)

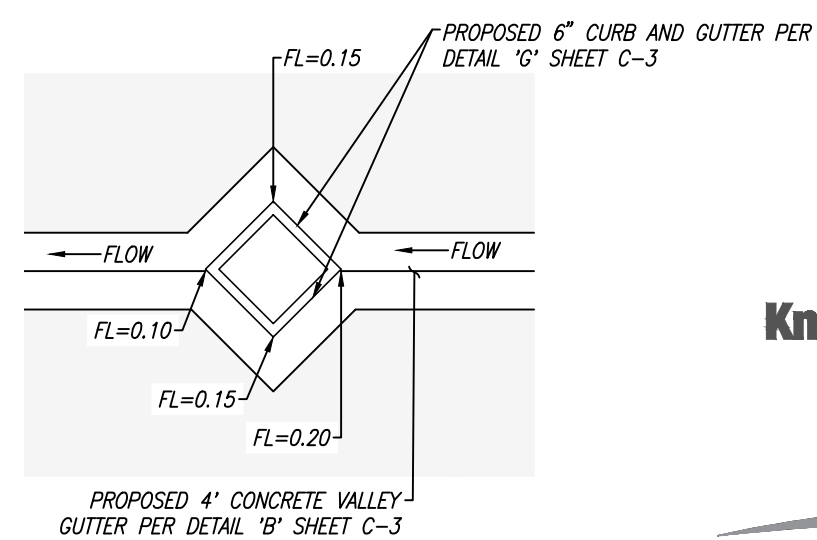

#### LANDSCAPE PLANTER DETAIL

NO SCALE



**PRECISION**  
CIVIL ENGINEERING, INC.



#### CONSTRUCTION PLANS FOR SOUTH SCHNOOR AVENUE AND WEST ALMOND AVENUE GRADING PLAN




CITY OF MADERA

ENGINEERING DEPARTMENT  
428 W. YOSEMITE AVENUE  
MADERA, CALIFORNIA 93638


PLAN REVISION		
CHANGE	DATE	APPROVAL

SHEET C-2 OF C-5 SHEETS	
APPROVAL	DATE
CITY ENGINEER	
REVIEWED BY	
PUBLIC WORKS	
FIRE DEPARTMENT	
PARK DEPARTMENT	
DESIGNED BY: NMG	CHECKED BY: CPG
DRAWN BY: CPG	INSPECTED BY: CPG
CONSTRUCTION DATES	
CONTRACTOR: SPR 2021-24	




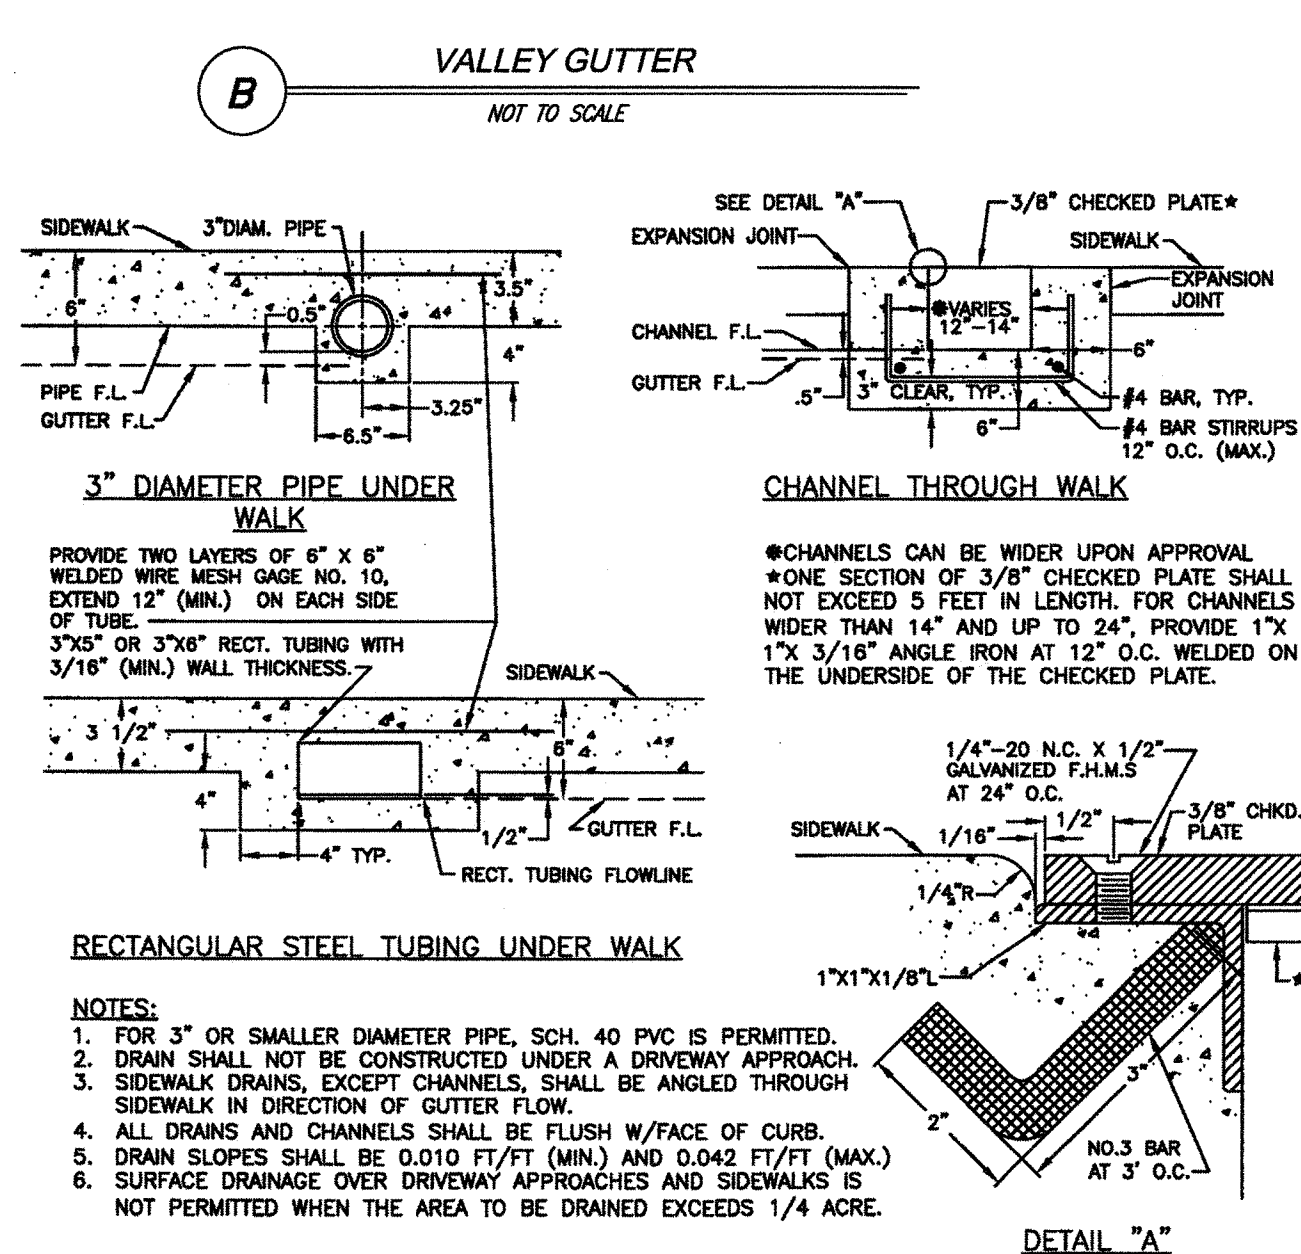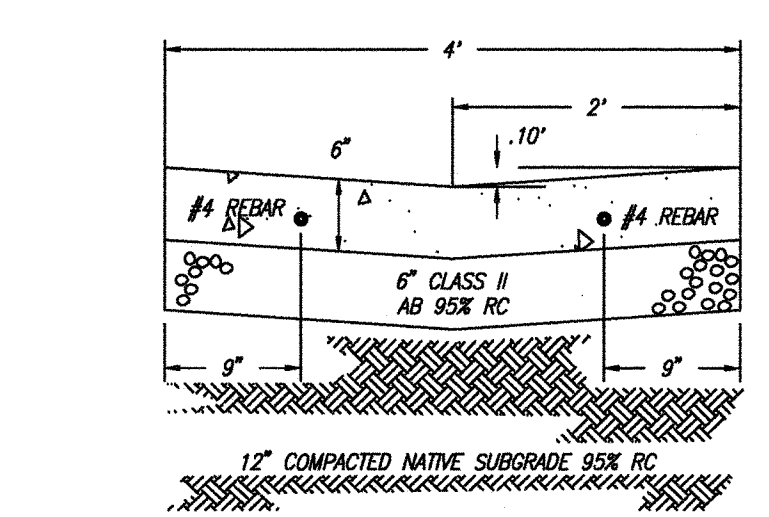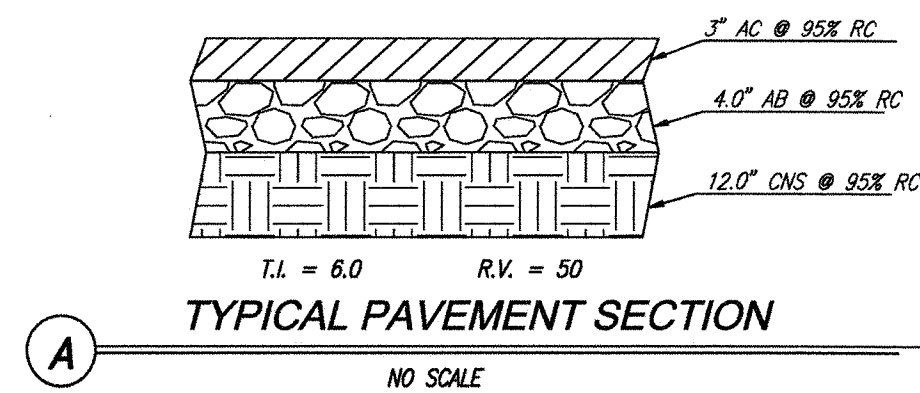


**C UNDERWALK DRAIN DETAIL**  
NO. SCALE

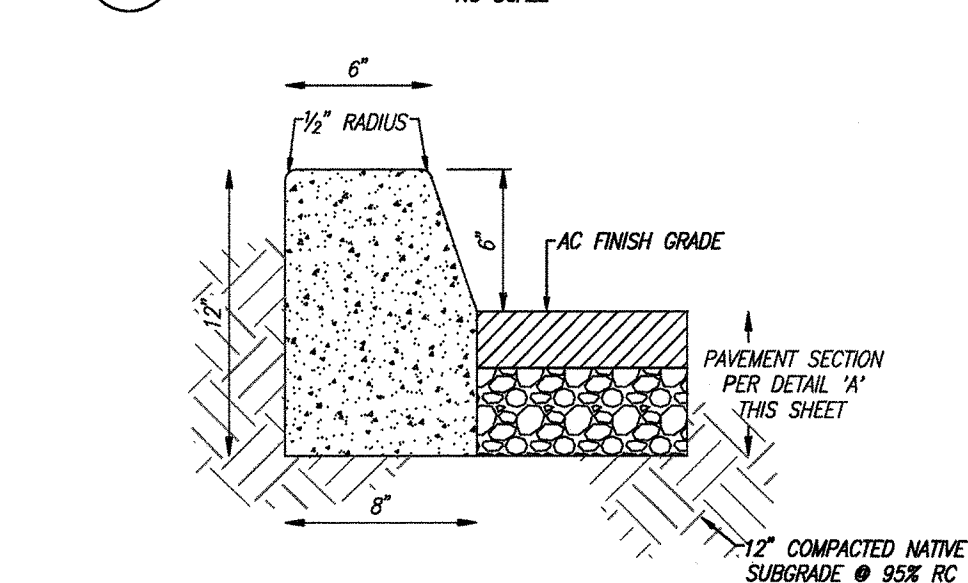


**D** 6" CONCRETE CURB  
NO SCALE

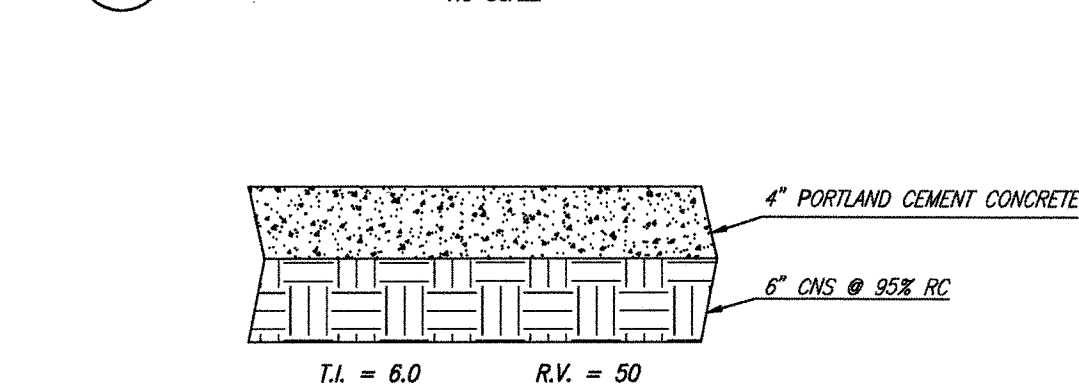


**E** **TYPICAL CONCRETE SECTION**  
NO SCALE

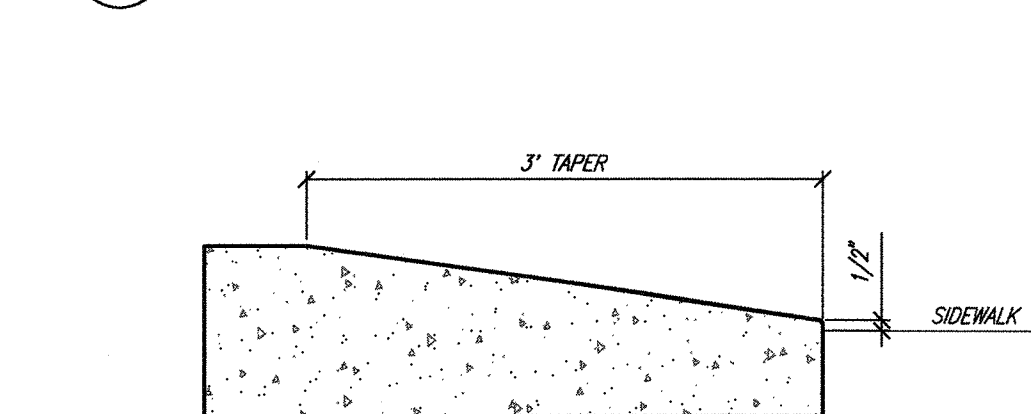

**F** *CURB TAPER DETAIL*  
NO SCALE

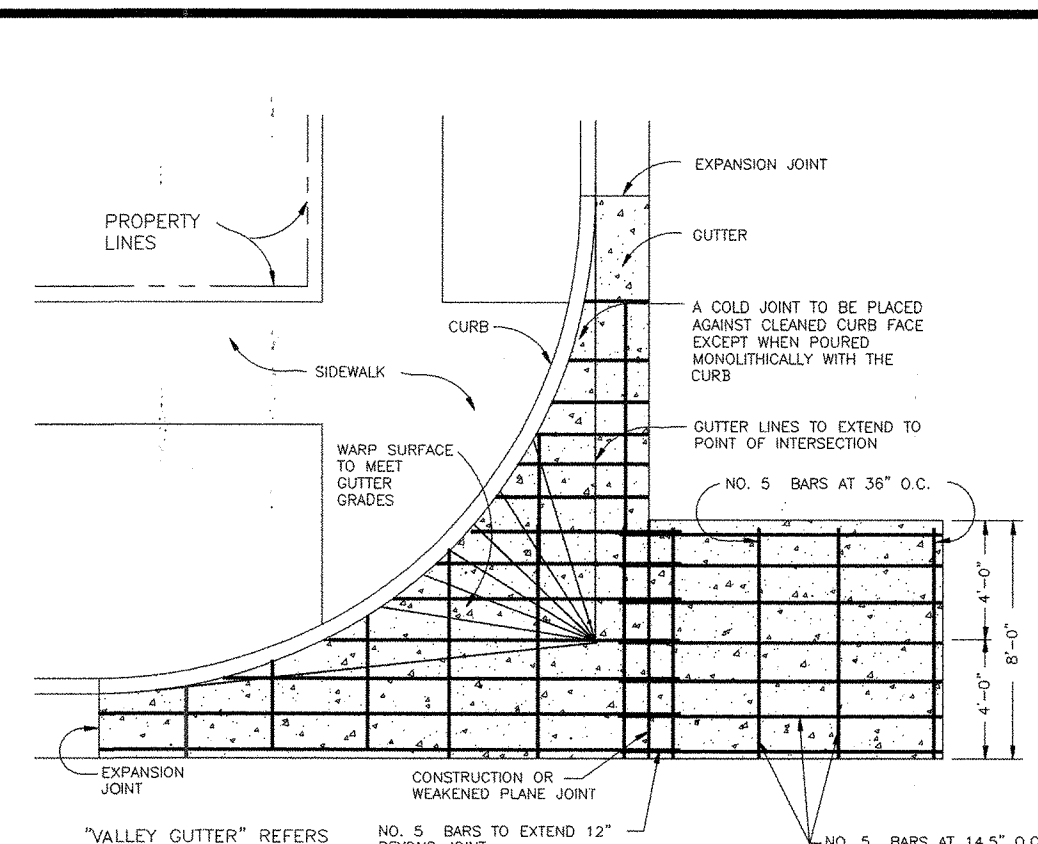


## PLAN

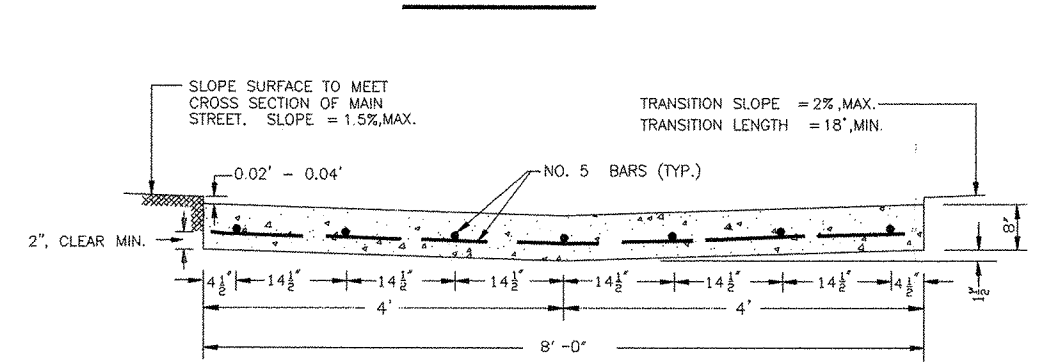


NOTE: 1) IN NEW CONSTRUCTION AREAS, VALLEY GUTTERS SHALL BE DESIGNED TO PROVIDE A MINIMUM DIFFERENCE OF THIRTY-FIVE HUNDREDTHS OF A FOOT (.35") FROM END OF RETURN TO END OF RETURN.  
2) ALL VALLEY GUTTERS SHALL BE CONSTRUCTED USING 6 SACK CLASS A CONCRETE PER STD. SPECIFICATIONS 14-2

### SECTION OF GUTTER


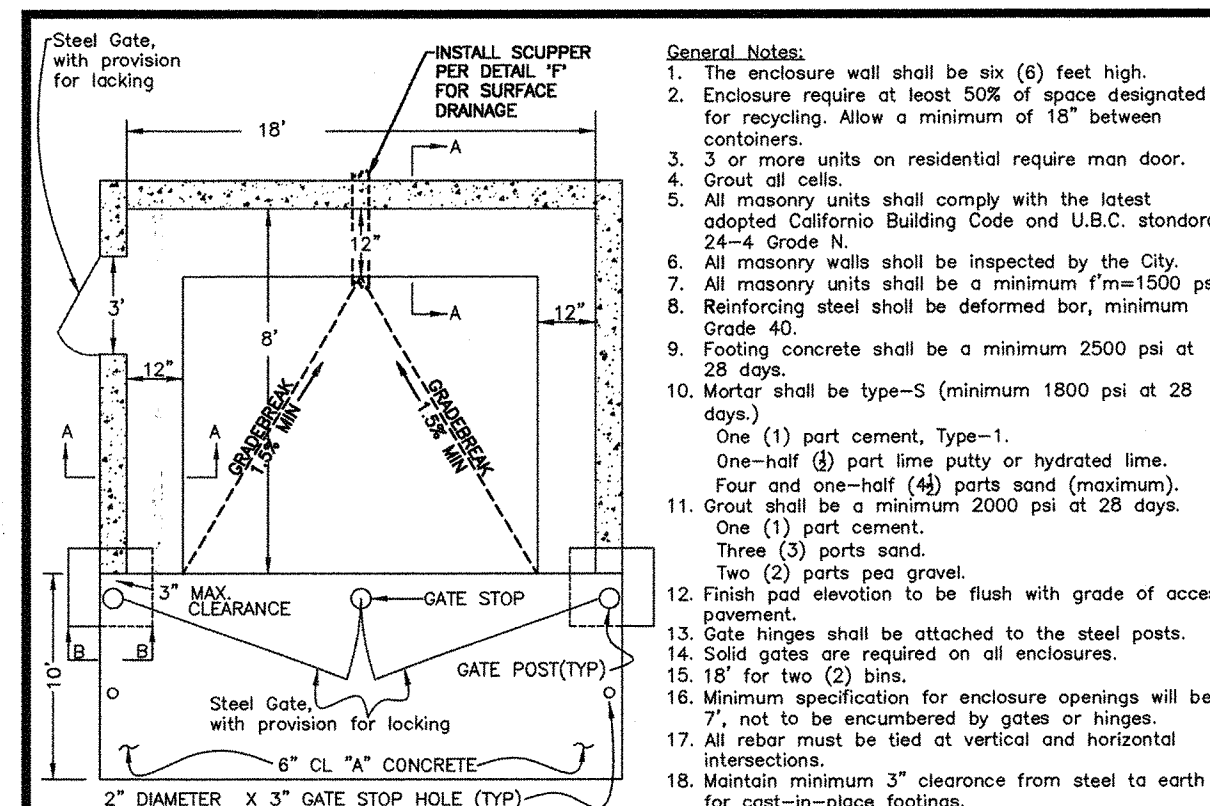


### Plan View

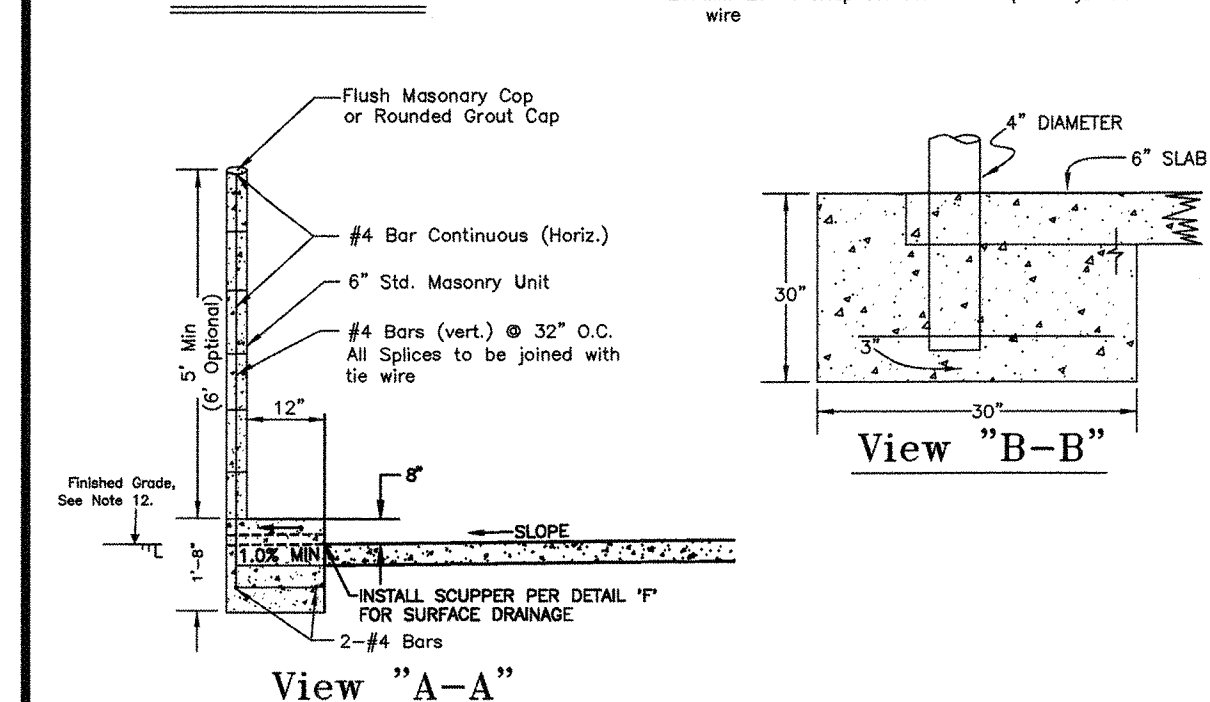


Typical Section w/ Concrete Block Wall


## TYPICAL REFUSE CONTAINER ENCLOSURE DETAILS

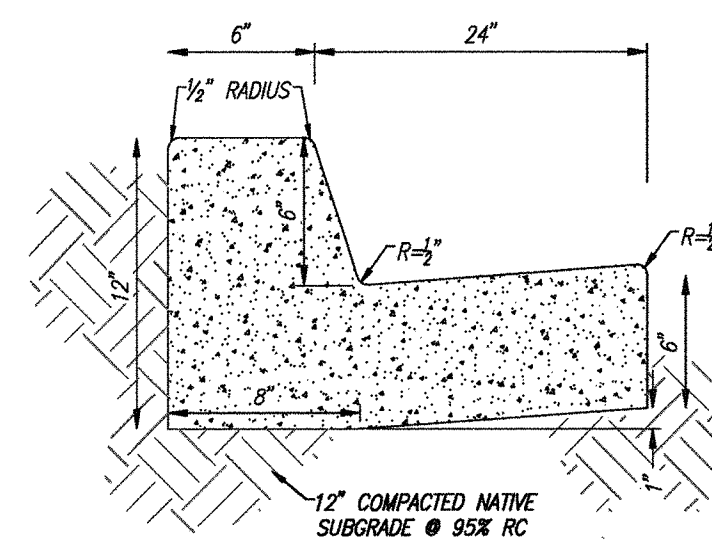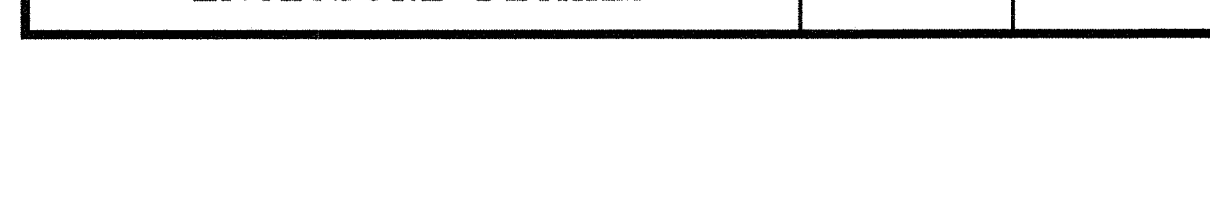


6" CONCRETE CURB AND GUTTER

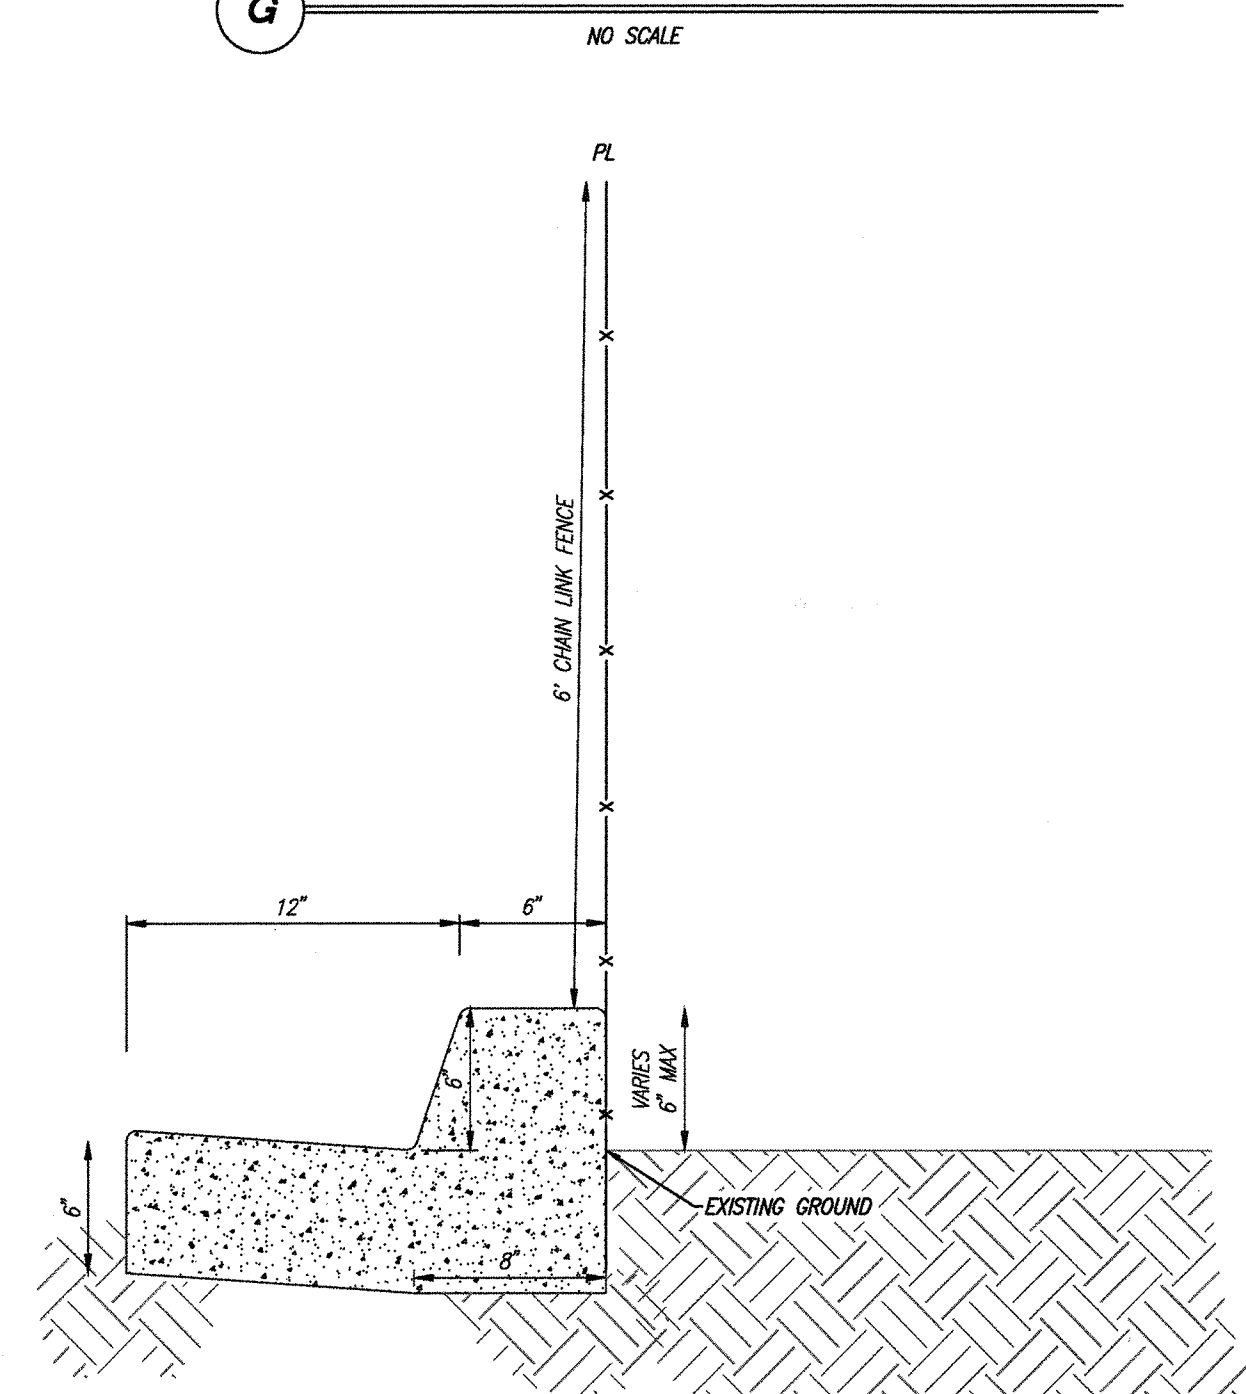

**A-A** **SECTION A-A**  
NO. SCALE

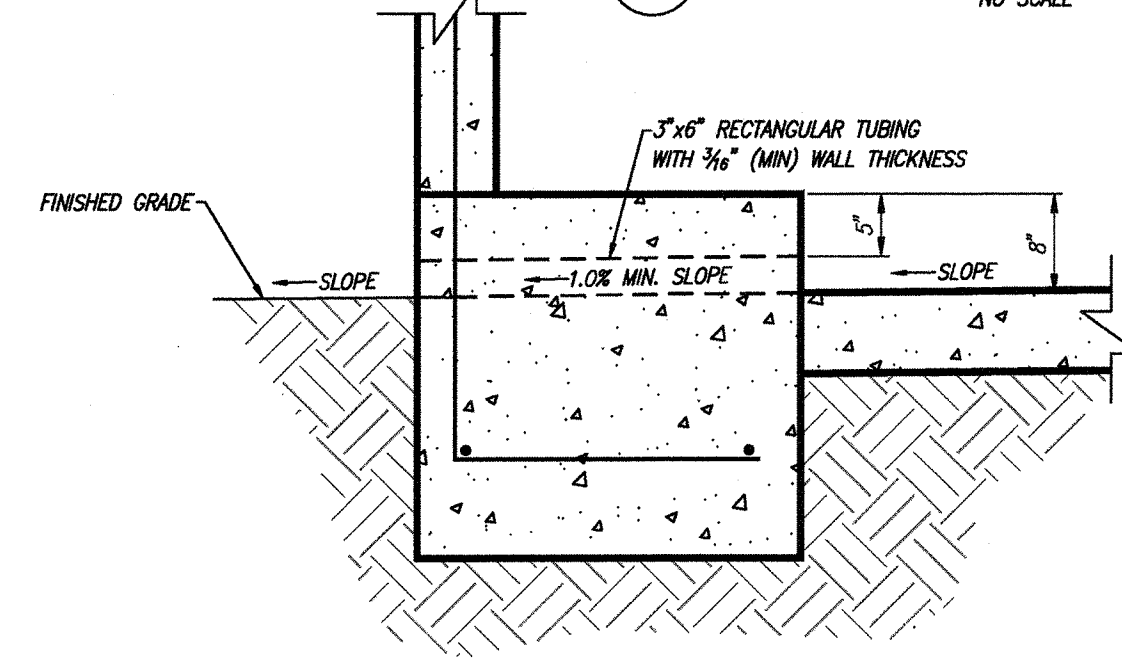

**H TRASH ENCLOSURE SCUPPER DETAIL**  
NO. SCALE

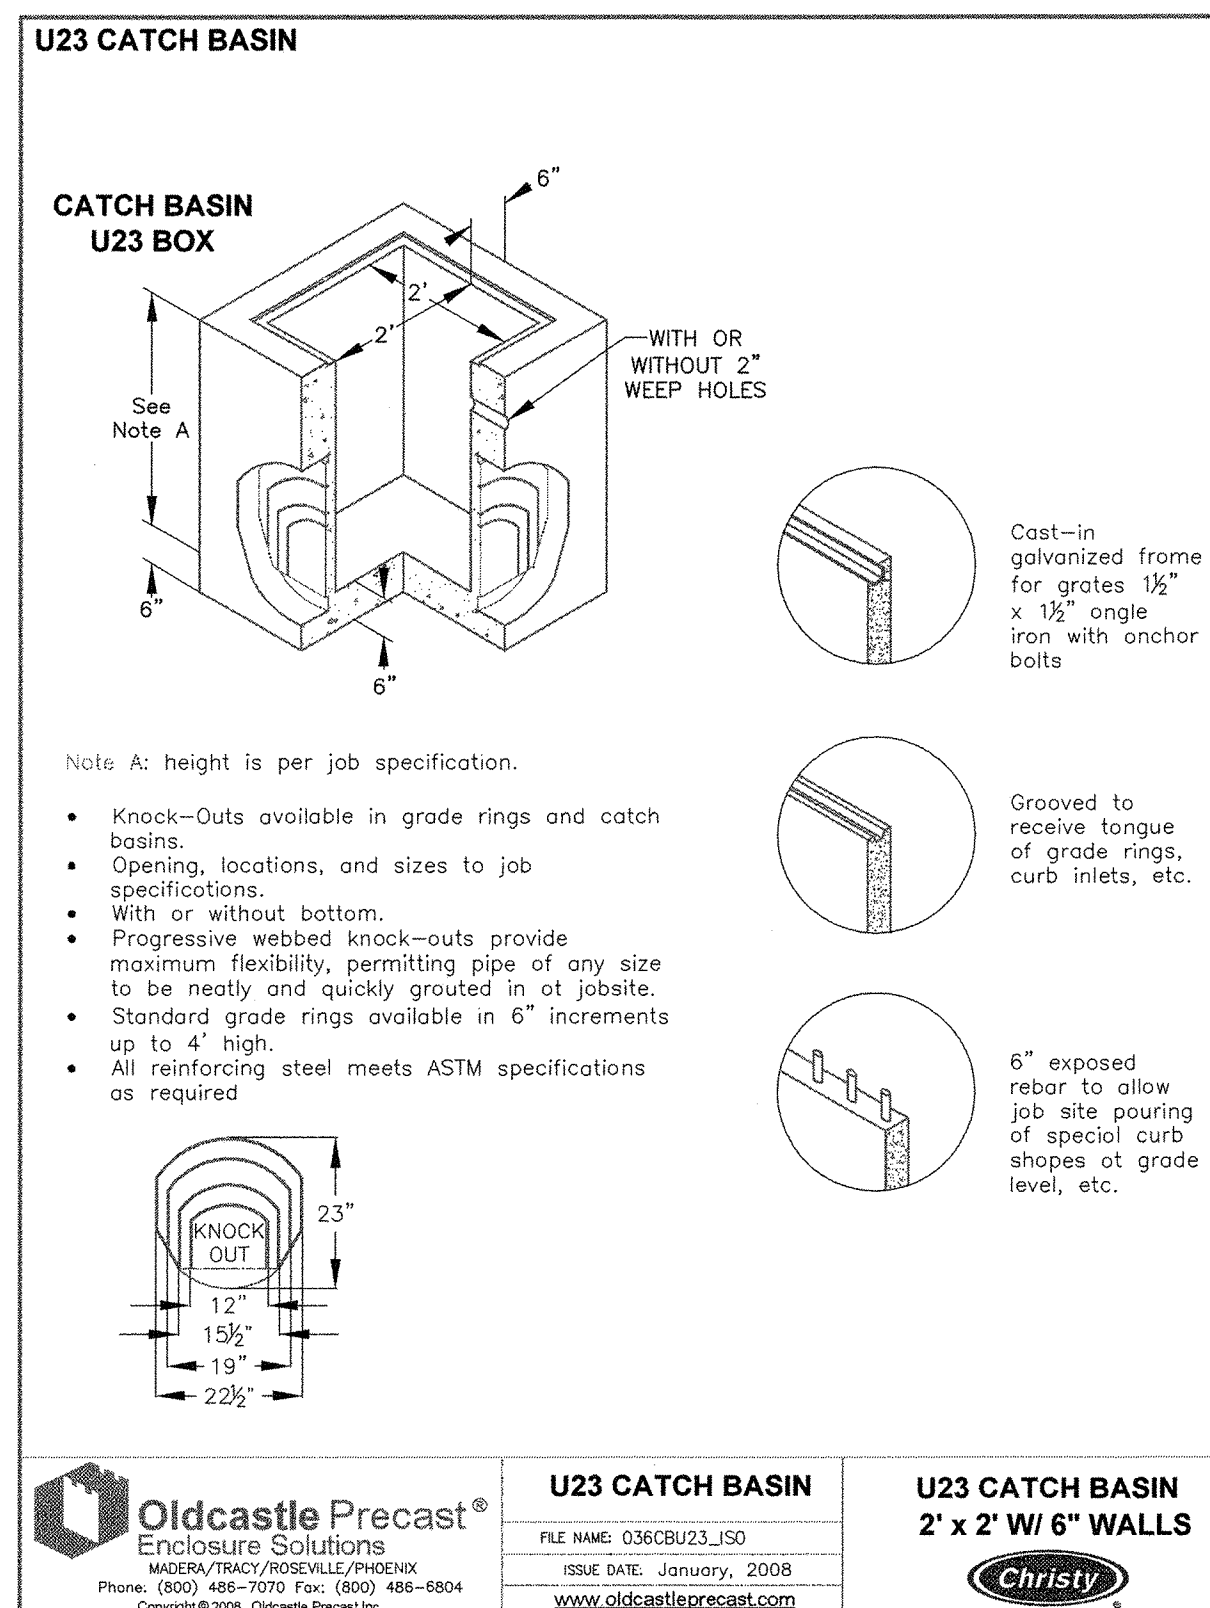

Copyright © 2008 by Oldcastle Precast Inc.



1234 Q. STREET, FRESNO, CA 93721 PH(559)449-4500 FAX(559)449-4513


CONSTRUCTION PLANS FOR  
WHOLESALE PARTNERS  
GRADING PLAN DETAILS

**CITY OF MADERA**  
ENGINEERING DEPARTMENT  
428 W. YOSEMITE AVENUE  
MADERA, CALIFORNIA 93638

SHEET C-3 OF C-5 SHEETS

ENGINEERING DEPARTMENT 428 W. YOSMITE AVE MADERA, CALIFORNIA 93638			APPROVAL _____ DATE _____	
CITY ENGINEER _____			CITY ENGINEER _____	
REVIEWED BY _____			REVIEWED BY _____	
PUBLIC WORKS: _____			PUBLIC WORKS: _____	
FIRE DEPARTMENT: _____			FIRE DEPARTMENT: _____	
PARK DEPARTMENT: _____			PARK DEPARTMENT: _____	
DESIGNED BY: MNG			CHECKED BY: _____	
DRAWN BY: CPG			INSPECTED BY: _____	
CONSTRUCTION DATES _____			CONSTRUCTION DATES _____	
CONTRACTOR: _____			CONTRACTOR: _____	
PROJECT No. SPR 2021-08			PROJECT No. SPR 2021-08	
WORK ORDER No. _____			WORK ORDER No. _____	



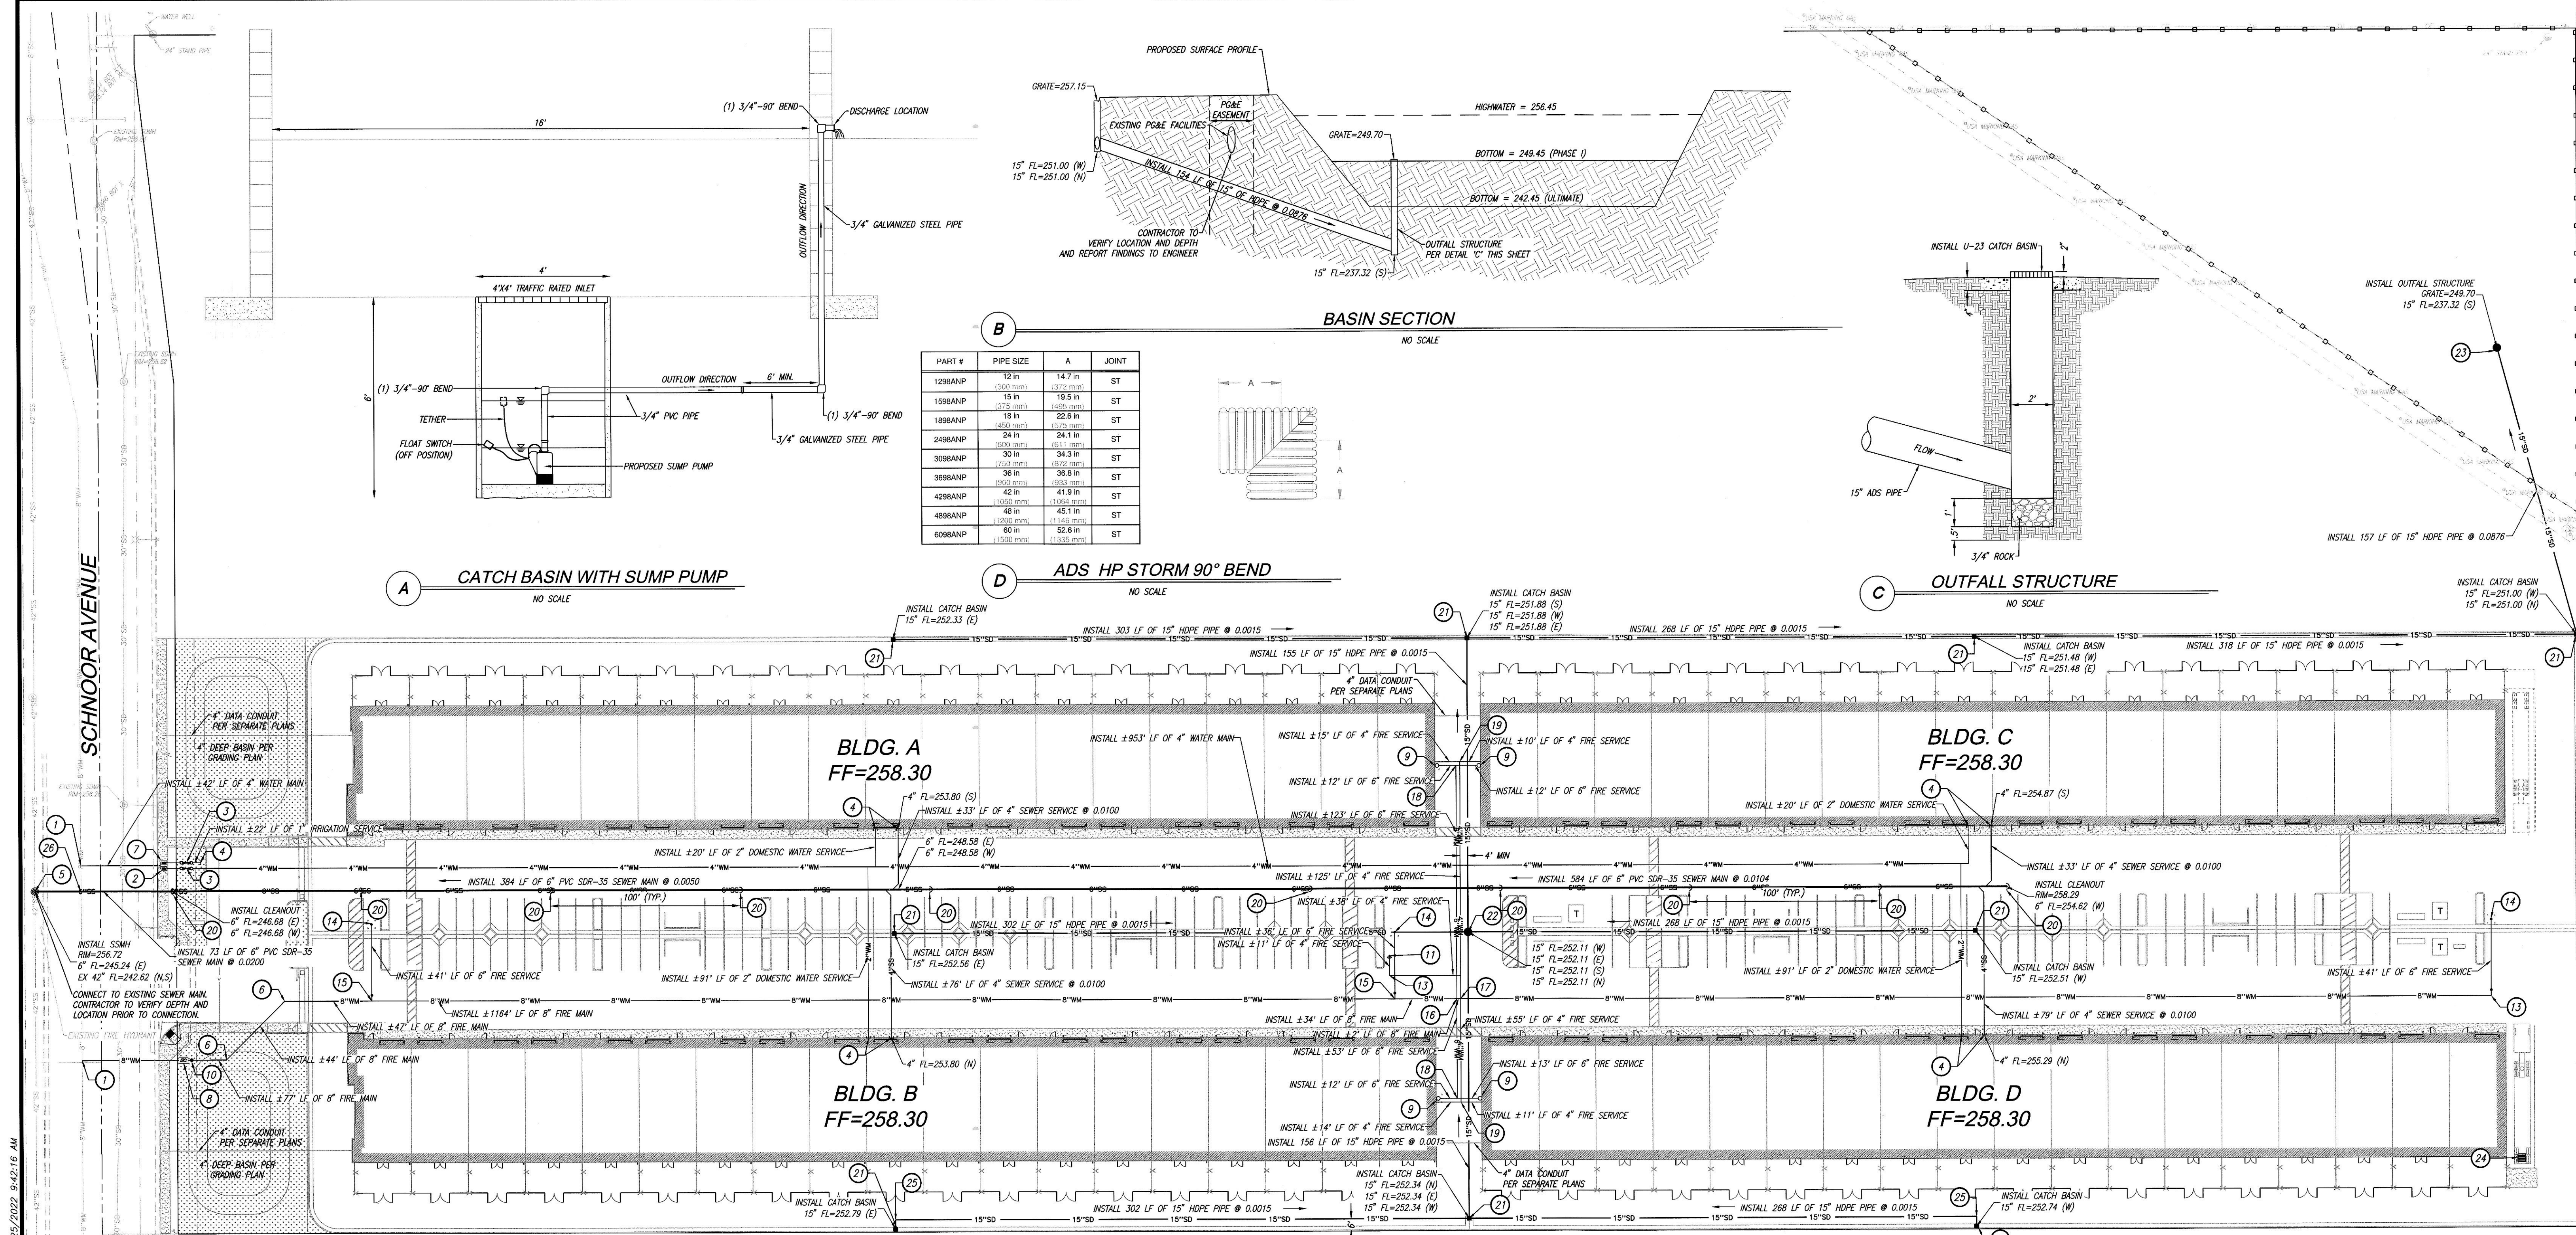


LEGEND

SSMH	SANITARY SEWER MANHOLE
EBP	EXISTING BACKFLOW PREVENTOR
ESMH	EXISTING SEWER MANHOLE
EW	EXISTING WATER METER
ES	EXISTING SEWER MAIN
EW	EXISTING WATER MAIN
WR	PROPOSED REDUCED BACKFLOW ASSEMBLY
WM	PROPOSED WATER METER
WS	PROPOSED SEWER MAIN (SIZE AS NOTED)
W	PROPOSED WATER MAIN (SIZE AS NOTED)
DC	PROPOSED DETECTOR CHECK

KEYNOTES:

- CONNECT TO EXISTING WATER MAIN PER METHOD OF HOT TAP. CONTRACTOR TO VERIFY SIZE AND DEPTH AND LOCATION OF EXISTING SERVICE MAIN PRIOR TO INSTALLATION.
- INSTALL 4" WATER METER PER CITY OF MADERA STD. W-10 AND W-9B
- INSTALL REDUCED PRESSURE PRINCIPLE BACKFLOW PREVENTION ASSEMBLY PER CITY OF MADERA STD. W-14
- CAP AND STUB SERVICE
- INSTALL 60" SEWER MANHOLE PER CITY OF MADERA STD. S-2
- INSTALL 45" BEND
- INSTALL 1" WATER METER PER CITY OF MADERA STD. W-9A AND W-9B
- INSTALL 8" DETECTOR CHECK PER CITY OF MADERA STD. W-16
- INSTALL FIRE RISER PER APPROVED FIRE PROTECTION PLANS. (SEPARATE SUBMITTAL)
- INSTALL POST INDICATOR VALVE PER DETAIL BELOW AND CITY OF MADERA FIRE DEPARTMENT STANDARDS
- INSTALL FIRE DEPARTMENT CONNECTION PER FDC/PIV DETAIL ON THIS SHEET AND CITY OF MADERA FIRE DEPARTMENT STANDARDS
- INSTALL 90° BEND
- INSTALL FIRE HYDRANT PER CITY OF MADERA STD. W-26 AND BOLLARDS PER W-27
- INSTALL 8"x6"x8" TEE
- INSTALL 8"x6"x8"x6" CROSS
- INSTALL 8"x4"x8"x4" CROSS
- INSTALL 6" TEE
- INSTALL 4" TEE
- INSTALL SANITARY SEWER CLEANOUT PER CITY OF MADERA STD. S-12A
- INSTALL CHRISTY CATCH BASIN PER DETAIL ON SHEET C-3
- INSTALL 36" ADS NYLOPLAST MANHOLE WITH SLOTTED TRAFFIC RATED LID PER MANUFACTURER SPECIFICATIONS
- INSTALL OUTFALL STRUCTURE PER DETAIL 'C' THIS SHEET
- INSTALL 4'x4' CATCH BASIN AND SUMP PUMP PER DETAIL 'A' THIS SHEET
- INSTALL ADS 90° BEND PER DETAIL 'D' THIS SHEET
- MAINTAIN MINIMUM 1' CLEARANCE BETWEEN WATER AND SEWER DEPTHS TO BE FIELD VERIFIED.




FRONT VIEW

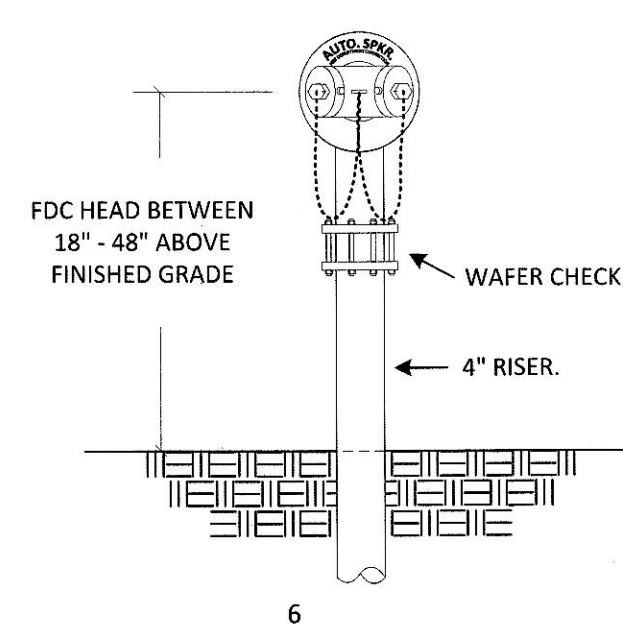

FIRE NOTES:

- UNDERGROUND TO BE INSTALLED, TESTED AND FLUSHED PER NFPA 24, 2013 ED.
- ONLY NEW, LISTED AND APPROVED DEVICES SHALL BE INSTALLED IN THIS SYSTEM.
- ALL VALVES SHALL HAVE A PERMANENTLY AFFIXED SIGN INDICATING ITS FUNCTION.
- CLEARANCE PIPING THROUGH HOLES IN PLATFORMS, FOUNDATIONS, WALLS, OR FLOORS: HOLES SHALL BE NOMINALLY 2" LARGER THAN THE PIPE FOR 1" NOMINAL TO 3 1/2" AND 4" LARGER THAN THE PIPE FOR PIPE 4" NOMINAL AND LARGER.
- IT IS THE CONTRACTOR'S RESPONSIBILITY TO MAKE WORK AVAILABLE FOR INSPECTION.
- AN APPROVED SET OF PLANS SHALL BE MAINTAINED ON THE JOB SITE.
- AN APPOINTMENT SHALL BE MADE A MINIMUM OF TWO WORKING DAYS IN ADVANCE FOR ALL TESTS AND INSPECTIONS.
- A SEPARATE PERMIT IS REQUIRED FOR THE INSTALLATION OF THE UG FIRE MAIN SYSTEM. THE PERMIT SHALL BE OBTAINED FROM THE BUILDING DEPARTMENT.
- A CONTROL VALVE IS REQUIRED FOR EACH PROPOSED FIRE HYDRANT.
- A CHECK VALVE IS REQUIRED BETWEEN THE FDC LINE "T" CONNECTION AND THE SUPPLY SYSTEM TO PREVENT WATER FROM PUSHING BACK TO THE SYSTEM.

FDC/PIV DETAIL

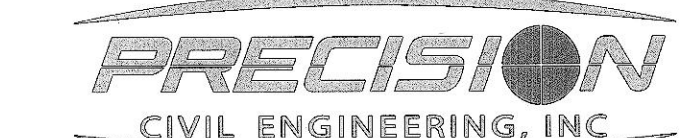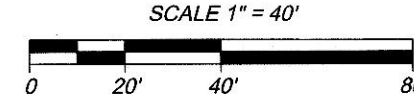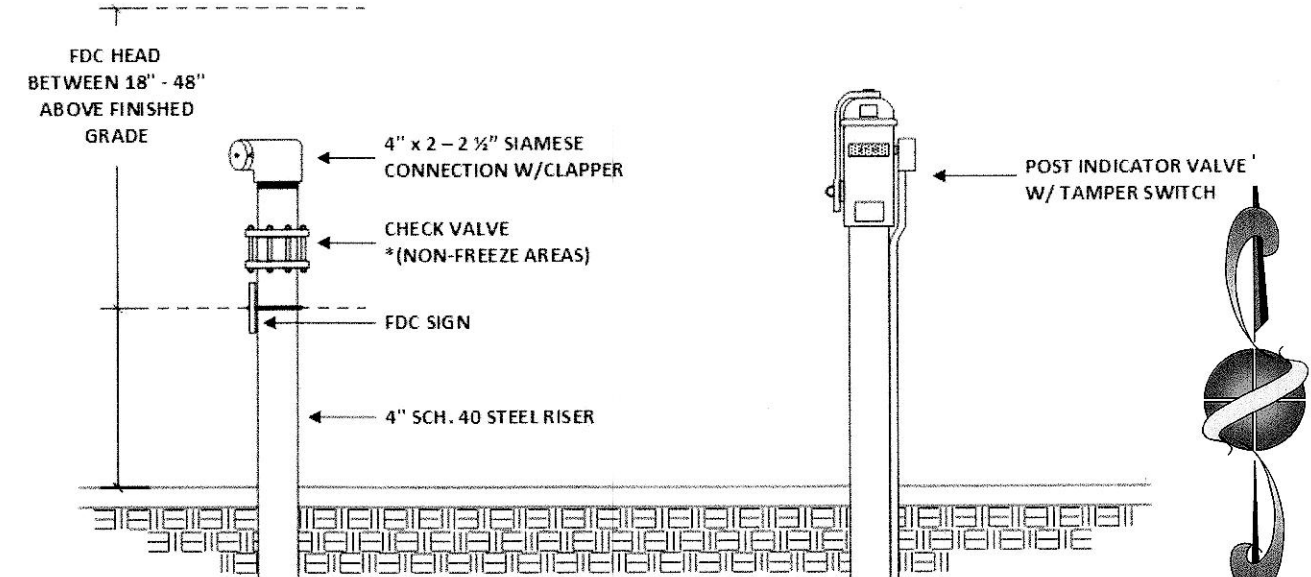

CONSTRUCTION PLANS FOR  
SOUTH SCHNOOR AVENUE AND WEST ALMOND AVENUE  
UTILITY PLAN

CITY OF MADERA ENGINEERING DEPARTMENT 420 W. YOSEMITE AVENUE MADERA, CALIFORNIA 93639		SHEET C-4 OF C-5 SHEETS	
APPROVAL CITY ENGINEER DESIGNED BY DRAWN BY CONSTRUCTION DATES CONTRACTOR PROJECT No. SPR 2021-24		DATE 10-26-22 CHECKED BY INSPECTED BY DATE COMPLETED	
PLAN REVISION CHANGE DATE APPROVAL		WORK ORDER No.	





ADDITIONAL TEMPORARY  
Bmps TO BE USED ON SITE



ITEM	BMP NAME
WM-01	MATERIAL DELIVERY AND STORAGE
WM-02	MATERIAL USE
WM-03	STOCKPILE MANAGEMENT
WM-04	SPILL PREVENTION CONTROL
WM-05	SOLID WASTE MANAGEMENT
WM-06	HAZARDOUS WASTE MANAGEMENT
WM-07	CONTAMINATED SOIL MANAGEMENT
WM-08	CONCRETE WASTE MANAGEMENT
WM-09	SANITARY-SEPTIC WASTE MANAGEMENT
WM-10	LIQUID WASTE MANAGEMENT
SC-5	FIBER ROLLS
SC-7	STREET SWEEPING
SC-10	STORM DRAIN INLET PROTECTION
TC-1	STABILIZED CONSTRUCTION ENTRANCE AND EXIT
TC-2	STABILIZED CONSTRUCTION ROADWAY
TC-3	ENTRANCE OUTLET TIRE WASH
EC-1	SCHEDULING
EC-15	SOIL PREPARATION - ROUGHENING
EC-16	NON-VEGETATED STABILIZATION
NS-1	WATER CONSERVATION PRACTICES
NS-2	DEWATERING OPERATION
NS-3	PAVING AND GRINDING OPERATION
NS-8	VEHICLE AND EQUIPMENT CLEANING
NS-9	VEHICLE AND EQUIPMENT FUELING
NS-10	VEHICLE AND EQUIPMENT MAINTENANCE
NS-12	CONCRETE CURING
NS-13	MATERIAL AND EQUIPMENT USE OVER WATER
NS-14	CONCRETE FINISHING
NS-15	DEMOLITION REMOVAL ADJACENT TO WATER

GENERAL NOTES:



- IT IS THE CONTRACTOR'S RESPONSIBILITY TO VERIFY THAT ALL BMP'S NECESSARY ARE IMPLEMENTED INCLUDING, BUT NOT LIMITED TO THE METHODS SHOWN ON THE EROSION CONTROL PLAN.
- STORM WATER DISCHARGES AND AUTHORIZED NON-STORM WATER DISCHARGES SHALL NOT CONTAIN A HAZARDOUS SUBSTANCE EQUAL TO OR IN EXCESS OF REPORTABLE QUANTITIES ESTABLISHED IN 40 C.F.R. 117.3 AND 302.4, UNLESS A SEPARATE NPDES PERMIT HAS BEEN ISSUED TO REGULATE THOSE DISCHARGES.
- MINIMIZE OR PREVENT POLLUTANTS IN STORM WATER DISCHARGES AND AUTHORIZED NON-STORM WATER DISCHARGES THROUGH THE USE OF CONTROLS, STRUCTURES, AND MANAGEMENT PRACTICES THAT ACHIEVE BAT FOR TOXIC AND NON-CONVENTIONAL POLLUTANTS AND BCT FOR CONVENTIONAL POLLUTANTS.
- CONDUCT AN INVENTORY OF THE PRODUCTS USED AND/OR EXPECTED TO BE USED AND THE END PRODUCTS THAT ARE PRODUCED AND/OR EXPECTED TO BE PRODUCED. THIS DOES NOT INCLUDE MATERIALS AND EQUIPMENT THAT ARE DESIGNED TO BE OUTDOORS AND EXPOSED TO ENVIRONMENTAL CONDITIONS (I.E. POLYS, EQUIPMENT PAIS, CABINETS, CONDUCTORS, INSULATORS, BRICKS, ETC.).
- COVER AND BERM LOOSE STOCKPILED CONSTRUCTION MATERIALS THAT ARE NOT ACTIVELY BEING USED (I.E. SOIL, SPOILS, AGGREGATE, FLY-ASH, STUCCO, HYDRATED LIME, ETC.).
- STORE CHEMICALS IN WATERIGHT CONTAINERS (WITH APPROPRIATE SECONDARY CONTAINMENT TO PREVENT ANY SPILLAGE OR LEAKAGE) IN A STORAGE SHED (COMPLETELY ENCLOSED).
- MINIMIZE EXPOSURE OF CONSTRUCTION MATERIALS TO PRECIPITATION. THIS DOES NOT INCLUDE MATERIALS AND EQUIPMENT THAT ARE DESIGNED TO BE OUTDOORS AND EXPOSED TO ENVIRONMENTAL CONDITIONS.
- IMPLEMENT BMP'S TO PREVENT THE OFF-SITE TRACKING OF LOOSE CONSTRUCTION AND LANDSCAPE MATERIALS.
- PREVENT DISPOSAL OF ANY RUNSE OR WASH WATERS OR MATERIALS ON IMPERVIOUS OR PEROUS SITE SURFACES OR INTO THE STORM DRAIN SYSTEM.
- ENSURE THE CONTAINMENT OF SANITATION FACILITIES (I.E. PORTABLE TOILETS) TO PREVENT DISCHARGES OF POLLUTANTS TO THE STORM WATER DRAINAGE SYSTEM OR RECEIVING WATER.
- CLEAN OR REPLACE SANITATION FACILITIES AND INSPECT THEM REGULARLY FOR LEAKS AND SPILLS.
- COVER WASTE DISPOSAL CONTAINERS AT THE END OF EVERY BUSINESS DAY AND DURING A RAIN EVENT.
- PREVENT DISCHARGES FROM WASTE DISPOSAL CONTAINERS TO THE STORM WATER DRAINAGE SYSTEM OR RECEIVING WATER.
- CONTAIN AND SECURELY PROTECT STOCKPILED WASTE MATERIAL FROM WIND AND RAIN AT ALL TIMES UNLESS ACTIVELY BEING USED.
- IMPLEMENT PROCEDURES THAT EFFECTIVELY ADDRESS HAZARDOUS AND NON-HAZARDOUS SPILLS.
- DEVELOP A SPILL RESPONSE AND IMPLEMENTATION ELEMENT OF THE SWPPP PRIOR TO COMMENCEMENT OF CONSTRUCTION ACTIVITIES. EQUIPMENT AND MATERIALS FOR CLEANUP OF SPILLS SHALL BE AVAILABLE ON SITE AND THAT SPILLS AND LEAKS SHALL BE CLEANED UP IMMEDIATELY AND DISPOSED OF PROPERLY. APPROPRIATE SPILL RESPONSE PERSONNEL SHOULD BE ASSIGNED AND TRAINED.
- ENSURE THE CONTAINMENT OF CONCRETE WASHOUT AREAS AND OTHER WASHOUT AREAS THAT MAY CONTAIN ADDITIONAL POLLUTANTS SO THERE IS NO DISCHARGE INTO THE UNDERLYING SOIL AND ONTO THE SURROUNDING AREAS.
- PREVENT OIL, GREASE, OR FUEL FROM VEHICLE STORAGE OR MAINTENANCE FROM LEAKING INTO THE GROUND, STORM DRAINS OR SURFACE WATERS.
- PLACE ALL EQUIPMENT OR VEHICLES, WHICH ARE TO BE FUELED, MAINTAINED AND STORED IN A DESIGNATED AREA FITTED WITH APPROPRIATE BMP'S.
- CLEAN LEAKS IMMEDIATELY AND DISPOSE OF LEAKED MATERIALS PROPERLY.
- CONTAIN FERTILIZERS AND OTHER STOCKPILED LANDSCAPE MATERIALS SUCH AS MULCHES AND TOPSOIL WHEN THEY ARE NOT ACTIVELY BEING USED.
- DISCONTINUE THE APPLICATION OF ANY ERODIBLE LANDSCAPE MATERIAL WITHIN TWO DAYS BEFORE A FORECASTED RAIN EVENT OR DURING PERIODS OF PRECIPITATION.
- APPLY ERODIBLE LANDSCAPE MATERIAL AT QUANTITIES AND APPLICATION RATES ACCORDING TO MANUFACTURER RECOMMENDATIONS OR BASED ON WRITTEN SPECIFICATION BY KNOWLEDGEABLE AND EXPERIENCED FIELD PERSONNEL.
- STACK ERODIBLE LANDSCAPE MATERIAL ON PALLETIS AND COVER OR STORE SUCH MATERIALS WHEN NOT BEING USED OR APPLIED.
- CONDUCT AN ASSESSMENT AND CREATE A LIST OF POTENTIAL POLLUTANT SOURCES AND IDENTIFY ANY AREAS OF THE SITE WHERE ADDITIONAL BMP'S ARE NECESSARY TO REDUCE OR PREVENT POLLUTANTS IN STORM WATER DISCHARGES AND AUTHORIZED NON-STORM WATER DISCHARGES. KEEP THIS LIST WITH THE SWPPP AND IDENTIFY ALL NON-VISIBLE POLLUTANTS WHICH ARE KNOWN, OR SHOULD BE KNOWN, TO OCCUR ON THE CONSTRUCTION SITE.
- IMPLEMENT GOOD HOUSEKEEPING MEASURES ON THE CONSTRUCTION SITE TO CONTROL THE AIR DEPOSITION OF SITE MATERIALS AND FROM SITE OPERATIONS. SUCH PARTICULATES CAN INCLUDE, BUT ARE NOT LIMITED TO, SEDIMENT, NUTRIENTS, TRASH, METALS, BACTERIA, OIL, GREASE, AND ORGANICS.
- WASH VEHICLES IN SUCH A MANNER AS TO PREVENT NON-STORM WATER DISCHARGES TO SURFACE WATERS OR DRAINAGE SYSTEMS.
- CLEAN STREETS IN SUCH A MANNER AS TO PREVENT UNAUTHORIZED NON-STORM WATER DISCHARGES FROM REACHING SURFACE WATER OR DRAINAGE SYSTEMS.
- PROMOTE EFFECTIVE SOIL COVER FOR INACTIVE AREAS AND ALL FINISHED SLOPES, OPEN SPACE, UTILITY BACKFILL, AND COMPLETED LOTS.
- LIMIT THE USE OF PLASTIC MATERIALS WHEN MORE SUSTAINABLE, ENVIRONMENTALLY FRIENDLY ALTERNATIVES EXIST. WHERE PLASTIC MATERIALS ARE DEEMED NECESSARY, THE DISCHARGER SHALL CONSIDER THE USE OF PLASTIC MATERIALS RESISTANT TO SOLAR DEGRADATION.
- IMPLEMENT AND MAINTAIN EFFECTIVE PERIMETER CONTROLS AND STABILIZE ALL CONSTRUCTION ENTRANCES AND LOTS TO SUFFICIENTLY CONTROL EROSION AND SEDIMENT DISCHARGES FROM THE SITE.
- EFFECTIVELY MANAGE ALL RUN-ON, ALL RUNOFF WITHIN THE SITE AND ALL RUNOFF THAT DISCHARGES OFF THE SITE. RUN-ON FROM OFF SITE SHALL BE DIRECTED AWAY FROM ALL DISTURBED AREAS OR SHALL COLLECTIVELY BE IN COMPLIANCE WITH THE EFFLUENT LIMITATIONS.
- ALL INSPECTION, MAINTENANCE, REPAIR AND SAMPLING ACTIVITIES AT THE PROJECT LOCATION SHALL BE PERFORMED OR SUPERVISED BY A QUALIFIED SWPPP PRACTITIONER. THE QSP MAY DELEGATE ANY OR ALL OF THESE ACTIVITIES TO AN EMPLOYEE TRAINED TO DO THE TASK(S) APPROPRIATELY, BUT SHALL ENSURE ADEQUATE DEPLOYMENT.
- PERFORM WEEKLY INSPECTIONS AND OBSERVATIONS, AND AT LEAST ONCE EACH 24-HOUR PERIOD DURING EXTENDED STORM EVENTS TO IDENTIFY AND RECORD BMP'S THAT NEED MAINTENANCE TO OPERATE EFFECTIVELY, THAT HAVE FAILED, OR THAT COULD FAIL TO OPERATE AS INTENDED. INSPECTORS SHALL BE THE QSP OR TRAINED BY THE QSP. COMPLETE AN INSPECTION CHECKLIST INCLUDING REQUIRED INFORMATION FOR EACH INSPECTION.
- IMPLEMENT REPAIRS OR DESIGN CHANGES TO BMP'S WITHIN 72 HOURS OF IDENTIFICATION AND COMPLETE THE CHANGES AS SOON AS POSSIBLE.
- REFER TO STORM WATER POLLUTION PREVENTION PLAN FOR ADDITIONAL INFORMATION ON BMP'S USED FOR SITE.
- 100 PERCENT OF TREES, STUMPS, ROCKS AND ASSOCIATED VEGETATION AND SOILS RESULTING PRIMARILY FROM LAND CLEARING SHALL BE REUSED OR RECYCLED.
- THE CONTRACTOR, OWNER & SUB-CONTRACTORS (BUT NOT LIMITED TO) ARE RESPONSIBLE FOR SWPPP (STORM WATER POLLUTION PREVENTION PROGRAM), THE IMPLEMENTATIONS AND VIOLATIONS. THEY SHOULD BE TRAINED AS NEEDED BY THE QSP (QUALIFIED SWPPP PRACTITIONER) AND OR HIS DESIGNATED REPRESENTATIVE.
- ALL MATERIALS FOR THE PROJECT, INCLUDING THE NATIVE SOIL (SEDIMENT) ARE CONSIDERED POLLUTANTS. THE POLLUTANTS SHALL NOT LEAVE THE SITE VIA DRAINAGE, WHEEL TRACKING AND/OR BY WIND. ALL MATERIALS INCLUDING WASTE ARE TO LEAVE THE SITE IN ADEQUATELY CONTAINED CONTAINERS.
- ALL WASTE AND STORAGE CONTAINERS SHALL BE KEPT COVERED AT ALL TIMES TO PREVENT LEACHING OF THE WASTE & MATERIALS FROM ESCAPING THEIR CONTAINER AND ONTO THE SITE. HAZARDOUS WASTE(PAINTS, STAINS, GLUES, ADHESIVES, ETC) SHALL BE STORED IN COVERED AREAS WITH SECONDARY CONTAINMENT FOR LIQUID MATERIALS IN CASE OF ACCIDENTAL LEAKAGE/SPILLAGE.
- REFER TO THE SWPPP PLAN (THE BMP BINDER OR DOCUMENTS) FOR DETAILS ON BMP'S (BEST MANAGEMENT PRACTICES) USED FOR THE SITE. IT SHALL BE KEPT ON THE SITE AT ALL TIMES AND BE MADE AVAILABLE FOR THE QSP AND OTHERS INSPECTING THE SITE. A DIGITAL COPY CAN BE FOUND AT: [https://smarts.waterboards.ca.gov/smarts/faces/public/taAccess.jspx?\\_af100xample](https://smarts.waterboards.ca.gov/smarts/faces/public/taAccess.jspx?_af100xample).

SCHNOOR AVENUE

SCALE 1" = 40'

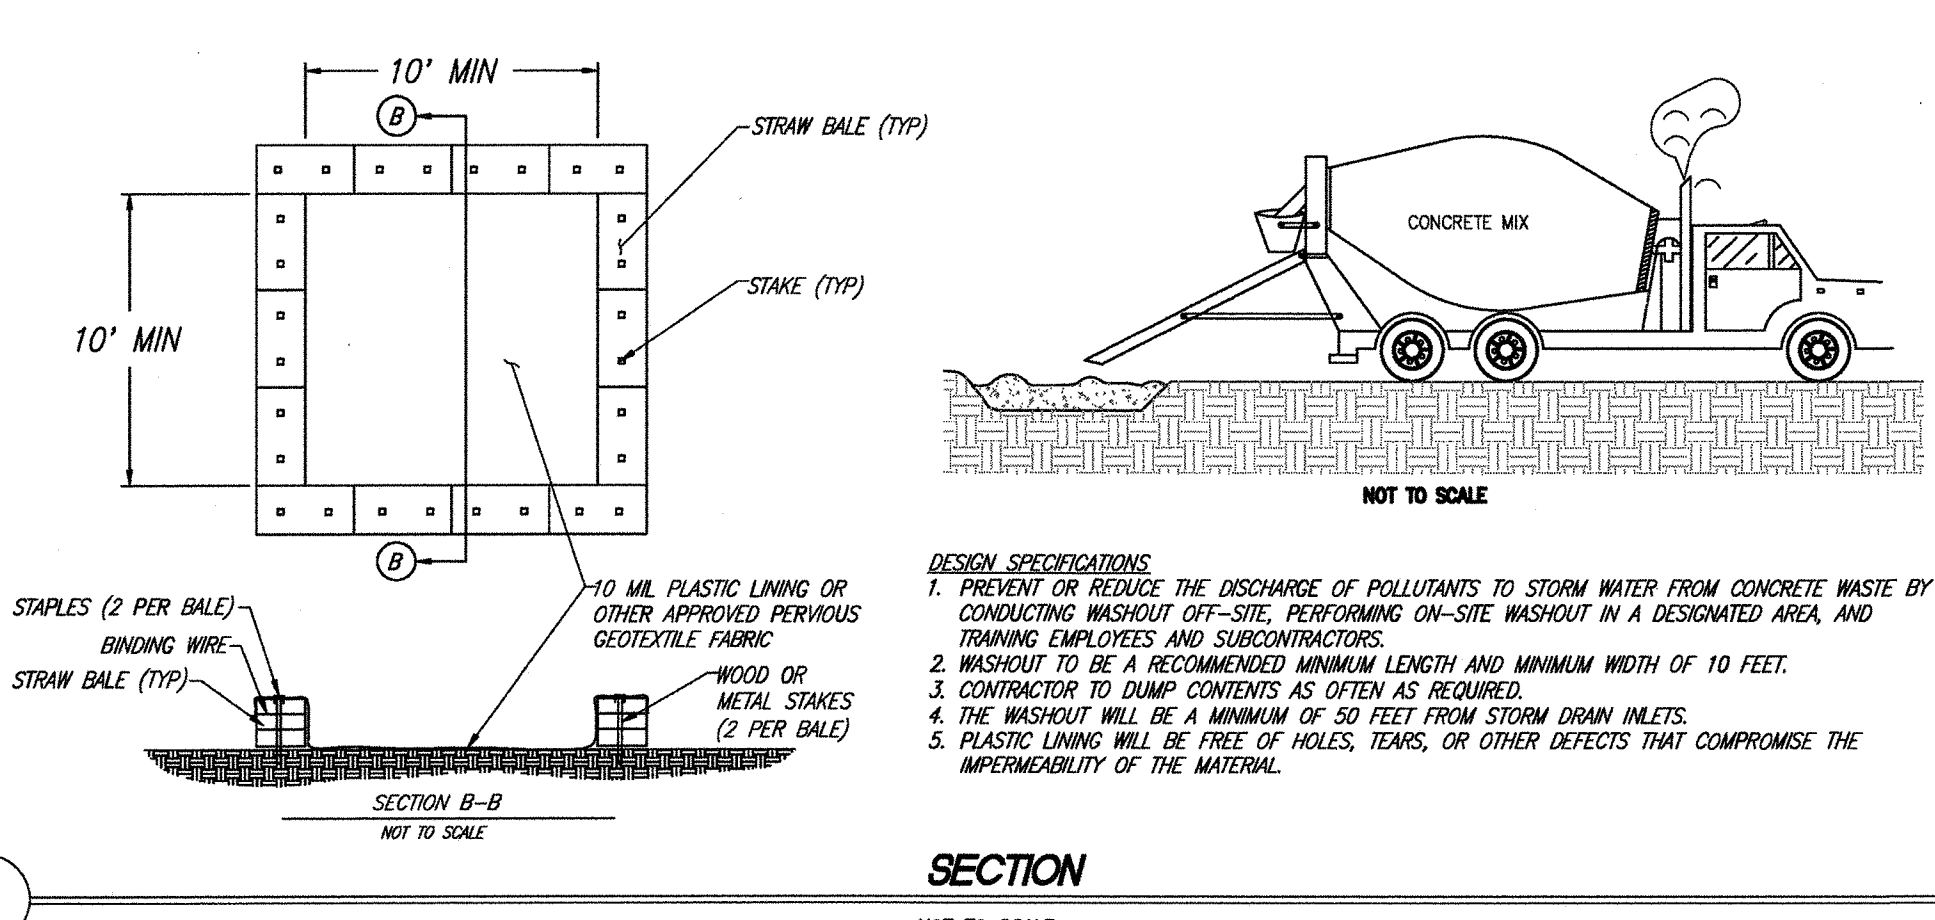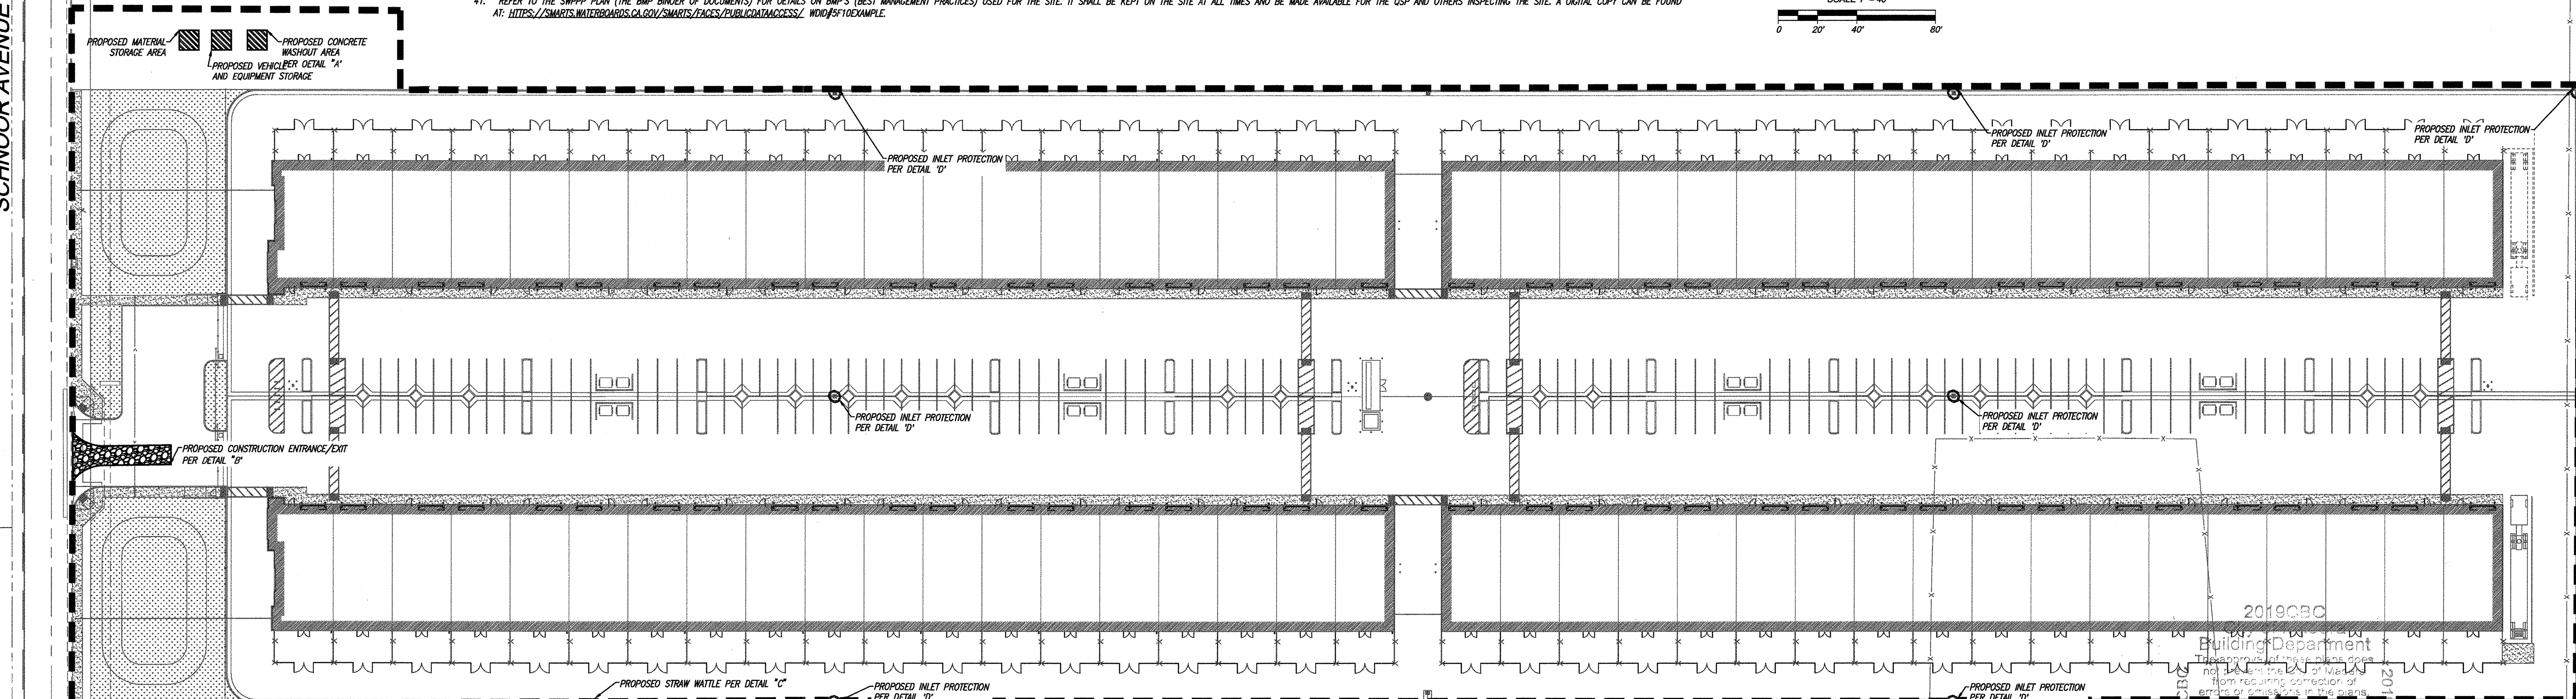

- DESIGN SPECIFICATIONS
- STONE APPLIED TO THE PAD WILL BE 2-INCH STONE.
  - THE LENGTH OF THE PAD WILL NOT BE LESS THAN 50 FEET.
  - THE THICKNESS OF THE PAD WILL A MINIMUM OF 8 INCHES.
  - THE WIDTH OF THE PAD WILL BE A MINIMUM OF 10 FEET.
  - FILTER FABRIC WILL BE PLACED OVER THE ENTIRE AREA BEFORE PLACING STONE.

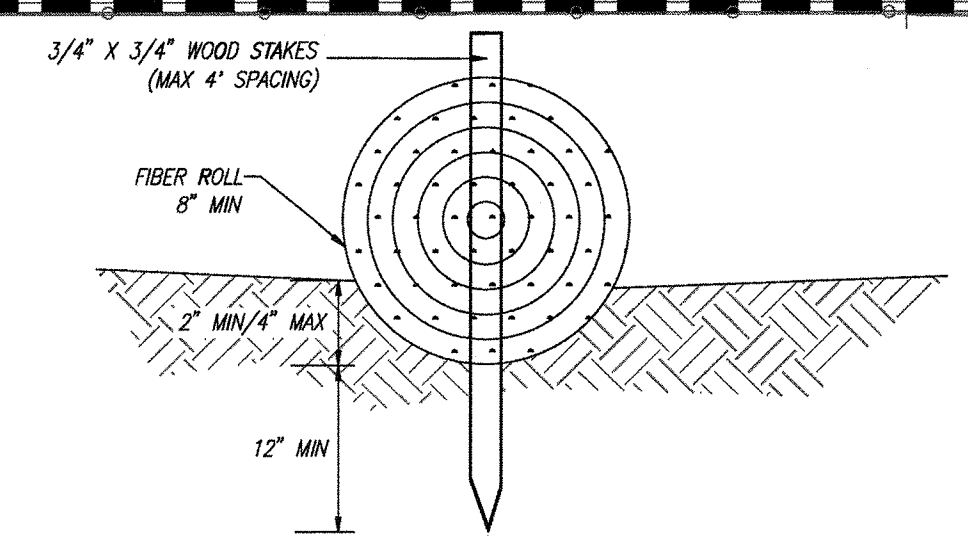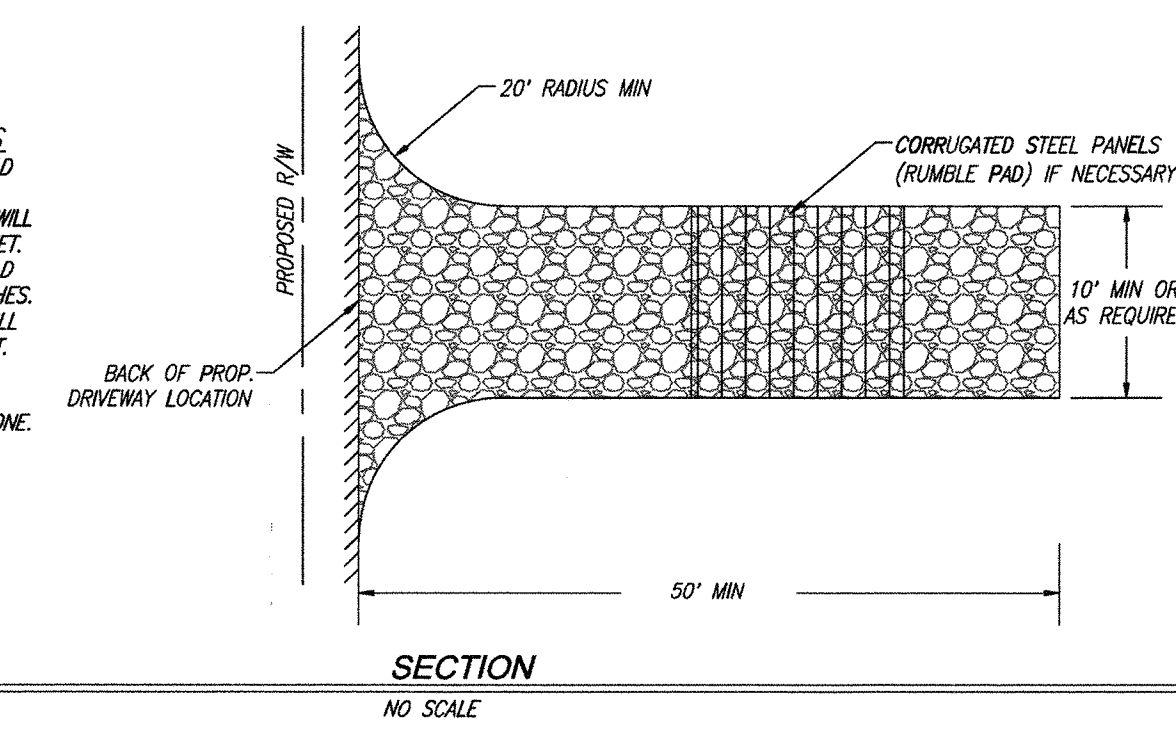

- DESIGN SPECIFICATIONS
- STRAW WATTLES (FIBER ROLLS) WILL BE EITHER PREFABRICATED ROLLS OR ROLLED TUBES OF GEOTEXTILE FABRIC.
  - FIBER ROLLED FIBER ROLL IS ASSEMBLED BY ROLLING THE LENGTH OF GEOTEXTILE FABRIC INTO A TUBE OF MINIMUM 8-INCH DIAMETER AND BINDING THE ROLL AT EACH END AND EVERY 4 FEET ALONG THE LENGTH OF THE ROLL WITH JUTE-TYPE TWINE.
  - PAKE FREE ANY DIRT CLOSING OR STANDING VEGETATION IN AREAS TO RECEIVE FIBER ROLLS.
  - PLACE FIBER ROLLS INTO A 2 TO 4 INCH DEEP TRENCH WITH A WIDTH EQUAL TO THE DIAMETER OF THE FIBER ROLL.
  - WALK ON TOP OF THE ROLL TO SEAT TIGHTLY AGAINST THE SOIL.
  - STAKE FIBER ROLLS INTO A 2 TO 4 INCH DEEP TRENCH WITH A WIDTH EQUAL TO THE DIAMETER OF THE FIBER ROLL.
  - USE WOOD STAKES WITH A NOMINAL CLASSIFICATION OF 0.75 X 0.75 INCH AND MINIMUM LENGTH OF 24 INCHES.
  - DRIVE STAKES AT THE END OF EACH FIBER ROLL AND SPACED 4 FEET MAXIMUM ON CENTER.
  - BERM THE BACKSIDE OF THE FIBER ROLL WITH SOIL TO ENSURE SEDIMENT ENTRAPMENT.

PRECISION  
CIVIL ENGINEERING, INC.

2019CBC  
Building Department  
APPROVED  
MAR 03 2022




CONSTRUCTION PLANS FOR  
SOUTH SCHNOOR AVENUE AND WEST ALMOND AVENUE  
EROSION CONTROL PLAN

CITY OF MADERA		SHEET C-5 OF C-5 SHEETS	
ENGINEERING DEPARTMENT 408 N. YOSEMITE AVENUE MADERA, CALIFORNIA 93638		DATE	
PLAN REVISION		APPROVAL	
INITIAL ISSUE DATE		CITY ENGINEER	
CHANGE		REVIEWED BY	
DATE		PUBLIC WORKS	
DATE		FIRE DEPARTMENT	
DATE		PARK DEPARTMENT	
DATE		DESIGNED BY: NMG	
DATE		DRAWN BY: CPG	
DATE		CHECKED BY:	
DATE		CONTRACTOR:	
DATE		PROJECT No. SPR 2021-24	








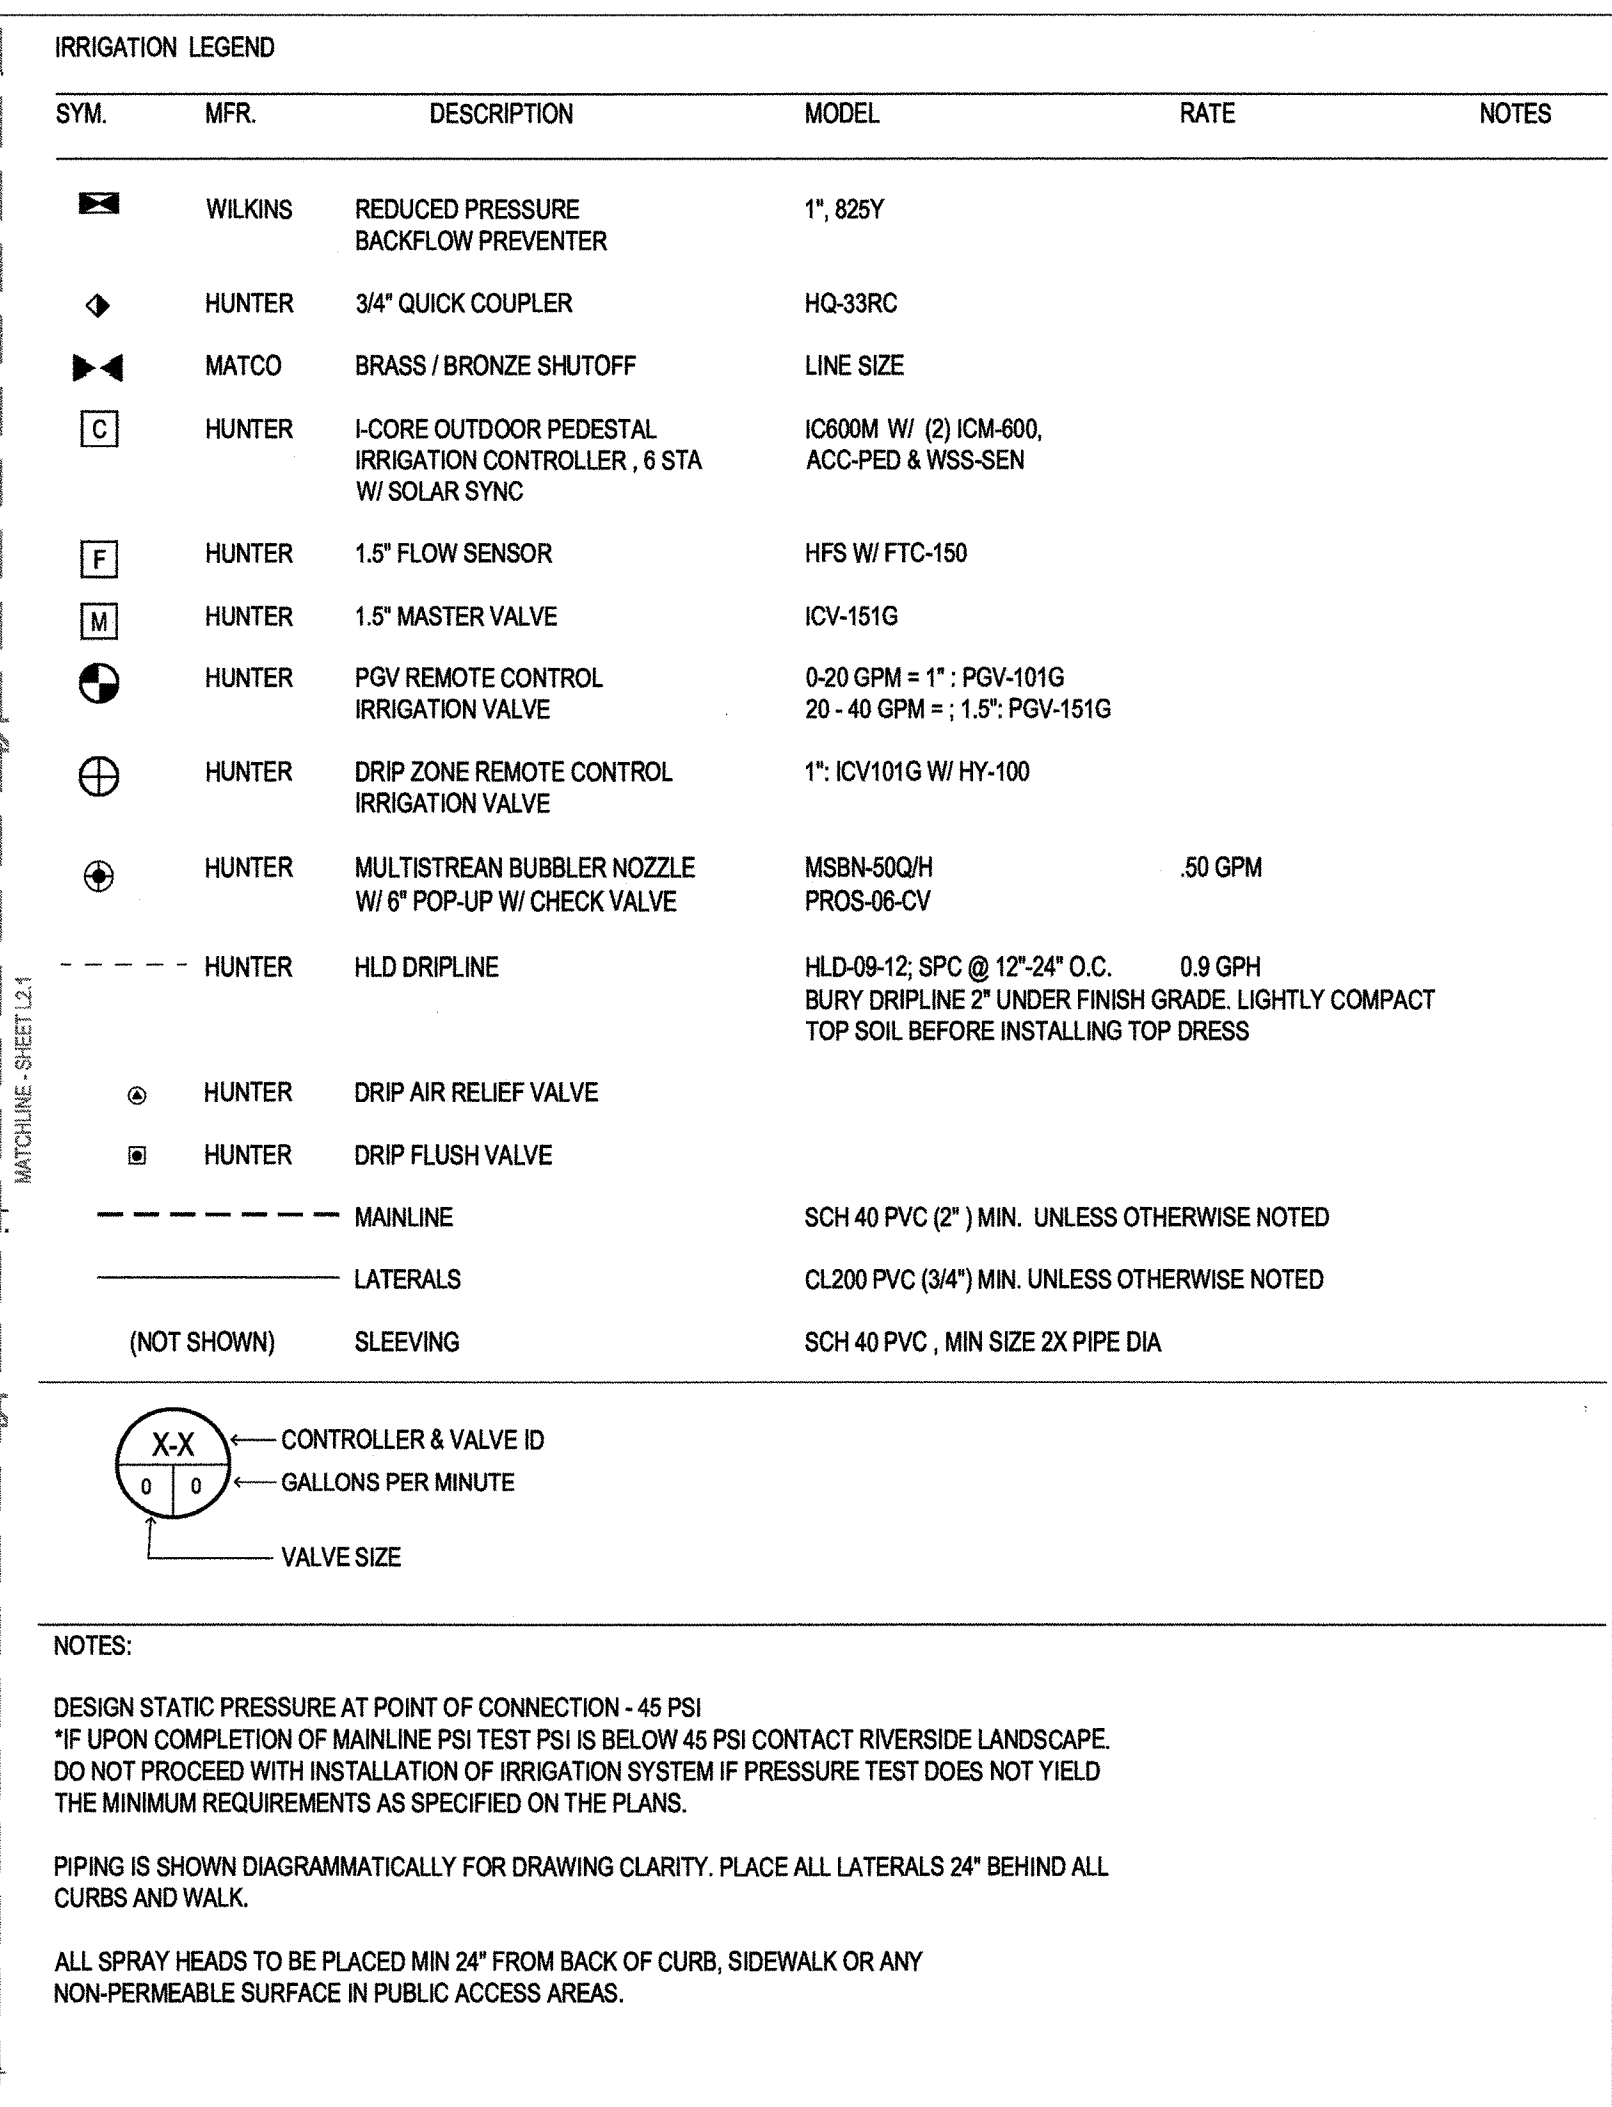

ALL SPRAY HEADS TO BE PLACED MIN 24" FROM BACK OF CURB, SIDEWALK OR ANY NON-PERMEABLE SURFACE IN PUBLIC ACCESS AREAS.


I HAVE COMPLIED WITH THE CRITERIA OF THE WATER EFFICIENT LANDSCAPE REQUIREMENTS ORDINANCE AND APPLIED THEM FOR THE EFFICIENT USE OF WATER IN THE IRRIGATION DESIGN AND PLANTING DESIGN PLAN

**UNDERGROUND  
SERVICE ALERT**  
of Northern California  
Call: TOLL FREE  
1-800-227-2600  
DAYS BEFORE YOU DIG

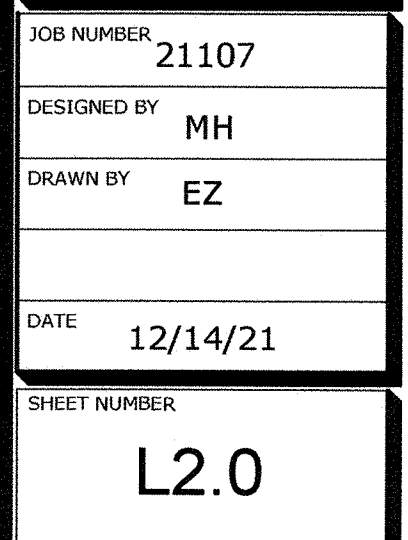




G:\Shared drives\DWG\Company\PROJECTS\2019\2019-05-04\2019-05-04.dwg 8/16/2021 11:48:50 AM

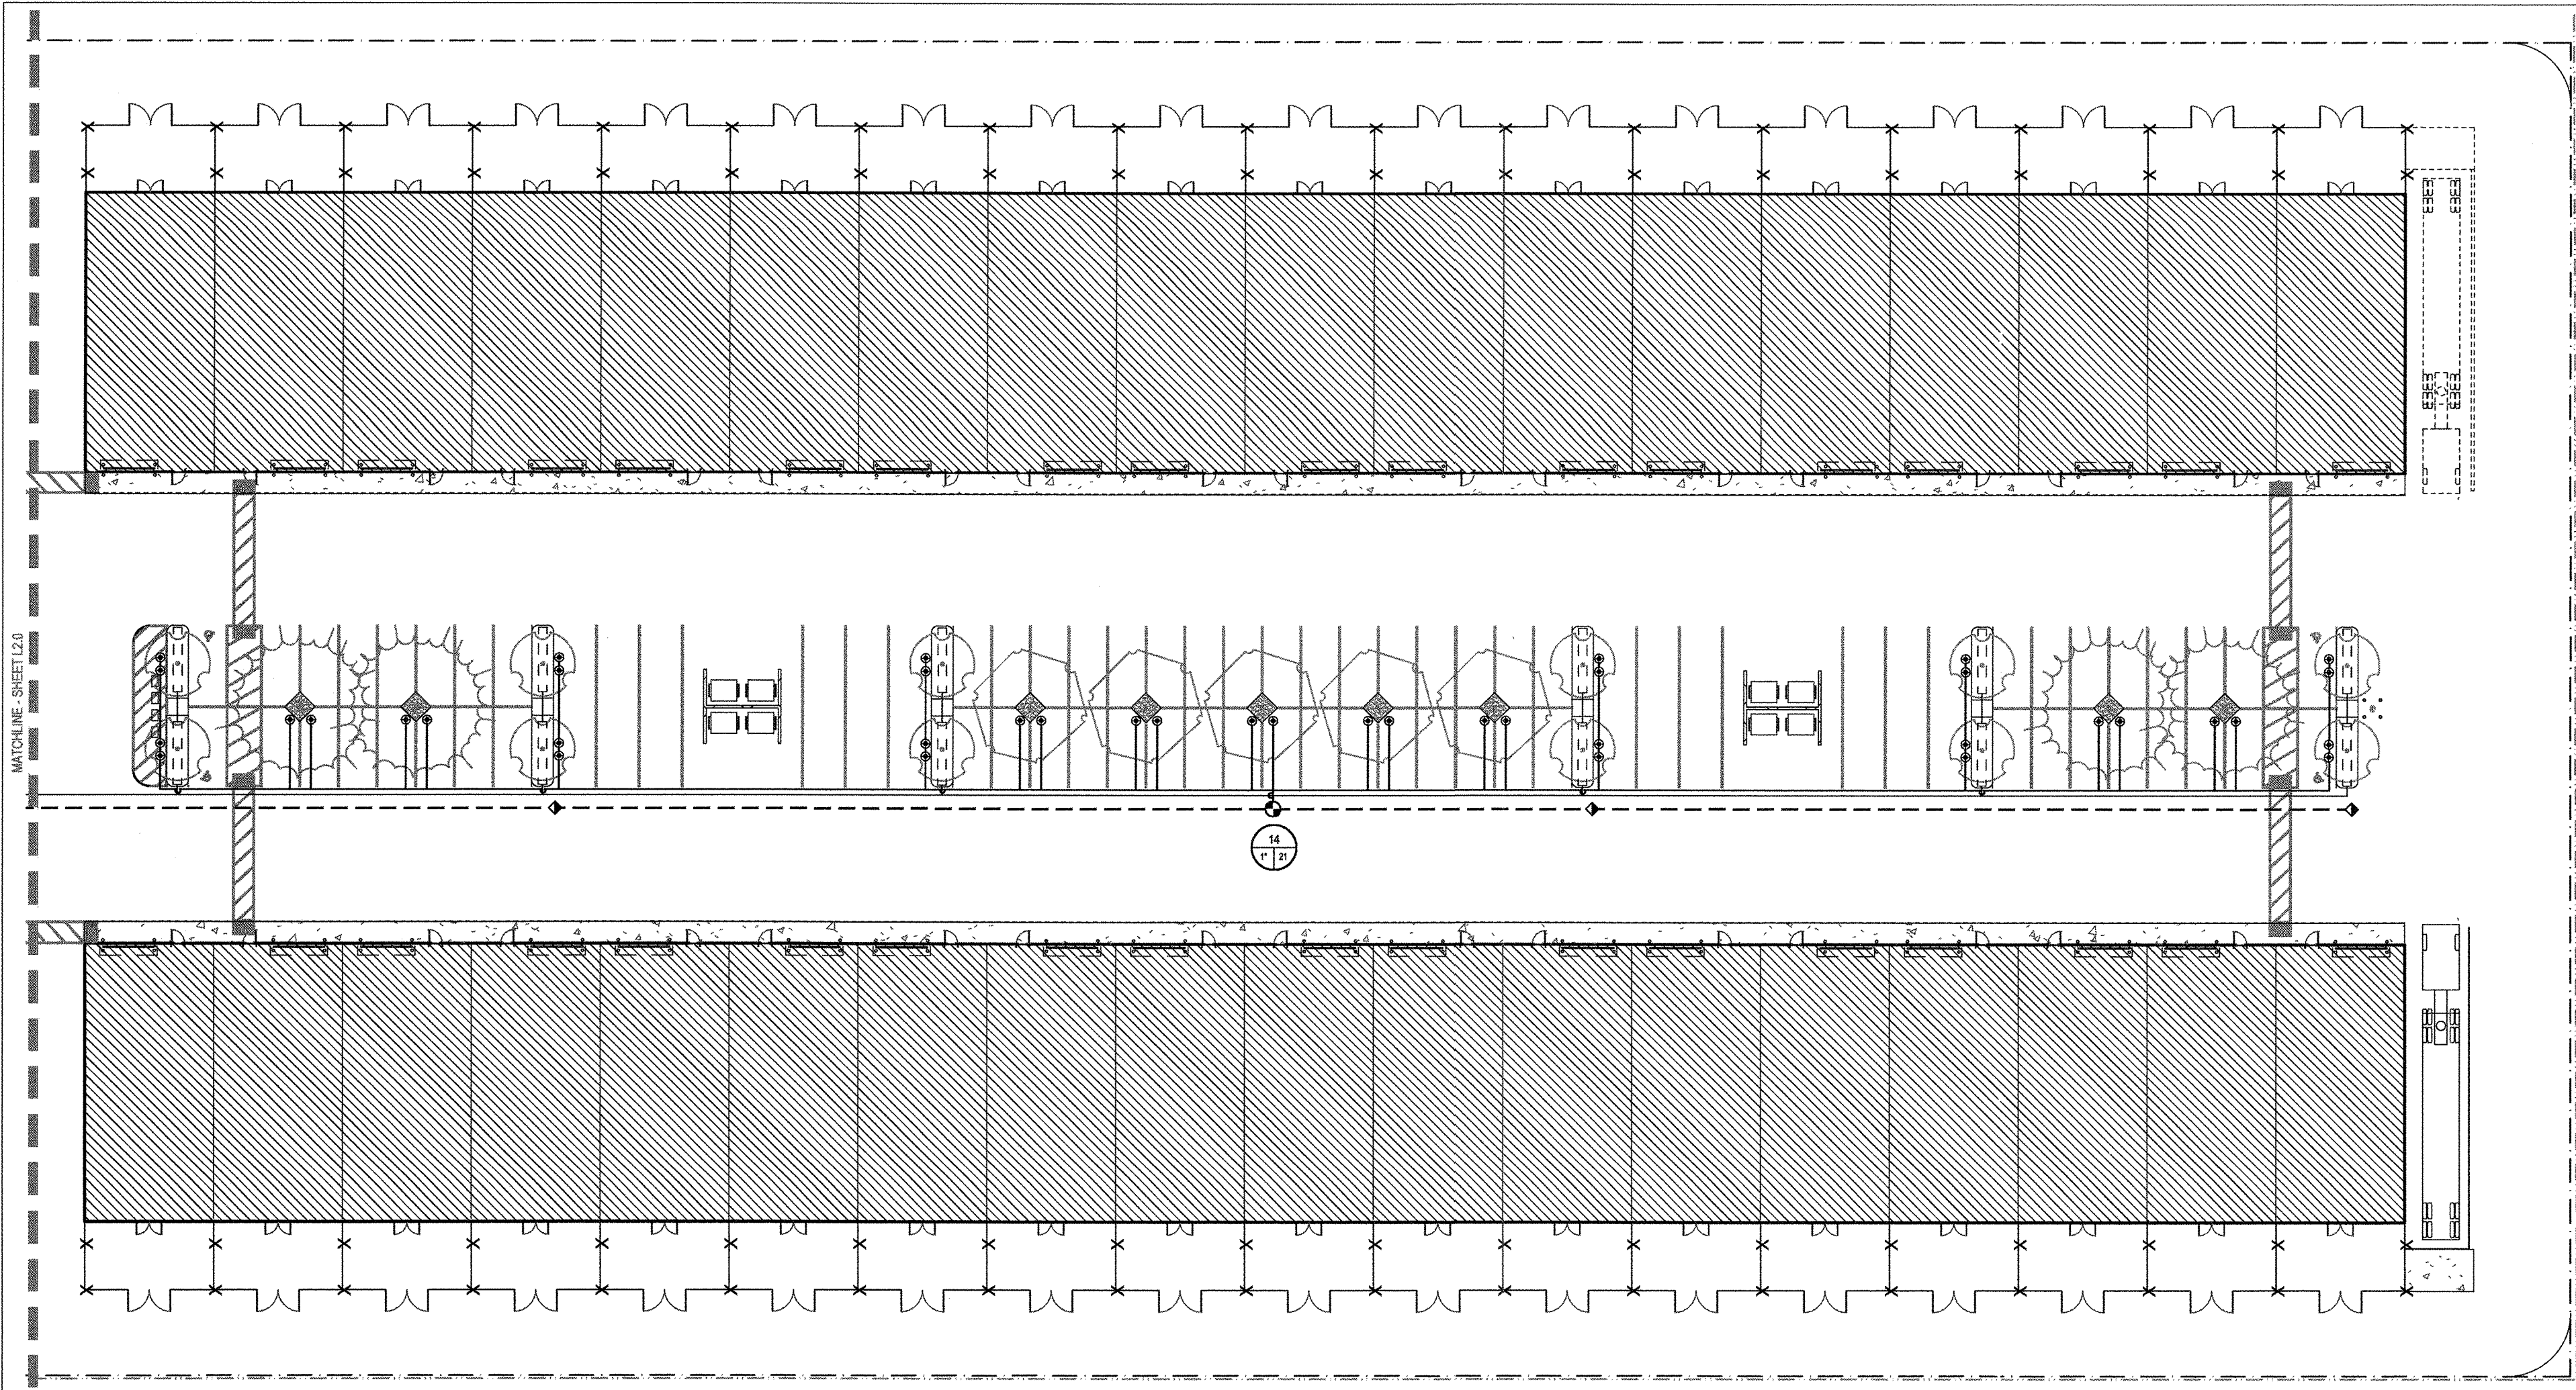

IRRIGATION LEGEND					
SYM.	MFR.	DESCRIPTION	MODEL	RATE	NOTES
⬮	WILKINS	REDUCED PRESSURE BACKFLOW PREVENTER	1", 825Y		
◊	HUNTER	3/4" QUICK COUPLER	HQ-33RC		
⬮	MATCO	BRASS / BRONZE SHUTOFF	LINE SIZE		
C	HUNTER	I-CORE OUTDOOR PEDESTAL IRRIGATION CONTROLLER, 6 STA W/ SOLAR SYNC	IC800M W/ (2) ICM-600, ACC-PED & WSS-SEN		
F	HUNTER	1.5" FLOW SENSOR	HFS W/ FTC-150		
M	HUNTER	1.5" MASTER VALVE	ICV-151G		
⊙	HUNTER	PGV REMOTE CONTROL IRRIGATION VALVE	0-20 GPM = 1"; PGV-101G 20 - 40 GPM = 1.5"; PGV-151G		
⊕	HUNTER	DRIP ZONE REMOTE CONTROL IRRIGATION VALVE	1"; ICV101G W/ HY-100		
⊕	HUNTER	MULTISTREAM BUBBLER NOZZLE W/ 6" POP-UP W/ CHECK VALVE	MSBN-50Q/H PROS-06-CV	.50 GPM	
---	HUNTER	HLD DRIPLINE	HLD-09-12, SPC @ 12"-24" O.C. BURY DRIPLINE 2" UNDER FINISH GRADE. LIGHTLY COMPACT TOP SOIL BEFORE INSTALLING TOP DRESS	0.9 GPH	
⊙	HUNTER	DRIP AIR RELIEF VALVE			
⊕	HUNTER	DRIP FLUSH VALVE			
---		MAINLINE	SCH 40 PVC (2" ) MIN. UNLESS OTHERWISE NOTED		
---		LATERALS	CL200 PVC (3/4") MIN. UNLESS OTHERWISE NOTED		
(NOT SHOWN)		SLEEVING	SCH 40 PVC, MIN SIZE 2X PIPE DIA		

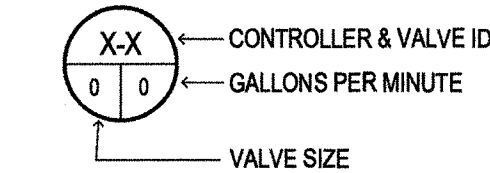

NOTES:

DESIGN STATIC PRESSURE AT POINT OF CONNECTION - 45 PSI  
\*IF UPON COMPLETION OF MAINLINE PSI TEST PSI IS BELOW 45 PSI CONTACT RIVERSIDE LANDSCAPE.  
DO NOT PROCEED WITH INSTALLATION OF IRRIGATION SYSTEM IF PRESSURE TEST DOES NOT YIELD THE MINIMUM REQUIREMENTS AS SPECIFIED ON THE PLANS.

PIPING IS SHOWN DIAGRAMMATICALLY FOR DRAWING CLARITY. PLACE ALL LATERALS 24" BEHIND ALL CURBS AND WALK.


ALL SPRAY HEADS TO BE PLACED MIN 24" FROM BACK OF CURB, SIDEWALK OR ANY NON-PERMEABLE SURFACE IN PUBLIC ACCESS AREAS.

I HAVE COMPLIED WITH THE CRITERIA OF THE WATER EFFICIENT LANDSCAPE REQUIREMENTS ORDINANCE AND APPLIED THEM FOR THE EFFICIENT USE OF WATER IN THE IRRIGATION DESIGN AND PLANTING DESIGN PLAN

SIGNATURE \_\_\_\_\_ LIC NO \_\_\_\_\_ DATE \_\_\_\_\_



SCALE: 1"=30'  
30' 0 30'

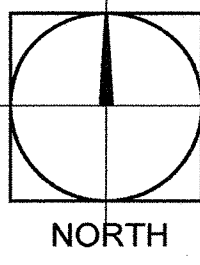

UNDERGROUND SERVICE ALERT  
of Northern California  
Call: TOLL FREE  
1-800-227-2600



BY \_\_\_\_\_  
REVISION \_\_\_\_\_  
DATE \_\_\_\_\_  
SEAL \_\_\_\_\_



IRRIGATION PLAN  
FOR  
LEASE FLEX. / WAREHOUSE BUILDINGS  
MADERA INDUSTRIAL WHSE, LLC  
S. SCHNOOR AVENUE, MADERA, CA

JOB NUMBER 21107

DESIGNED BY MH


DRAWN BY EZ

DATE 12/14/21

SHEET NUMBER

L2.1



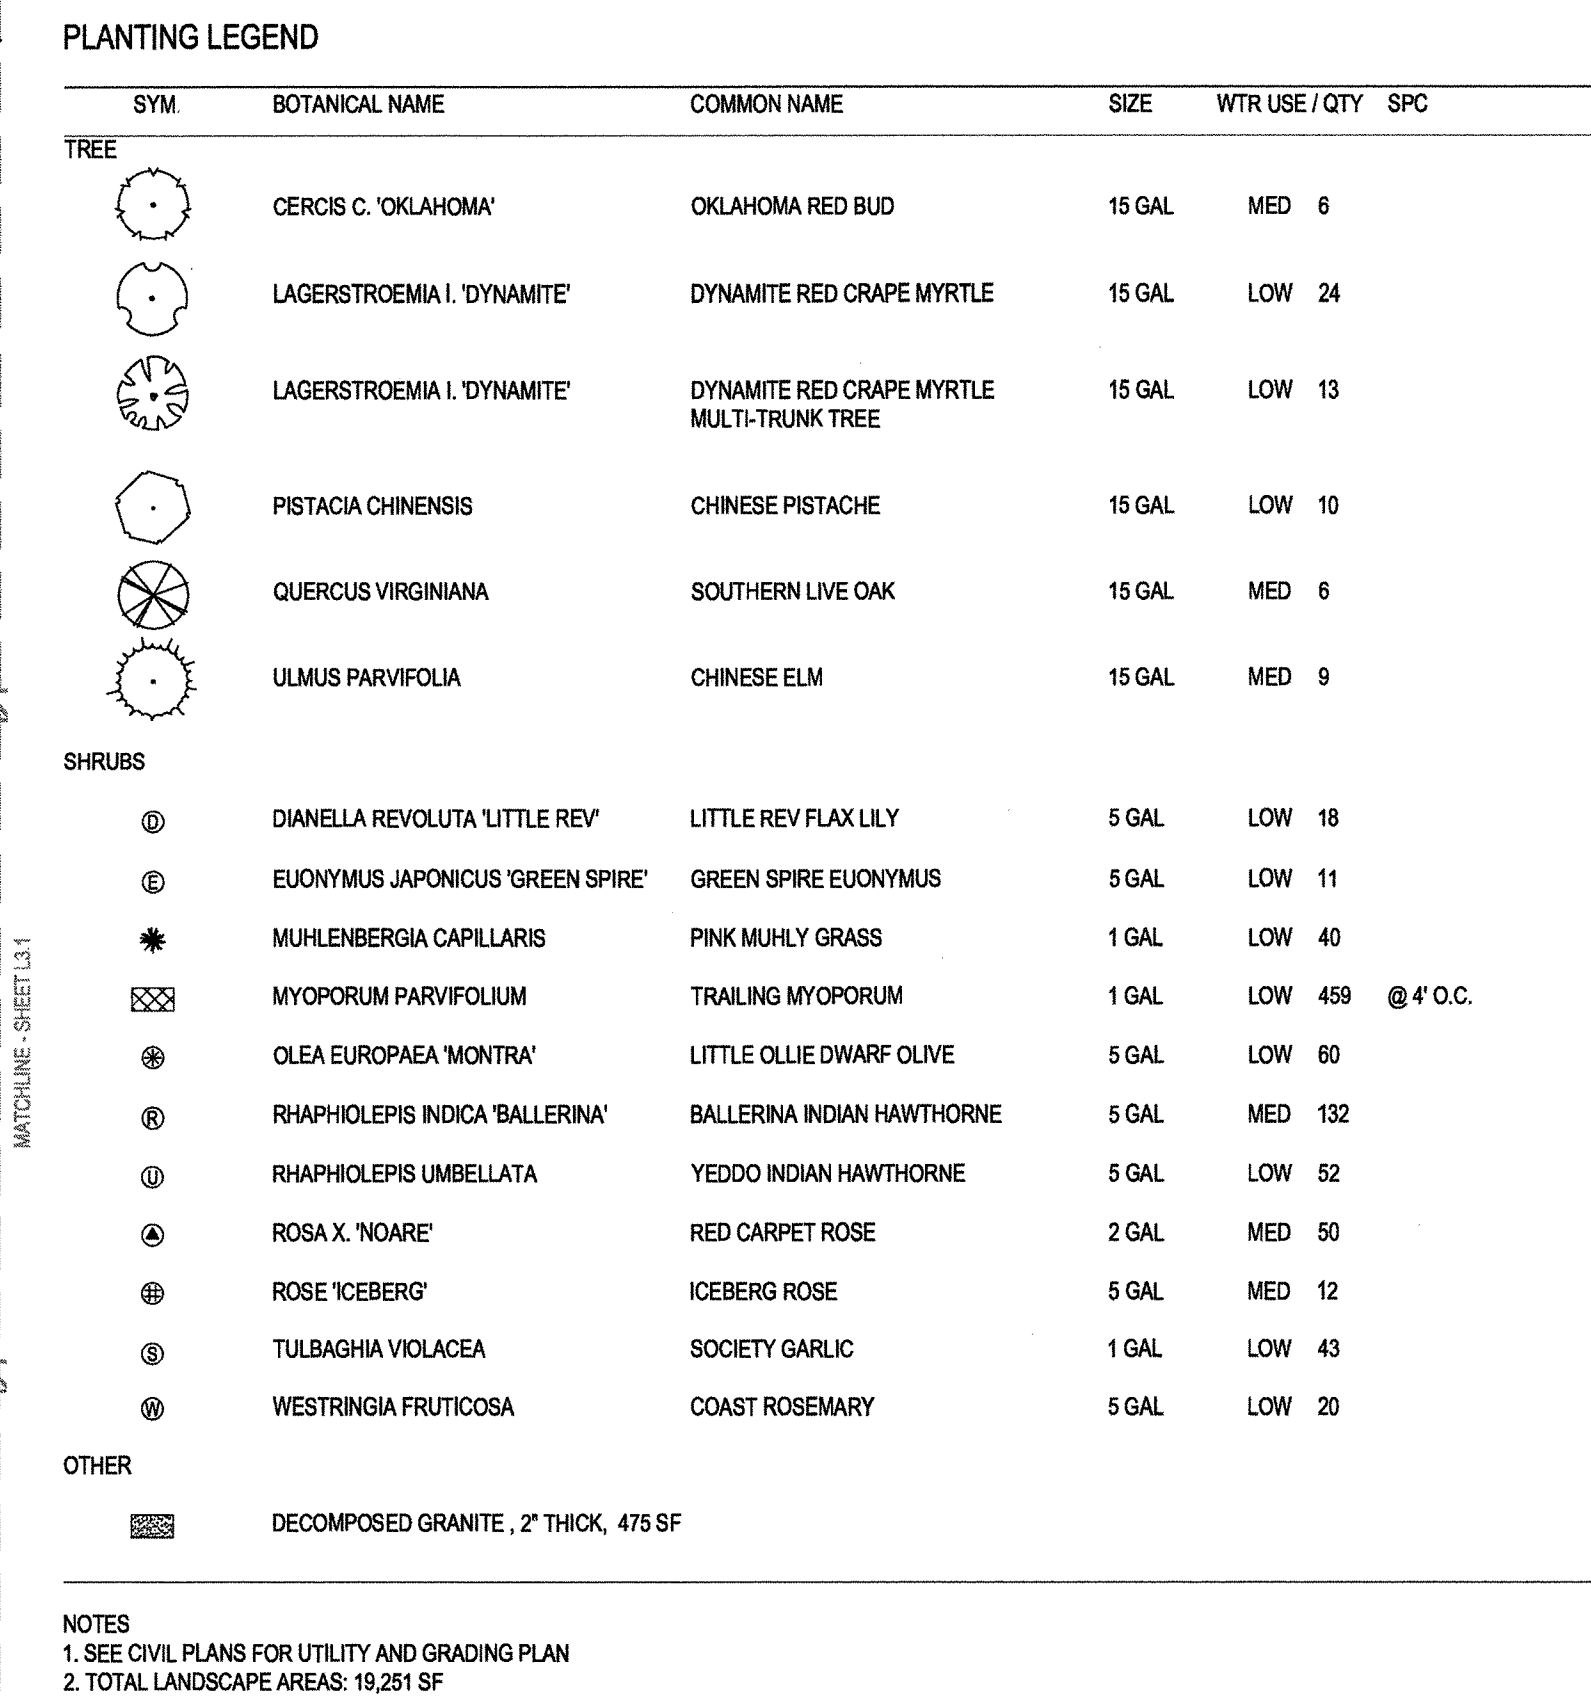

**DBKO**  
DESIGN BUILD  
LJC103228

**W H S**  
[PARTNERS]


DATE	REVISION	BY

ANY INFORMATION OR DATA ON THIS DRAWING IS NOT INTENDED TO BE SUITABLE FOR REUSE BY ANY PERSON, FIRM, CORPORATION, OR ANY OTHERS ON EXTENSIONS OF THIS PROJECT OR FOR ANY USE ON ANY OTHER PROJECT. ANY REUSE WITHOUT WRITTEN VERIFICATION AND ADAPTATION BY THE ENGINEER IS AT THE USER'S RISK.



[illegible]

58% of parking lot is shaded MORE than the required 50%

**84%** of landscape areas covered in vegetation is MORE than the required 75%

2019CBO  
City of Madera  
Building Department  
The approval of these plans does  
not prevent the City of Madera  
from requiring correction of  
errors or omissions in the plans,  
specifically in the construction.  
Subject to field corrections and  
approval of the Codes and  
Inspection Division  
**APPROVED**  
By:   
Date: MAR 03 2022

SIGNATURE	LIC NO	DATE
-----------	--------	------

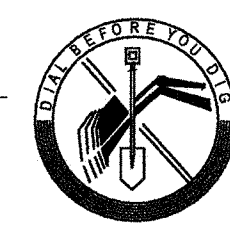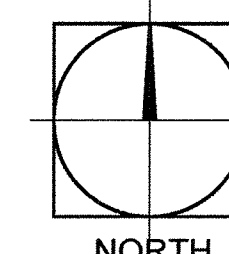


**UNDERGROUND  
SERVICE ALERT**  
of Northern California  
Call: TOLL FREE  
1-800-227-2600  
DAYS BEFORE YOU DIG

**PLANTING PLAN**  
LEASE FLEX. / WAREHOUSE BUILDINGS  
FOR  
MADERA INDUSTRIAL WHSE, LLC  
S. SCHNOOR AVENUE, MADERA, CA

JOB NUMBER	21107
DESIGNED BY	MH
DRAWN BY	EZ
DATE	12/14/21
SHEET NUMBER	L3.0




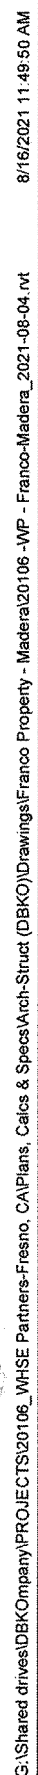

**DBKO**  
DESIGN BUILD  
JCE022223

**WHSE**  
[PARTNERS]

ANY INFORMATION OR DATA ON THIS DRAWING IS NOT INTENDED TO BE SUITABLE FOR RELIEF BY ANY PERSON, FIRM, CORPORATION, OR ANY OTHERS ON EXTENSIONS OF THIS PROJECT OR FOR ANY USE ON ANY OTHER PROJECT. ANY RELIEF WITHOUT WRITTEN VERIFICATION AND ADAPTATION BY THE ENGINEER FOR THE SPECIFIC PURPOSE INTENDED WILL BE AT THE USER'S SOLE RISK AND WITHOUT LIABILITY ON EQUAL EXPOSURE TO THE ENGINEER.



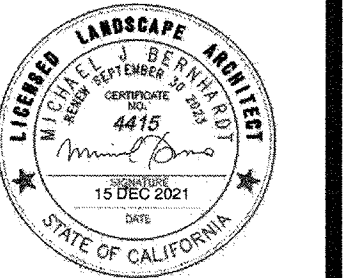


**LEASE FLEX. / WAREHOUSE BUILDINGS**  
FOR  
**MADERA INDUSTRIAL WHSE., LLC**  
S. SCHNOOR AVENUE, MADERA, CA

NUMBER	21107
IGNED BY	MH
OWN BY	EZ
E	12/14/21
ET NUMBER	L3.1




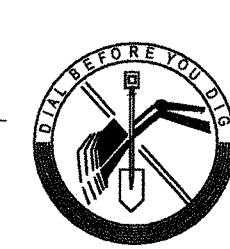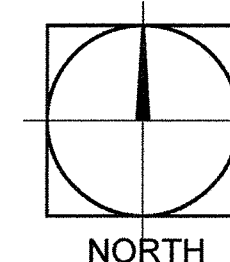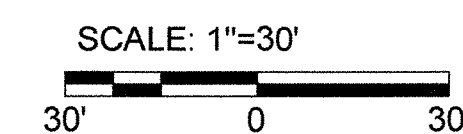


**UNDERGROUND  
SERVICE ALERT**  
of Northern California  
Call: TOLL FREE  
1-800-227-2600  
DAYS BEFORE YOU DIG








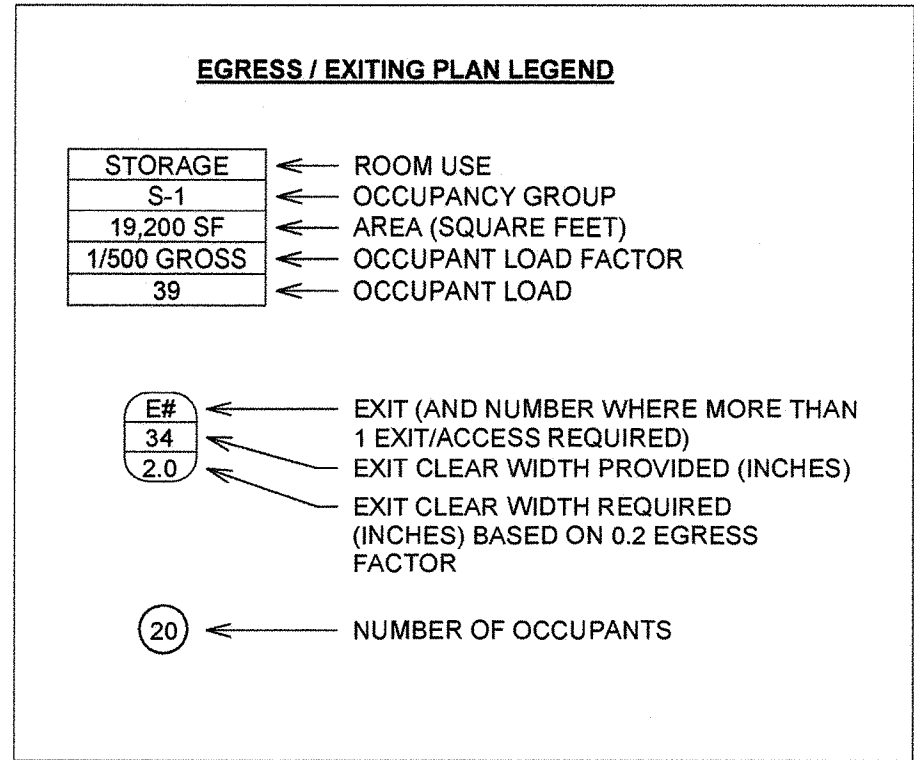

EXIT ACCESS TRAVEL DISTANCE SCHEDULE			
EGRESS PATH ID	OCCUPANT LOAD	TOTAL TRAVEL DISTANCE	ALLOWABLE TRAVEL DISTANCE
A	4	82.9'	250.0'

\*TOTAL TRAVEL DISTANCE IS LESS THAN 100.0' THEREFORE A SINGLE EXIT / EXIT ACCESS IS PERMITTED SINCE COMMON PATH OF EGRESS TRAVEL DISTANCE IS LESS THAN 100 FT. FOR A S-1/B OCCUPANCY W/ SPRINKLER SYSTEM (CBC TABLE 1006.2.1)

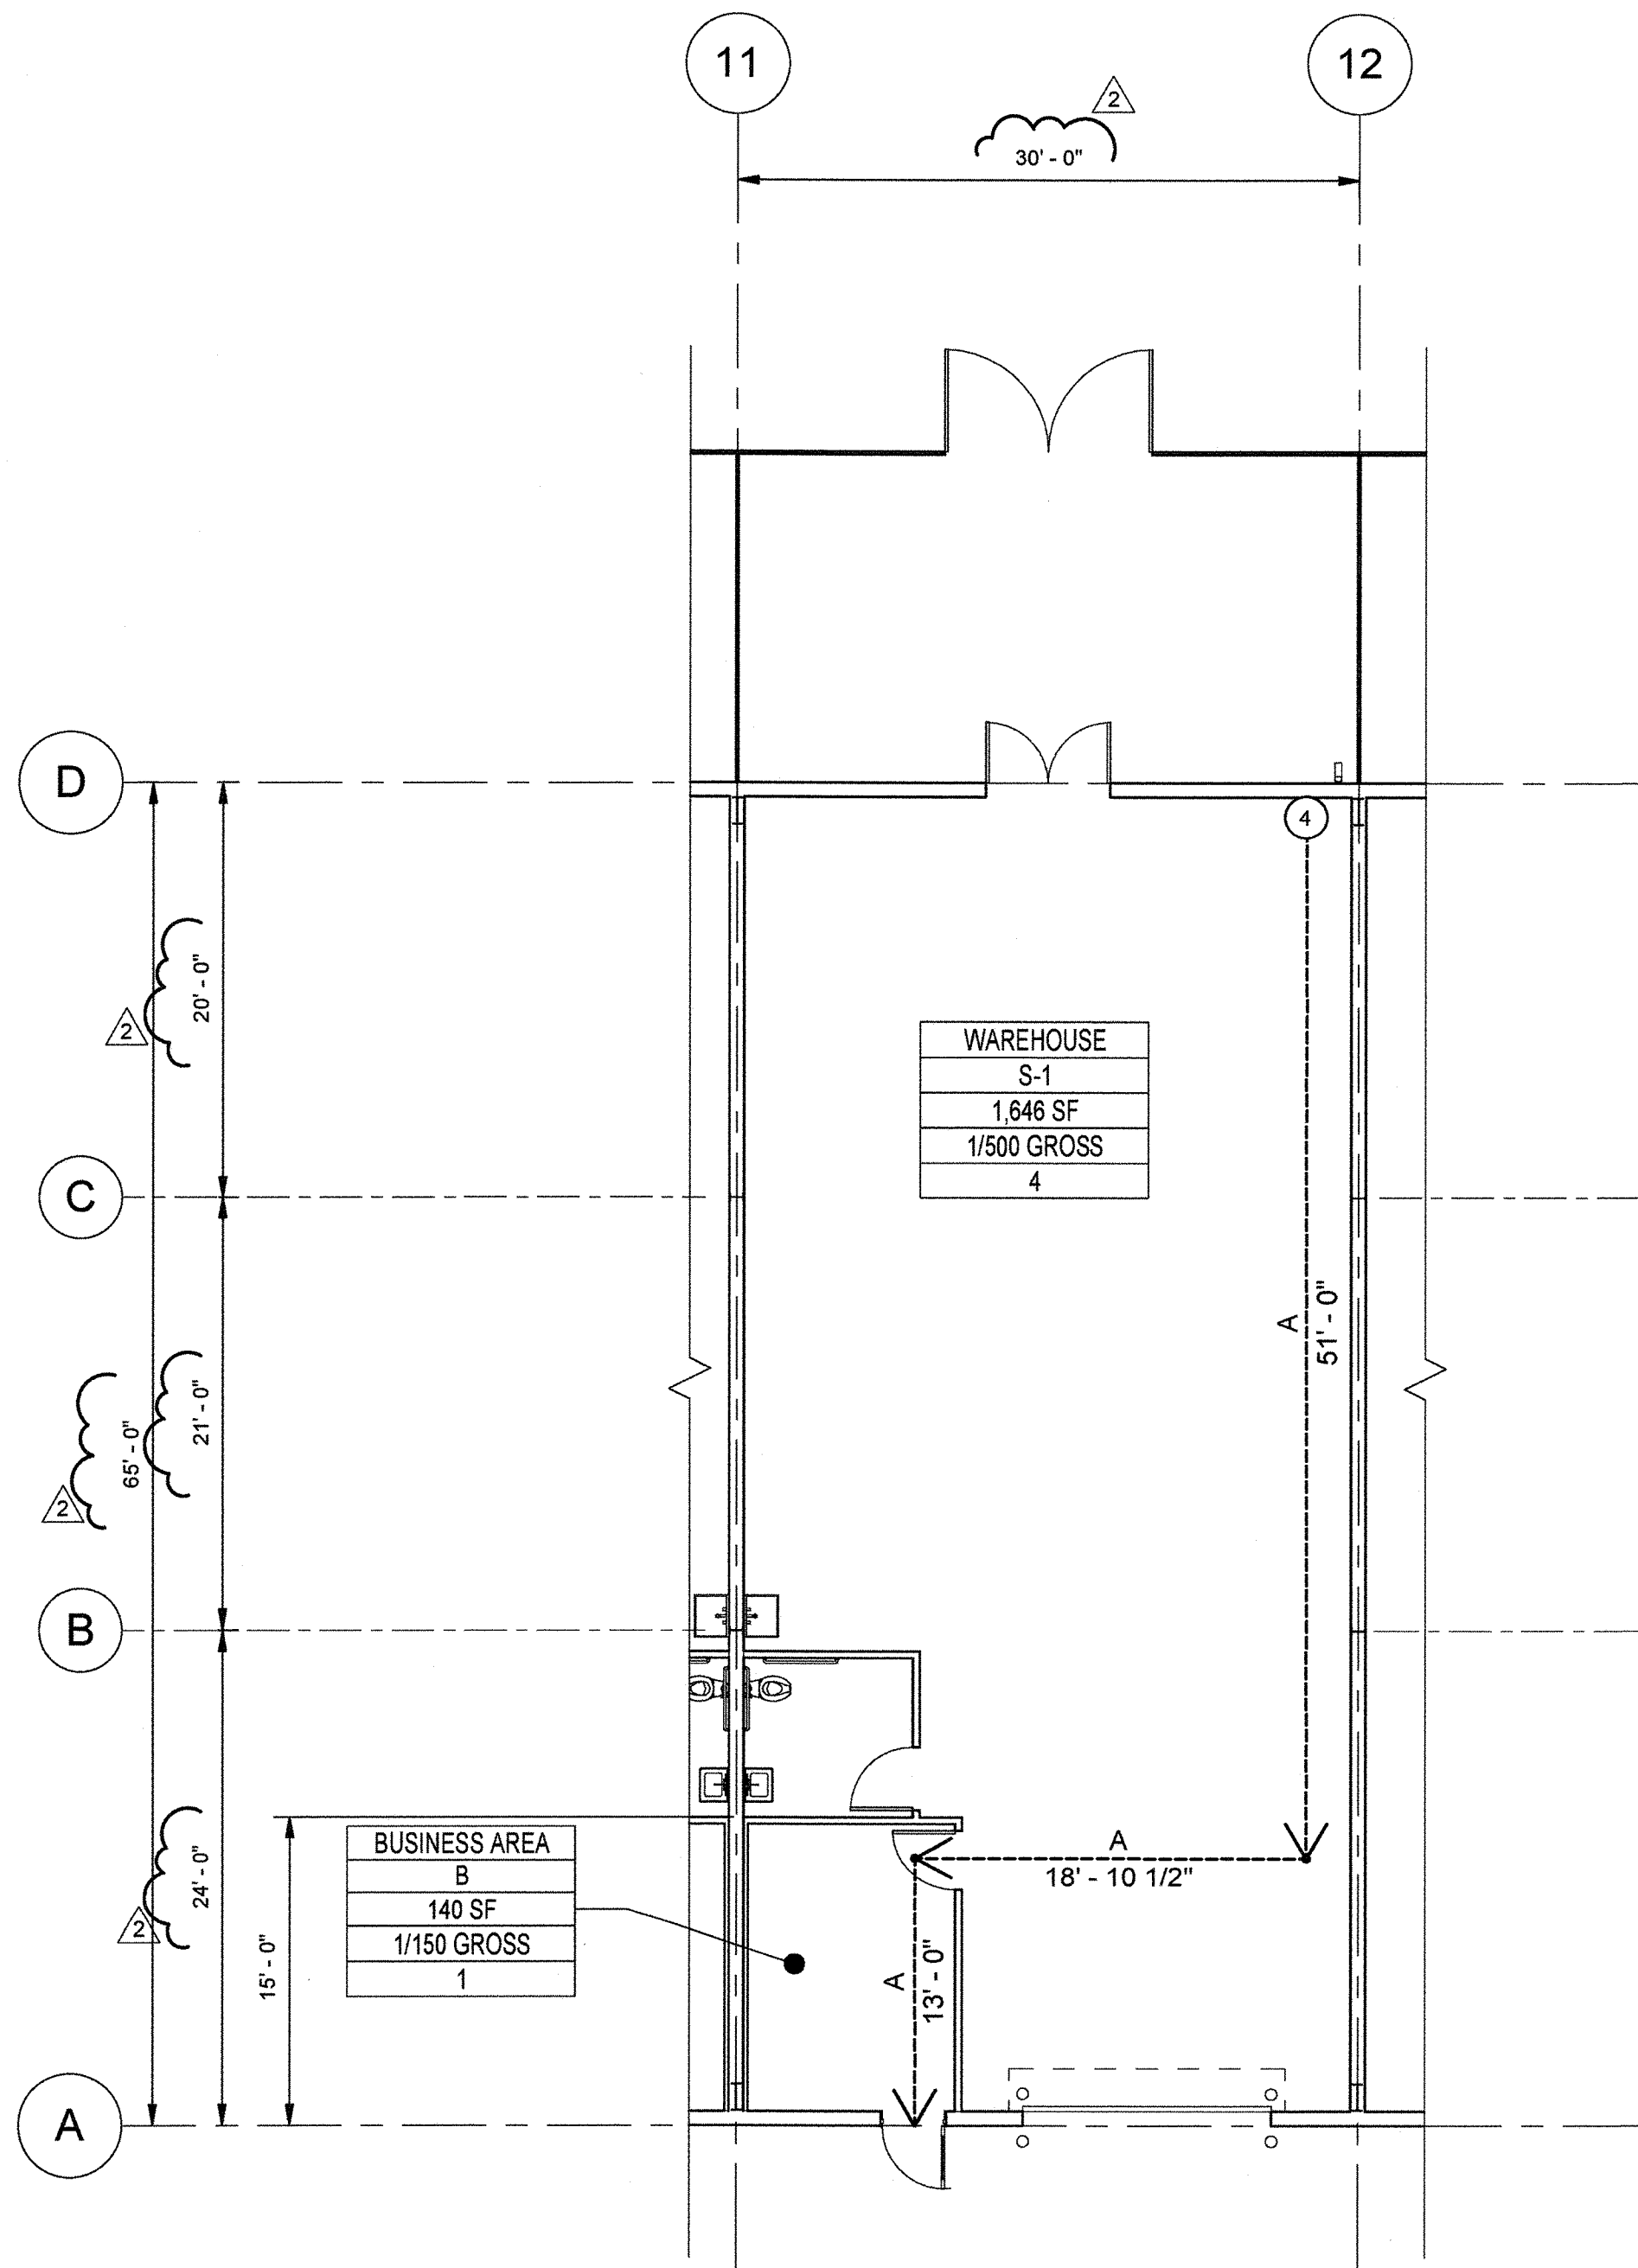

1 TYP. UNIT FLOOR PLAN - EGRESS / EXITING  
G1.0 1/8" = 1'-0"

## CODE ANALYSIS - NEW BUILDINGS

**APPLICABLE BUILDING CODES:**  
2019 CALIFORNIA BUILDING CODE  
2019 CALIFORNIA FIRE CODE  
2019 CALIFORNIA PLUMBING CODE  
2019 CALIFORNIA MECHANICAL CODE  
2019 CALIFORNIA ELECTRICAL CODE  
2019 CALIFORNIA ENERGY CODE

**TYPE OF CONSTRUCTION:**  
TYPE II-B, FULLY SPRINKLERED

**OCCUPANCY CLASSIFICATIONS:**  
NONSEPARATED OCCUPANCIES PER CBC 508.3:

S-1 (STORAGE) - FUTURE LEASE SPACES BY TENANTS W/ SMALL WAREHOUSING NEEDS (NO HIGH PILE STORAGE)  
B (OFFICE COMMERCIAL)

NOTE - NO PRODUCTS WILL BE STORED OR USED IN THE QUANTITIES EXCEEDED TABLE 307.1(1) OR TABLE 307.1(2) THAT WOULD REQUIRE ANY SPACES OF THIS BUILDING TO MEET H OCCUPANCY REQUIREMENTS.

**BUILDING AREA ALLOWABLE:**  
TABULAR ALLOWABLE AREA,  $A_t$  = 70,000 SF - S-1, SPRINKLERED ONE-STORY, TYPE II-B (CBC TABLE 506.2)

(FRONTAGE INCREASE CONSERVATIVELY NOT CONSIDERED)

**ACTUAL AREA PROVIDED:**

PROPOSED: 37,188 SF (BLDG. A)  
37,188 SF (BLDG. B)  
35,100 SF (BLDG. C)  
35,100 SF (BLDG. D)

**BUILDING HEIGHTS:**  
ALLOWABLE: 75' (CBC TABLE 504.3)

PROPOSED: 24' - 0" MAX. PARAPET HEIGHT

**OCCUPANT LOAD**  
PER EGRESS PLAN THIS SHEET

**EGRESS WIDTH**  
DOOR WIDTH = 0.2 x 34 TOTAL OCCUPANTS = 6.8" REQUIRED (1005.3.2) --> MIN. 34" DOOR OPENINGS USED

**MEANS OF EGRESS ILLUMINATION**  
ILLUMINATION LEVEL IS NOT TO BE LESS THAN 1 FOOTCANDLE AT THE WALKING SURFACE (1008.2).

EMERGENCY POWER - PROVIDE EMERGENCY POWER SYSTEM TO OPERATE THE EGRESS ILLUMINATION FOR A DURATION OF NOT LESS THAN 90 MINS (1008.3)

**EXIT SIGNS**  
EXIT AND EXIT ACCESS DOORS ARE TO BE MARKED BY AN APPROVED EXIT SIGN READILY VISIBLE FROM ANY DIRECTION OF APPROACH. LOCATE AS REQUIRED TO CLEARLY INDICATE THE DIRECTION OF EGRESS TRAVEL. PLACEMENT IS TO BE SUCH THAT NO POINT IN AN EXIT PASSAGE IS MORE THAN 100 FEET (OR LISTED VIEWING DISTANCE FOR SIGN IF LESS THAN 100 FEET) FROM THE NEAREST VISIBLE EXIT SIGN.

EXIT SIGNS SHALL BE INTERNALLY OR EXTERNALLY ILLUMINATED (1013.3) PER APPLICABLE SECTION (1013.5 OR 1013.6) AT ALL TIMES AND MEET EMERGENCY ILLUMINATION REQUIREMENTS AS APPLICABLE

**COMMON PATH OF EGRESS TRAVEL**  
SPRINKLER SYSTEM PROVIDED (CBC TABLE 1006.2.1)

MAXIMUM COMMON EGRESS PATH = 100 FT. (B / S OCCUPANCIES - SPRINKLERED)

**EXITS**  
FOR SPACES WITH OCCUPANT LOAD > 49 AND COMMON PATH OF EGRESS TRAVEL > 100' (CBC TABLE 1006.2.1), TWO EXITS/EXIT ACCESSES REQUIRED AND ARE TO REMAIN UNOBSTRUCTED AT ALL TIMES --> OCCUPANT LOAD IS LESS THAN 49 FOR EACH TENANT SPACE THEREFORE ONLY ONE EXIT IS REQUIRED

DOOR SWING IS TO BE IN THE DIRECTION OF EGRESS WHEN THE OCCUPANT LOAD FROM A BUILDING OR SPACE IS GREATER THAN 49 (CBC 1010.1.2.1)

**EXCEPTION 1 - EXIT SIGNS ARE NOT REQUIRED IN ROOMS OR AREAS THAT REQUIRE ONLY ONE EXIT OR EXIT ACCESS.**

**EXCEPTION 2 - MAIN EXTERIOR EXIT DOORS OR GATES THAT ARE OBVIOUSLY AND CLEARLY IDENTIFIABLE AS EXITS NEED NOT HAVE EXIT SIGNS WHERE APPROVED BY THE BUILDING OFFICIAL.**

**EXIT ACCESS TRAVEL DISTANCE**  
OCCUPANCY S-1 AND SPRINKLER SYSTEM PROVIDED (TABLE 1017.2)

MAXIMUM EXIT ACCESS TRAVEL DISTANCE PERMITTED = 250' (S-1 - FULLY SPRINKLERED) / 300' (B - FULLY SPRINKLERED)

**REQUIRED SEPARATION:**  
NONE REQUIRED

**FIRE RESISTANCE FOR EXTERIOR WALLS:**  
ALL WALLS GREATER THAN OR EQUAL TO 10' SEPARATION - NONE REQUIRED (TABLE 602)

**SMOKE AND HEAT VENTS**  
HIGH PILE COMBUSTIBLE STORAGE (SECTION 910.2.2)

--> NO HIGH PILED STORAGE PROPOSED IN THIS BUILDING.

**FIRE EXTINGUISHERS (CFC SECTION 906)**  
INSTALLED IN ACCORDANCE WITH NFPA 10 AND IFC 906.9

ORDINARY HAZARD --> PROVIDE MIN. 2-A-10-B-C RATED EXTINGUISHER AT MIN. OF MAXIMUM TRAVEL DISTANCE OF 75 FT OR 11,250 SF MAX. AREA (CFC TABLE 906.3(1))

STORE AND MOUNT IN NON-CORROSIVE ENVIRONMENT TO THE SATISFACTION OF THE FIRE MARSHALL ACCESSIBLE SO THAT THE TOP IS NO MORE THAN 5' ABOVE FINISHED FLOOR (FOR EXTINGUISHERS WEIGHING NO MORE THAN 40 LBS.) AND NO LESS THAN 4" CLEARANCE AT BASE (CBC 906.9). PROVIDE WEATHERPROOF CABINET AT EXTERIOR LOCATIONS.

AT OFFICE AND ADMIN AREAS WHERE WALLS ARE FINISHED WITH GYPBOARD, PROVIDED SEMI-RECESSED CABINET THAT PROTRUDES NO MORE THAN 4" OFF THE WALL SURFACE.

**INTERIOR FINISHES (CBC TABLE 803.9)**  
WALL AND CEILING RATINGS (S, B BUILDINGS - ROOMS AND ENCLOSED SPACES)

CLASS	MAX. FLAME SPREAD INDEX	MAX. SMOKE DEVELOPED INDEX
C	75 - 200	0 - 450

REQUIREMENTS OF SECTIONS 803.2 THRU 803.13 APPLY.



WHSE  
[PARTNERS]

BY	REVISION	DATE	PLAN CHECK RESPONSE
	2	11/17/2021	



**EGRESS PLAN AND CODE SUMMARY**  
LEASE FLEX. / WAREHOUSE BUILDINGS  
FOR  
MADERA INDUSTRIAL WHSE, LLC  
S. SCHNOOR AVENUE, MADERA, CA

JOB NUMBER	21107
DESIGNED BY	RT
DRAWN BY	LM
DATE	9/17/2021

SHEET NUMBER  
G1.0



11B-304 - TURNING SPACE

11B-304.1 - GENERAL  
TURNING SPACES SHALL COMPLY WITH SECTION 11B-304.

11B-304.2 - FLOOR OR GROUND SURFACES

FLOOR OR GROUND SURFACE OF A TURNING SPACE SHALL COMPLY WITH 11B-302. SEE 5  
G2.1  
CHANGES IN LEVEL ARE NOT PERMITTED (EXCEPT THAT SLOPES NOT STEEPER THAN 1:48 ARE PERMITTED).

11B-304.3 - SIZE

TURNING SPACE SHALL COMPLY WITH SECTION 11B-304.3.1 OR 11B-304.3.2.

11B-304.3.1 - CIRCULAR SPACE

THE TURNING SPACE SHALL BE A SPACE OF 60 INCHES DIAMETER MIN. THE SPACE IS PERMITTED TO INCLUDE KNEE AND TOE CLEARANCE COMPLYING WITH 11B-306 PER 10  
G2.1

11B-304.3.2 - T-SHAPED SPACE

THE TURNING SPACE SHALL BE A T-SHAPED SPACE WITHIN A 60 INCH SQUARE MIN. WITH ARMS AND BASE 36 INCHES WIDE MINIMUM. EACH ARM OF THE T SHALL BE CLEAR OF OBSTRUCTIONS 12 INCHES MIN. IN EACH DIRECTION AND THE BASE SHALL BE CLEAR OF OBSTRUCTIONS 24 INCHES MINIMUM. THE SPACE IS PERMITTED TO INCLUDE KNEE AND TOE CLEARANCE COMPLYING WITH 11B-306 ONLY AT THE END OF EITHER THE BASE OR ONE ARM.

11B-304.4 - DOOR SWING

DOORS SHALL BE PERMITTED TO SWING INTO TURNING SPACES

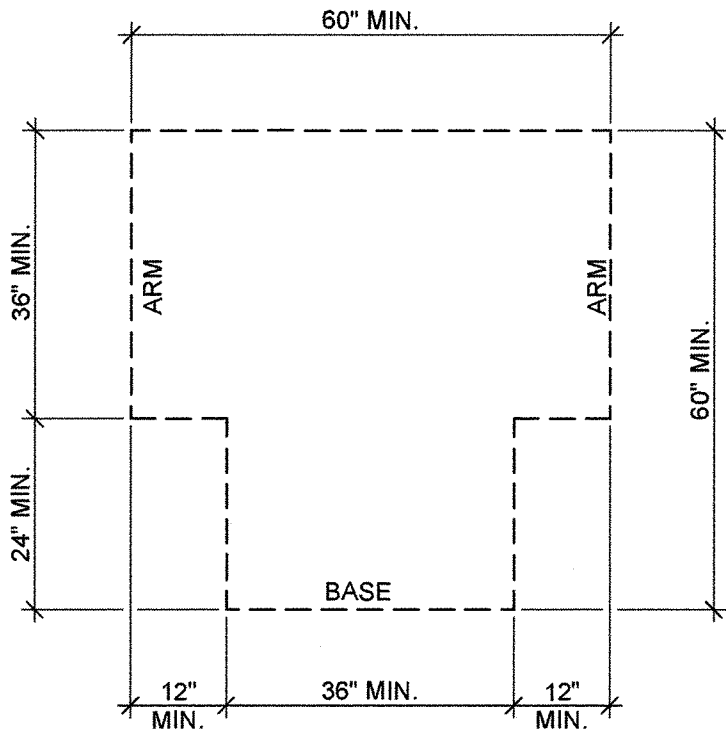


FIG. 11B-304.3.2 - T-SHAPED TURNING SPACE

11B-305 - CLEAR FLOOR OR GROUND SPACE

11B-305.1 - GENERAL  
CLEAR FLOOR OR GROUND SPACE SHALL COMPLY WITH SECTION 11B-305.

11B-305.2 - FLOOR OR GROUND SURFACES

FLOOR OR GROUND SURFACE OF A CLEAR FLOOR OR GROUND SPACE SHALL COMPLY WITH 11B-302. CHANGES IN LEVEL ARE NOT PERMITTED (EXCEPT THAT SLOPES NOT STEEPER THAN 1:48 ARE PERMITTED).

11B-305.3 - SIZE

THE CLEAR FLOOR OR GROUND SPACE SHALL BE 30 INCHES MIN. BY 48" MIN.

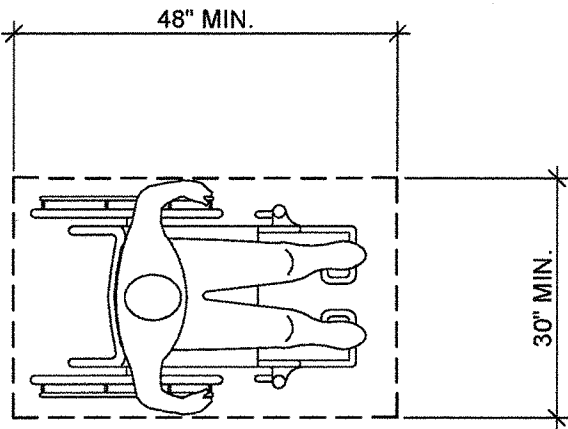


FIG. 11B-305.3 - CLEAR FLOOR OR GROUND SPACE

5  
G2.0  
ACCESSIBLE TURNING AND CLEAR FLOOR SPACES  
1/2" = 1'-0"

11B-307 - PROTRUDING OBJECTS

11B-307.2 - PROTRUSION LIMITS

OBJECTS WITH LEADING EDGES MORE THAN 27 INCHES AND NOT MORE THAN 80 INCHES ABOVE THE FINISHED FLOOR OR GROUND SHALL PROTRUDE 4 INCHES MAX. INTO THE CIRCULATION PATH (EXCEPT HANDRAILS SHALL BE PERMITTED TO PROTRUDE 4-1/2 INCHES MAX.)

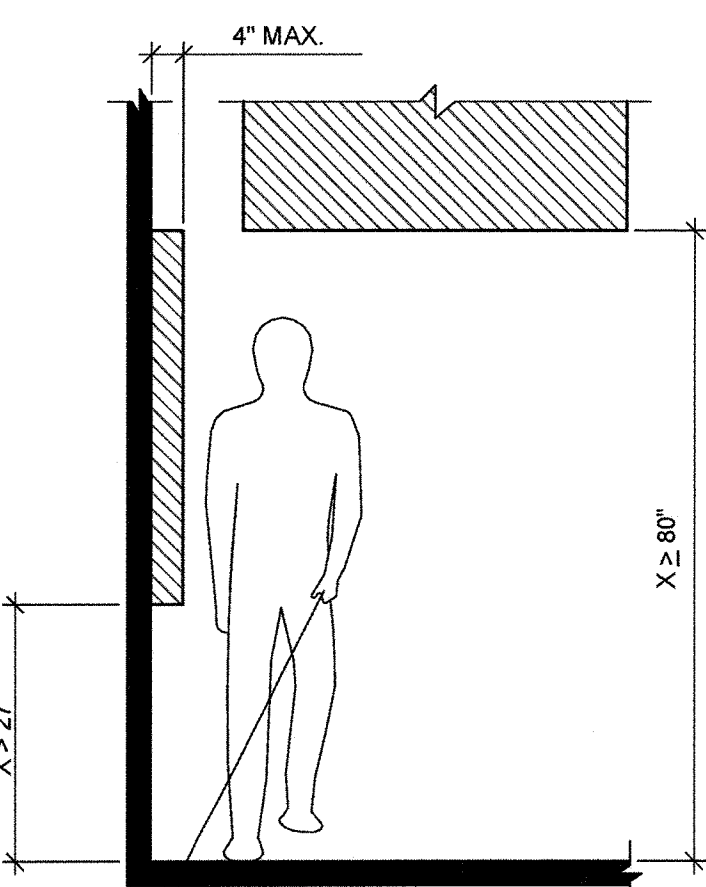


FIG. 11B-307.2 - LIMITS OF PROTRUDING OBJECTS

9  
G2.0  
WALL AND POST-MOUNTED PROTRUDING OBJECT REQUIREMENTS  
1/2" = 1'-0"

11B-305 - CLEAR FLOOR OR GROUND SPACE (CONT.)

11B-305.4 - KNEE AND TOE CLEARANCE

UNLESS OTHERWISE SPECIFIED, CLEAR FLOOR OR GROUND SPACE SHALL BE PERMITTED TO INCLUDE KNEE AND TOE CLEARANCE COMPLYING WITH SECTION 11B-306 PER 10  
G2.1

11B-305.5 - POSITION

UNLESS OTHERWISE SPECIFIED, CLEAR FLOOR OR GROUND SPACE SHALL BE POSITIONED FOR EITHER FORWARD OR PARALLEL APPROACH TO AN ELEMENT.

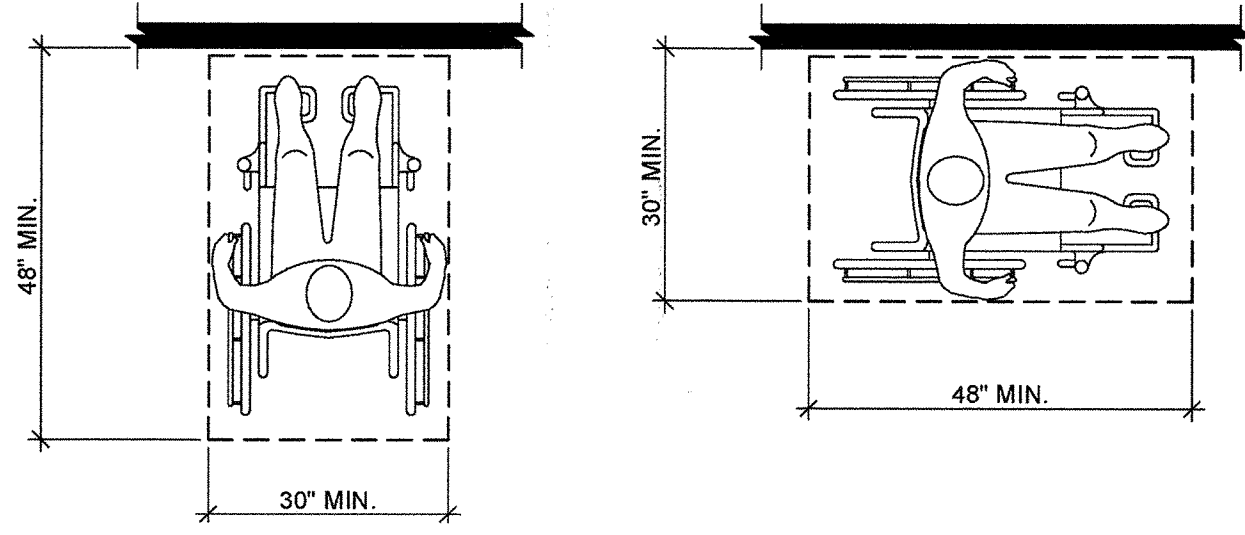


FIG. 11B-305.5 - POSITION OF CLEAR FLOOR OR GROUND SPACE

11B-305.6 - APPROACH

ONE FULL UNOBSTRUCTED SIDE OF THE CLEAR FLOOR OR GROUND SPACE SHALL ADJOIN AN ACCESSIBLE ROUTE OR ADJOIN ANOTHER CLEAR FLOOR OR GROUND SPACE. CLEAR FLOOR OR GROUND SPACE MAY OVERLAP AN ACCESSIBLE ROUTE, UNLESS SPECIFICALLY PROHIBITED ELSEWHERE IN CHAPTER 11B.

11B-305.7 - MANEUVERING CLEARANCE

WHERE A CLEAR FLOOR OR GROUND SPACE IS LOCATED IN AN ALCOVE OR OTHERWISE CONFINED ON ALL OR PART OF THREE SIDES, ADDITIONAL MANEUVERING CLEARANCE SHALL BE PROVIDED IN ACCORDANCE WITH SECTIONS 11B-305.7.1 AND 11B-305.7.2.

11B-305.7.1 - FORWARD APPROACH

ALCOVES SHALL BE 36 INCHES WIDE MIN. WHERE THE DEPTH EXCEEDS 24 INCHES.

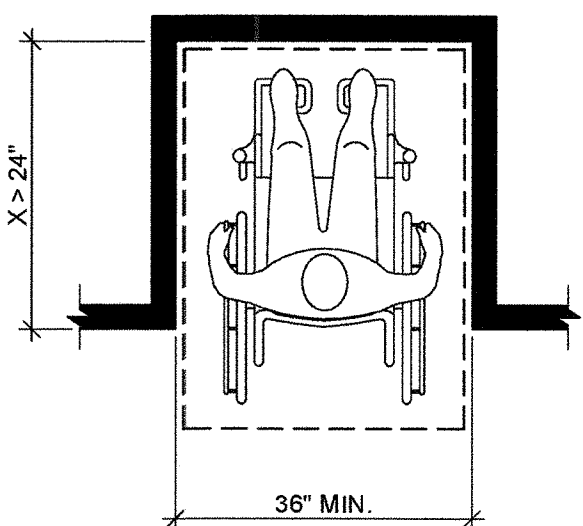


FIG. 11B-305.7.1 - MANEUVERING CLEARANCE IN AN ALCOVE, FORWARD APPROACH

11B-305.7.2 - PARALLEL APPROACH

ALCOVES SHALL BE 60 INCHES WIDE MIN. WHERE THE DEPTH EXCEEDS 15 INCHES.

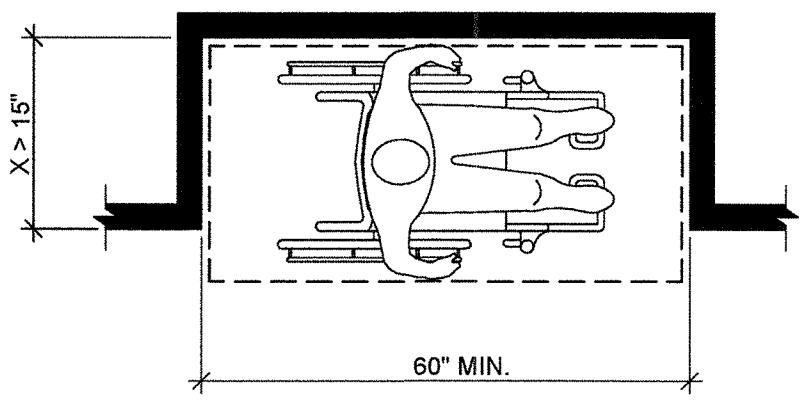


FIG. 11B-305.7.2 - MANEUVERING CLEARANCE IN AN ALCOVE, PARALLEL APPROACH

11B-307.3 - POST-MOUNTED OBJECTS

FREE-STANDING OBJECTS MOUNTED ON POSTS OR PYLONS SHALL OVERHANG CIRCULATION PATHS 12 INCHES MAX. WHEN LOCATED 27 INCHES MIN. AND 80 INCHES MAX. ABOVE THE FINISHED FLOOR OR GROUND. WHERE A SIGN OR OTHER OBSTRUCTION IS MOUNTED BETWEEN POSTS OR PYLONS AND THE CLEAR DISTANCE BETWEEN THE POSTS OR PYLONS IS GREATER THAN 12 INCHES, THE LOWEST EDGE OF SUCH SIGN OR OBSTRUCTION SHALL BE 27 INCHES MAX. OR 80 INCHES MIN. ABOVE THE FINISHED FLOOR OR GROUND.

11B-307.3.1 - EDGES AND CORNERS

WHERE SIGNS OR OTHER OBJECTS ARE MOUNTED ON POSTS OR PYLONS, AND THEIR BOTTOM EDGES ARE LESS THAN 80 INCHES ABOVE THE FLOOR OR GROUND SURFACE, THE EDGES OF SUCH SIGNS AND OBJECTS SHALL BE ROUNDED OR EASED AND THE CORNERS SHALL HAVE A MINIMUM RADIUS OF 1/8 INCH.

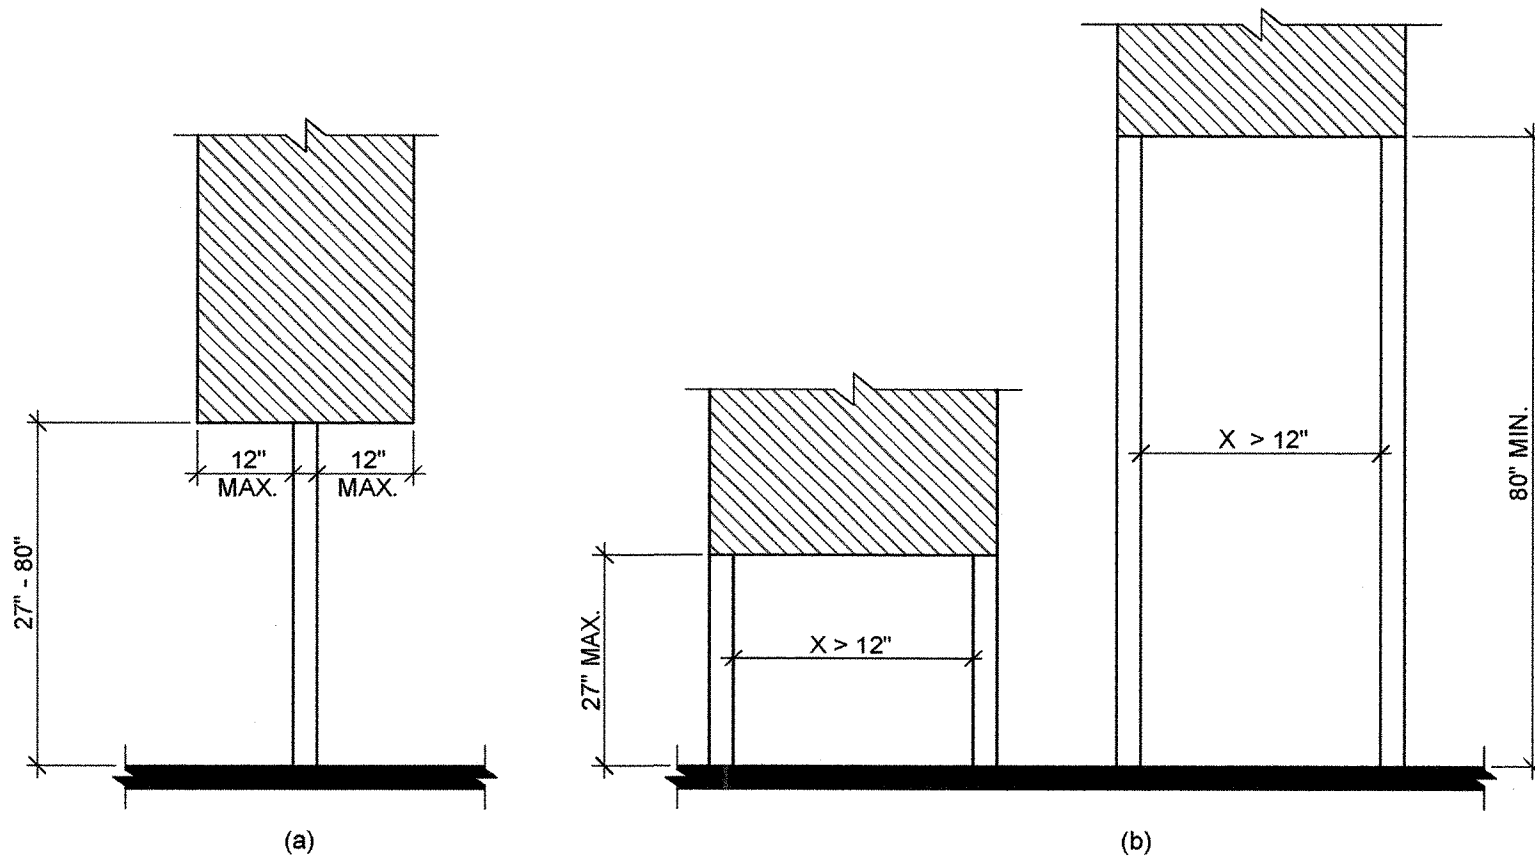


FIG. 11B-307.3 - POST-MOUNTED PROTRUDING OBJECTS

11B-309 - OPERABLE PARTS

11B-309.1 - GENERAL

OPERABLE PARTS SHALL COMPLY WITH SECTION 11B-309.

11B-309.2 - CLEAR FLOOR SPACE

A CLEAR FLOOR OR GROUND SPACE COMPLYING WITH SECTION 11B-305 SHALL BE PROVIDED. SEE 5  
G2.0

11B-309.3 - HEIGHT

OPERABLE PARTS SHALL BE PLACED WITHIN ONE OR MORE OF THE REACH RANGES SPECIFIED IN 11B-308.

FOR HEIGHT OF RESTROOM DISPENSERS, SEE 1  
A2.1

11B-309.4 - OPERATION

OPERABLE PARTS SHALL BE OPERABLE WITH ONE HAND AND SHALL NOT REQUIRE TIGHT GRASPING, PINCHING, OR TWISTING OF THE WRIST. THE FORCE REQUIRED TO ACTIVATE OPERABLE PARTS SHALL BE 5 POUNDS MAX. (5 POUND MAX. FORCE DOES NOT APPLY TO GAS PUMP NOZZLES OR ELECTRIC VEHICLE CONNECTORS).

11B-308 - REACH RANGES

11B-308.1 - GENERAL

REACH RANGES SHALL COMPLY WITH SECTION 11B-308.

11B-308.1.1 - ELECTRICAL SWITCHES/CONTROLS

CONTROLS AND SWITCHES INTENDED TO BE USED BY THE OCCUPANT OF THE ROOM OR AREA TO CONTROL LIGHTING AND RECEPTACLE OUTLETS, APPLIANCES, OR COOLING, HEATING, AND VENTILATING EQUIPMENT, SHALL COMPLY WITH SECTION 11B-308 EXCEPT THE LOW REACH SHALL BE MEASURED TO THE BOTTOM OF THE OUTLET BOX AND THE HIGH REACH SHALL BE MEASURED TO THE TOP OF THE OUTLET BOX.

11B-308.1.2 - ELECTRICAL RECEPTACLE OUTLETS

ELECTRICAL RECEPTACLE OUTLETS ON BRANCH CIRCUITS OF 30 AMPERES OR LESS & COMM. SYSTEM RECEPTACLES SHALL COMPLY WITH SECTION 11B-308 EXCEPT THE LOW REACH SHALL BE MEASURED TO THE BOTTOM OF THE OUTLET BOX AND THE HIGH REACH SHALL BE MEASURED TO THE TOP OF THE OUTLET BOX.

11B-308.2 - FORWARD REACH

11B-308.2.1 - UNOBSTRUCTED FORWARD REACH

WHERE A FORWARD REACH IS UNOBSTRUCTED, THE HIGH FORWARD REACH SHALL BE 48 INCHES MAX. AND LOW FORWARD REACH SHALL BE 15 INCHES MIN. ABOVE THE FINISHED FLOOR OR GROUND.

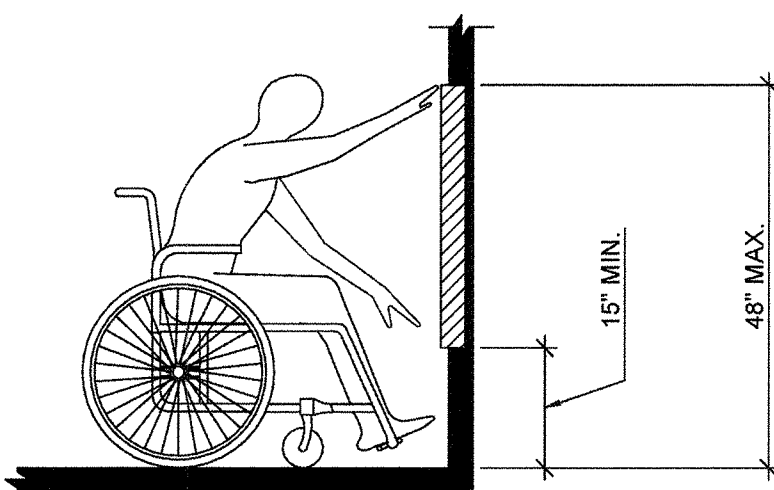


FIG. 11B-308.2.1 - UNOBSTRUCTED FORWARD REACH

11B-308.2.2 - OBSTRUCTED HIGH FORWARD REACH

WHERE A HIGH FORWARD REACH IS OVER AN OBSTRUCTION, THE CLEAR FLOOR SPACE SHALL EXTEND BENEATH THE ELEMENT FOR A DISTANCE NOT LESS THAN THE REQUIRED REACH DEPTH OVER THE OBSTRUCTION. THE HIGH FORWARD REACH SHALL BE 48 INCHES MAX. WHERE THE REACH DEPTH IS 20 INCHES MAXIMUM. WHERE THE REACH DEPTH EXCEEDS 20 INCHES, THE HIGH FORWARD REACH SHALL BE 44 INCHES MAX. AND THE REACH DEPTH SHALL BE 25 INCHES MAXIMUM.

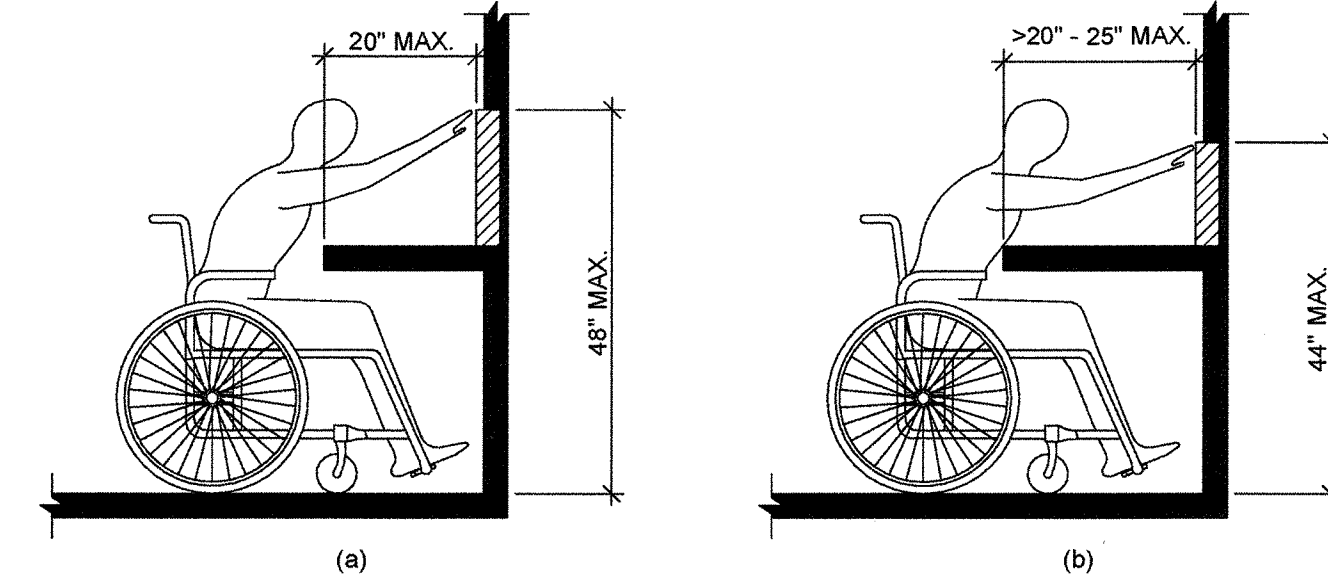


FIG. 11B-308.2.2 - OBSTRUCTED HIGH FORWARD REACH

7  
G2.0  
ACCESSIBILITY AT OPERABLE PARTS AND REACH RANGES  
1/2" = 1'-0"

11B-308.3 - SIDE REACH

11B-308.3.1 - UNOBSTRUCTED SIDE REACH

WHERE A CLEAR FLOOR OR GROUND SPACE ALLOWS A PARALLEL APPROACH TO AN ELEMENT AND THE SIDE REACH IS UNOBSTRUCTED, THE HIGH SIDE REACH SHALL BE 48 INCHES MAX. AND THE LOW SIDE REACH SHALL BE 15 INCHES MIN. ABOVE THE FINISHED FLOOR OR GROUND.

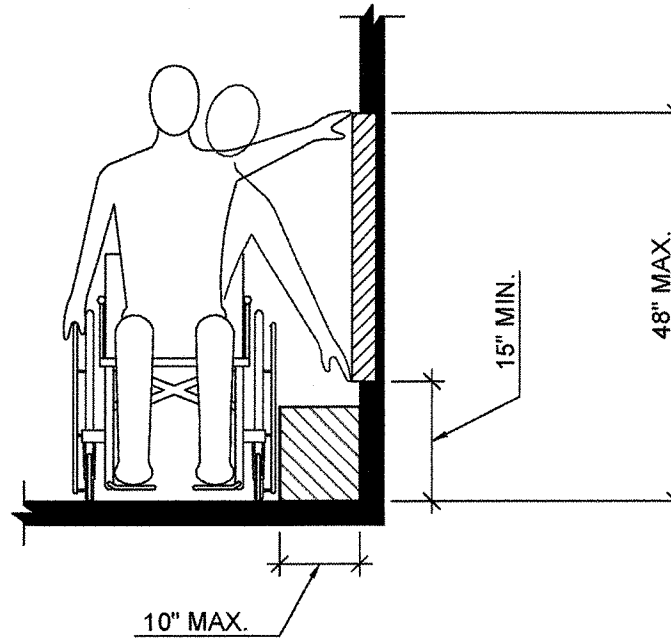


FIG. 11B-308.3.1 - UNOBSTRUCTED SIDE REACH

11B-308.3.2 - OBSTRUCTED HIGH SIDE REACH

WHERE A CLEAR FLOOR OR GROUND SPACE ALLOWS A PARALLEL APPROACH TO AN ELEMENT AND THE HIGH SIDE REACH IS OVER AN OBSTRUCTION, THE HEIGHT OF THE OBSTRUCTION SHALL BE 34 INCHES MAX. AND THE DEPTH OF THE OBSTRUCTION SHALL BE 24 INCHES MAX. THE HIGH SIDE REACH SHALL BE 48 INCHES MAX. FOR A REACH DEPTH OF 10 INCHES MAXIMUM. WHERE THE REACH DEPTH EXCEEDS 10 INCHES, THE HIGH SIDE REACH SHALL BE 46 INCHES MAX. FOR A REACH DEPTH OF 24 INCHES MAX.

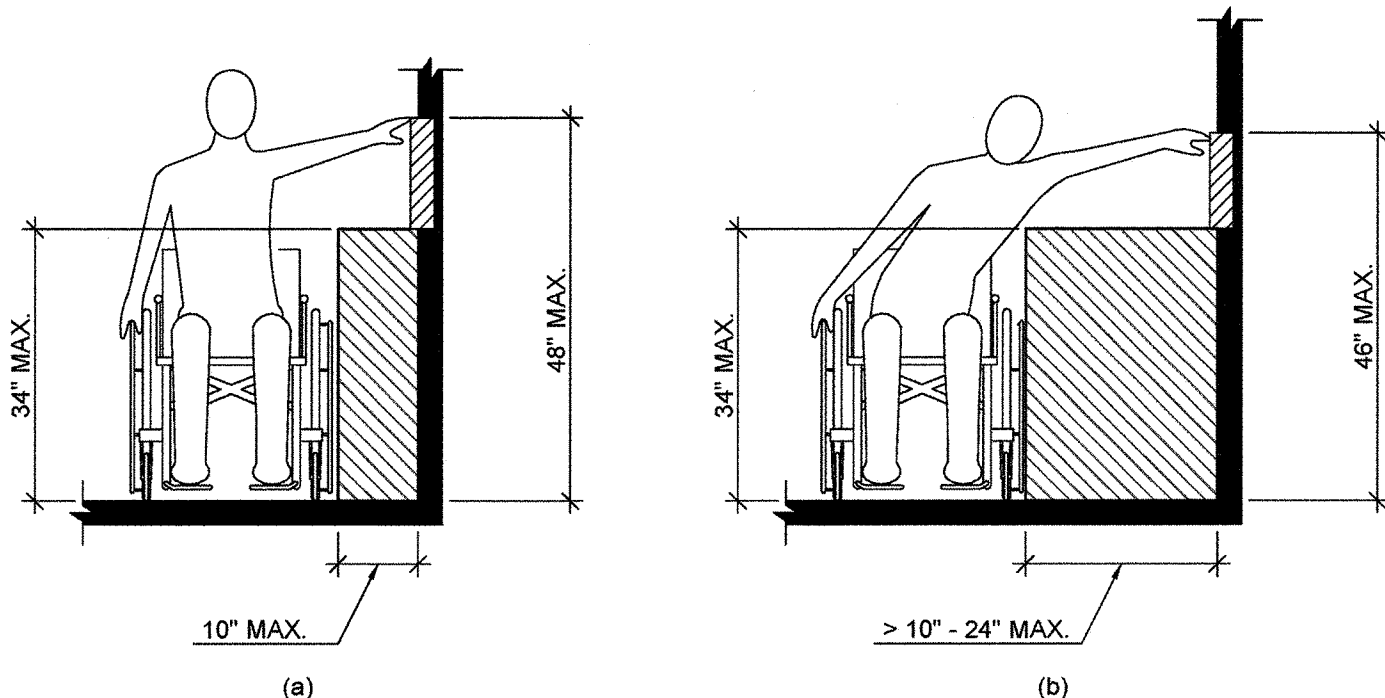


FIG. 11B-308.3.2 - OBSTRUCTED HIGH SIDE REACH

11B-307.4 - VERTICAL CLEARANCE

VERTICAL CLEARANCE SHALL BE 80 INCHES HIGH MINIMUM. GUARDRAILS OR OTHER BARRIERS SHALL BE PROVIDED WHERE THE VERTICAL CLEARANCE IS LESS THAN 80 INCHES HIGH. THE LEADING EDGE OF SUCH GUARDRAIL OR BARRIER SHALL BE LOCATED 27 INCHES MAXIMUM ABOVE THE FINISHED FLOOR OR GROUND.

EXCEPTION: DOOR CLOSERS AND DOOR STOPS SHALL BE PERMITTED TO BE 78 INCHES MIN. ABOVE THE FINISHED FLOOR OR GROUND.

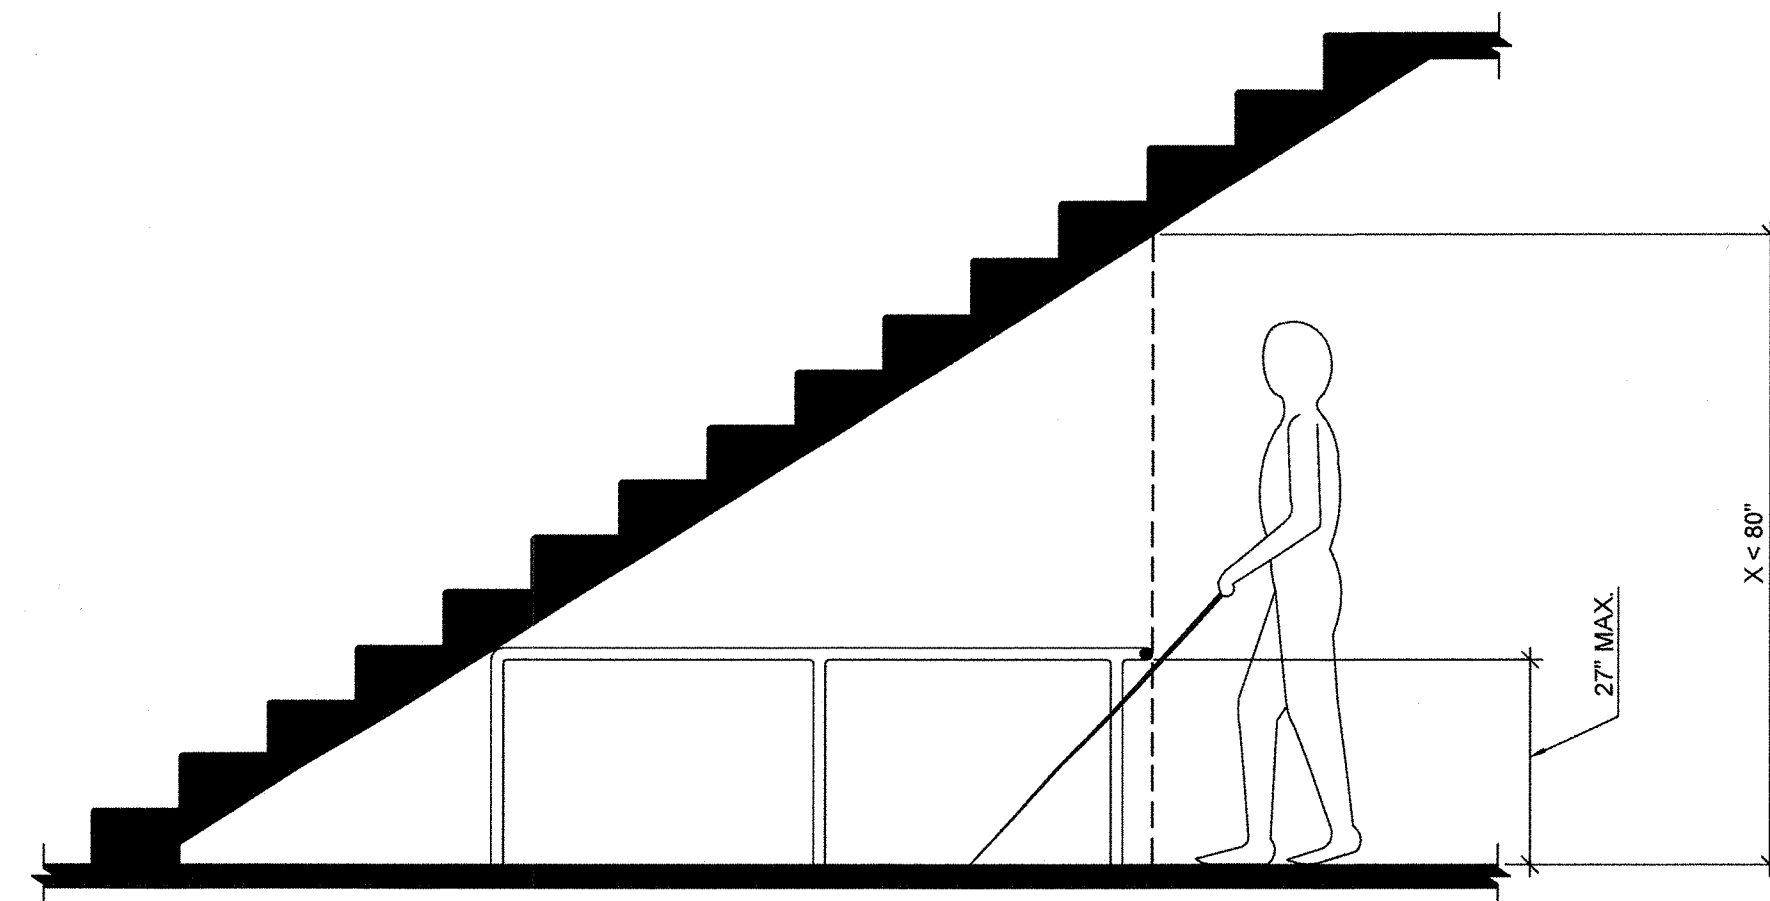


FIG. 11B-307.4 - VERTICAL CLEARANCE

2019CBC  
City of Madera  
Building Department  
The approval of these plans does not prevent the City of Madera from requiring correction of errors or omissions in the plans, specifications or construction. Subject to final inspection and approval of the City Engineer and the City of Madera.

APPROVED  
By: [Signature]  
Date: MAR 03 2022







11B-404 - DOORS, DOORWAYS, AND GATES

- 11B-402.1 - GENERAL**  
DOORS, DOORWAYS, AND GATES THAT ARE PART OF AN ACCESSIBLE ROUTE SHALL COMPLY WITH 11B-404.
- EXCEPTIONS:
- DOORS, DOORWAYS, AND GATES DESIGNED TO BE OPERATED ONLY BY SECURITY PERSONNEL SHALL NOT BE REQUIRED TO COMPLY WITH 11B-404.2.7, 11B-404.2.8, 11B-404.2.9, 11B-404.3.2 AND 11B-404.3.4 THROUGH 11B-404.3.7. A SIGN VISIBLE FROM THE APPROACH SIDE COMPLYING WITH 11B-703.5 SHALL BE POSTED STATING "ENTRY RESTRICTED AND CONTROLLED BY SECURITY PERSONNEL".
  - AT DETENTION AND CORR. FACILITIES, DOORS, DOORWAYS, AND GATES DESIGNED TO BE OPERATED ONLY BY SECURITY PERSONNEL SHALL NOT BE REQUIRED TO COMPLY WITH 11B-404.2.7, 11B-404.2.8, 11B-404.2.9, 11B-404.3.2 AND 11B-404.3.4 THROUGH 11B-404.3.7.

**11B-404.2 - MANUAL DOORS, DOORWAYS, AND MANUAL GATES**  
MANUAL DOORS AND DOORWAYS AND MANUAL GATES INTENDED FOR USER PASSAGE SHALL COMPLY WITH 11B-404.2.

**11B-404.2.1 - REVOLVING DOORS, GATES, AND TURNSTILES**  
REVOLVING DOORS, GATES, AND TURNSTILES SHALL NOT BE PART OF AN ACCESSIBLE ROUTE.

**11B-404.2.2 - DOUBLE LEAF DOORS AND GATES**  
AT LEAST ONE OF THE ACTIVE LEAFS OF DOORWAYS WITH TWO LEAVES SHALL COMPLY WITH 11B-404.2.3 AND 11B404.2.4.

**11B-404.2.3 - CLEAR WIDTH**  
DOOR WIDTHS SHALL PROVIDE A CLEAR WIDTH OF 32 INCHES MINIMUM. CLEAR OPENINGS OF DOORWAYS WITH SWINGING DOORS SHALL BE MEASURED BETWEEN THE FACE OF THE DOOR AND THE STOP, WITH THE DOOR OPEN 90 DEGREES. OPENINGS MORE THAN 24 INCHES DEEP SHALL PROVIDE A CLEAR OPENING OF 36 INCHES MINIMUM. THERE SHALL BE NO PROJECTIONS INTO THE REQUIRED CLEAR OPENING WIDTH LOWER THAN 34 INCHES ABOVE THE FINISHED FLOOR OR GROUND. PROJECTIONS INTO THE CLEAR OPENING WIDTH BETWEEN 34 INCHES AND 80 INCHES ABOVE THE FINISHED FLOOR OR GROUND SHALL NOT EXCEED 4 INCHES.

- EXCEPTION:
- IN ALTERATIONS, A PROJECTION OF 5/8 INCH MAX. INTO THE REQUIRED CLEAR WIDTH SHALL BE PERMITTED FOR THE LATCH SIDE STOP.
  - DOOR CLOSERS AND DOOR STOPS SHALL BE PERMITTED TO BE 78 INCHES ABOVE THE FINISHED FLOOR OR GROUND.


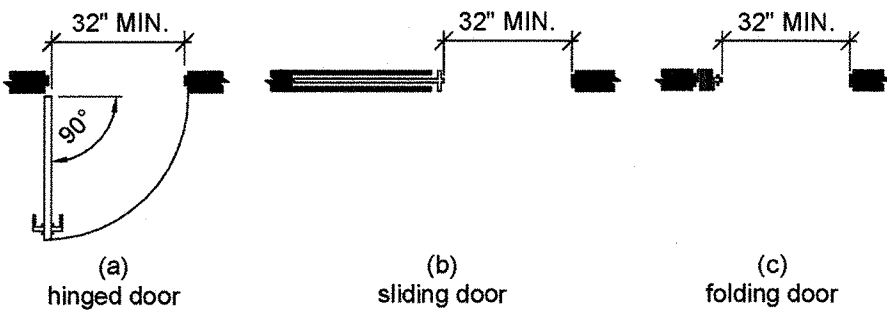


FIG. 11B-404.2.3 - CLEAR WIDTH OF DOORWAYS

**11B-404.2.4 - MANEUVERING CLEARANCES**  
MIN. MANEUVERING CLEARANCES AT DOORS AND GATES SHALL COMPLY WITH 11B-404.2.4. MANEUVERING CLEARANCES SHALL EXTEND THE FULL WIDTH OF THE DOORWAY AND THE REQUIRED LATCH SIDE OR HINGE SIDE CLEARANCE.

**11B-404.2.4.1 - SWINGING DOORS AND GATES**  
SEE FIGURE 11B-404.2.4.1

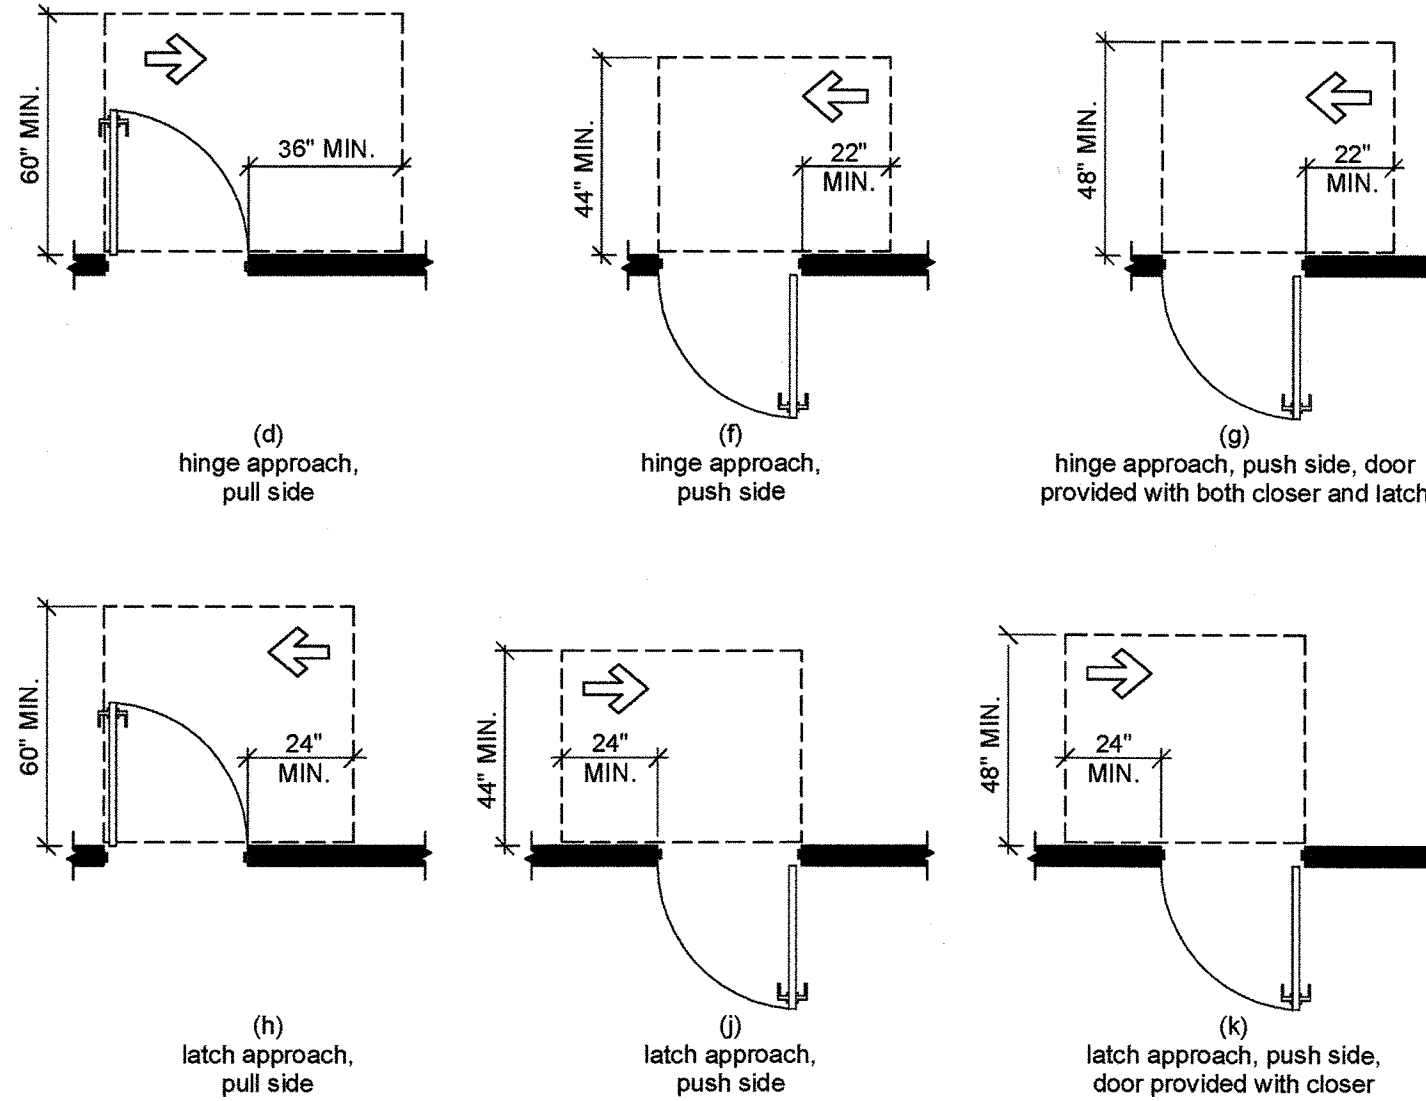

NOTE - FOR FRONT APPROACHES, COMPLY WITH FIGURE 11B-404.2.4.3

FIG. 11B-404.2.4.1 - MANEUVERING CLEARANCES AT MANUAL SWING DOORS AND GATES

**11B-404.2.4.2 - DOORWAYS WITHOUT DOORS OR GATES, SLIDING DOORS, AND FOLDING DOORS**  
SEE FIGURE 11B-404.2.4.2

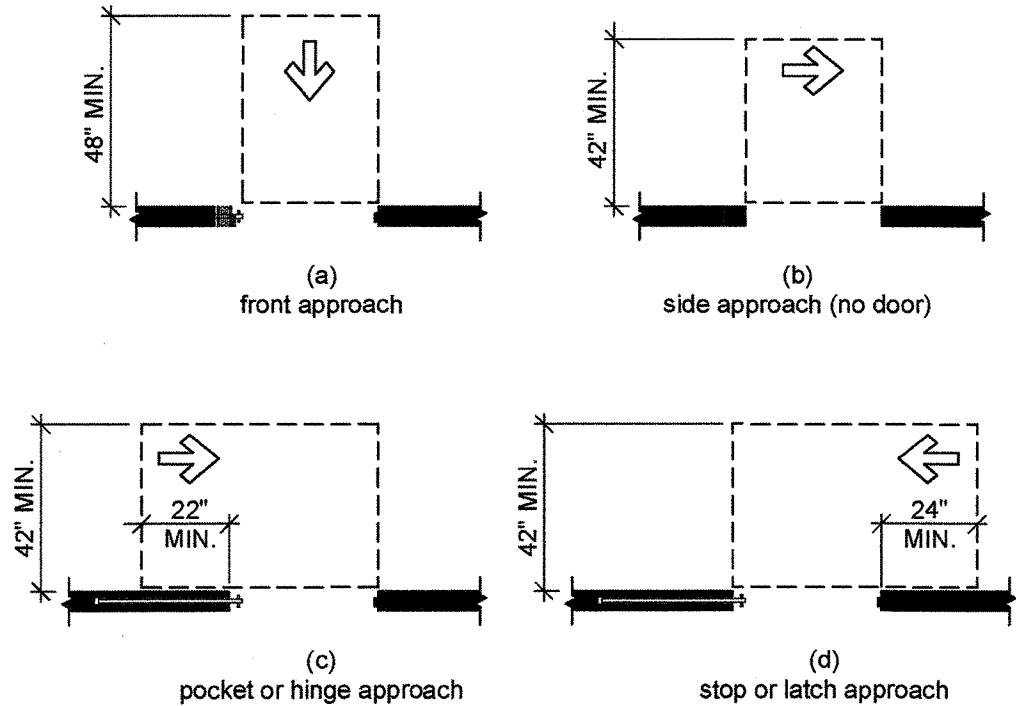


FIG. 11B-404.2.4.2 - MANEUVERING CLEARANCES AT DOORWAYS WITHOUT DOORS, SLIDING DOORS, GATES, AND FOLDING DOORS

**11B-404.2.4.3 - RECESSED DOORS AND GATES**  
SEE FIGURE 11B-404.2.4.3

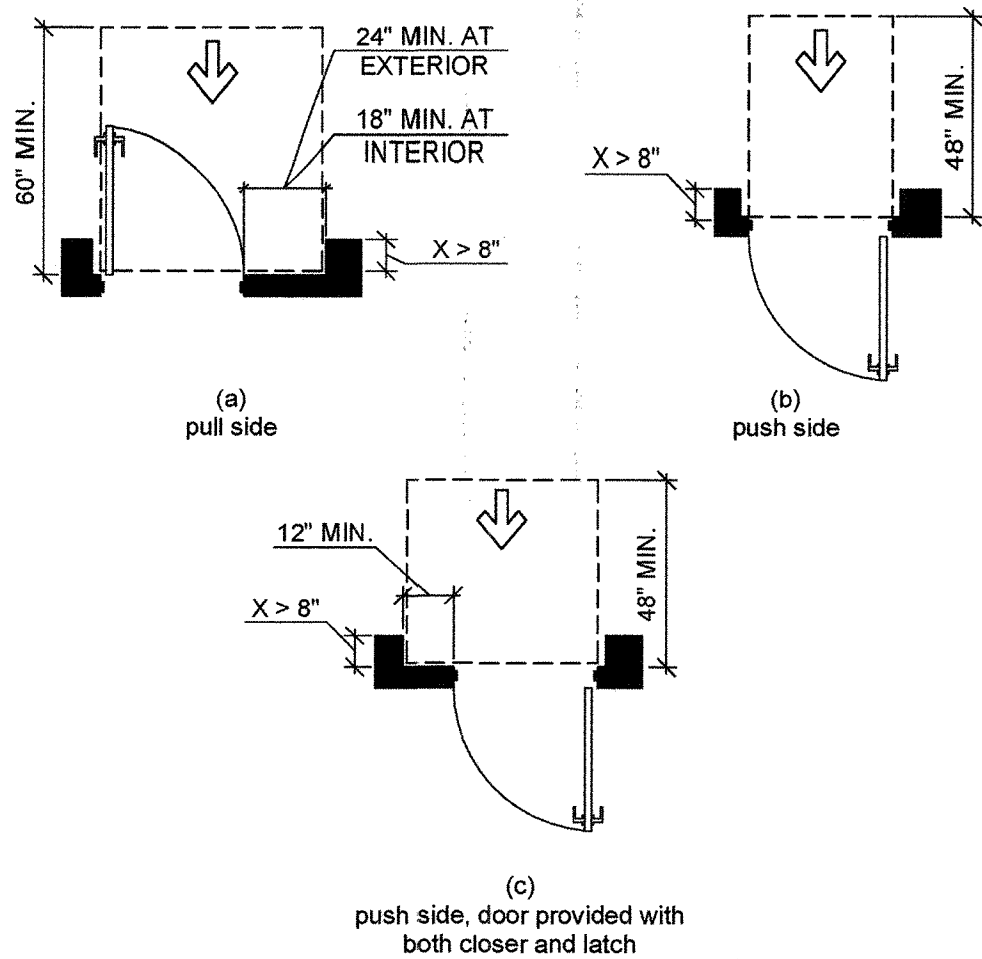


FIG. 11B-404.2.4.3 - MANEUVERING CLEARANCES AT RECESSED DOORS AND GATES

**11B-404.2.4.4 - FLOOR OR GROUND SURFACES**  
FLOOR OR GROUND SURFACE WITHIN REQUIRED MANEUVERING CLEARANCES SHALL COMPLY WITH SECTION 11B-302 (SEE 5 G2.1). CHANGES IN LEVEL ARE NOT PERMITTED.

- EXCEPTIONS:
- SLOPES NOT STEEPER THAN 1:48 SHALL BE PERMITTED.
  - CHANGES IN LEVEL AT THRESHOLDS COMPLYING WITH 11B-404.2.5 SHALL BE PERMITTED.

**11B-404.2.5 - THRESHOLDS**  
THRESHOLDS, IF PROVIDED AT DOORWAYS, SHALL BE 1/2 INCH HIGH MAXIMUM. RAISED THRESHOLDS AND CHANGES IN LEVEL AT DOORWAYS SHALL COMPLY WITH 11B-302 AND 11B-303 PER 5 G2.1

**11B-404.2.6 - DOORS IN SERIES AND GATES IN SERIES**  
THE DISTANCE BETWEEN TWO HINGED OR PIVOTED DOORS IN SERIES AND GATES IN SERIES SHALL BE 48 INCHES MIN. PLUS THE WIDTH OF DOORS OR GATES SWINGING INTO THE SPACE.

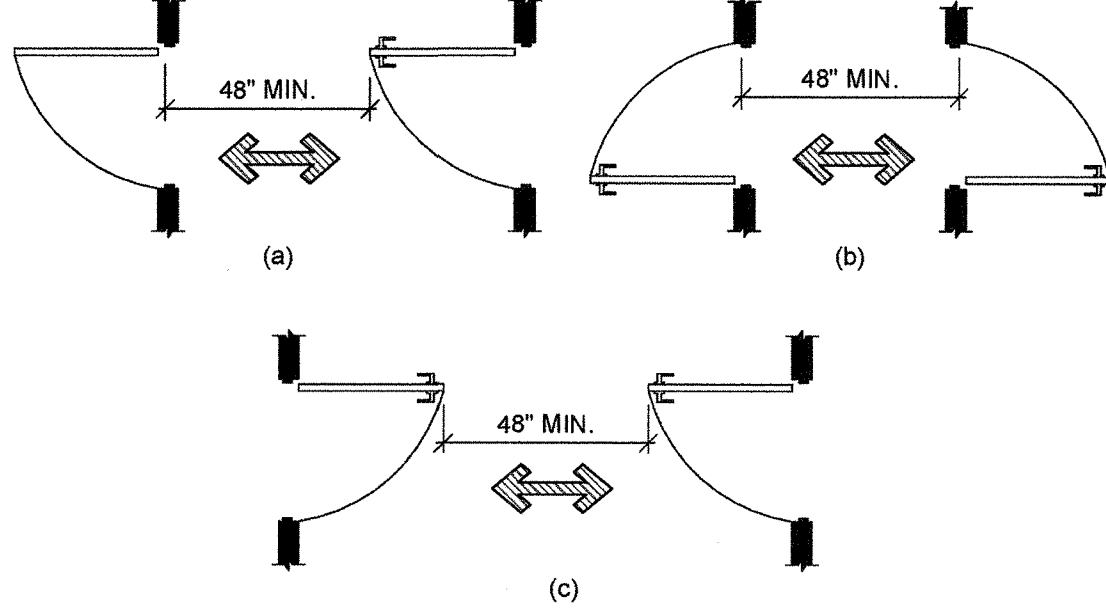


FIG. 11B-404.2.6 - DOORS IN SERIES AND GATES IN SERIES

**11B-404.2.7 - DOOR AND GATE HARDWARE**  
HANDLES, PULLS, LATCHES, LOCKS, AND OTHER OPERABLE PARTS ON DOORS AND GATES SHALL COMPLY WITH SECTION 11B-308.4. OPERABLE PARTS OF SUCH HARDWARE SHALL BE 34 INCHES MIN. AND 44 INCHES MAX. ABOVE THE FINISHED FLOOR OR GROUND. WHERE SLIDING DOORS ARE IN THE FULLY OPEN POSITION, OPERATING HARDWARE SHALL BE EXPOSED AND USABLE FROM BOTH SIDES.

- EXCEPTIONS:
- EXISTING LOCKS SHALL BE PERMITTED IN ANY LOCATION AT EXISTING GLAZED DOORS WITHOUT STILES, EXISTING OVERHEAD ROLLING DOORS OR GRILLES, AND SIMILAR EXISTING DOORS OR GRILLES THAT ARE DESIGNED WITH LOCKS THAT ARE ACTIVATED ONLY AT THE TOP OR BOTTOM RAIL.
  - ACCESS GATES IN BARRIER WALLS AND FENCES PROTECTING POOLS, SPAS, AND HOT TUBS SHALL BE PERMITTED TO HAVE OPERABLE PARTS OF THE RELEASE OF LATCH ON SELF-LATCHING DEVICES AT 54 INCHES MAX. ABOVE THE FINISHED FLOOR OR GROUND PROVIDED THAT SELF-LATCHING DEVICES ARE NOT ALSO SELF-LOCKING DEVICES AND OPERATED BY MEANS OF KEY, ELECTRONIC OPENER, OR INTEGRAL COMBINATION LOCK.

**11B-404.2.8.1 - CLOSING SPEED (DOOR AND GATE CLOSERS)**  
DOOR CLOSERS AND GATE CLOSERS SHALL BE ADJUSTED SO THAT FROM AN OPEN POSITION OF 90 DEGREES, THE TIME REQUIRED TO MOVE THE DOOR TO A POSITION OF 12 DEGREES FROM THE LATCH IS 5 SECONDS MIN.

**11B-404.2.8.2 - CLOSING SPEED (SPRING HINGES)**  
DOOR AND GATE SPRING HINGES SHALL BE ADJUSTED SO THAT FROM THE OPEN POSITION OF 70 DEGREES, THE DOOR OR GATE SHALL MOVE TO THE CLOSED POSITION IN 1.5 SECONDS MIN.

**11B-404.2.9 - DOOR AND GATE OPENING FORCE**  
THE FORCE FOR PUSHING OR PULLING OPEN A DOOR OR GATE SHALL BE AS FOLLOWED:

- INTERIOR HINGED DOORS AND GATES: 5 POUNDS MAX.
- SLIDING OR FOLDING DOORS: 5 POUNDS MAX.
- REQUIRED FIRE DOORS: THE MIN. OPENING FORCE ALLOWABLE BY THE APPROPRIATE ADMINISTRATIVE AUTHORITY, NOT TO EXCEED 15 POUNDS.
- EXTERIOR HINGED DOORS: 5 POUNDS MAX.

THESE FORCES DO NOT APPLY TO THE FORCE REQUIRED TO RETRACT LATCH BOLTS OR DISENGAGE OTHER DEVICES THAT HOLD THE DOOR OR GATE IN A CLOSED POSITION.

**11B-404.2.11 - VISION LIGHTS**  
DOORS, GATES, AND SIDE LIGHTS ADJACENT TO DOORS OR GATES, CONTAINING ONE OR MORE GLAZING PANELS THAT PERMIT VIEWING THROUGH THE PANELS SHALL HAVE THE BOTTOM OF AT LEAST ONE GLAZED PANEL LOCATED 43 INCHES MAX. ABOVE THE FINISHED FLOOR.

EXCEPTION: GLAZING PANELS WITH THE LOWEST PART MORE THAN 66 INCHES FORM THE FINISHED FLOOR OR GROUND SHALL NOT BE REQUIRED TO COMPLY WITH 11B404.2.11.




I:\Shared drives\DBKCompany\PROJECTS\20106\_WHSE Partners-Fresno, CA\Plans, Calcs & Specs\Arch-Struct (DBK)\Drawings\Franco Property - Modera\WHSE-BLDGA\_2021-09-12.rvt



[illegible]



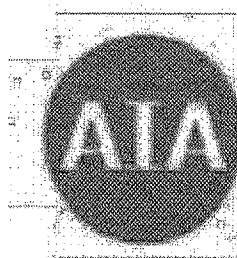

California

# 2019 CALIFORNIA GREEN BUILDING STANDARDS CODE

## NONRESIDENTIAL MANDATORY MEASURES, SHEET 1 (July 2021, Includes July 2021 Supplement)

Y NA RESPON. PARTY

ALL CONTRACTORS TO COMPLY

**5.504.4 FINISH MATERIAL POLLUTANT CONTROL.** Finish materials shall comply with Sections 5.504.4.1 through 5.504.4.5.

**5.504.4.1 Adhesives, sealants and caulks.** Adhesives, sealants, and caulks used on the project shall meet the requirements of the following standards:

1. Adhesives, adhesive bonding primers, adhesive primers, sealants, sealant primers and caulks shall comply with local or regional air pollution control or air quality management district rules where applicable, or SCAQMD Rule 1168 VOC limits, as shown in Tables 5.504.4.1 and 5.504.4.2. Such products also shall comply with the Rule 1168 prohibition on the use of certain toxic compounds (chloroform, ethylene dichloride, methylene chloride, perchloroethylene and trichloroethylene), except for aerosol products as specified in subsection 2, below.

2. Aerosol adhesives, and smaller unit sizes of adhesives, and sealant or caulking compounds (in units of product, less packaging, which do not weigh more than one pound and do not consist of more than 16 fluid ounces) shall comply with statewide VOC standards and other requirements, including prohibitions on use of certain toxic compounds, of California Code of Regulations, Title 17, commencing with Section 94507.

TABLE 5.504.4.1 - ADHESIVE VOC LIMIT<sup>1,2</sup>

Less Water and Less Exempt Compounds in Grams per Liter

ARCHITECTURAL APPLICATIONS	CURRENT VOC LIMIT
INDOOR CARPET ADHESIVES	50
CARPET PAD ADHESIVES	50
OUTDOOR CARPET ADHESIVES	150
WOOD FLOORING ADHESIVES	100
RUBBER FLOOR ADHESIVES	60
SUBFLOOR ADHESIVES	50
CERAMIC TILE ADHESIVES	65
VCT & ASPHALT TILE ADHESIVES	50
DRYWALL & PANEL ADHESIVES	50
COVE BASE ADHESIVES	50
MULTIPURPOSE CONSTRUCTION ADHESIVES	70
STRUCTURAL GLAZING ADHESIVES	100
SINGLE-PLY ROOF MEMBRANE ADHESIVES	250
OTHER ADHESIVES NOT SPECIFICALLY LISTED	50
<b>SPECIALTY APPLICATIONS</b>	
PVC WELDING	510
CPVC WELDING	490
ABS WELDING	325
PLASTIC CEMENT WELDING	250
ADHESIVE PRIMER FOR PLASTIC	550
CONTACT ADHESIVE	80
SPECIAL PURPOSE CONTACT ADHESIVE	250
STRUCTURAL WOOD MEMBER ADHESIVE	140
TOP & TRIM ADHESIVE	250
<b>SUBSTRATE SPECIFIC APPLICATIONS</b>	
METAL TO METAL	30
PLASTIC FOAMS	50
POROUS MATERIAL (EXCEPT WOOD)	50
WOOD	30
FIBERGLASS	80

1. IF AN ADHESIVE IS USED TO BOND DISSIMILAR SUBSTRATES TOGETHER, THE ADHESIVE WITH THE HIGHEST VOC CONTENT SHALL BE ALLOWED.

2. FOR ADDITIONAL INFORMATION REGARDING METHODS TO MEASURE THE VOC CONTENT SPECIFIED IN THIS TABLE, SEE SOUTH COAST AIR QUALITY MANAGEMENT DISTRICT RULE 1168, [www.arb.ca.gov/DREB/SC/CURHTML/R1168.PDF](http://www.arb.ca.gov/DREB/SC/CURHTML/R1168.PDF)

TABLE 5.504.4.2 - SEALANT VOC LIMIT

Less Water and Less Exempt Compounds in Grams per Liter

SEALANTS	CURRENT VOC LIMIT
ARCHITECTURAL	250
MARINE DECK	760
NONMEMBRANE ROOF	300
ROADWAY	250
SINGLE-PLY ROOF MEMBRANE	450
OTHER	420
<b>SEALANT PRIMERS</b>	
ARCHITECTURAL	
NONPOROUS	250
POROUS	775
MODIFIED BITUMINOUS	500
MARINE DECK	760
OTHER	750

NOTE: FOR ADDITIONAL INFORMATION REGARDING METHODS TO MEASURE THE VOC CONTENT SPECIFIED IN THESE TABLES, SEE SOUTH COAST AIR QUALITY MANAGEMENT DISTRICT RULE 1168.

**5.504.4.3 Paints and coatings.** Architectural paints and coatings shall comply with VOC limits in Table 1 of the ARB Architectural Coatings Suggested Control Measure, as shown in Table 5.504.4.3, unless more stringent local limits apply. The VOC content limit for coatings that do not meet the definitions for the specialty coatings categories listed in Table 5.504.4.3 shall be determined by classifying the coating as a Flat, Nonflat or Nonflat-High Gloss coating, based on its gloss, as defined in Subsections 4.21, 4.36 and 4.37 of the 2007 California Air Resources Board Suggested Control Measure, and the corresponding Flat, Nonflat or Nonflat-High Gloss VOC limit in Table 5.504.4.3 shall apply.

**5.504.4.3.1 Aerosol Paints and coatings.** Aerosol paints and coatings shall meet the PWMIR Limits for VOC in Section 94522(a)(3) and other requirements, including prohibitions on use of certain toxic compounds and ozone depleting substances, in Sections 94522(c)(2) and (c)(3) of California Code of Regulations, Title 17, commencing with Section 94520; and in areas under the jurisdiction of the Bay Area Air Quality Management District additionally comply with the percent VOC by weight of product limits of Regulation 8 Rule 49.

TABLE 5.504.4.3 - VOC CONTENT LIMITS FOR ARCHITECTURAL COATINGS<sup>1,2</sup>

GRAMS OF VOC PER LITER OF COATING, LESS WATER & LESS EXEMPT COMPOUNDS

COATING CATEGORY	CURRENT VOC LIMIT
FLAT COATINGS	50
NONFLAT COATINGS	100
NONFLAT HIGH GLOSS COATINGS	150
<b>SPECIALTY COATINGS</b>	
ALUMINUM ROOF COATINGS	400
BASEMENT SPECIALTY COATINGS	400
BITUMINOUS ROOF COATINGS	50
BITUMINOUS ROOF PRIMERS	350
BOND BREAKERS	350
CONCRETE CURING COMPOUNDS	350
CONCRETE/MASONRY SEALERS	100
DRIVEWAY SEALERS	50
DRY FOG COATINGS	150
FAUX FINISHING COATINGS	350
FIRE RESISTIVE COATINGS	350
FLOOR COATINGS	100
FORM-RELEASE COMPOUNDS	250
GRAPHIC ARTS COATINGS (SIGN PAINTS)	500
HIGH-TEMPERATURE COATINGS	420
INDUSTRIAL MAINTENANCE COATINGS	250
LOW SOLIDS COATINGS <sup>1</sup>	120
MAGNESITE CEMENT COATINGS	450
MASTIC TEXTURE COATINGS	100
METALLIC PIGMENTED COATINGS	500
MULTICOLOR COATINGS	250
PRETREATMENT WASH PRIMERS	420
PRIMERS, SEALERS, & UNDERCOATERS	100
REACTIVE PENETRATING SEALERS	350
RECYCLED COATINGS	250
ROOF COATINGS	50
RUST PREVENTATIVE COATINGS	250
SHELLACS:	
CLEAR	730
OPAQUE	550
SPECIALTY PRIMERS, SEALERS & UNDERCOATERS	100
STAINS	250
STONE CONSOLIDANTS	450
SWIMMING POOL COATINGS	340
TRAFFIC MARKING COATINGS	100
TUB & TILE REFINISH COATINGS	420
WATERPROOFING MEMBRANES	250
WOOD COATINGS	275
WOOD PRESERVATIVES	350
ZINC-RICH PRIMERS	340

1. GRAMS OF VOC PER LITER OF COATING, INCLUDING WATER & EXEMPT COMPOUNDS

2. THE SPECIFIED LIMITS REMAIN IN EFFECT UNLESS REVISED LIMITS ARE LISTED IN SUBSEQUENT COLUMNS IN THE TABLE.

3. VALUES IN THIS TABLE ARE DERIVED FROM THOSE SPECIFIED BY THE CALIFORNIA AIR RESOURCES BOARD, ARCHITECTURAL COATINGS SUGGESTED CONTROL MEASURE, FEB. 1, 2008. MORE INFORMATION IS AVAILABLE FROM THE AIR RESOURCES BOARD.

**5.504.4.3.2 Verification.** Verification of compliance with this section shall be provided at the request of the enforcing agency. Documentation may include, but is not limited to, the following:

1. Manufacturer's product specification
2. Field verification of on-site product containers

**5.504.4.4 Carpet Systems.**

All carpet installed in the building interior shall meet the requirements of the California Department of Public Health, "Standard Method for the Testing and Evaluation of Volatile Organic Chemical Emissions from Indoor Sources Using Environmental Chambers," Version 1.2, January 2017 (Emission testing method for California Specifications 01350).

See California Department of Public Health's website for certification programs and testing labs. <https://www.cdph.ca.gov/Programs/CCDCPP/DEOD/CEHLB/IAQ/Pages/VOC.aspx#material>

**5.504.4.4.1 Carpet cushion.** All carpet cushion installed in the building interior shall meet the requirements of the California Department of Public Health, "Standard Method for the Testing and Evaluation of Volatile Organic Chemical Emissions from Indoor Sources Using Environmental Chambers," Version 1.2, January 2017 (Emission testing method for California Specifications 01350).

See California Department of Public Health's website for certification programs and testing labs. <https://www.cdph.ca.gov/Programs/CCDCPP/DEOD/CEHLB/IAQ/Pages/VOC.aspx#material>

**5.504.4.4.2 Carpet adhesive.** All carpet adhesive shall meet the requirements of Table 5.504.4.1.

**5.504.4.5 Composite wood products.** Hardwood plywood, particleboard and medium density fiberboard composite wood products used on the interior or exterior of the buildings shall meet the requirements for formaldehyde as specified in ARB's Air Toxics Control Measure (ATCM) for Composite Wood (17 CCR 93120 et seq.). Those materials not exempted under the ATCM must meet the specified emission limits, as shown in Table 5.504.4.5.

**5.504.4.5.3 Documentation.** Verification of compliance with this section shall be provided as requested by the enforcing agency. Documentation shall include at least one of the following:

1. Product certifications and specifications.
2. Chain of custody certifications.
3. Product labeled and invoiced as meeting the Composite Wood Products regulation (see CCR, Title 17, Section 93120, et seq.).
4. Exterior grade products marked as meeting the PS-1 or PS-2 standards of the Engineered Wood Association, the Australian AS/NZS 2289 or European EN 338 standards.
5. Other methods acceptable to the enforcing agency.

TABLE 5.504.4.5 - FORMALDEHYDE LIMITS.

MAXIMUM FORMALDEHYDE EMISSIONS IN PARTS PER MILLION

PRODUCT	CURRENT LIMIT
HARDWOOD PLYWOOD VENEER CORE	0.05
HARDWOOD PLYWOOD COMPOSITE CORE	0.05
PARTICLE BOARD	0.09
MEDIUM DENSITY FIBERBOARD	0.11
THIN MEDIUM DENSITY FIBERBOARD	0.13

1. VALUES IN THIS TABLE ARE DERIVED FROM THOSE SPECIFIED BY THE CALIFORNIA AIR RESOURCES BOARD, AIR TOXICS CONTROL MEASURE FOR COMPOSITE WOOD AS TESTED IN ACCORDANCE WITH ASTM E 1333. FOR ADDITIONAL INFORMATION, SEE CALIFORNIA CODE OF REGULATIONS, TITLE 17, SECTIONS 93120 THROUGH 93120.12.

2. THIN MEDIUM DENSITY FIBERBOARD HAS A MAXIMUM THICKNESS OF 5/16 INCHES (8 MM).

**5.504.4.6 Resilient flooring systems.** Where resilient flooring is installed, at least 80 percent of floor area receiving resilient flooring shall meet the requirements of the California Department of Public Health, "Standard Method for the Testing and Evaluation of Volatile Organic Chemical Emissions from Indoor Sources Using Environmental Chambers," Version 1.2, January 2017 (Emission testing method for California Specifications 01350).

See California Department of Public Health's website for certification programs and testing labs. <https://www.cdph.ca.gov/Programs/CCDCPP/DEOD/CEHLB/IAQ/Pages/VOC.aspx#material>

**5.504.4.6.1 Verification of compliance.** Documentation shall be provided verifying that resilient flooring materials meet the pollutant emission limits.

**5.504.5.3 Filters.** In mechanically ventilated buildings, provide regularly occupied areas of the building with air filtration media for outside and return air that provides at least a Minimum Efficiency Reporting Value (MERV) of 13. MERV 13 filters shall be installed prior to occupancy, and recommendations for maintenance with filters of the same value shall be included in the operation and maintenance manual.

**Exceptions:** Existing mechanical equipment.

**5.504.5.3.1 Labeling.** Installed filters shall be clearly labeled by the manufacturer indicating the MERV rating.

**5.504.7 ENVIRONMENTAL TOBACCO SMOKE (ETS) CONTROL.** Where outdoor areas are provided for smoking, prohibit smoking within 25 feet of building entries, outdoor air intakes and operable windows and within the building as already prohibited by other laws or regulations; or as enforced by ordinances, regulations or policies of any city, county, city and county, California Community College, campus of the California State University, or campus of the University of California, whichever are more stringent. When ordinances, regulations or policies are not in place, post signage to inform building occupants of the prohibitions.

### SECTION 5.505 INDOOR MOISTURE CONTROL

**5.505.1 INDOOR MOISTURE CONTROL.** Buildings shall meet or exceed the provisions of California Building Code, CCR, Title 24, Part 2, Sections 1202 (Ventilation) and Chapter 14 (Exterior Walls). For additional measures, see Section 5.507.2 of this code.

### SECTION 5.506 INDOOR AIR QUALITY

**5.506.1 OUTSIDE AIR DELIVERY.** For mechanically or naturally ventilated spaces in buildings, meet the minimum requirements of Section 120.1 (Requirements for Ventilation) of the California Energy Code, or the applicable local code, whichever is more stringent, and Division 1, Chapter 4 of CCR, Title 8.

**5.506.2 CARBON DIOXIDE (CO<sub>2</sub>) MONITORING.** For buildings or additions equipped with demand control ventilation, CO<sub>2</sub> sensors and ventilation controls shall be specified and installed in accordance with the requirements of the California Energy Code, Section 120(c)(4).

### SECTION 5.507 ENVIRONMENTAL COMFORT

**5.507.4 ACOUSTICAL CONTROL.** Employ building assemblies and components with Sound Transmission Class (STC) values determined in accordance with ASTM E 90 and ASTM E 413, or Outdoor-Indoor Sound Transmission Class (OITC) determined in accordance with ASTM E 1332, using either the prescriptive or performance method in Section 5.507.4.1 or 5.507.4.2.

**Exception:** Buildings with few or no occupants or where occupants are not likely to be affected by exterior noise, as determined by the enforcement authority, such as factories, stadiums, storage, enclosed parking structures and utility buildings.

**Exception: [D8A-S8]** For public schools and community colleges, the requirements of this section and all subsections apply only to new construction.

**5.507.4.1 Exterior noise transmission, prescriptive method.** Wall and roof-ceiling assemblies exposed to the noise source making up the building or addition envelope or altered envelope shall meet a composite STC rating of at least 50 or a composite OITC rating of no less than 40, with exterior windows of a minimum STC of 40 or OITC of 30 in the following locations:

1. Within the 65 CNEL noise contour of an airport.

**Exceptions:**

1. Le or CNEL for military airports shall be determined by the facility Air Installation Compatible Land Use Zone (AICLUZ) plan.
2. Le or CNEL for other airports and heliports for which a land use plan has not been developed shall be determined by the local general plan noise element.

2. Within the 65 CNEL or Le noise contour of a freeway or expressway, railroad, industrial source or fixed-guideway source as determined by the Noise Element of the General Plan.

**5.507.4.1.1. Noise exposure where noise contours are not readily available.** Buildings exposed to a noise level of 65 dB L<sub>eq</sub> 1-hr during any hour of operation shall have building, addition or alteration exterior wall and roof-ceiling assemblies exposed to the noise source meeting a composite STC rating of at least 45 (or OITC 35), with exterior windows of a minimum STC of 40 (or OITC 30).

**5.507.4.2 Performance Method.** For buildings located as defined in Section 5.507.4.1 or 5.507.4.1.1, wall and roof-ceiling assemblies exposed to the noise source making up the building or addition envelope or altered envelope shall be constructed to provide an interior noise environment attributable to exterior sources that does not exceed an hourly equivalent noise level (Leq-1hr) of 50 dBA in occupied areas during any hour of operation.

**5.507.4.2.1 Site Features.** Exterior features such as sound walls or earth berms may be utilized as appropriate to the building, addition or alteration project to mitigate sound migration to the interior.

**5.507.4.2.2 Documentation of Compliance.** An acoustical analysis documenting complying interior sound levels shall be prepared by personnel approved by the architect or engineer of record.

**5.507.4.3 Interior sound transmission.** Wall and floor-ceiling assemblies separating tenant spaces and tenant spaces and public places shall have an STC of at least 40.

**Note:** Examples of assemblies and their various STC ratings may be found at the California Office of Noise Control: [www.toobase.org/PDF/CaseStudies/stc\\_ratings.pdf](http://www.toobase.org/PDF/CaseStudies/stc_ratings.pdf)

### SECTION 5.508 OUTDOOR AIR QUALITY

**5.508.1 Ozone depletion and greenhouse gas reductions.** Installations of HVAC, refrigeration and fire suppression equipment shall comply with Sections 5.508.1.1 and 5.508.1.2.

**5.508.1.1 Chlorofluorocarbons (CFCs).** Install HVAC, refrigeration and fire suppression equipment that do not contain CFCs.

**5.508.1.2 Halons.** Install HVAC, refrigeration and fire suppression equipment that do not contain Halons.

**5.508.2 Supermarket refrigerant leak reduction.** New commercial refrigeration systems shall comply with the provisions of this section when installed in retail food stores 8,000 square feet or more conditioned area, and that utilize either refrigerated display cases, or walk-in coolers or freezers connected to remote compressor units or condensing units. The leak reduction measures apply to refrigeration systems containing high-global-warming potential (high-GWP) refrigerants with a GWP of 150 or greater. New refrigeration systems include both new facilities and the replacement of existing refrigeration systems in existing facilities.

**Exception:** Refrigeration systems containing low-global warming potential (low-GWP) refrigerant with a GWP value less than 150 are not subject to this section. Low-GWP refrigerants are nonozone-depleting refrigerants that include ammonia, carbon dioxide (CO<sub>2</sub>), and potentially other refrigerants.

Y NA RESPON. PARTY = YES NOT APPLICABLE RESPONSIBLE PARTY (ie: ARCHITECT, ENGINEER, OWNER, CONTRACTOR, INSPECTOR, ETC.)

**5.508.2.1 Refrigerant piping.** Piping compliant with the California Mechanical Code shall be installed to be accessible for leak protection and repairs. Piping runs using threaded pipe, copper tubing with an outside diameter (OD) less than 1/4 inch, flared tubing connections and short radius elbows shall not be used in refrigerant systems except as noted below.

**5.508.2.1.1 Threaded pipe.** Threaded connections are permitted at the compressor rack.

**5.508.2.1.2 Copper pipe.** Copper tubing with an OD less than 1/4 inch may be used in systems with a refrigerant charge of 5 pounds or less.

**5.508.2.1.2.1 Anchorage.** One-fourth-inch OD tubing shall be securely clamped to a rigid base to keep vibration levels below 8 mils.

**5.508.2.1.3 Flared tubing connections.** Double-flared tubing connections may be used for pressure controls, valve pilot lines and oil.

**Exception:** Single-flared tubing connections may be used with a multiring seal coated with industrial sealant suitable for use with refrigerants and tightened in accordance with manufacturer's recommendations.

**5.508.2.1.4 Elbows.** Short radius elbows are only permitted where space limitations prohibit use of long radius elbows.

**5.508.2.2 Valves.** Valves and fittings shall comply with the California Mechanical Code and as follows.

**5.508.2.2.1 Pressure relief valves.** For vessels containing high-GWP refrigerant, a rupture disc shall be installed between the outlet of the vessel and the inlet of the pressure relief valve.

**5.508.2.2.1.1 Pressure detection.** A pressure gauge, pressure transducer or other device shall be installed in the space between the rupture disc and the relief valve inlet to indicate a disc rupture or discharge of the relief valve.

**5.508.2.2.2 Access valves.** Only Schrader access valves with a brass or steel body are permitted for use.

**5.508.2.2.2.1 Valve caps.** For systems with a refrigerant charge of 5 pounds or more, valve caps shall be brass or steel and not plastic.

**5.508.2.2.2.2 Seal caps.** If designed for it, the cap shall have a neoprene O-ring in place.

**5.508.2.2.2.2.1 Chain tethers.** Chain tethers to fit over the stem are required for valves designed to have seal caps.

**Exception:** Valves with seal caps that are not removed from the valve during stem operation.

**5.508.2.3 Refrigerated service cases.** Refrigerated service cases holding food products containing vinegar and salt shall have evaporator coils of corrosion-resistant material, such as stainless steel; or be coated to prevent corrosion from these substances.

**5.508.2.3.1 Coil coating.** Consideration shall be given to the heat transfer efficiency of coil coating to maximize energy efficiency.

**5.508.2.4 Refrigerant receivers.** Refrigerant receivers with capacities greater than 200 pounds shall be fitted with a device that indicates the level of refrigerant in the receiver.

**5.508.2.5 Pressure testing.** The system shall be pressure tested during installation prior to evacuation and charging.

**5.508.2.5.1 Minimum pressure.** The system shall be charged with regulated dry nitrogen and appropriate tracer gas to bring system pressure up to 300 psig minimum.

**5.508.2.5.2 Leaks.** Check the system for leaks, repair any leaks, and retest for pressure using the same gauge.

**5.508.2.5.3 Allowable pressure change.** The system shall stand, unaltered, for 24 hours with no more than a +/- one pound pressure change from 300 psig, measured with the same gauge.

**5.508.2.6 Evacuation.** The system shall be evacuated after pressure testing and prior to charging.

**5.508.2.6.1 First vacuum.** Pull a system vacuum down to at least 1000 microns (+/- 500 microns), and hold for 30 minutes.

**5.508.2.6.2 Second vacuum.** Pull a second system vacuum to a minimum of 500 microns and hold for 30 minutes.

**5.508.2.6.3 Third vacuum.** Pull a third vacuum down to a minimum of 300 microns, and hold for 24 hours with a maximum drift of 100 microns over a 24-hour period.

### CHAPTER 7

### INSTALLER & SPECIAL INSPECTOR QUALIFICATIONS

#### 702 QUALIFICATIONS

**702.1 INSTALLER TRAINING.** HVAC system installers shall be trained and certified in the proper installation of HVAC systems including ducts and equipment by a nationally or regionally recognized training or certification program. Uncertified persons may perform HVAC installations when under the direct supervision and responsibility of a person trained and certified to install HVAC systems or contractor licensed to install HVAC systems. Examples of acceptable HVAC training and certification programs include but are not limited to the following:

1. State certified apprenticeship programs.
2. Public utility training programs.
3. Training programs sponsored by trade, labor or statewide energy consulting or verification organizations.
4. Programs sponsored by manufacturing organizations.
5. Other programs acceptable to the enforcing agency.

**702.2 SPECIAL INSPECTION [HCO].** When required by the enforcing agency, the owner or the responsible entity acting as the owner's agent shall employ one or more special inspectors to provide inspection or other duties necessary to substantiate compliance with this code. Special inspectors shall demonstrate competence to the satisfaction of the enforcing agency for the particular type of inspection or task to be performed. In addition to other certifications or qualifications acceptable to the enforcing agency, the following certifications or education may be considered by the enforcing agency when evaluating the qualifications of a special inspector:

1. Certification by a national or regional green building program or standard publisher.
2. Certification by a statewide energy consulting or verification organization, such as HERS raters, building performance contractors, and home energy auditors.
3. Successful completion of a third party apprentice training program in the appropriate trade.
4. Other programs acceptable to the enforcing agency.

**Notes:**

1. Special inspectors shall be independent entities with no financial interest in the materials or the project they are inspecting for compliance with this code.
2. HERS raters are special inspectors certified by the California Energy Commission (CEC) to rate homes in California according to the Home Energy Rating System (HERS).

**[BSC-CG]** When required by the enforcing agency, the owner or the responsible entity acting as the owner's agent shall employ one or more special inspectors to provide inspection or other duties necessary to substantiate compliance with this code. Special inspectors shall demonstrate competence to the satisfaction of the enforcing agency for the particular type of inspection or task to be performed. In addition, the special inspector shall have a certification from a recognized state, national or international association, as determined by the local agency. The area of certification shall be closely related to the primary job function, as determined by the local agency.


**Note:** Special inspectors shall be independent entities with no financial interest in the materials or the project they are inspecting for compliance with this code.

#### 703 VERIFICATIONS

**703.1 DOCUMENTATION.** Documentation used to show compliance with this code shall include but is not limited to construction documents, plans, specifications, builder or installer certification, inspection reports, or other methods acceptable to the enforcing agency which demonstrate substantial conformance. When specific documentation or special inspection is necessary to verify compliance, that method of compliance will be specified in the appropriate section or identified applicable checklist.



WHSE  
[PARTNERS]

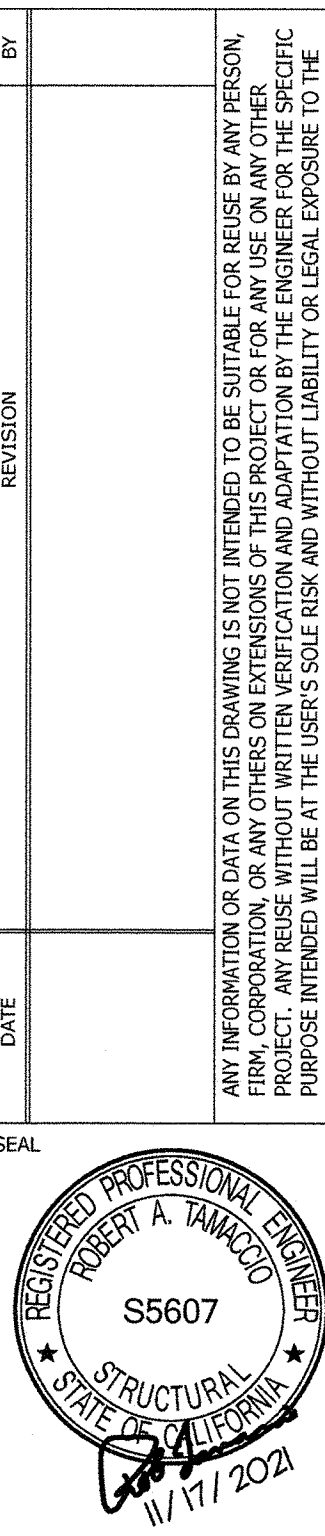

CALGREEN (SHEET 3 OF 3)  
LEASE FLEX. / WAREHOUSE BUILDINGS  
FOR  
MADERA INDUSTRIAL WHSE, LLC  
S. SCHNOOR AVENUE, MADERA, CA

21107

RT

CD

11/17/2021

SHEET NUMBER

G3.2



A5.602  
CALGreen VERIFICATION GUIDELINES  
MANDATORY MEASURES CHECKLIST  
(2019 SUPPLEMENT effective July 1, 2021)

**Application:** This checklist shall be used for nonresidential projects that meet one of the following: new construction, building additions of 1,000 square feet or greater, or building alterations with a permit valuation of \$200,000 or more pursuant to Section 301.3 AND do not trigger a Tier 1 or Tier 2 requirement:

**Y** = Yes (section has been selected and/or included)  
**N/A** = Not Applicable (code section does not apply to the project—mainly used for additions and alterations)  
**O** = Other (provide explanation)  
**[N]** = New construction pursuant to Section 301.3  
**[A]** = Additions and/or Alterations pursuant to Section 301.3

Chapter 5 Divisions

DIVISION 5.1 Planning and Design

Requirement	SECTION TITLE	CODE SECTION	Y	N	N/A	O	PLAN SHEET, SPEC, OR ATTACH REFERENCE
Mandatory	Storm water pollution prevention for projects that disturb less than 1 acre of land	5.106.1 through 5.106.2			X		
Mandatory	Short-term bicycle parking (with exception)	5.106.4.1.1	X				SEE SHEET A1.0
Mandatory	Long-term bicycle parking	5.106.4.1.2 through 5.106.4.1.5	X				SEE SHEET A1.0
Mandatory	Designated parking for clean air vehicles with footnote and note	5.106.5.2	X				SEE SHEET A1.0
Mandatory	Parking stall marking	5.106.5.2.1	X				SEE SHEET A1.0, NOTE 3
Mandatory	Single charging space requirements	5.106.5.3.1			X		
Mandatory	Multiple charging space requirements [N]	5.106.5.3.2	X				SEE ELECTRICAL PLANS FOR FUTURE CHARGING PROVISIONS
Mandatory	EV charging space calculation [N] (with exceptions)	5.106.5.3.3	X				13 OF THE 18 STALLS REQUIRE FUTURE CHARGING PROVISIONS, SEE

Requirement	SECTION TITLE	CODE SECTION	Y	N	N/A	O	PLAN SHEET, SPEC, OR ATTACH REFERENCE
Mandatory	Basis of Design (BOD) [N]	5.410.2.2			X		
Mandatory	Commissioning plan [N]	5.410.2.3			X		
Mandatory	Functional performance testing [N]	5.410.2.4			X		
Mandatory	Documentation and training [N]	5.410.2.5			X		
Mandatory	Systems manual [N]	5.410.2.5.1			X		
Mandatory	Systems operation training [N]	5.410.2.5.2			X		
Mandatory	Commissioning report [N]	5.410.2.6			X		
Mandatory	Testing and adjusting for new buildings < 10,000 sf or new systems that serve additions or alterations [A]	5.410.4	X				MECH. CONTRACTOR TO PROVIDE TESTING AND ADJUSTING FOR CONDITIONED SPACES
Mandatory	System testing plan for renewable energy, landscape irrigation and water reuse [A]	5.410.4.2	X				SEE LANDSCAPING PLANS FOR IRRIGATION REQUIREMENTS.
Mandatory	Procedures for testing and adjusting	5.410.4.3	X				
Mandatory	Procedures for HVAC balancing	5.410.4.3.1	X				
Mandatory	Reporting for testing and adjusting	5.410.4.4	X				
Mandatory	Operation and maintenance (O&M) manual	5.410.4.5	X				
Mandatory	Inspection and reports	5.410.4.5.1					PROV. IF REQUIRED BY AHJ

DIVISION 5.5 Environmental Quality

Requirement	SECTION TITLE	CODE SECTION	Y	N	N/A	O	PLAN SHEET, SPEC, OR ATTACH REFERENCE
Mandatory	Fireplaces	5.503.1			X		

Requirement	SECTION TITLE	CODE SECTION	Y	N	N/A	O	PLAN SHEET, SPEC, OR ATTACH REFERENCE
							ELECTRICAL SITE PLAN.
Mandatory	[N] Identification	5.106.5.3.4	X				SEE ELECTRICAL PLANS FOR SERVICE PANEL CIRCUIT IDENTIFICATION
Mandatory	[N] Future charging spaces with note	5.106.5.3.5	X				SEE SHEET A1.0, NOTE 3
Mandatory	Light pollution reduction [N] (with exceptions, notes and table)	5.106.8	X				SEE ELECTRICAL PLANS FOR OUTDOOR LIGHTING SCHED.
Mandatory	Grading and paving (exception for additions and alterations not altering the drainage path)	5.106.10	X				SEE CIVIL GRADING PLAN

DIVISION 5.2 Energy Efficiency

Requirement	SECTION TITLE	CODE SECTION	Y	N	N/A	O	PLAN SHEET, SPEC, OR ATTACH REFERENCE
Mandatory	Meet the minimum energy efficiency standard	5.201.1	X				SEE TITLE 24 REPORT

DIVISION 5.3 Water Efficiency and Conservation

Requirement	SECTION TITLE	CODE SECTION	Y	N	N/A	O	PLAN SHEET, SPEC, OR ATTACH REFERENCE
Mandatory	Separate meters (new buildings or additions > 50,000 sf that consume more than 100 gal/day)	5.303.1.1			X		
Mandatory	Separate meters (for tenants in new buildings or additions that consume more than 1,000 gal/day)	5.303.1.2			X		
Mandatory	Water closets shall not exceed 1.28 gallons per flush (gpf)	5.303.3.1	X				SEE PLUMBING PLANS FOR FIXTURE SCHEDULE

Requirement	SECTION TITLE	CODE SECTION	Y	N	N/A	O	PLAN SHEET, SPEC, OR ATTACH REFERENCE
Mandatory	Woodstoves	5.503.1.1			X		
Mandatory	Temporary ventilation	5.504.1			X		
Mandatory	Covering of ducts openings and protection of mechanical equipment during construction	5.504.3	X				MECH. CONTRACTOR TO COMPLY
Mandatory	Adhesives, sealants, and caulks	5.504.4.1	X				SEE PRODUCT REQUIREMENTS ON SHEET G3.2
Mandatory	Paints and coatings	5.504.4.3	X				SEE PRODUCT REQUIREMENTS ON SHEET G3.2
Mandatory	Aerosol paints and coatings	5.504.4.3.1	X				SEE PRODUCT REQUIREMENTS ON SHEET G3.2
Mandatory	Aerosol paints and coatings: verification	5.504.4.3.2	X				PROVIDE DOCUMENTATION TO AHJ AS REQUIRED
Mandatory	Carpet systems	5.504.4.4			X		
Mandatory	Carpet cushion	5.504.4.4.1			X		
Mandatory	Carpet adhesives per Table 5.504.4.1	5.504.4.4.2			X		
Mandatory	Composite wood products	5.504.4.5			X		
Mandatory	Composite wood products: documentation	5.504.4.5.3			X		
Mandatory	Resilient flooring systems	5.504.4.6	X				SEE PRODUCT REQUIREMENTS ON SHEET G3.2
Mandatory	Resilient flooring: verification of compliance	5.504.4.6.1	X				PROVIDE DOCUMENTATION TO AHJ AS REQUIRED
Mandatory	Filters (with exceptions)	5.504.5.3	X				PROV. MERV 13 FILTERS ON ALL NEW VENTILATION EQUIP.
Mandatory	Filters: labeling	5.504.5.3.1	X				VERIFY LABELS CLEARLY SPECIFY MERV RATING.
Mandatory	Environmental tobacco smoke (ETS) control	5.504.7			X		
Mandatory	Indoor moisture control	5.505.1	X				DESIGN COMPLIES

Requirement	SECTION TITLE	CODE SECTION	Y	N	N/A	O	PLAN SHEET, SPEC, OR ATTACH REFERENCE
Mandatory	Wall-mounted urinals shall not exceed 0.125 gpf	5.303.3.2.1			X		
Mandatory	Floor-mounted urinals shall not exceed 0.5 gpf	5.303.3.2.2			X		
Mandatory	Single showerhead shall have maximum flow rate of 1.8 gpm (gallons per minute) at 80 psi	5.303.3.3.1			X		
Mandatory	Multiple showerheads serving one shower shall have a combined flow rate of 1.8 gpm at 80 psi	5.303.3.3.2			X		
Mandatory	Nonresidential lavatory faucets	5.303.3.4.1	X				SEE PLUMBING SCHED. ON P1.0 FOR COMPLIANT FIXTURES
Mandatory	Kitchen faucets	5.303.3.4.2			X		
Mandatory	Wash fountains	5.303.3.4.3			X		
Mandatory	Metering faucets	5.303.3.4.4			X		
Mandatory	Metering faucets for wash fountains	5.303.3.4.5			X		
Mandatory	Pre-rinse spray valve	5.303.3.4.6			X		
Mandatory	Food waste disposers	5.303.4.1			X		
Mandatory	Areas of additions or alterations	5.303.5			X		
Mandatory	Standards for plumbing fixtures and fittings	5.303.6	X				SEE PLUMBING SCHED. ON P1.0 FOR COMPLIANT FIXTURES
Mandatory	Outdoor potable water use in landscape areas (with notes)	5.304.1					SEE LANDSCAPING PLANS

Requirement	SECTION TITLE	CODE SECTION	Y	N	N/A	O	PLAN SHEET, SPEC, OR ATTACH REFERENCE
Mandatory	Outside air delivery	5.506.1	X				SEE MECH. DWGS.
Mandatory	Carbon dioxide (CO2) monitoring	5.506.2	X				SEE MECH. DWGS.
Mandatory	Acoustical control (with exception)	5.507.4			X		
Mandatory	Exterior noise transmission, prescriptive method (with exceptions)	5.507.4.1			X		
Mandatory	Noise exposure where noise contours are not readily available	5.507.4.1.1			X		
Mandatory	Performance method	5.507.4.2			X		
Mandatory	Site features	5.507.4.2.1			X		
Mandatory	Documentation of compliance	5.507.4.2.2			X		
Mandatory	Interior sound transmission (with note)	5.507.4.3			X		
Mandatory	Ozone depletion and greenhouse gas reductions	5.508.1	X				SEE MECH.
Mandatory	Chlorofluorocarbons (CFCs)	5.508.1.1			X		
Mandatory	Halons	5.508.1.2			X		
Mandatory	Supermarket refrigerant leak reduction for retail food stores 8,000 square feet or more	5.508.2 through 5.508.2.6.3			X		
	END OF MANDATORY PROVISIONS						

DIVISION 5.4 Material Conservation and Resource Efficiency							
Requirement	SECTION TITLE	CODE SECTION	Y	N	N/A	O	PLAN SHEET, SPEC, OR ATTACH REFERENCE
Mandatory	Weather protection	5.407.1	X				SEE ARCH. PLANS FOR WEATHER-RESISTANT EXT. WALL CONST.
Mandatory	Moisture control: sprinklers	5.407.2.1	X				SEE LANDSCAPING PLANS.
Mandatory	Moisture control: exterior door protection	5.407.2.2.1	X				OVERHANGS PROVIDED
Mandatory	Moisture control: flashing	5.407.2.2.2	X				SEE PEMB DRAWINGS FOR BLDG. FLASHINGS
Mandatory	Construction waste management—comply with either: Sections 5.408.1.1, 5.408.1.2, 5.408.1.3 or more stringent local ordinance	5.408.1.1, 5.408.1.2, 5.408.1.3	X				CONTRACTOR IS TO SUBMIT WASTE MANAGEMENT PLAN FOR CONSTRUCTION GENERATED WASTE PRIOR TO START OF WORK
Mandatory	Construction waste management: documentation	5.408.1.4	X				PROVIDE CITY OF MADERA REQUIRED DOCUMENTATION
Mandatory	Universal waste [A]	5.408.2			X		
Mandatory	Excavated soil and land clearing debris (100% reuse or recycle)	5.408.3	X				
Mandatory	Recycling by occupants (with exception)	5.410.1	X				RECYCLING BINS TO BE PROVIDED AT DUMPSTER ENCLOSURES
Mandatory	Recycling by occupants: additions (with exception)	5.410.1.1			X		
Mandatory	Recycling by occupants: sample ordinance	5.410.1.2	X				RECYCLING BINS TO BE PROVIDED AT DUMPSTER ENCLOSURES
Mandatory	Commissioning new buildings (≥ 10,000 sf) [N]	5.410.2			X		CONDITIONED SPACES FOR BLDG.'S LESS THAN 10,000 SF
Mandatory	Owner's or owner representative's Project Requirements (OPR) [N]	5.410.2.1			X		

Documentation Author's / Responsible Designer's Declaration Statement	
<input type="checkbox"/> Mandatory: I attest that this mandatory provisions checklist is accurate and complete.	
Signature: <i>Robert A. Tarkood</i>	Date: 2/28/2022
Company: DBKO DESIGN+BUILD, LLC	License: S5607
Address: 3406 VIA LIDO, STE 1A 24	Phone: 619.307.9770
City/State/Zip: NEWPORT BEACH, CA 92663	

2019CBC  
City of Madera  
Building Department  
The approval of these plans does not prevent the City of Madera from requiring correction of errors or omissions in the plans, specifications, or construction. Subject to field verification and approval of the City Engineer.

APPROVED  
By: *[Signature]*  
Date: MAR 03 2022



WHSE  
[PARTNERS]

By: \_\_\_\_\_  
REVISION  
DATE  
SEAL  
REGISTERED PROFESSIONAL ENGINEER  
ROBERT A. TARKOOD  
S5607  
STRUCTURAL  
STATE OF CALIFORNIA  
1/18/2022


CALGREEN (SHEET 4 OF 4)  
LEASE FLEX. / WAREHOUSE BUILDINGS  
FOR  
MADERA INDUSTRIAL WHSE, LLC  
S. SCHNOOR AVENUE, MADERA, CA

JOB NUMBER: 21107  
DESIGNED BY: RT  
DRAWN BY:  
DATE: 2/28/2022  
SHEET NUMBER: G3.3



1. ACCESSIBLE PATH OF TRAVEL TO ENTRANCES (MAX. SLOPE OF 5% PERMITTED IN THE DIRECTION OF TRAVEL AND MAX. 2% CROSS-SLOPE PERPENDICULAR TO THE DIRECTION OF TRAVEL).
2. SEE SHEET A1.1 FOR ACCESSIBLE PARKING STALL DETAILS.
3. CLEAN AIR VEHICLE PARKING STALLS - BASED ON THE NUMBER OF PARKING STALLS PROVIDED, 18 STALLS ARE TO BE DESIGNATED FOR CLEAN AIR VEHICLES - WHERE AN "A" IS DENOTED AT A STALL THE FOLLOWING TEXT IS TO BE PLACED SUCH THAT THE LOWER EDGE OF THE SECOND ROW OF TEXT IS ALIGNED WITH THE END OF THE STALL STRIPING AND IS VISIBLE BENEATH A PARKED VEHICLE:

4. FOR CITY OF MADERA STANDARD CMU TRASH ENCLOSURE CONSTRUCTION, SEE SHEET A1.1. IN ADDITION, TRASH ENCLOSURES ARE TO MEET ALL CLEARANCES AND ACCESS REQUIREMENTS OF MID-VALLEY DISPOSAL.

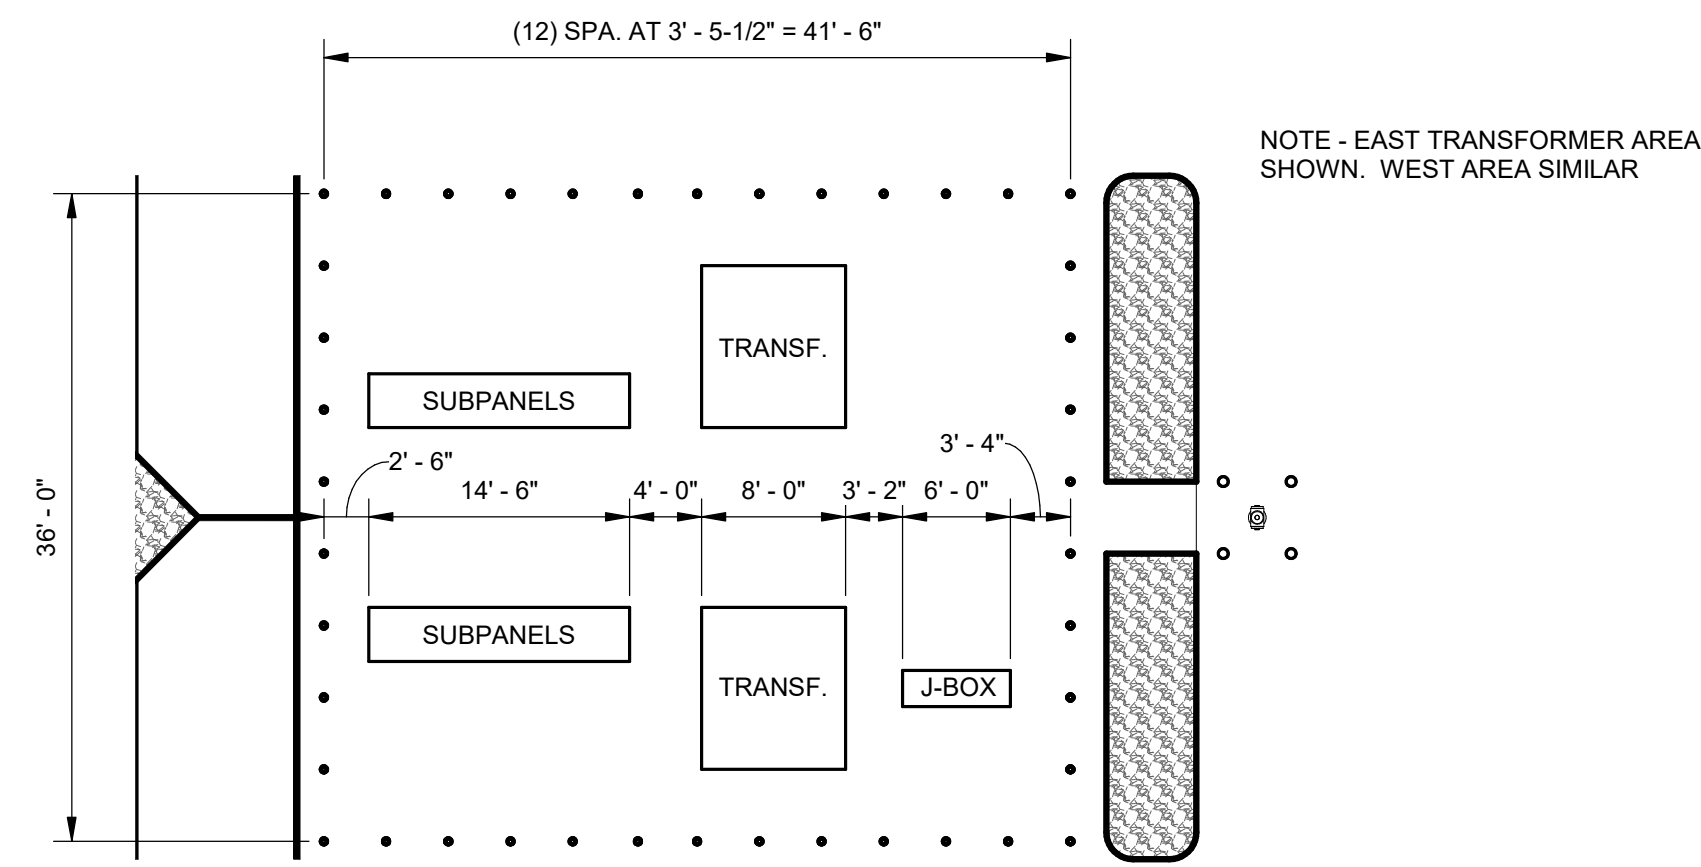

**CITY OF MADERA OFF-STREET PARKING REQUIREMENTS (MUNICIPAL CODE SECTION 10-3.1202):**

PARKING SPACES REQUIRED  
ONE SPACE FOR EACH TWO EMPLOYEES, PLUS ONE SPACE  
FOR EACH 300 SQUARE FEET OF OFFICE SPACE AND  
CUSTOMER NET FLOOR AREA, PLUS ONE LOADING SPACE FOR  
EACH 10,000 SQUARE FEET OF GROSS FLOOR AREA


STANDARD STALLS - 9'x19'

124 SPACES PROVIDED

LOADING SPACES - 10'x35'

**24 LOADING SPACES PROVIDED**

2 PARTIAL PLAN AT TRANSFORMER YARD  
A1.0 3/32" = 1'-0"

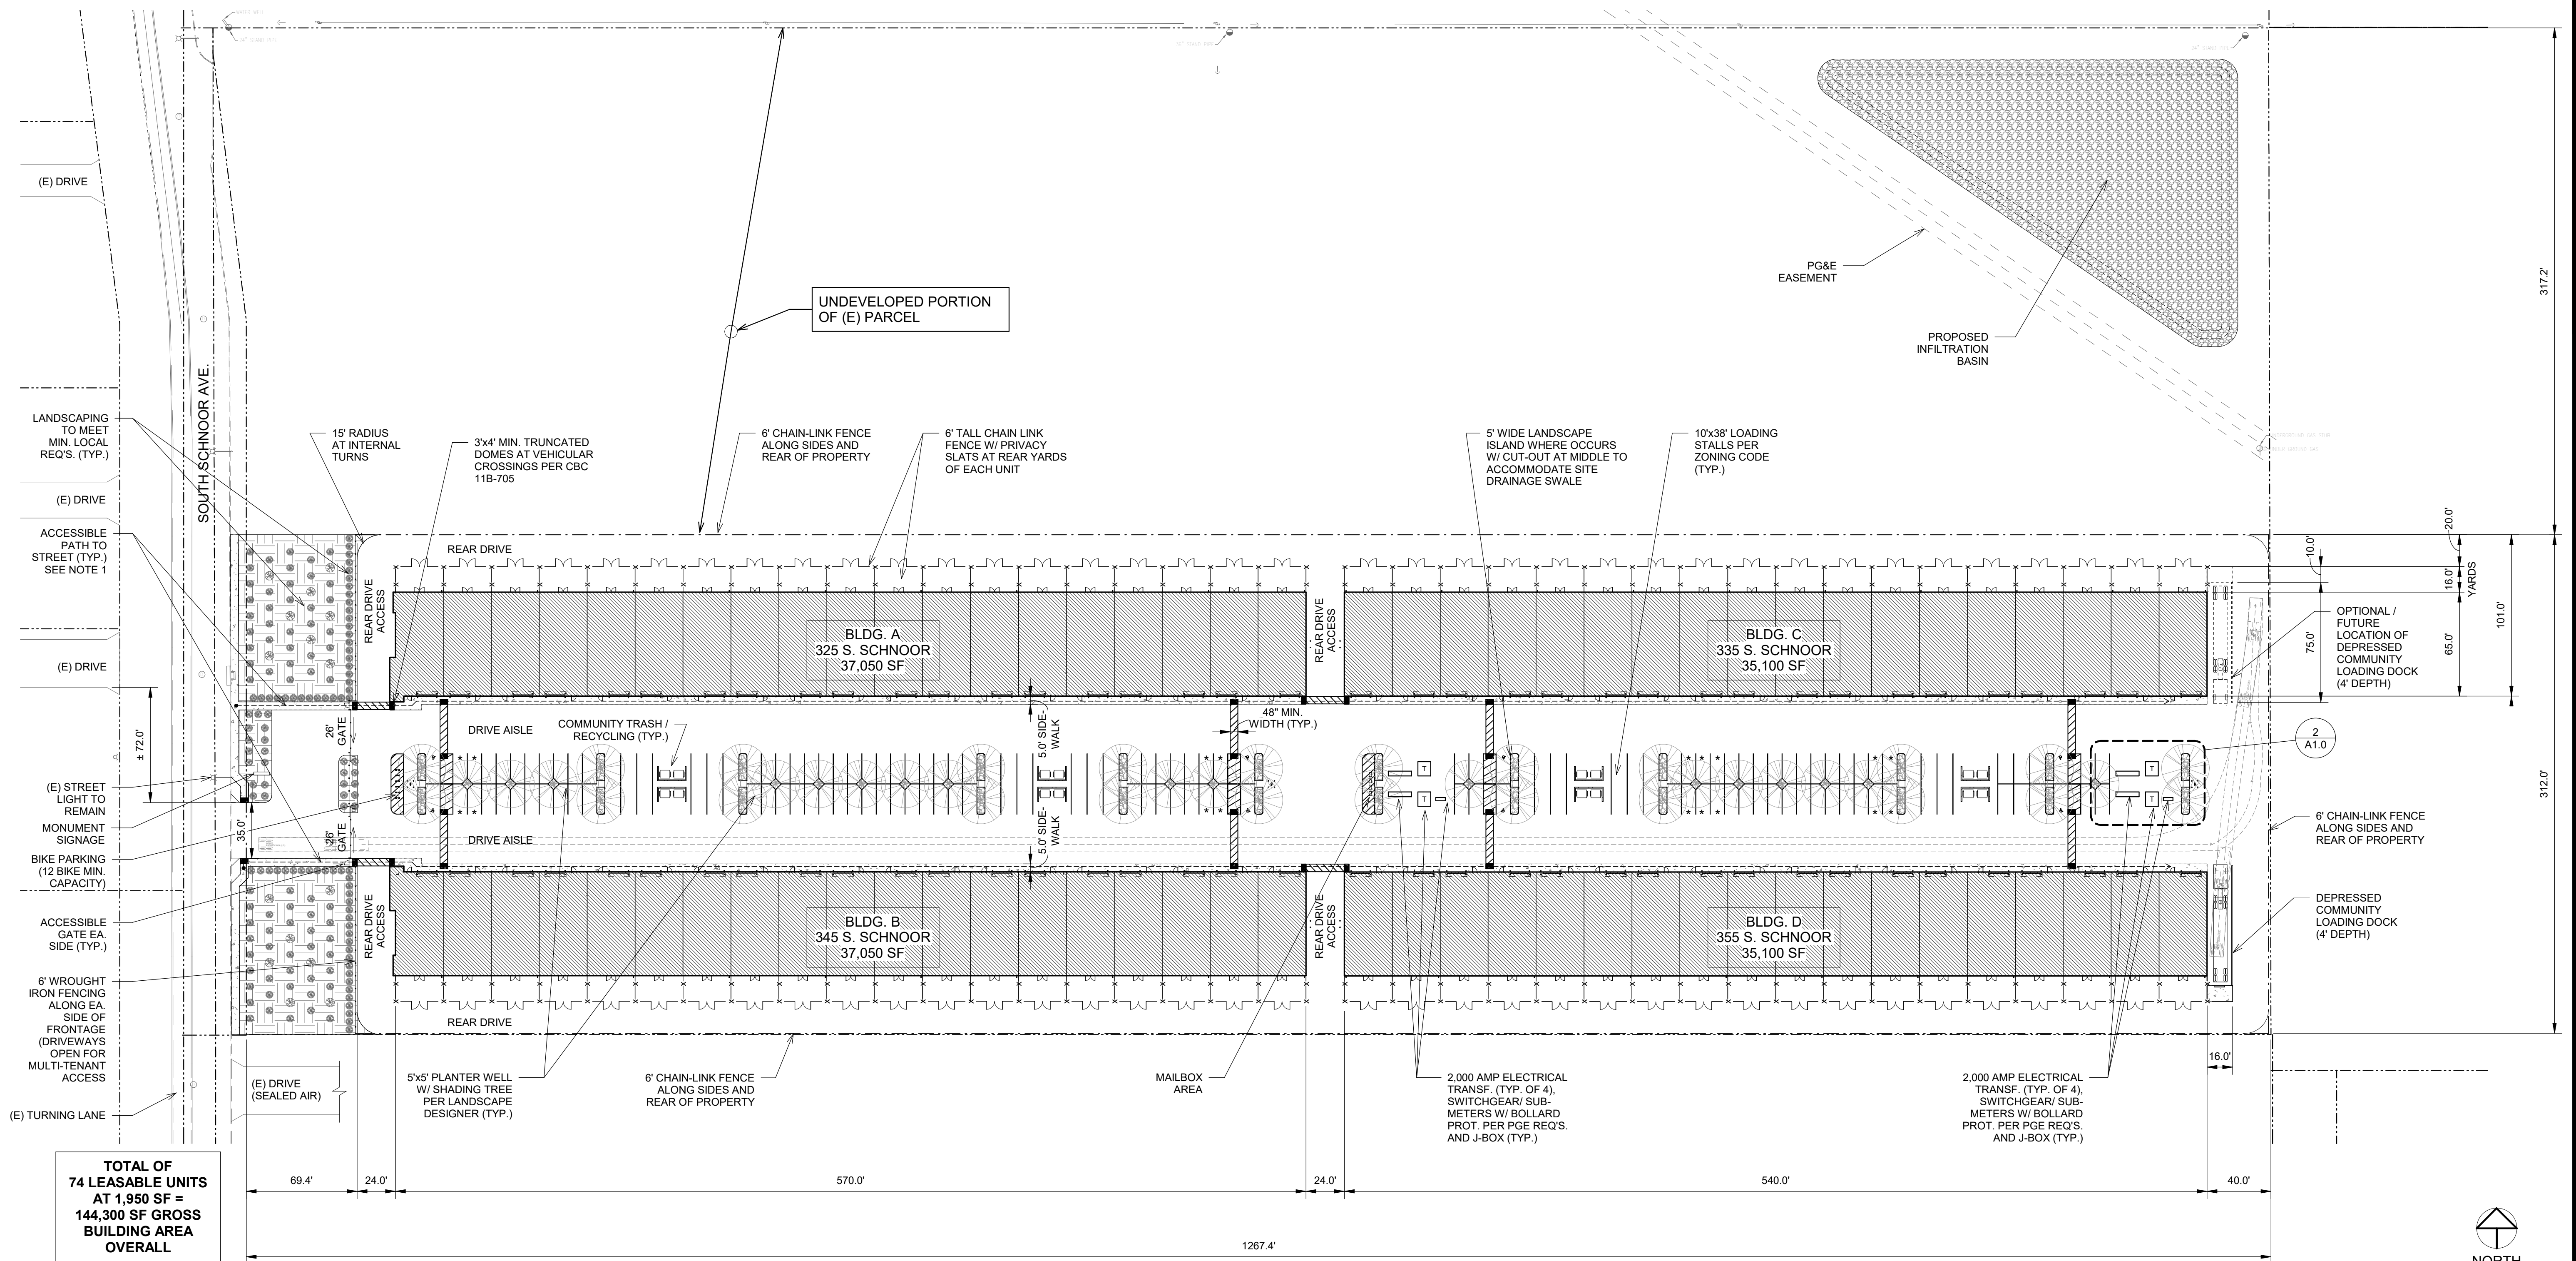

1 SITE PLAN  
A1.0 1" = 50'-0"



11/17/2021	2	PLAN CHECK RESPONSE	ANY INFORMATION OR DATA ON THIS DRAWING IS NOT INTENDED TO BE SUITABLE FOR REUSE BY ANY PERSON, OR FOR ANY PURPOSES OTHER THAN THE SPECIFIC PURPOSES FOR WHICH IT WAS PREPARED. 
2/1/2022	3	PAGE UPDATES	




**LEASE FLEX. / WAREHOUSE BUILDINGS**

**FOR**

**MADERA INDUSTRIAL WHSE, LLC**


**S. SCHNOOR AVENUE, MADERA, CA**

NUMBER	21107
IGNED BY	RT
OWN BY	LM
DATE	9/17/2021
ET NUMBER	

## A1.0





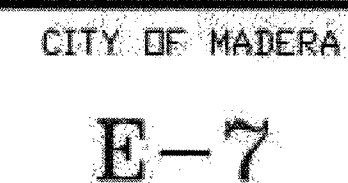



11/17/2021	2	PLAN CHECK RESPONSE	<p>ANY INFORMATION OR DATA ON THIS DRAWING IS NOT INTENDED TO BE SUITABLE FOR REUSE BY ANY PERSON, FIRM, CORPORATION, OR ANY OTHERS ON EXTENSIONS OF THIS PROJECT OR FOR ANY USE ON ANY OTHER PROJECT. ANY REUSE WITHOUT WRITTEN VERIFICATION AND ADAPTATION BY THE ENGINEER FOR THE SPECIFIC PURPOSE INTENDED WILL BE AT THE USER'S SOLE RISK AND WITHOUT LIABILITY OR LEGAL EXPOSURE TO THE ENGINEER.</p>
2/28/2022	4	PC RESPONSE	



**FIRE SITE PLAN**

**LEASE FLEX. / WAREHOUSE BUILDINGS**

**FOR**

**MADERA INDUSTRIAL WHSE, LLC**


**S. SCHNOOR AVENUE, MADERA, CA**

ISS NUMBER	21107
SIGNED BY	RT
DRAWN BY	CD
DATE	11/17/2021

## A1.2



01	FIRE LANE / FIRE TRUCK ACCESS PATH
02	NEW SITE FIRE HYDRANT W/ BOLLARD PROTECTION
03	(E) HYDRANT ALONG FRONTAGE ROADWAY
04	MIN. 28' RADIUS AT INSIDE OF FIRE ACCESS PATH
05	"NO PARKING / FIRE LANE SIGN" (SIZE AND HEIGHT PER APPLICABLE CITY STANDARDS) ALONG BOTH REAR DRIVES AND FRONT AND MIDDLE REAR ACCESS DRIVES AT 60' O.C. MAX. SPACING
06	FIRE SPRINKLER RISER / FIRE DEPT. CONN. (FDC) W/ BOLLARD PROTECTION
07	HAMMERHEAD TURN-AROUND FOR FIRE TRUCK MANEUVERABILITY
08	"NO PARKING / FIRE LANE" SIGN (SIZE AND HEIGHT PER APPLICABLE CITY STANDARDS) MOUNTED TO REAR/EAST FENCE AT 60' MAX. SPACING

FIRE FLOW AND DURATION BASED ON SUM OF BUILDING AREA = 144,576 SF (TYPE IIB CONSTRUCTION, FULLY SPRINKLERED)  
PER CFC TABLE B105.2, FIRE FLOW = 25% OF 8,000 GPM = 2,000 GPM AT DURATION OF 2 HOURS (TABLE B105.1(2))  
MIN. NUMBER OF HYDRANTS AT 2,000 GPM = MIN. 2 HYDRANTS AT 450x1.5 = 675 FT. MAX. SPACING (578 FT PROVIDED)

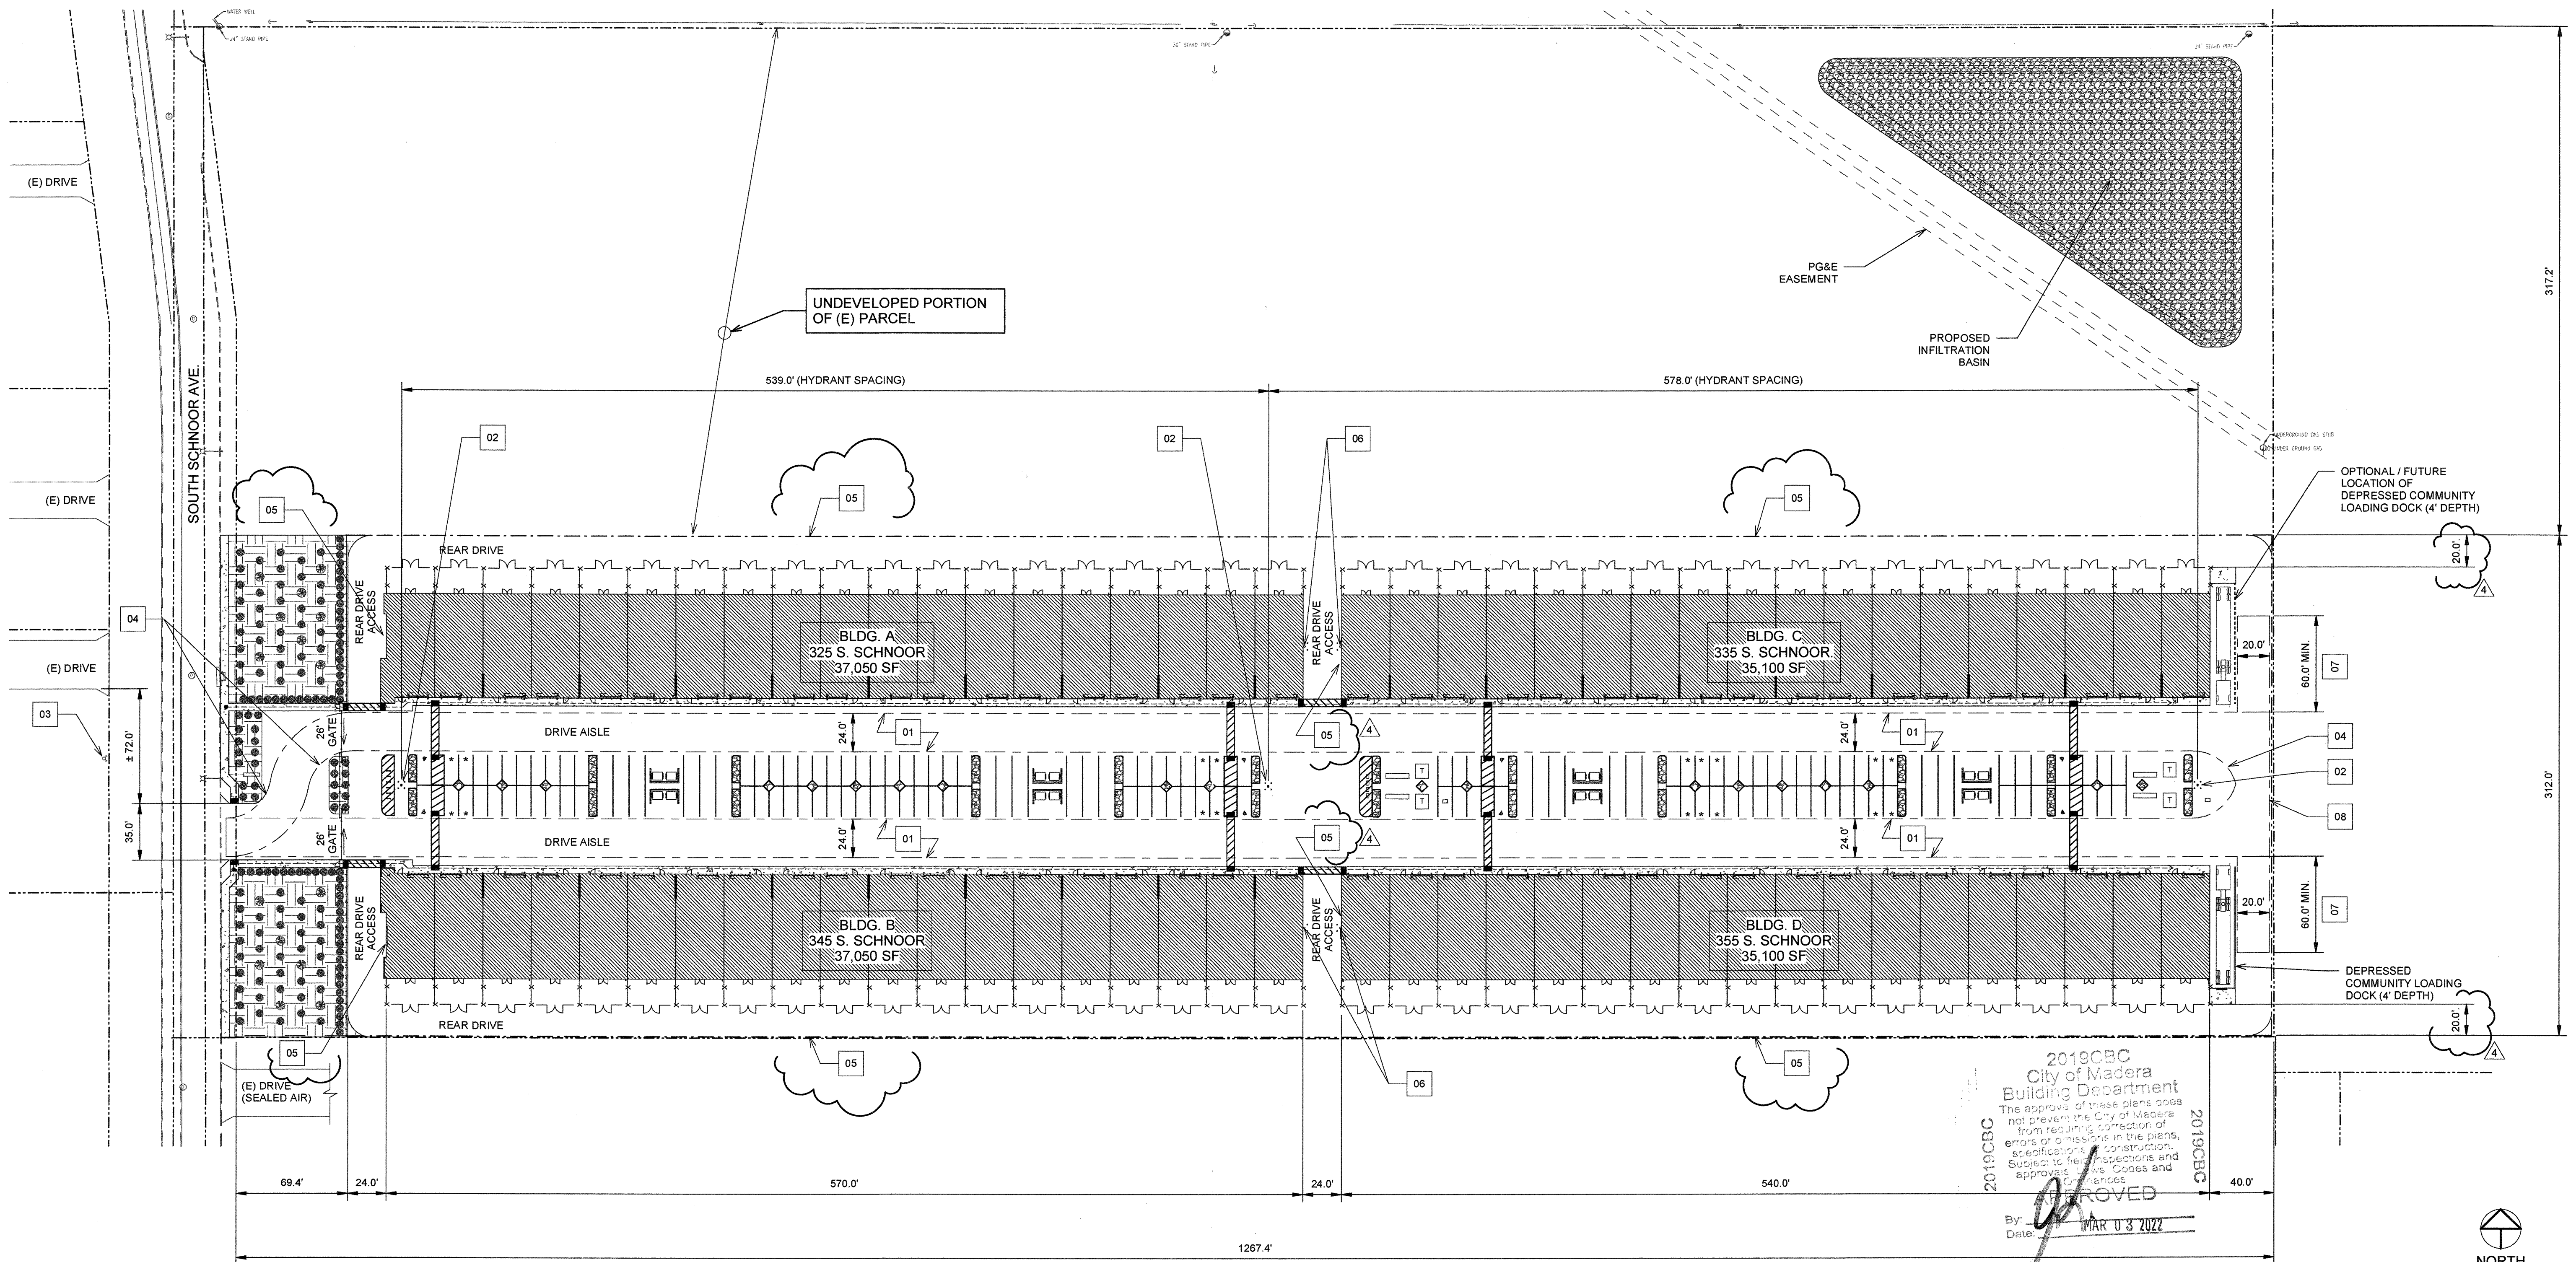

1 FIRE SITE PLAN  
A1.2 1" = 50'-0"




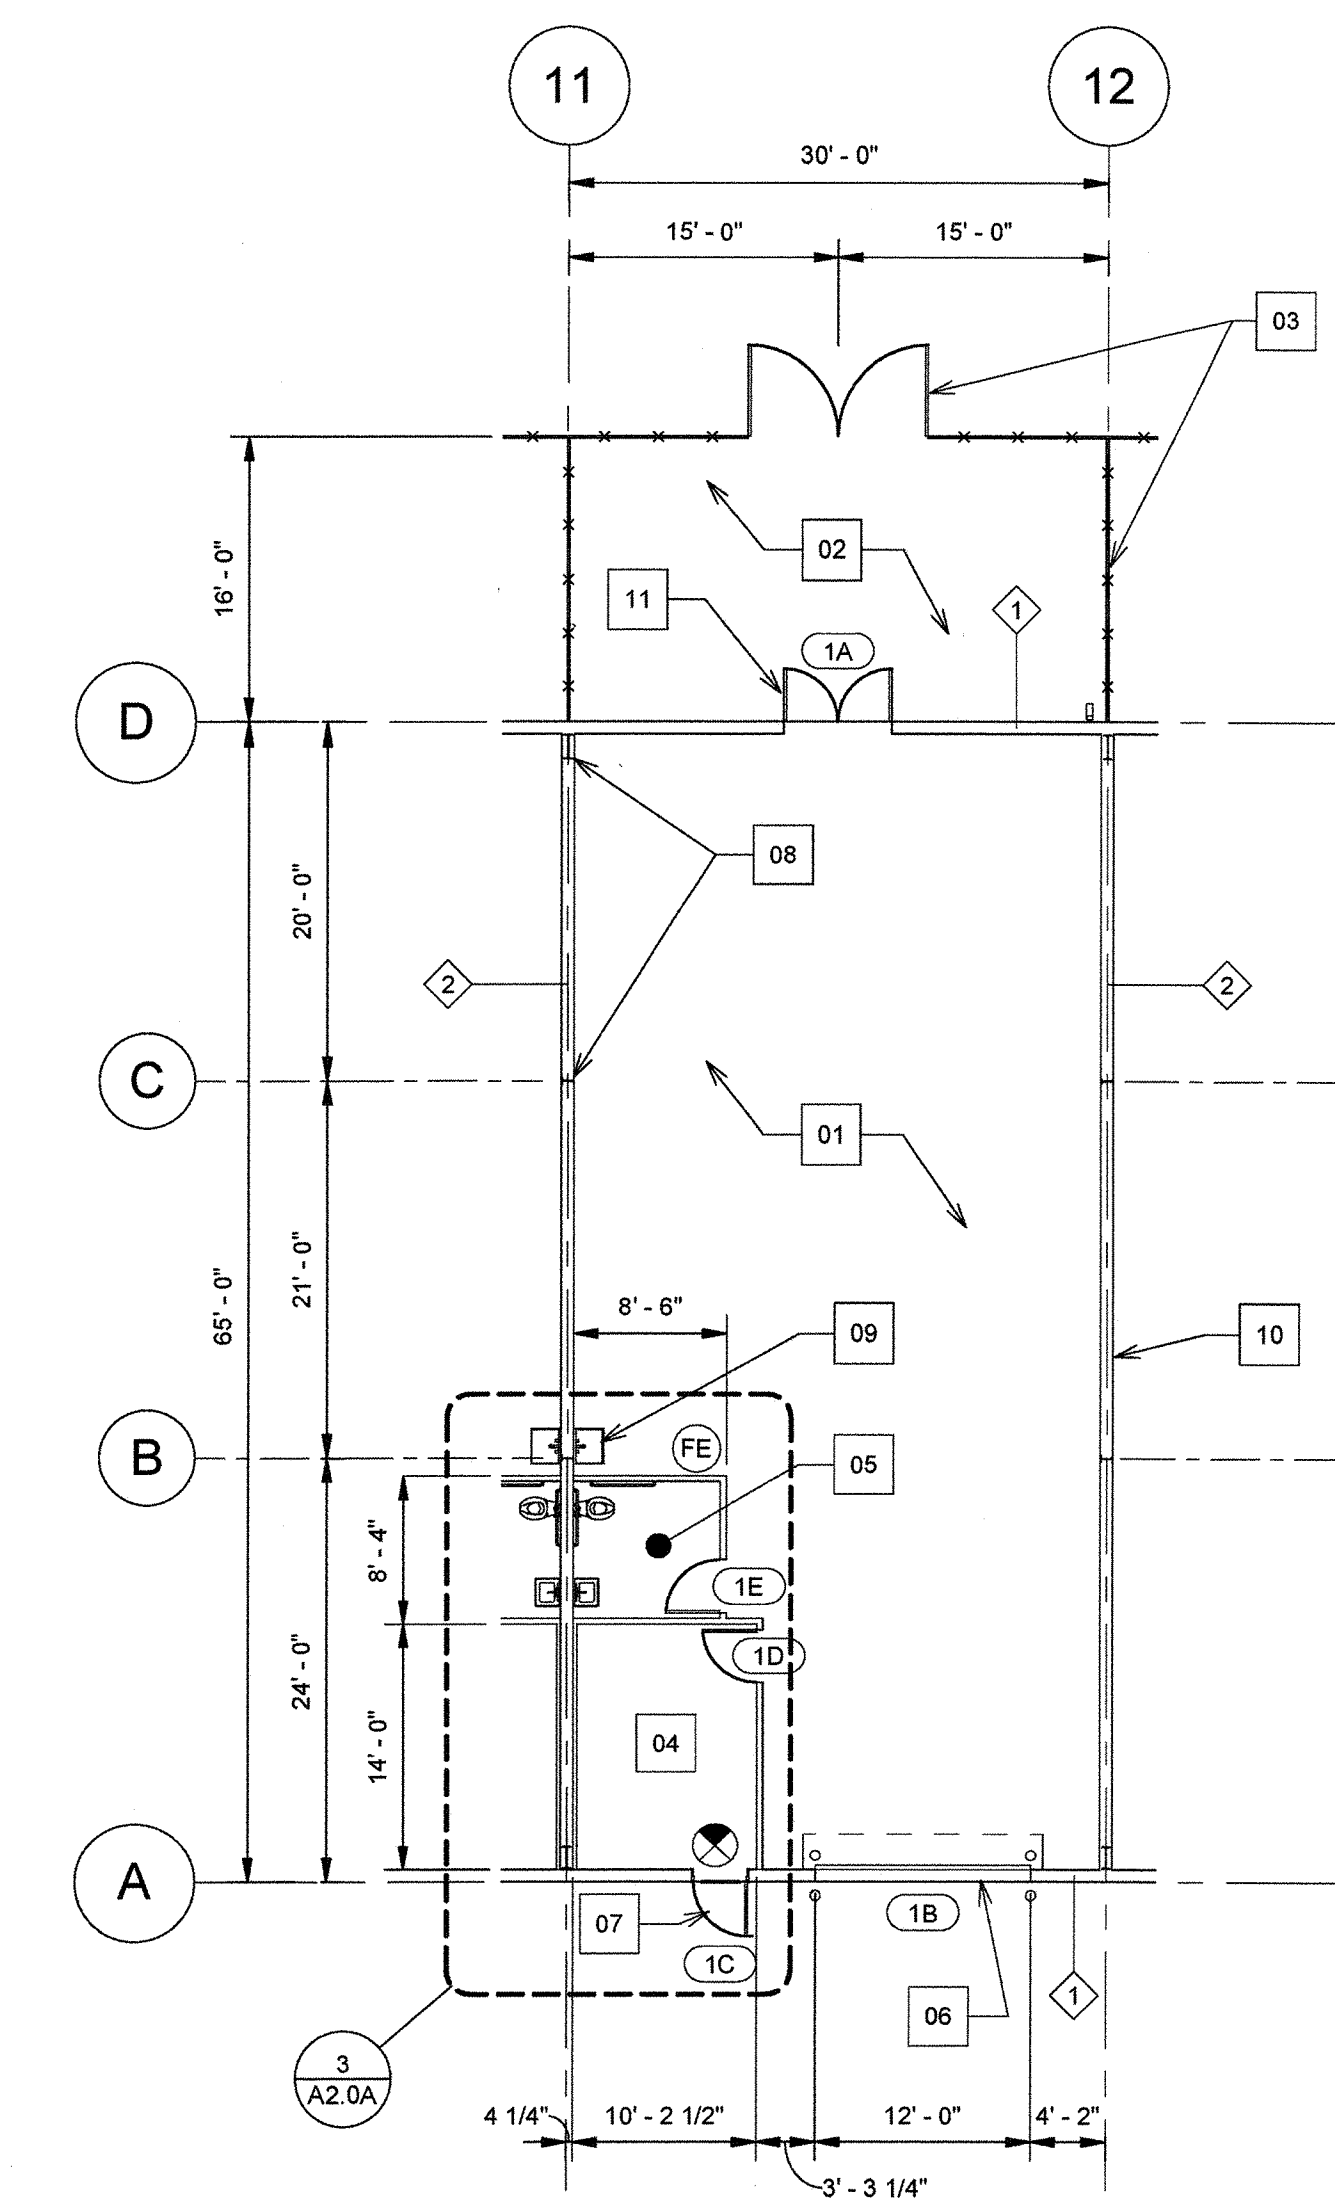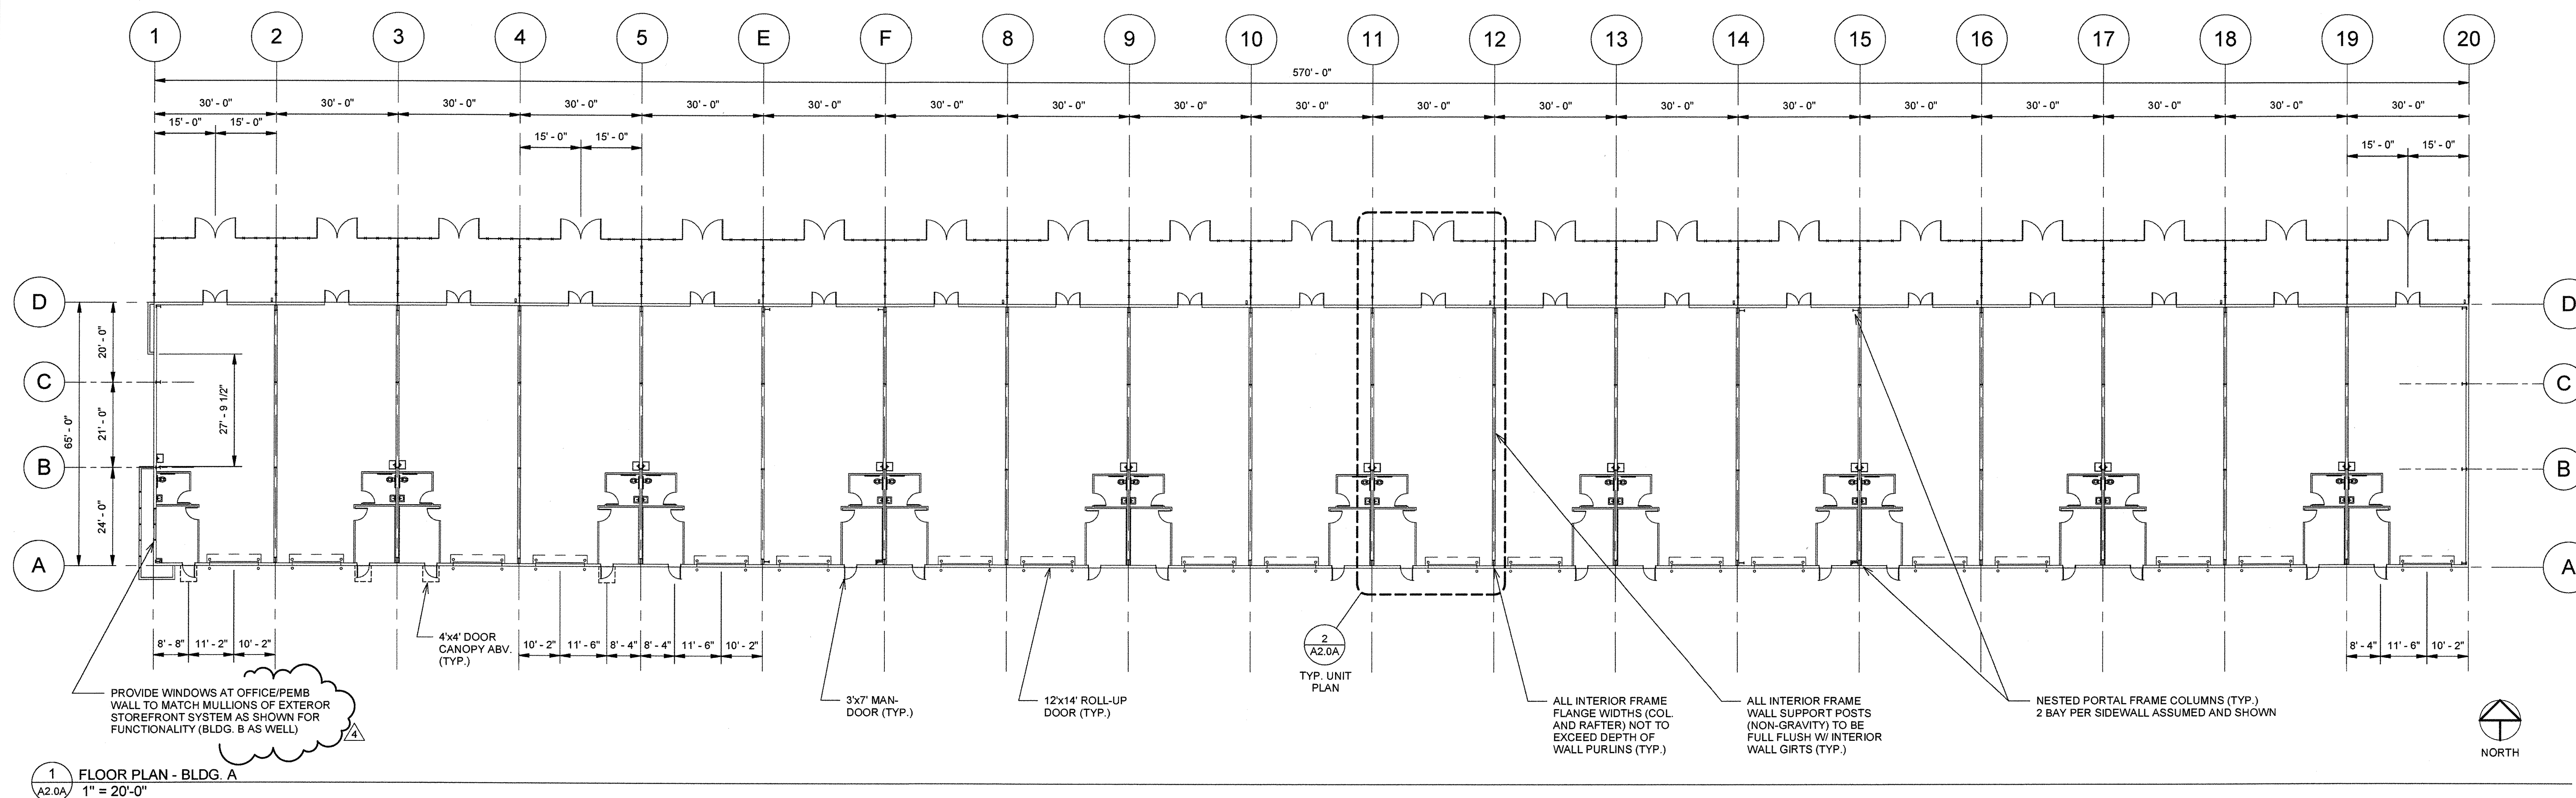

2 TYP. UNIT FLOOR PLAN  
A2.0A 3/32" = 1'-0"


## FLOOR PLAN KEYNOTES

- |    |   |
|----|---|
| 01 | WAREHOUSE AREA W/ ROOF MOUNTED EVAP. COOLER AND SUSPENDED UNIT HEATER (CONSIDERED UNCONDITIONED SPACE DUE TO BTU'S) AND ONE (1) ROOF SKYLIGHT |
| 02 | INTERIOR SECURED STORAGE AREA / YARD  |
| 03 | CHAINLINK FENCE W/ PRIVACY SLATS (6' HEIGHT) AND DOUBLE LEAF (5' LEAFS) ACCESS GATE   |
| 04 | OFFICE AREA (CONDITIONED)   |
| 05 | ACCESSIBLE RESTROOM (W/ EXHAUST ONLY)   |
| 06 | 12'x14' ROLL-UP DOOR  |
| 07 | 3'x7' INSULATED DOOR W/ INTEGRAL HALF-LITE WINDOW W/ SECURITY GLAZING (WIRE REINFORCED)   |
| 08 | TYP. METAL BLDG. COLUMN WHERE OCCURS  |
| 09 | ACCESSIBLE STAINLESS STEEL HANDWASH SINK  |
| 10 | INTERIOR METAL PEMB GIRTS W/ ONE (1) LAYER 5/8" DRYWALL EA. SIDE AND ACOUSTICAL INSULATION FULL HT.   |
| 11 | 6'x7' DOUBLE LEAF DOOR  |

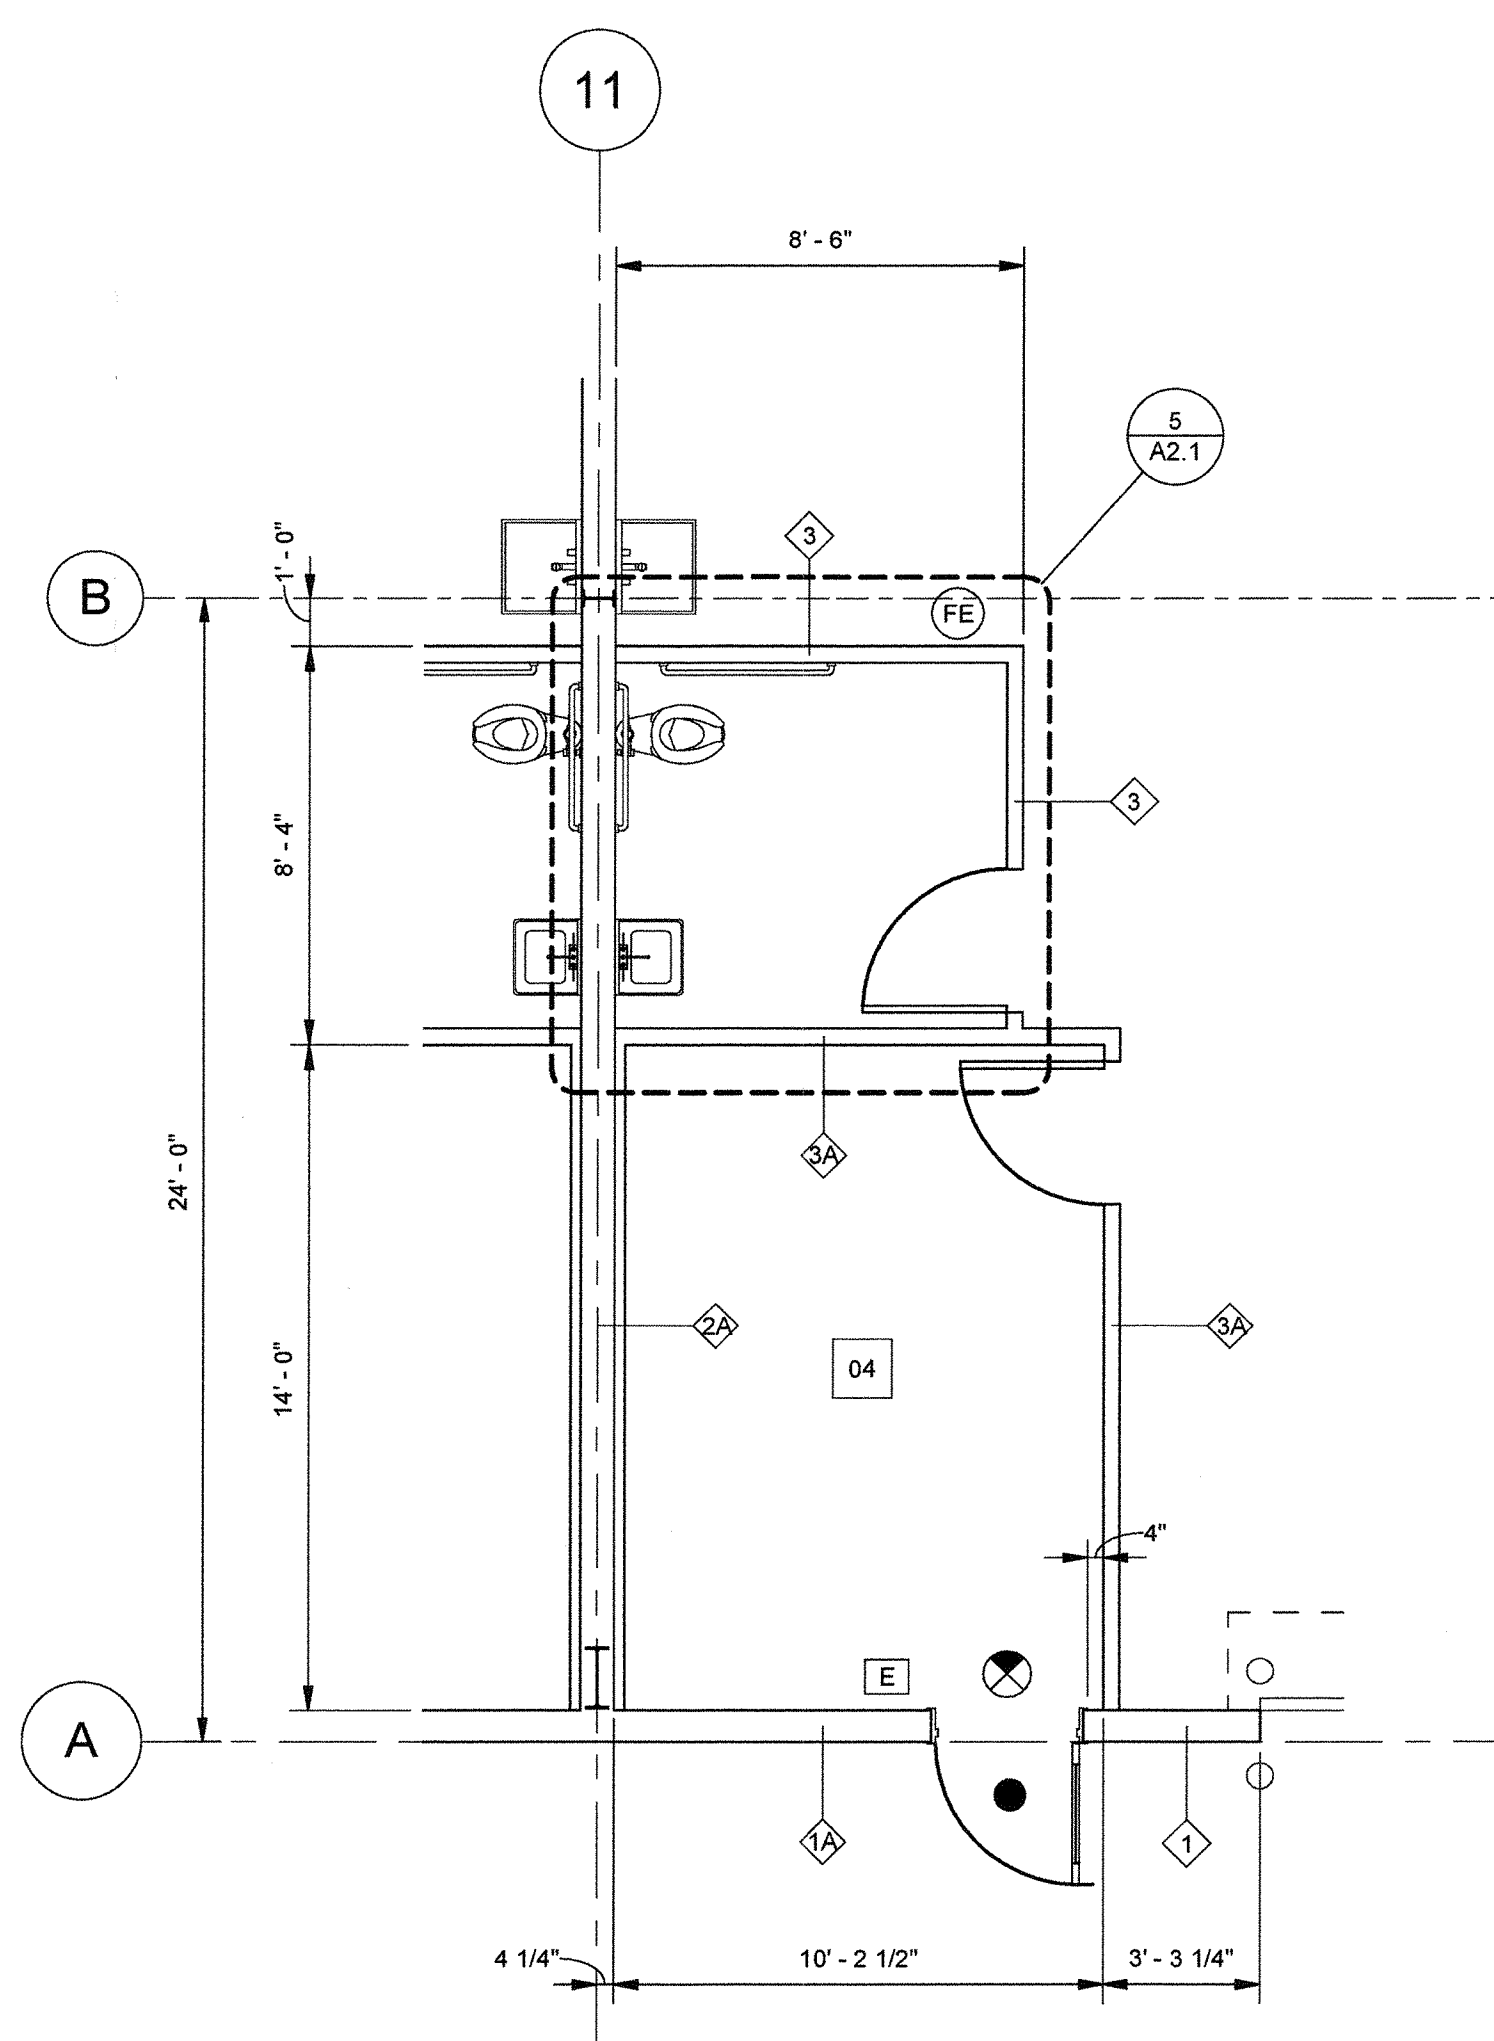










3 TYP. ENLARGED PLAN AT OFFICE / RESTROOM  
A2.0A 1/4" = 1'-0"

**TYP. FLOOR PLAN NOTES:**

 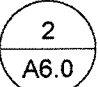
1. WHERE SIGNAGE PROVIDED AT DOORS IDENTIFYING ROOM NAMES, FUNCTIONS, OR NUMBERS, PROVIDE ACCESSIBLE SIGNAGE PER 
2. UNLESS NOTED OTHERWISE, ALL DIMENSIONS ARE TO CENTER OF WALL, FACE OF STUD, OR BUILDING LINE AS SHOWN.
3. UNLESS NOTED OTHERWISE, ALL DOORS ARE TO BE LOCATED 4" MIN. FROM ADJACENT PERPENDICULAR WALLS (HINGE SIDE).

**TYP. FLOOR PLAN LEGEND**

- |   |   |   |  |
|---|---|---|--|
|  | WALL PER  |  |  |
|  | TACTILE "EXIT" SIGN PER   |  |  |
|  | ILLUMINATED EXIT SIGN - FACE MOUNTED ON WALL ABOVE DOOR OR SUSPENDED FROM CEILING. SEE G1.0 FOR OTHER REQUIREMENTS  |   |  |
|   | SOLID FILL INDICATES ORIENTATION OF TEXT FACE   |   |  |
|  | ILLUMINATED DIRECTIONAL EXIT SIGN - FACE MOUNTED ON WALL OR SUSPENDED FROM CEILING WITH DIRECTIONAL ARROW INDICATING DIRECTION TO EXIT. SEE G1.0 FOR OTHER REQUIREMENTS |   |  |
|  | PORTABLE FIRE EXTINGUISHER. SEE G1.0 FOR REQUIREMENTS.  |   |  |
|  | EGRESS ILLUMINATION AT EXTERIOR LANDING EXIT (CBC 1006.3)   |   |  |

2019CBC  
City of Medera  
Building Department  
The approval of these plans does  
not prevent the City of Medera  
from requiring correction of  
errors or omissions in the plans,  
specifications or construction.  
Subject to field inspections and  
approvals of the Codes and  
Grading  
**APPROVED**  
By:   
Date: MAR 03 2022



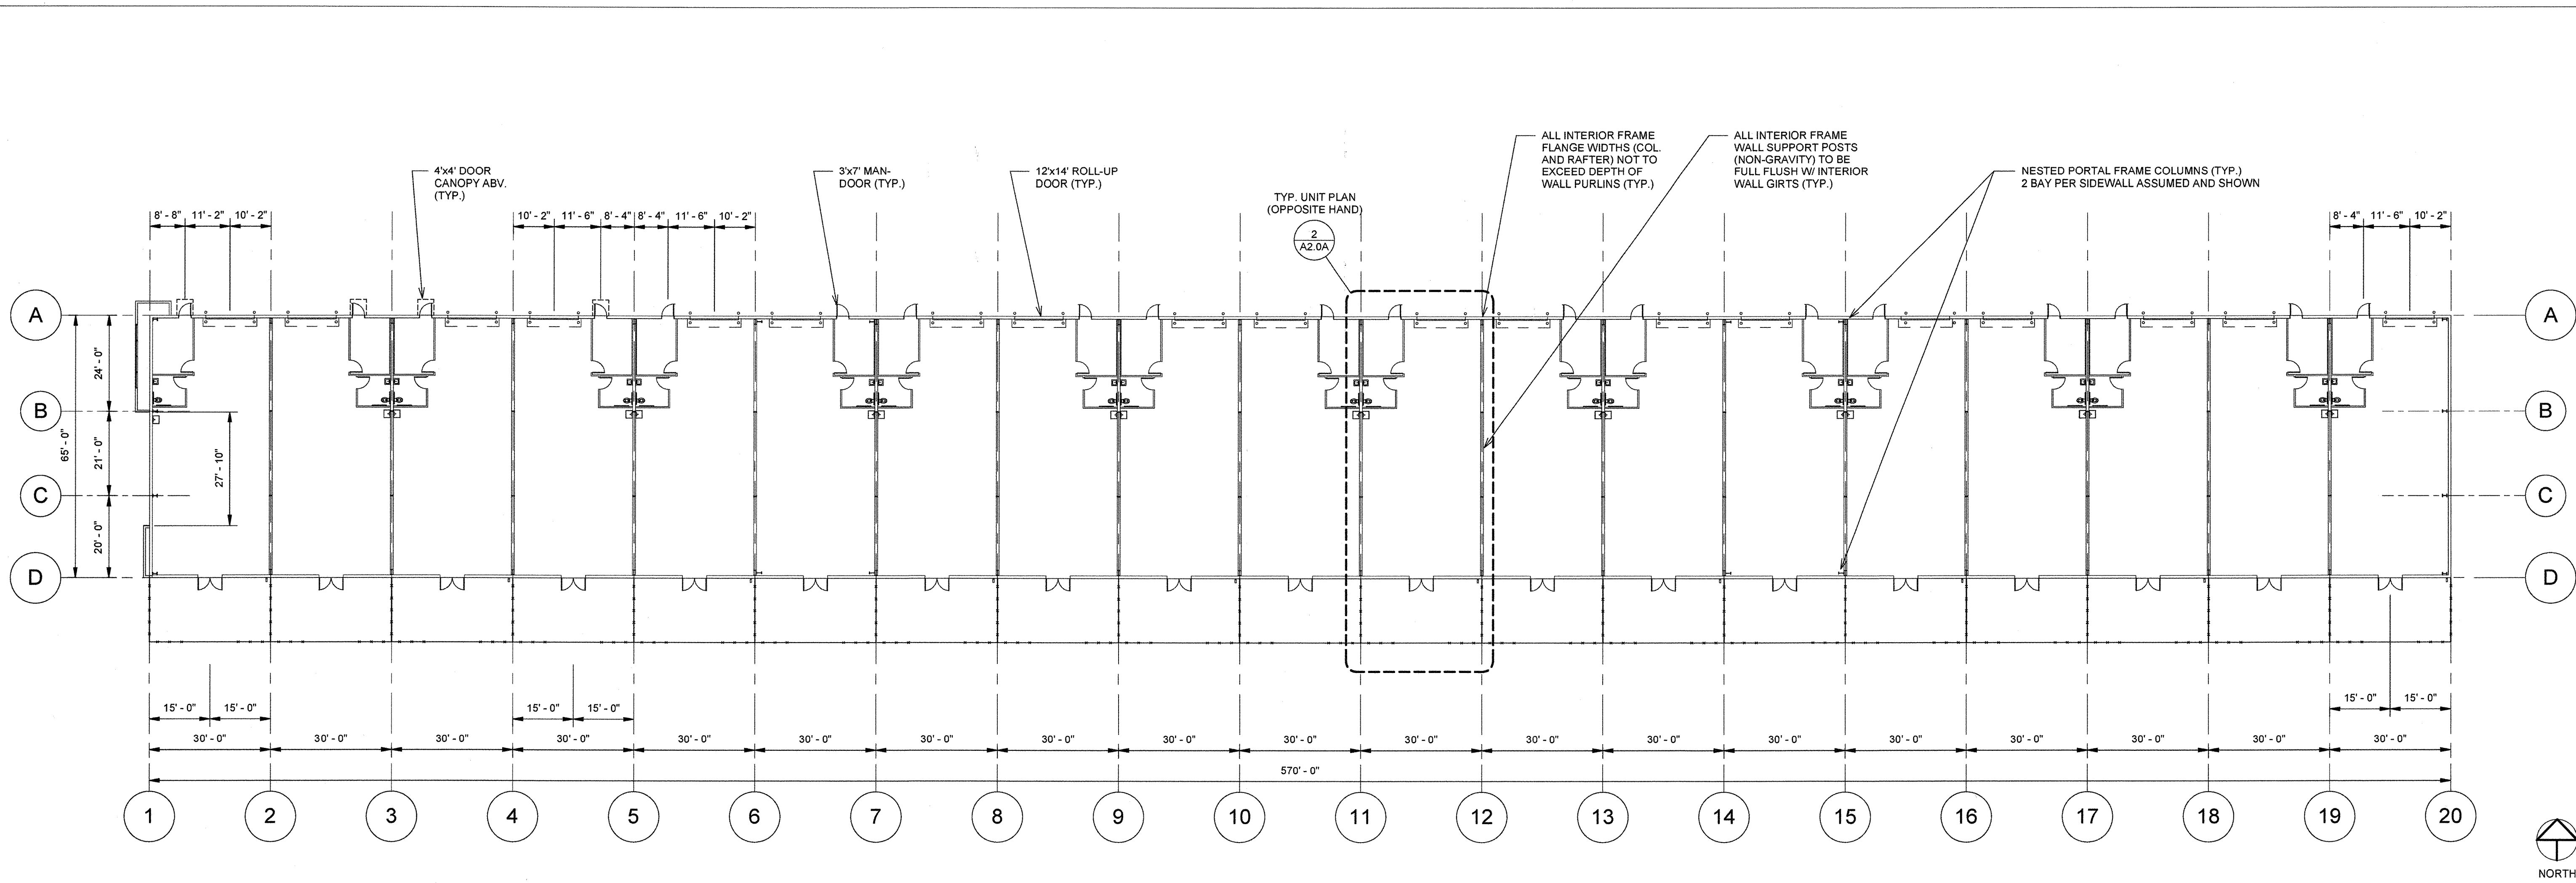

1 FLOOR PLAN - BLDG. B  
A2.0B 1" = 20'-0"

BY	
REVISION	
DATE	




FLOOR PLAN - BLDG. B  
LEASE FLEX. / WAREHOUSE BUILDINGS  
FOR  
MADERA INDUSTRIAL WHSE, LLC  
S. SCHNOOR AVENUE, MADERA, CA

2019CBC  
City of Madera  
Building Department  
The approval of these plans does not prevent the City of Madera from requiring correction of errors or omissions in the plans, specifications, or construction. Subject to field inspections and approvals by the City and the State of California.  
APPROVED  
By: [Signature]  
Date: MAR 03 2022

JOB NUMBER:	21107
DESIGNED BY:	RT
DRAWN BY:	LM
DATE:	9/17/2021
SHEET NUMBER:	A2.0B



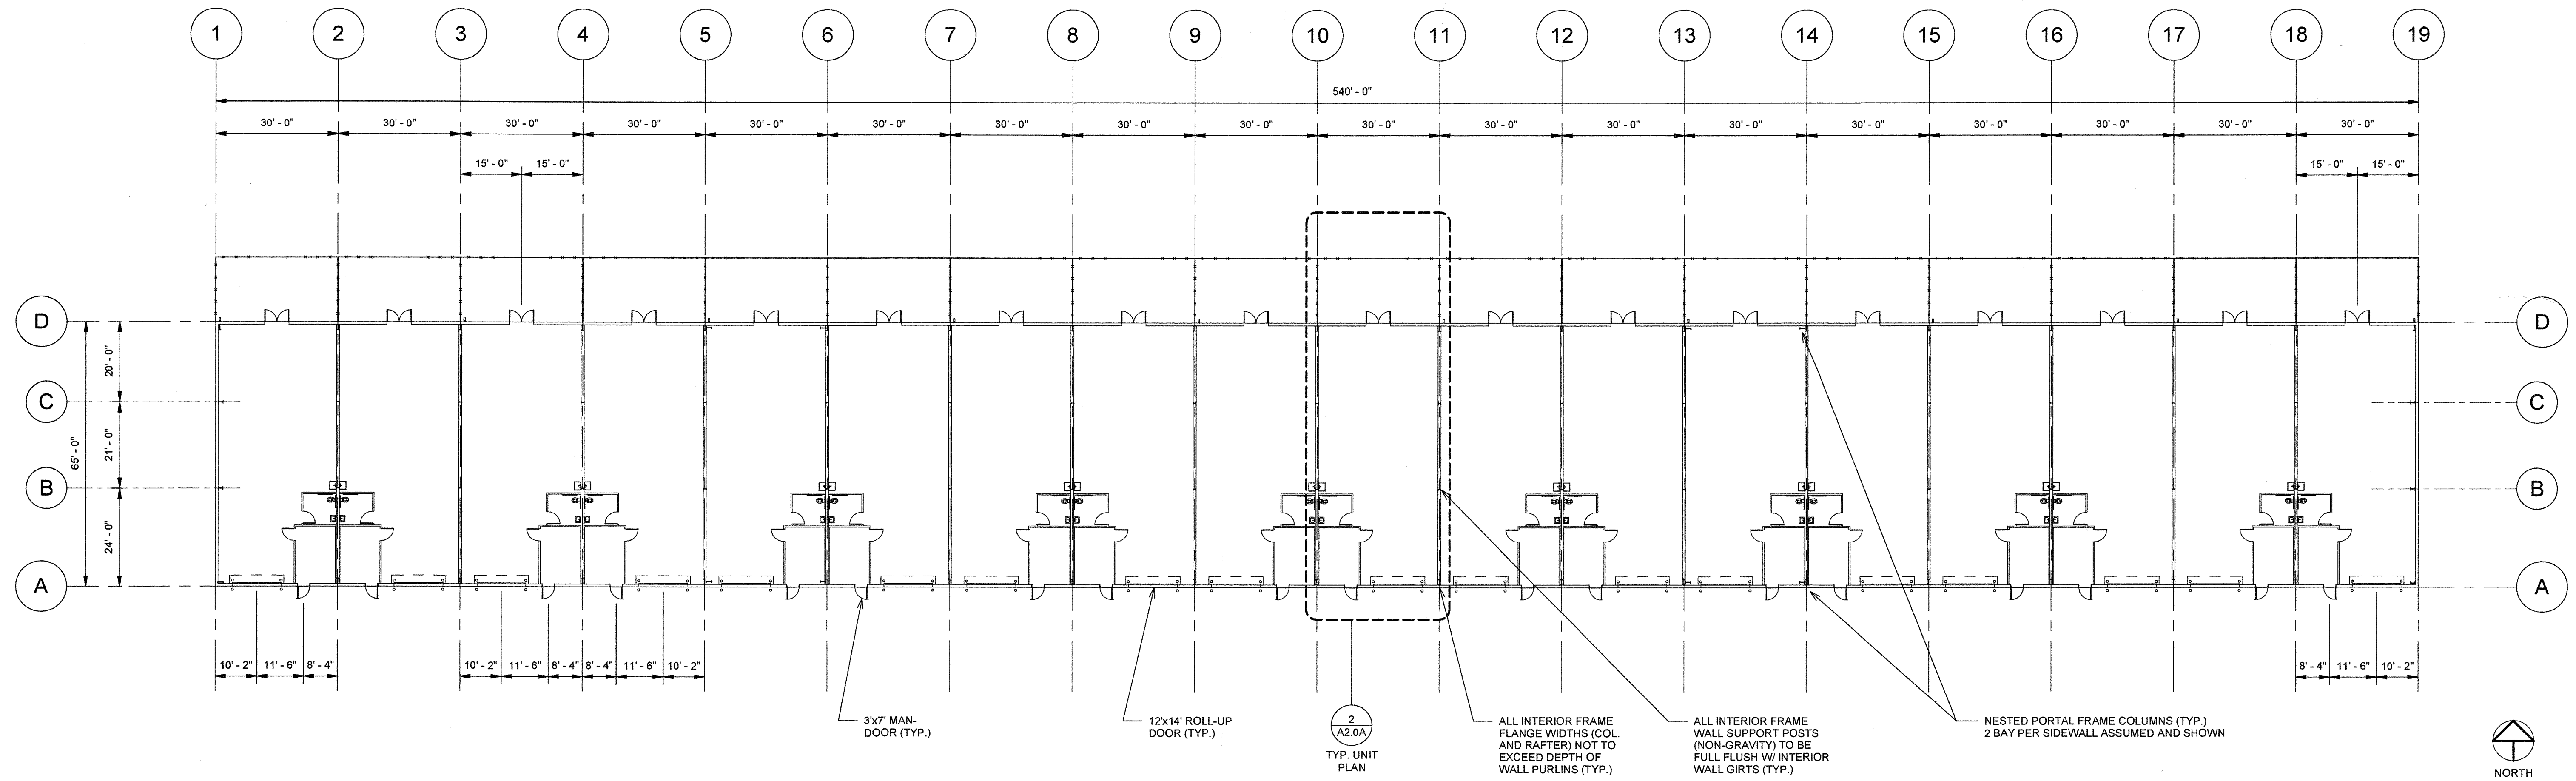


1 FLOOR PLAN - BLDG. C  
A2.0C 1" = 20'-0"

2019CBC  
City of Medera  
Building Department  
The approval of these plans does not prevent the City of Medera from requiring correction of errors or omissions in the plans, specifications or construction. Subject to field inspections and approvals, all other codes and

2019CBC  
APPROVED  
By: \_\_\_\_\_  
Date: \_\_\_\_\_ MAR 03 2022



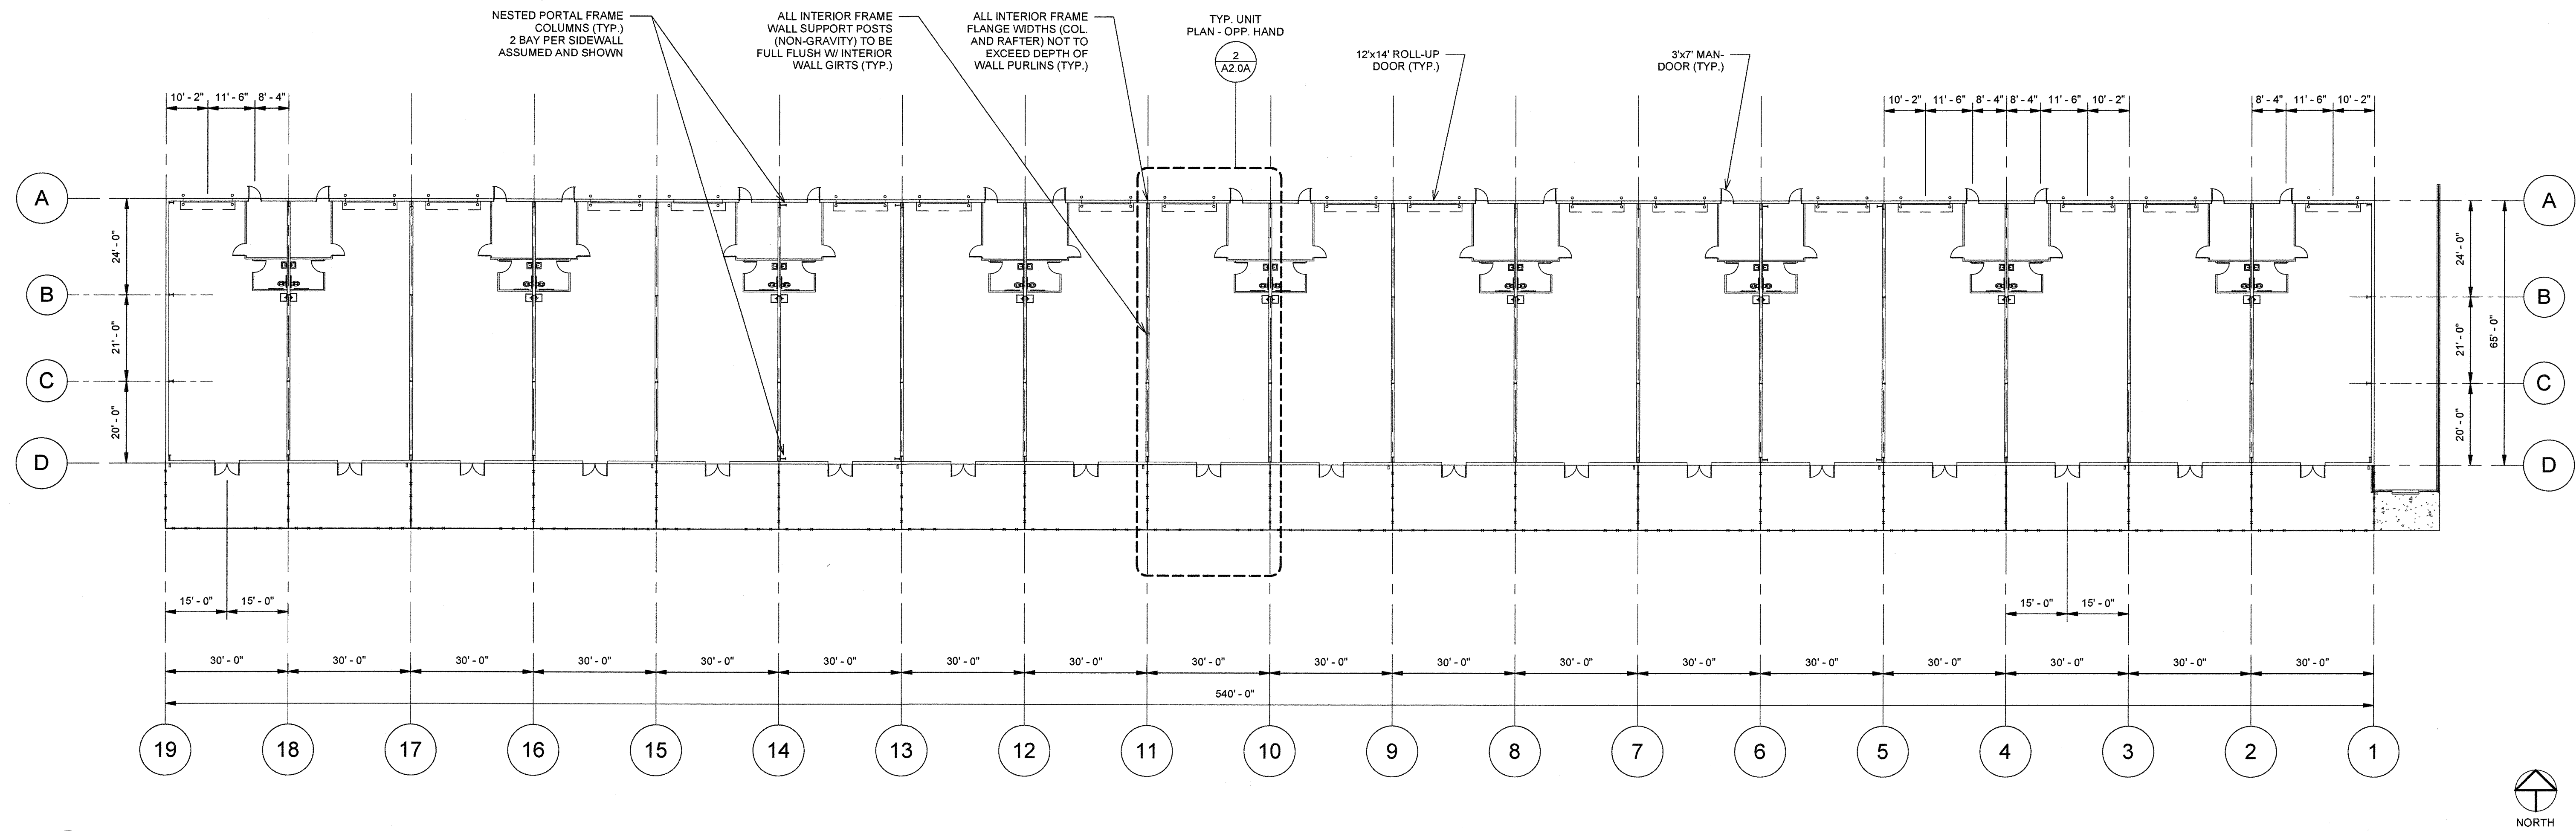

1 FLOOR PLAN - BLDG. D  
A2.0D 1" = 20'-0"


2019C0C0

City of Medera  
Building Department


2019C0C0


APPROVED

By:   
Date: MAR. 0-3 2022




## A2.1


1. WATER SUPPLY AND DRAIN ARE TO BE WRAPPED OR OTHERWISE PROTECTED AGAINST CONTACT AT LAVATORY.
2. FAUCET CONTROLS ARE TO COMPLY WITH 118-309. HAND-OPERATED METERING FAUCETS ARE TO REMAIN OPEN FOR 10 SECONDS MIN.
3. WHEN ADJACENT TO A SIDEWALL OR PARTITION, LAVATORIES ARE TO BE A MINIMUM 18" CLEAR MEASURED FROM THE CL OF THE FIXTURE.

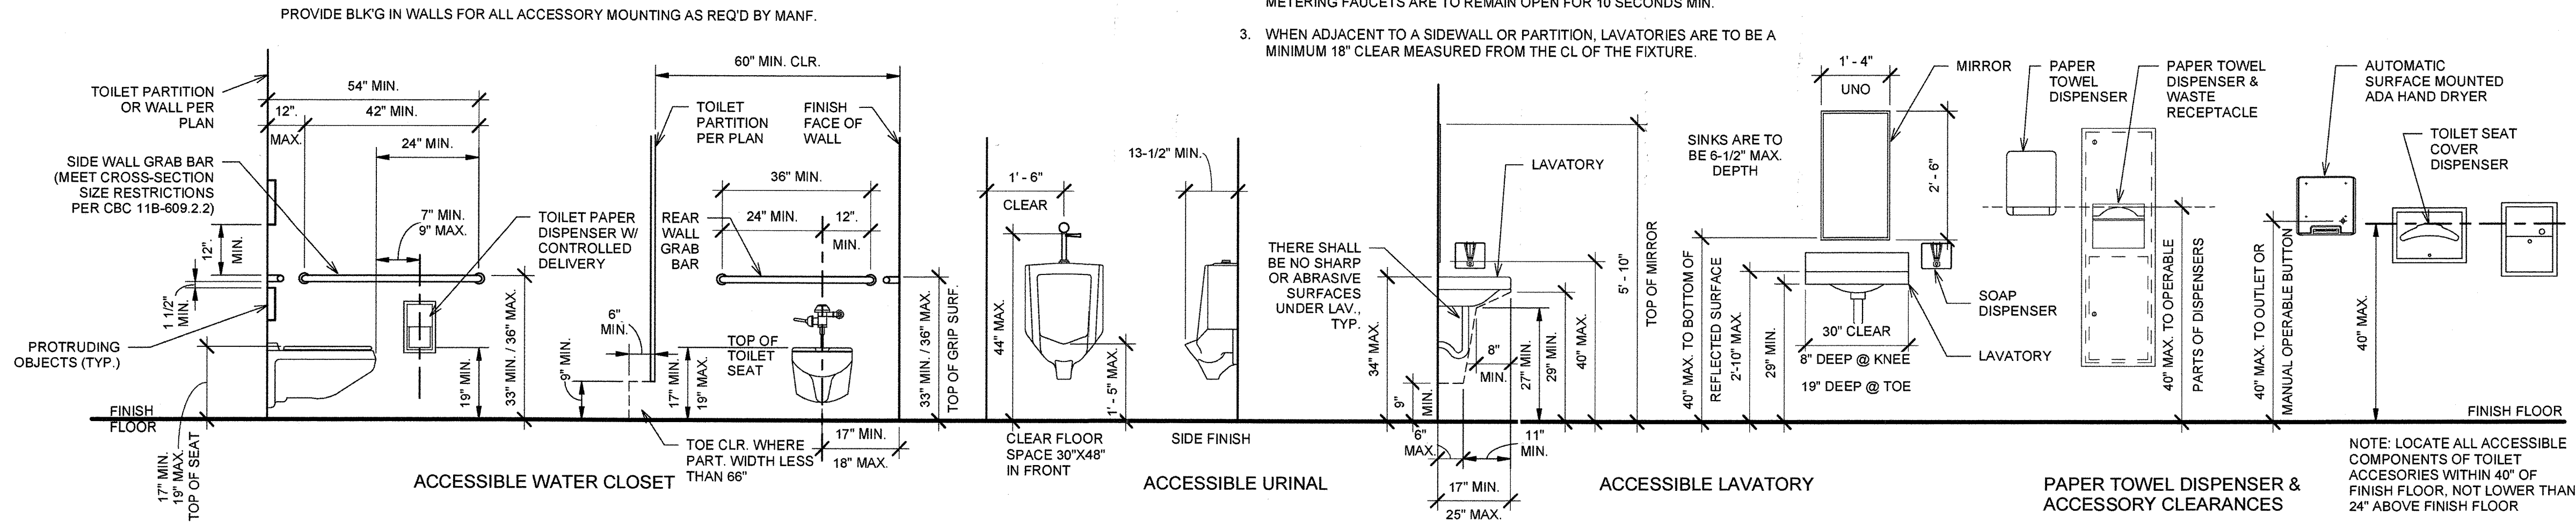

## 1 TYPICAL ACCESSIBLE FIXTURE MOUNTING

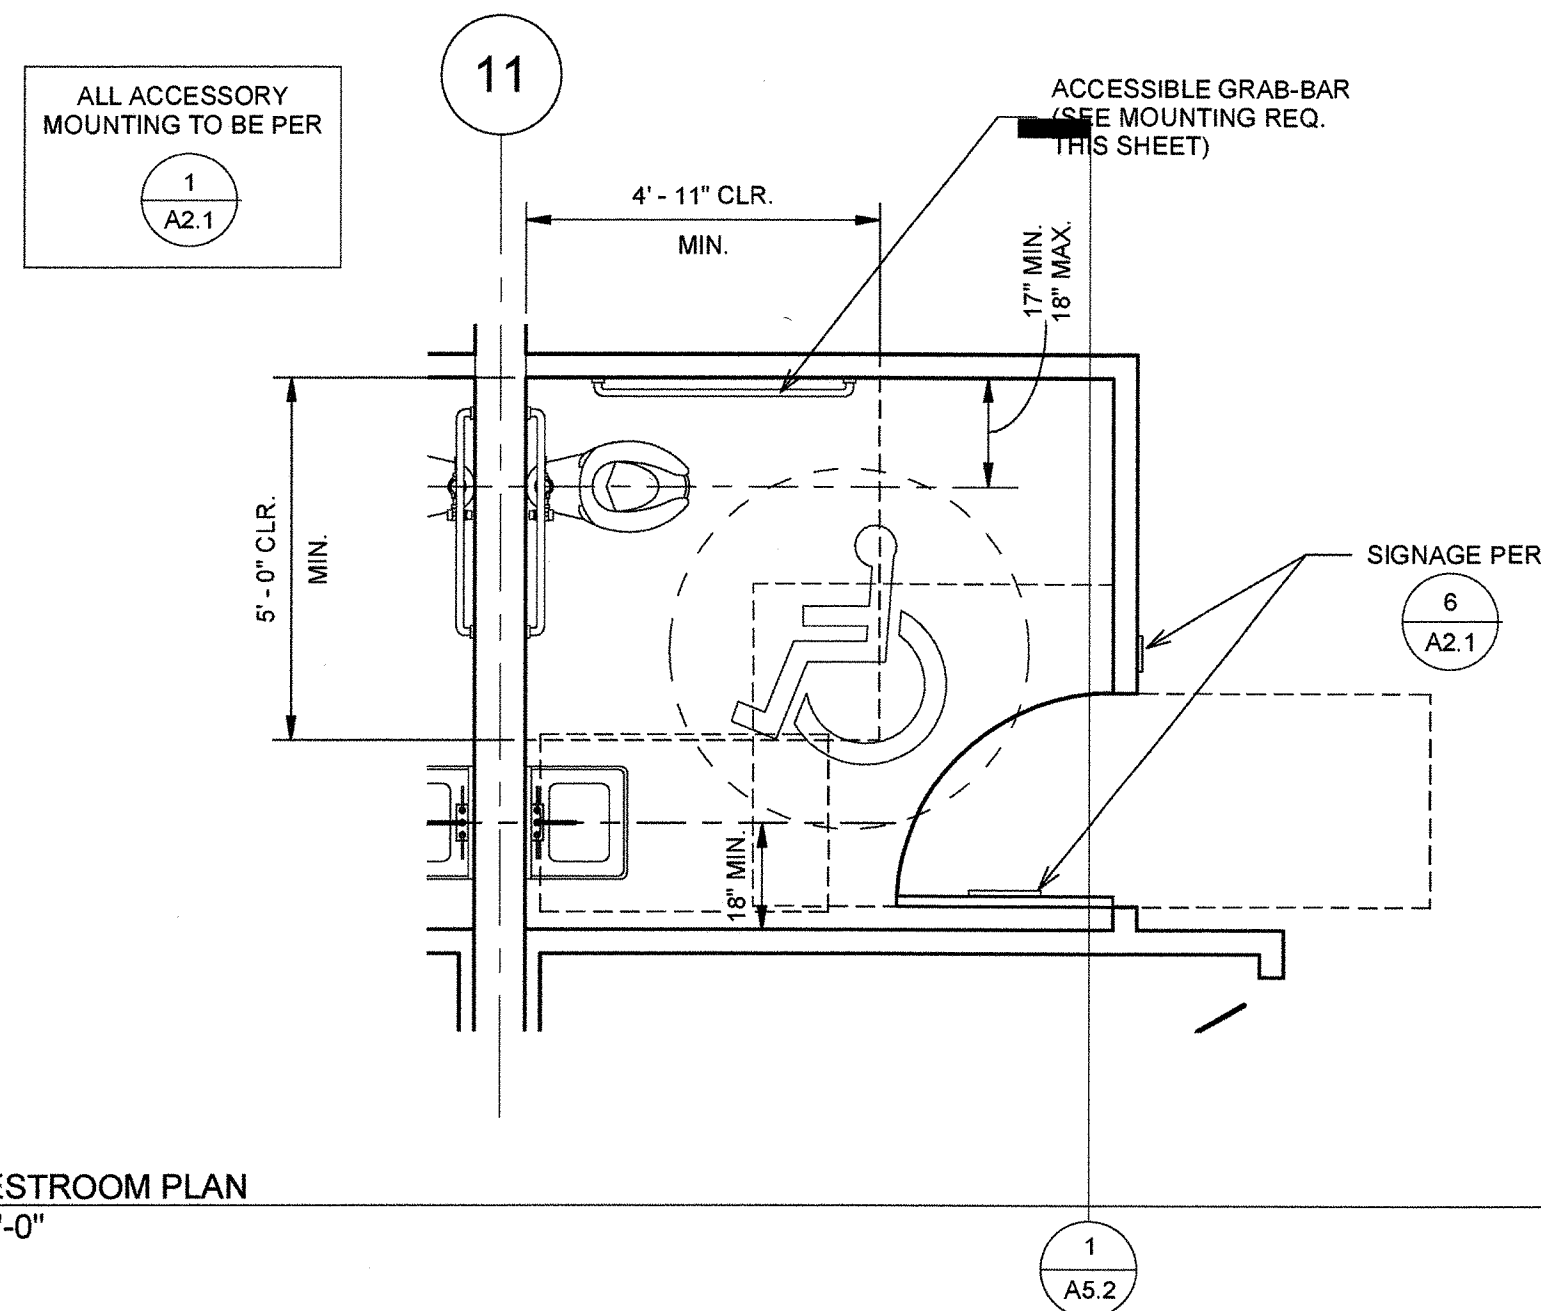

5 TYP. RESTROOM PLAN  
A2.1 3/8" = 1'-0"

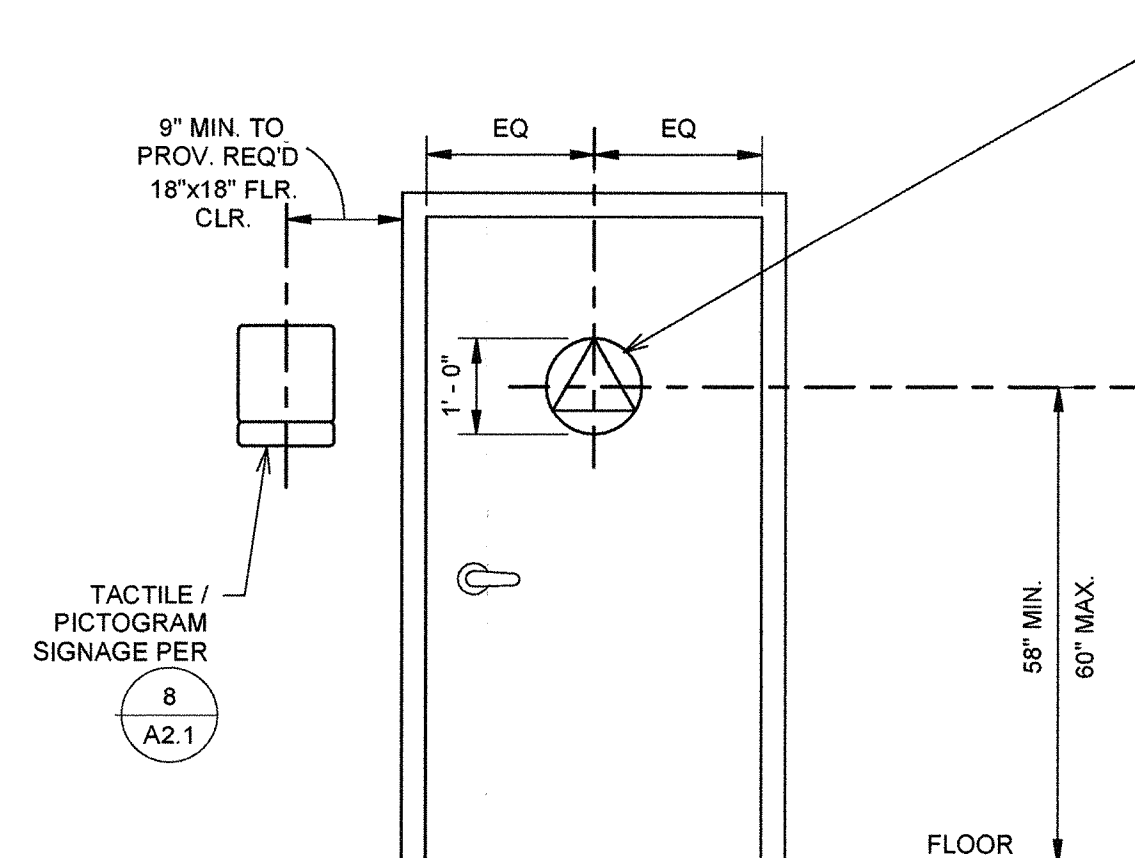

6	RESTROOM SIGNAGE
A2.1	1/2" = 1'-0"

APPLICABLE DOOR SIGNAGE (CBC  
11B-703.7.2.6):


UNISEX FACILITIES:  
1/4" THICK 12"Ø CIRCLE W/ 1/4" THICK  
TRIANGLE W/ A VERTEX POINTING  
UPWARD

SUPERIMPOSED WITHIN THE CIRCLE AND  
CONTRASTING BACKGROUNDS PER  
CBC 11B-703.7.2.6.3

MEN'S FACILITIES:  
1/4" THICK EQUILATERAL TRIANGLE W/ 12"  
EDGES AND VERTEX POSITIONED  
UPWARDS


AND CONTRASTING BACKGROUNDS PER  
CBC 11B-703.7.2.6.1


WOMEN'S FACILITIES:  
1/4" THICK 12"Ø CIRCLE AND CONTRASTING  
BACKGROUNDS PER CBC 11B-703.7.2.6.2

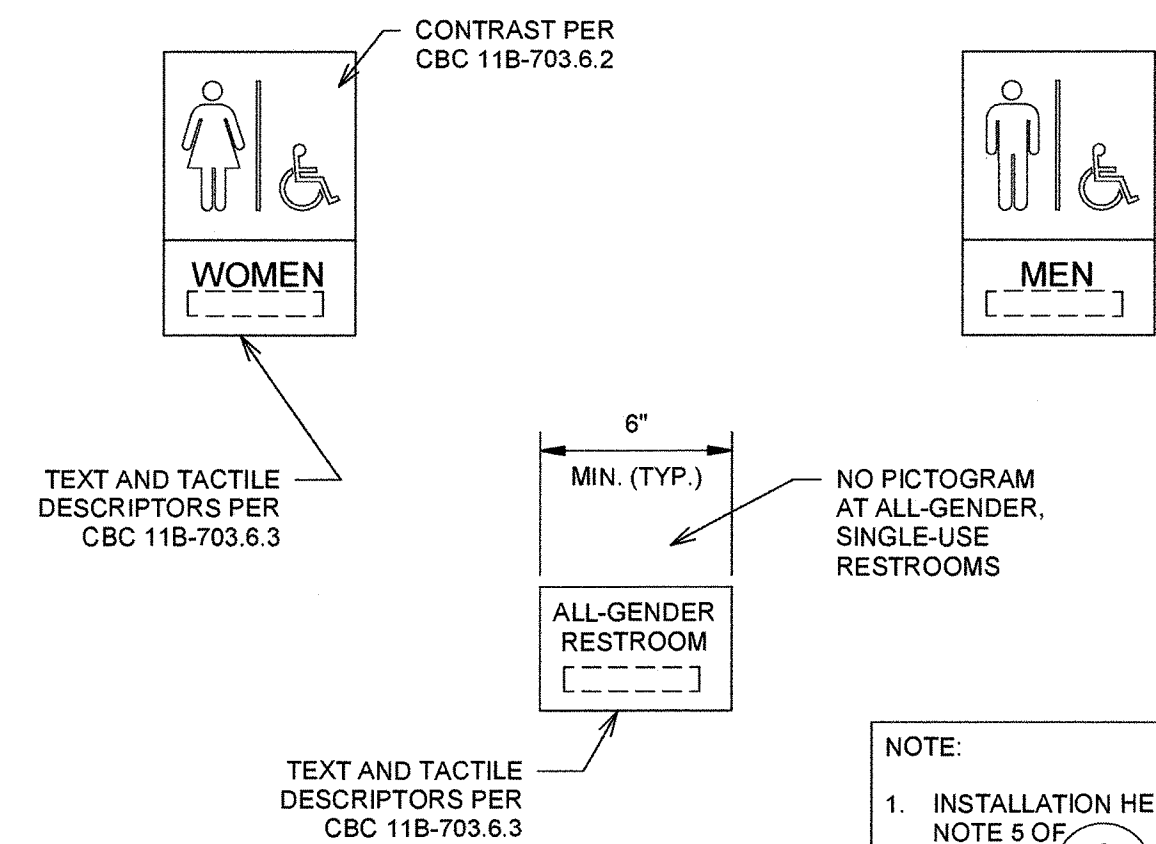

8 RESTROOM TACTILE SIGNAGE  
A2.1 2" = 1'-0"

**NOTE:**


1. INSTALLATION HEIGHT PER  
NOTE 5 OF 
2. COMPLY WITH CBC TITLE 24  
ACCESSIBILITY REQUIREMENTS.

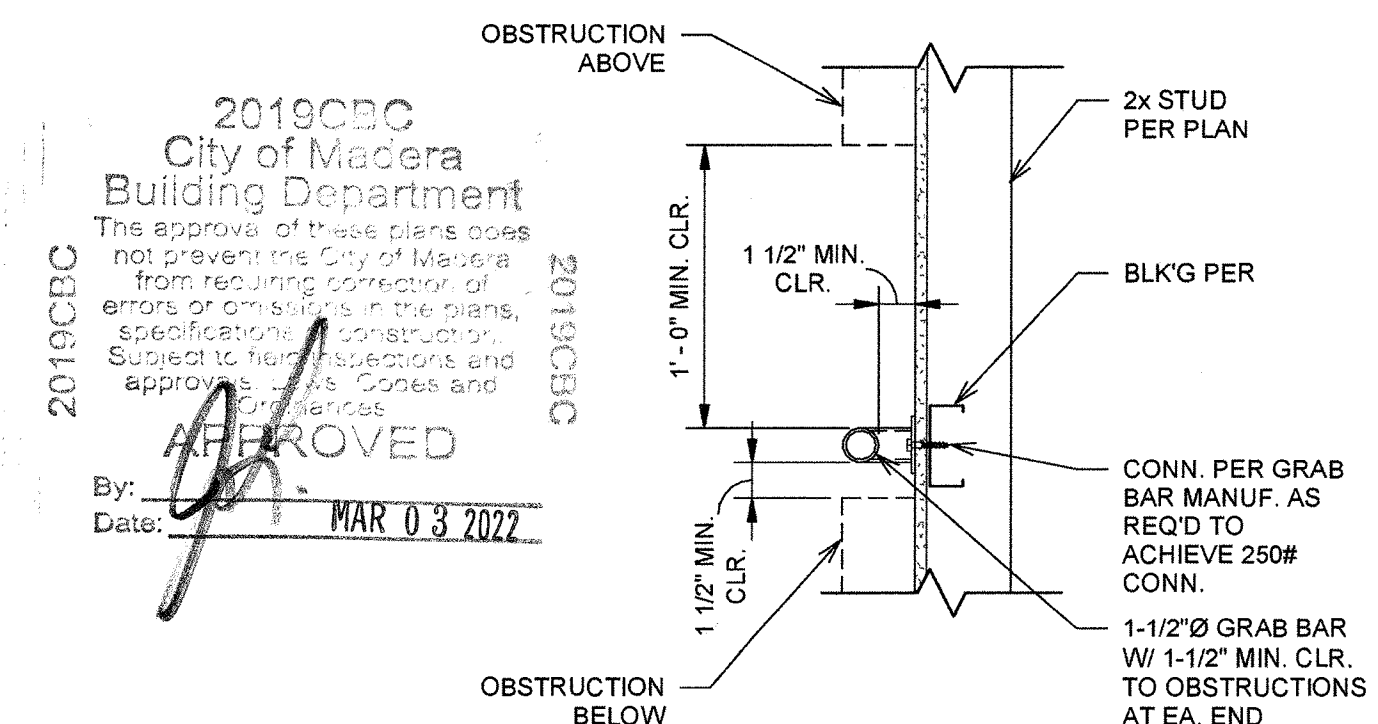

12 GRAB BAR DETAIL  
A2.1 1 1/2" = 1'-0"



11/22/2021 2:58:07 PM  
C:\Users\dwad\OneDrive\Documents\Projects\20190808\_WHSE\Drawings\Roof\Roof Plan - Warehouse Buildings - Madera\WHSE-BLDG\_2019-10-15.dwg

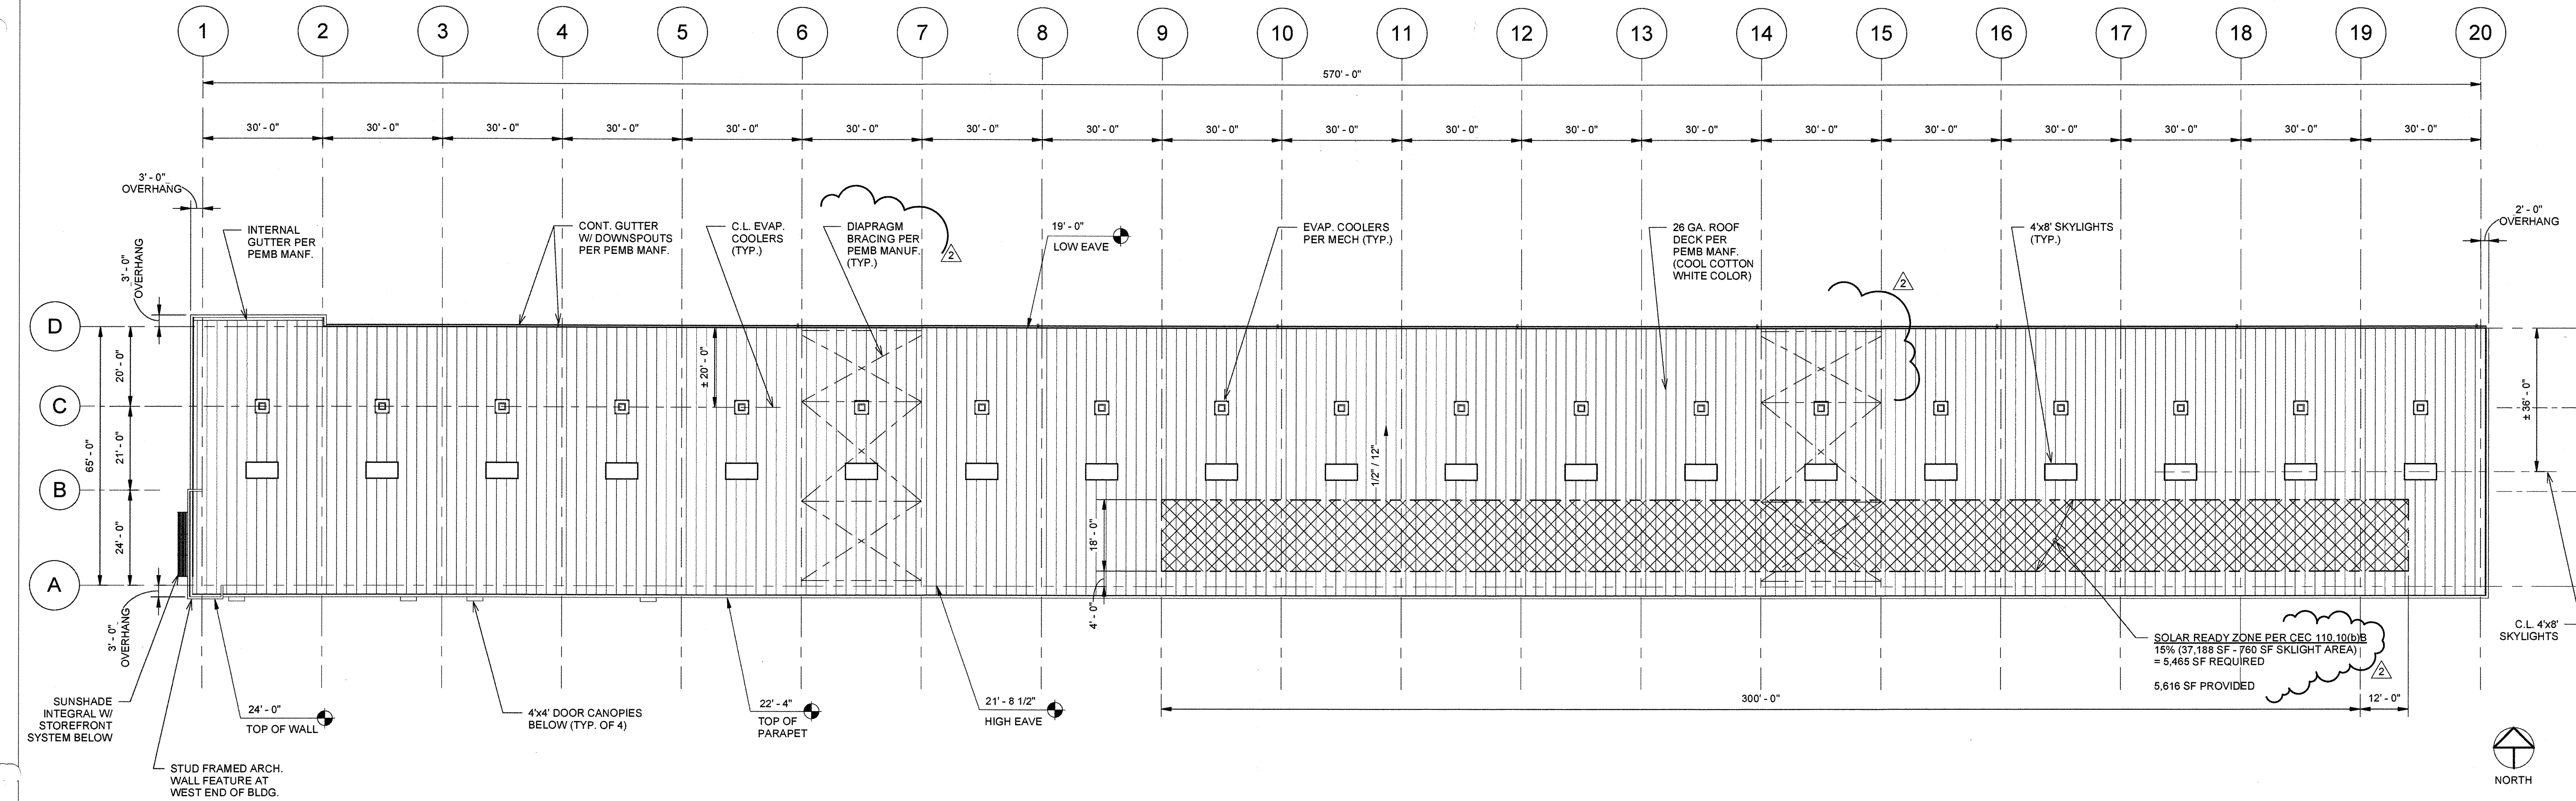

1 ROOF PLAN - BLDG. A  
A3.0A 1" = 20'-0"

2019CBC  
City of Madera  
Building Department  
The approval of these plans does not prevent the City of Madera from requiring correction of errors or omissions in the plans, specifications, or construction. Subject to field inspection and approval of the City Engineer.  
APPROVED  
By: [Signature]  
Date: MAR 03 2022



WHSE  
[PARTNERS]

BY	REVISION
	2 PLAN CHECK RESPONSE
DATE	11/17/2021
SEAL	



ROOF PLAN - BLDG. A  
FOR  
LEASE FLEX. / WAREHOUSE BUILDINGS  
MADERA INDUSTRIAL WHSE, LLC  
S. SCHNOOR AVENUE, MADERA, CA

JOB NUMBER	21107
DESIGNED BY	RT
DRAWN BY	LM
DATE	9/17/2021

SHEET NUMBER  
A3.0A




DATE	REVISION	BY
11/17/2021	2 PLAN CHECK RESPONSE	



**ROOF PLAN - BLDG. B**  
FOR  
**LEASE FLEX. / WAREHOUSE BUILDINGS**  
**MADERA INDUSTRIAL WHSE, LLC**  
S. SCHNOOR AVENUE, MADERA, CA


JOB NUMBER	21107
DESIGNED BY	RT
DRAWN BY	LM
DATE	9/17/2021
SHEET NUMBER	A3.0B

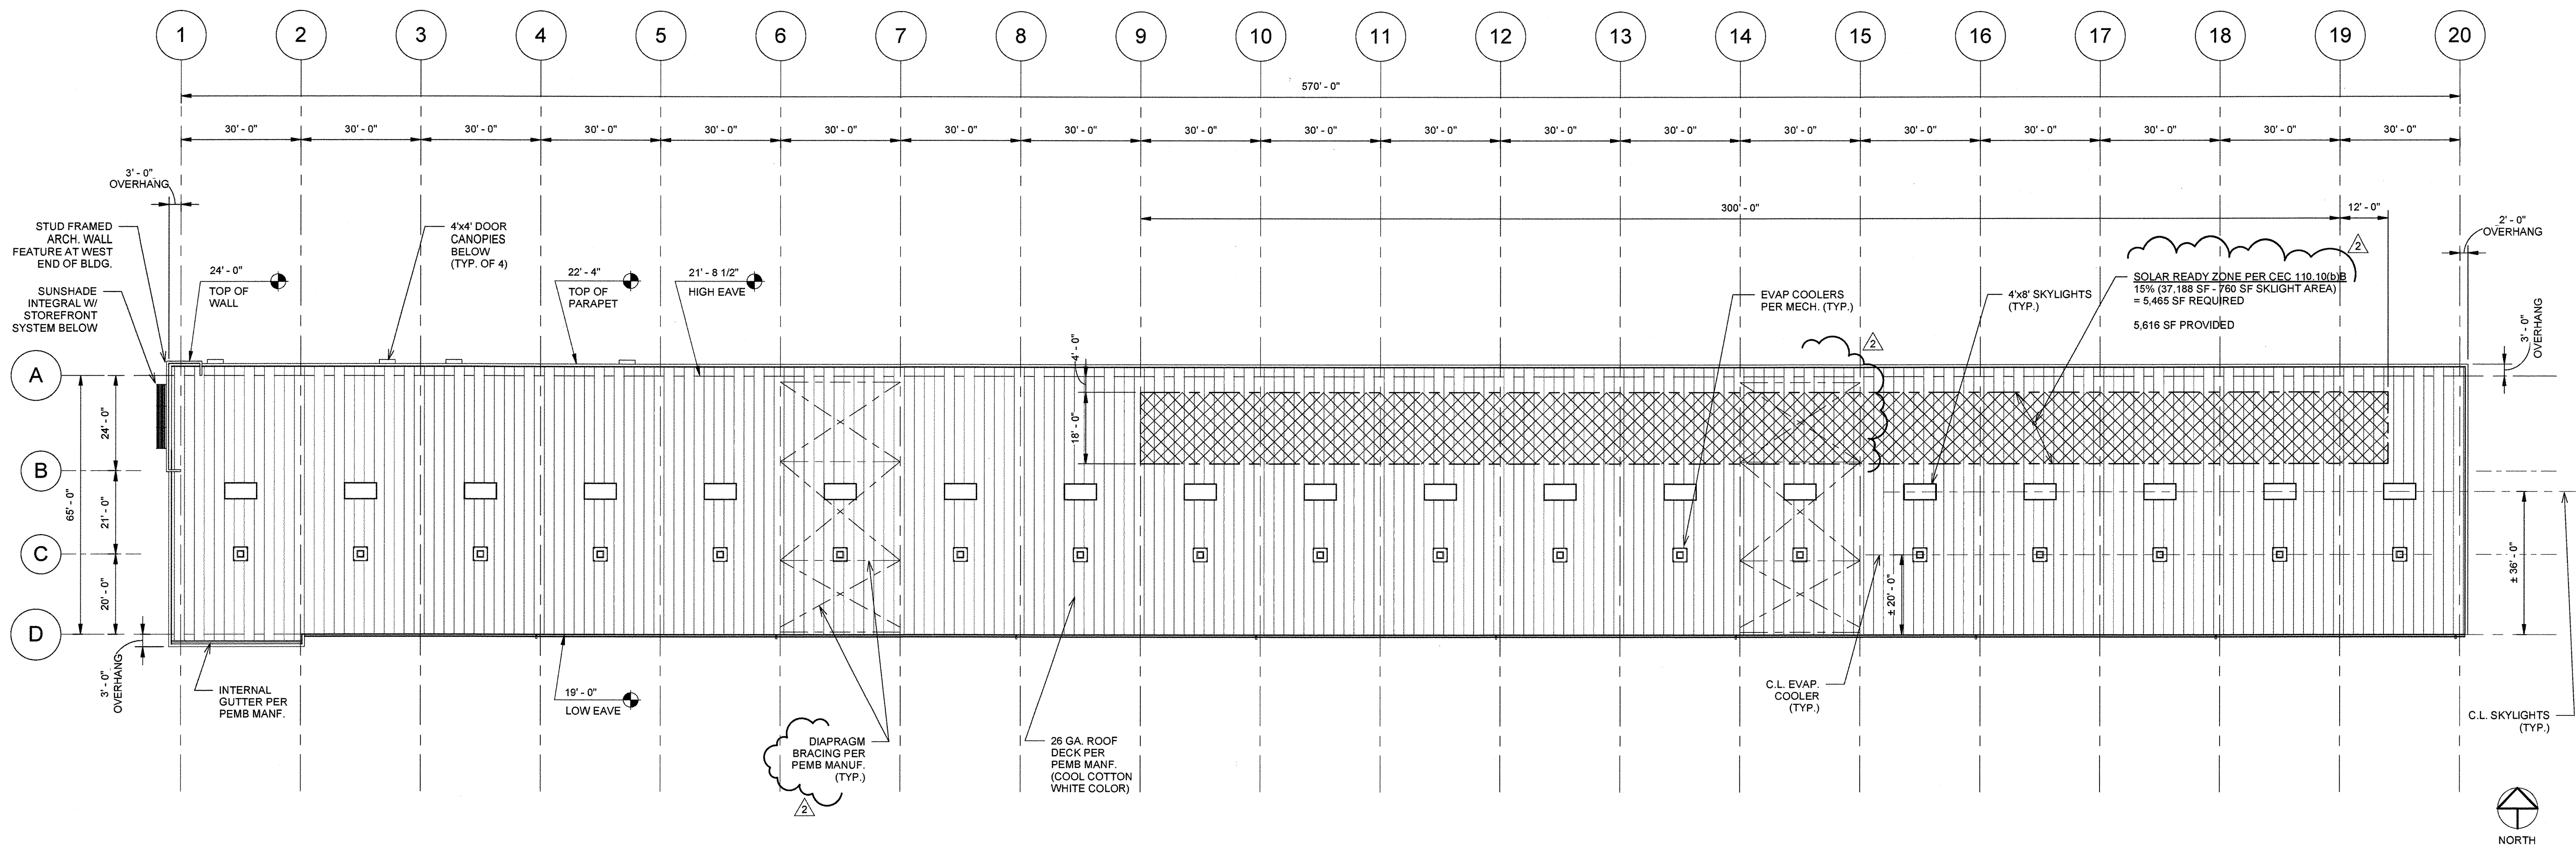

**1 ROOF PLAN - BLDG. B**  
A3.0B 1" = 20'-0"

2019CRC  
City of Madera  
Building Department  
The approval of these plans does not prevent the City of Madera from requiring correction of errors or omissions in the plans, specifications, construction, or materials. Subject to the inspections and approvals of the City of Madera.  
APPROVED  
By: [Signature]  
Date: MAR 03 2022



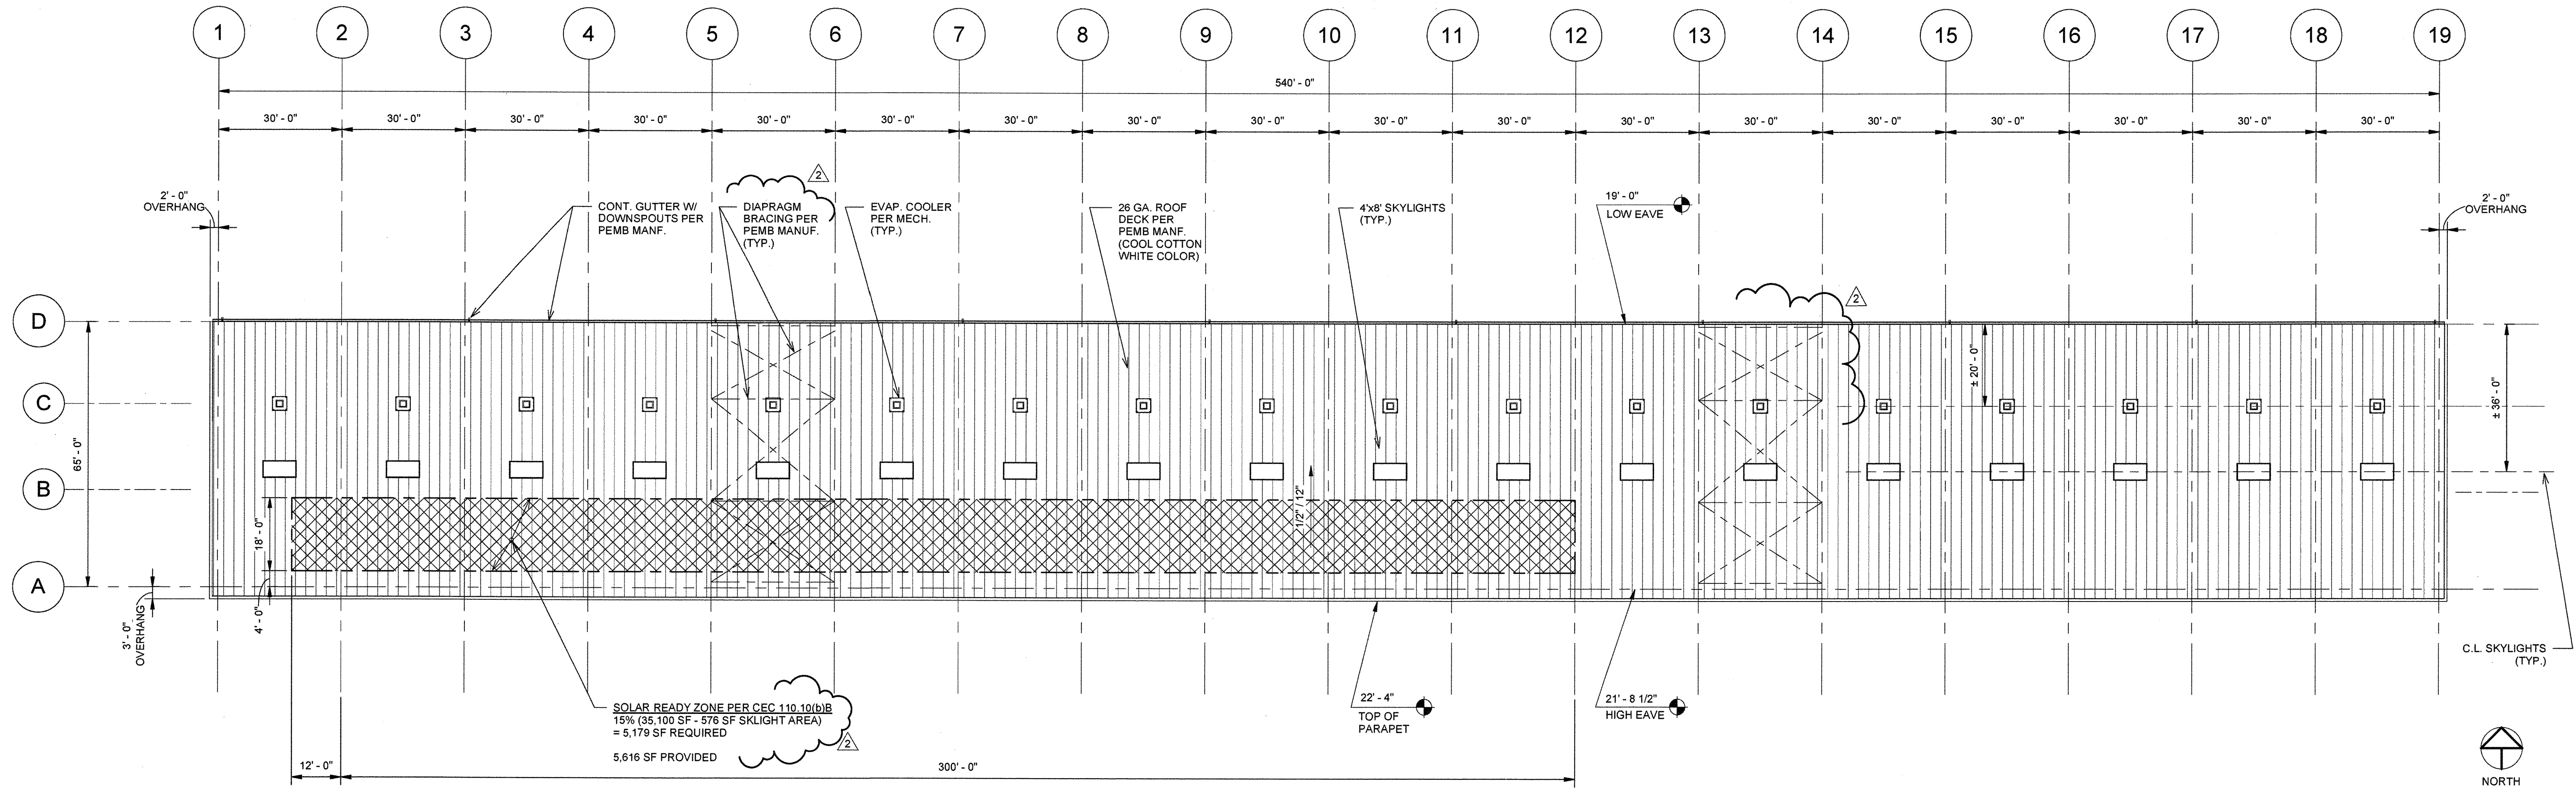



**1 ROOF PLAN - BLDG. C**  
A3.0C 1" = 20'-0"

REVISION	DATE	BY	DESCRIPTION
2	11/17/2021		PLAN CHECK RESPONSE



**ROOF PLAN - BLDG. C**  
FOR  
**LEASE FLEX. / WAREHOUSE BUILDINGS**  
**MADERA INDUSTRIAL WHSE, LLC**  
S. SCHNOOR AVENUE, MADERA, CA

2019CBC  
City of Madera  
Building Department  
The approval of these plans does not prevent the City of Madera from requiring correction of errors or omissions in the plans, specifications of construction, subject to field inspections and approvals of the City.  
By: *[Signature]*  
Date: MAR 03 2022  
APPROVED

JOB NUMBER	21107
DESIGNED BY	RT
DRAWN BY	LM
DATE	9/17/2021
SHEET NUMBER	A3.0C






11/17/2021	2	PLAN CHECK RESPONSE	<p>ANY INFORMATION OR DATA ON THIS DRAWING IS NOT INTENDED TO BE SUITABLE FOR REUSE BY ANY PERSON, PROJECT, OR FIRM WITHOUT WRITTEN VERIFICATION AND ADAPTATION BY THE ENGINEER FOR THE SPECIFIC PURPOSE. INTENDED WILL BE AT THE USER'S SOLE RISK AND WITHOUT LIABILITY OR LEGAL EXPOSURE TO THE ENGINEER.</p>
------------	---	---------------------	---



LEASE FLEX. / WAREHOUSE BUILDINGS  
FOR  
MADERA INDUSTRIAL WHSE, LLC  
S. SCHNOOR AVENUE, MADERA, CA

NUMBER	21107
DESIGNED BY	RT
DRAWN BY	LM
9/17/2021	

### A3.0D

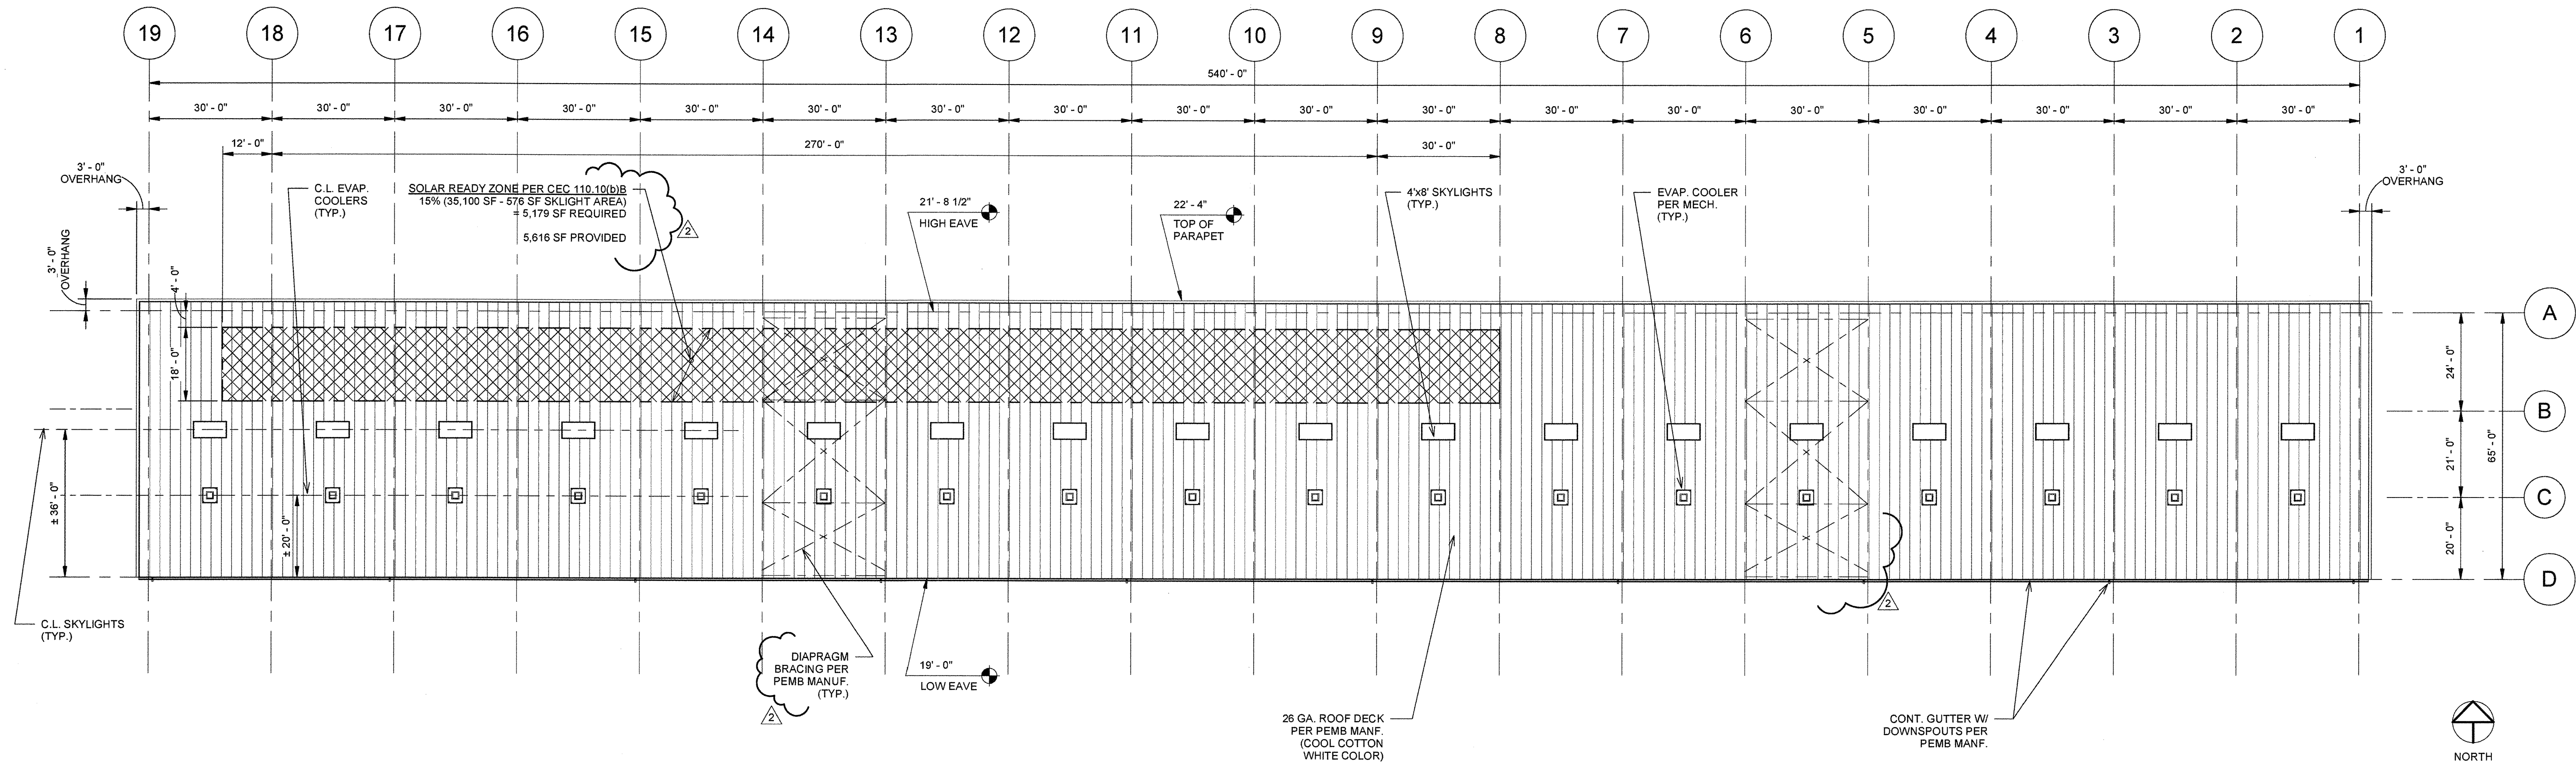


1 ROOF PLAN - BLDG. D  
A3.0D 1" = 20'-0"

2019CBOC  
City of Madera  
Building Department  
The approve of these plans does  
not prevent the City of Madera  
from requiring correction of  
errors of omission in the plans,  
specifications or in the contract.  
Subject to field inspection and  
approval of the Plans and  
Specifications.

2019CBOC

APPROVED

By:   
Date: MAR 03 2022




# ELEVATION KEYNOTES

- 01 24 GA. R-PANEL ROOF DECK BY PEMB MANUF. (COOL ROOF / WHITE COLOR TO MEET T24 ENERGY CODE AS APPLICABLE)
- 02 GUTTER AND DOWNSPOUT PER PEMB MANUFACTURER (COLOR TO MATCH WALL PANELS)
- 03 PROJECTED FACADE 26 GA. R-PANEL PER PEMB MANUFACTURER (STANDARD BLUE COLOR PER MANUFACTURER)
- 04 12'x14' OVERHEAD DOORS - STANDARD GREY COLOR
- 05 3'x7' WALK-DOOR / ENTRANCE (PAINTED BLUE COLOR TO MATCH BLDG. FACADE PANEL)


- 06 REVERSE RIB 26 GA. R-PANEL AT ALL EXTERIOR WALLS PER PEMB MANUF. (STANDARD GREY COLOR)
- 07 ROOF SLOPE BEYOND (1/2" / FT.)
- 08 6' TALL CHAINLINK FENCE AT YARDS W/ PRIVACY SLATS
- 09 DOUBLE-LEAF 10' WIDE ACCESS IN CHAIN LINK FENCE AT YARDS
- 10 NEW 4"x24"x4'-0" SAFETY BOLLARD (PAINTED SAFETY YELLOW)

- 11 ROOFTOP MOUNTED EVAPORATIVE COOLING UNIT FOR SHOP / WAREHOUSE AREA
- 12 (1) 4'x8' SKY-LIGHT EACH UNIT
- 13 BACK-LIGHT BUILDING SIGNAGE (UNDER SEPARATE PERMIT)
- 14 ARCH. WALL LIGHT
- 15 LED WALL PACK FOR SITE LIGHTING AS REQ'D. PER ELECTRICAL ENGINEER


- 16 DOOR CANOPY (TYP. OF 4)
- 17 OPAQUE STOREFRONT SYSTEM W/ INTEGRAL SUNSHADE
- 18 HORIZONTAL RIBBED PANEL

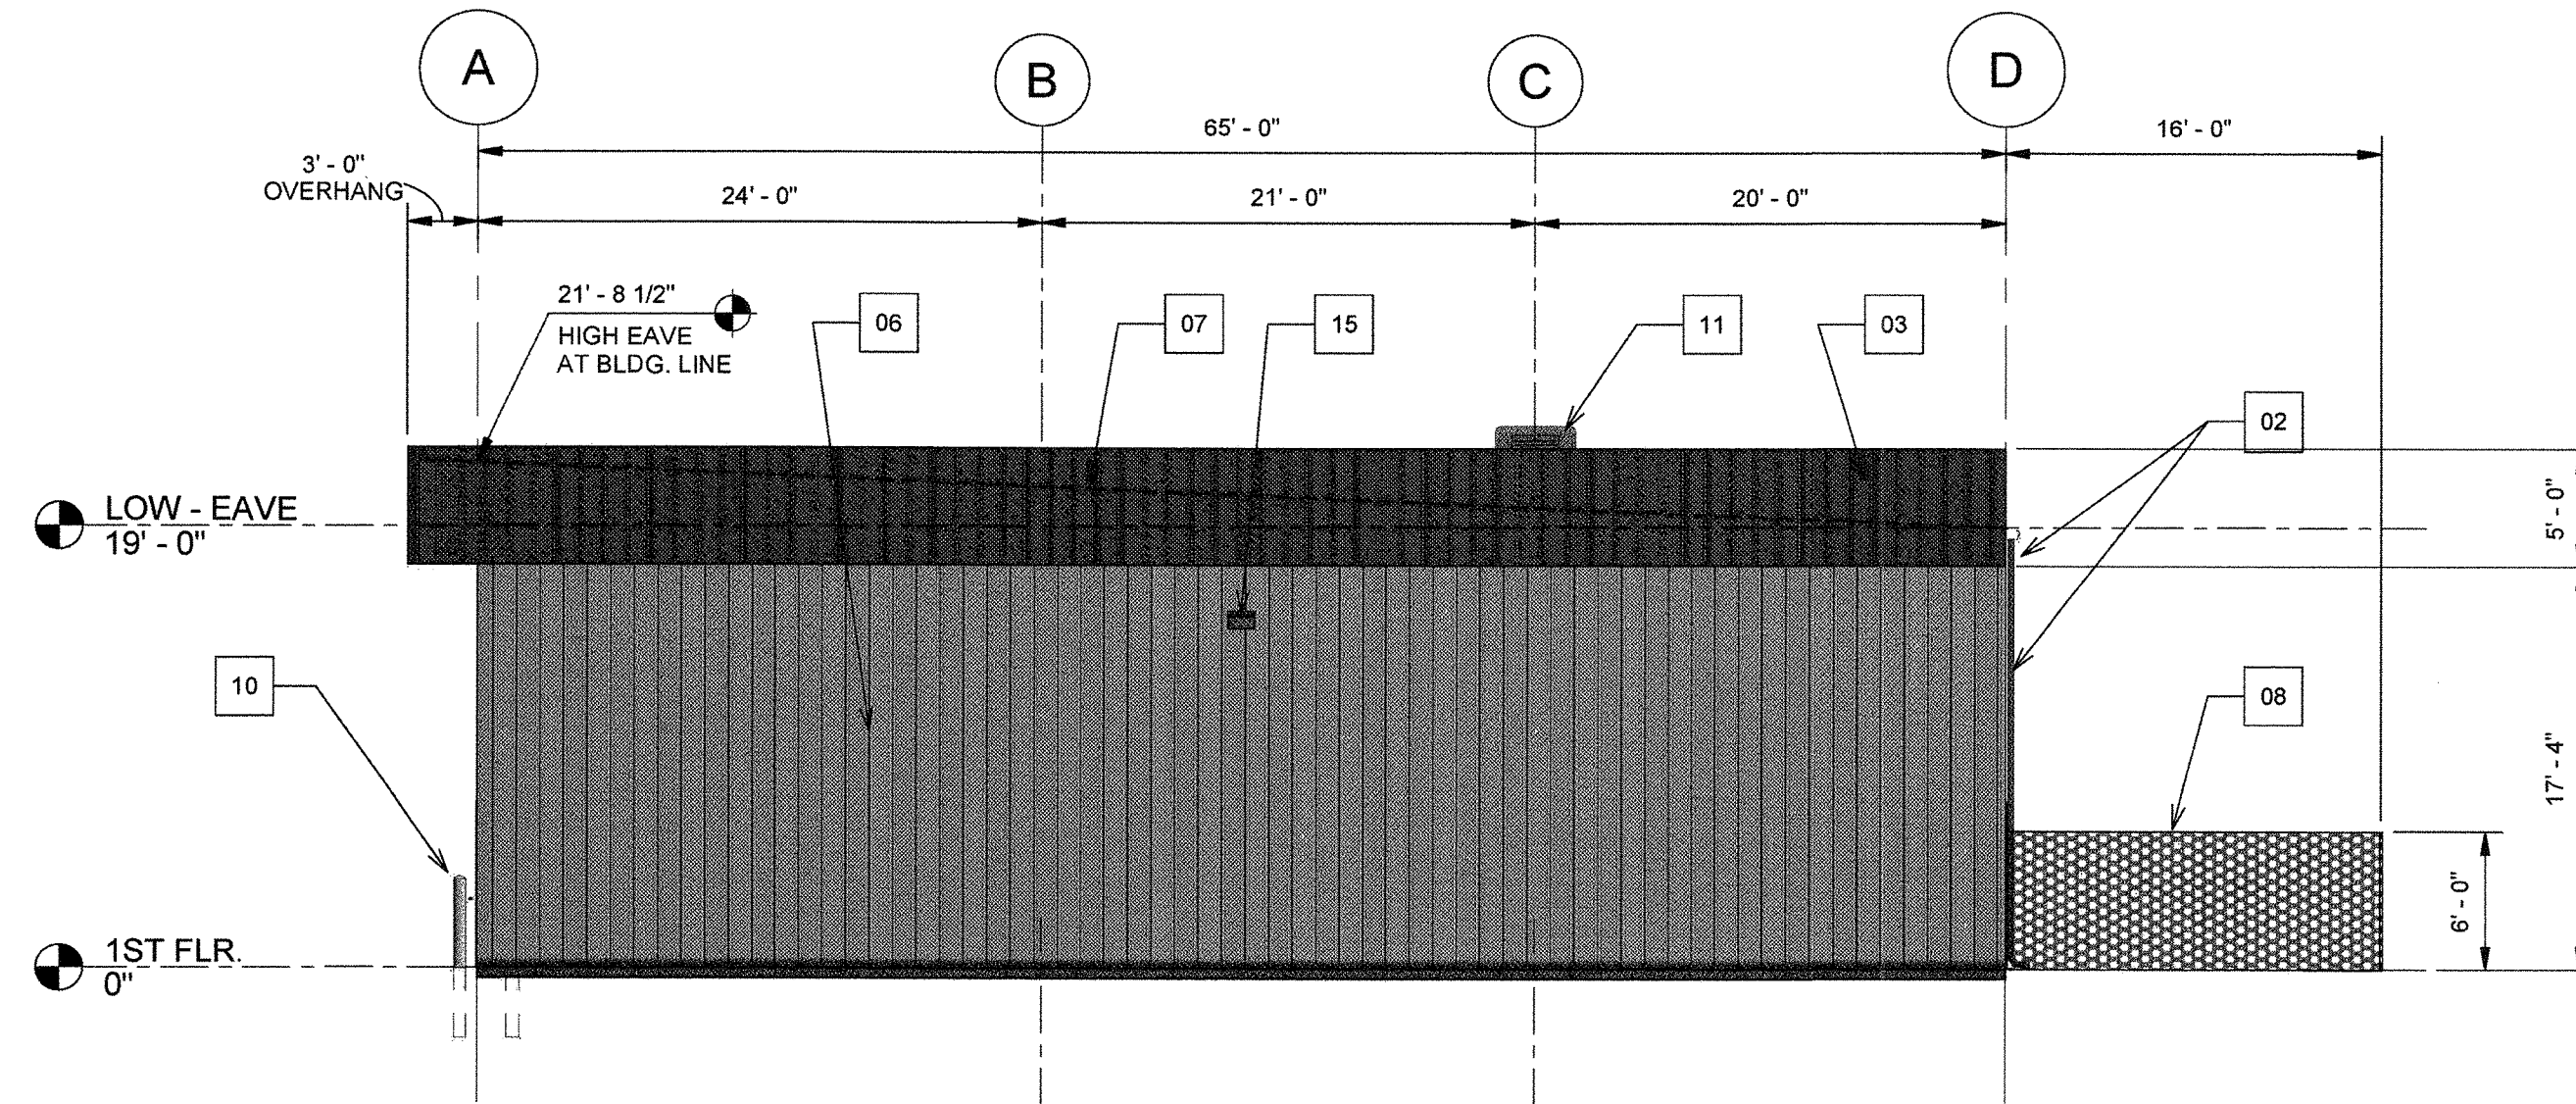


1 BLDG A - EAST ELEVATION  
A5.0A  
1/8" = 1'-0"

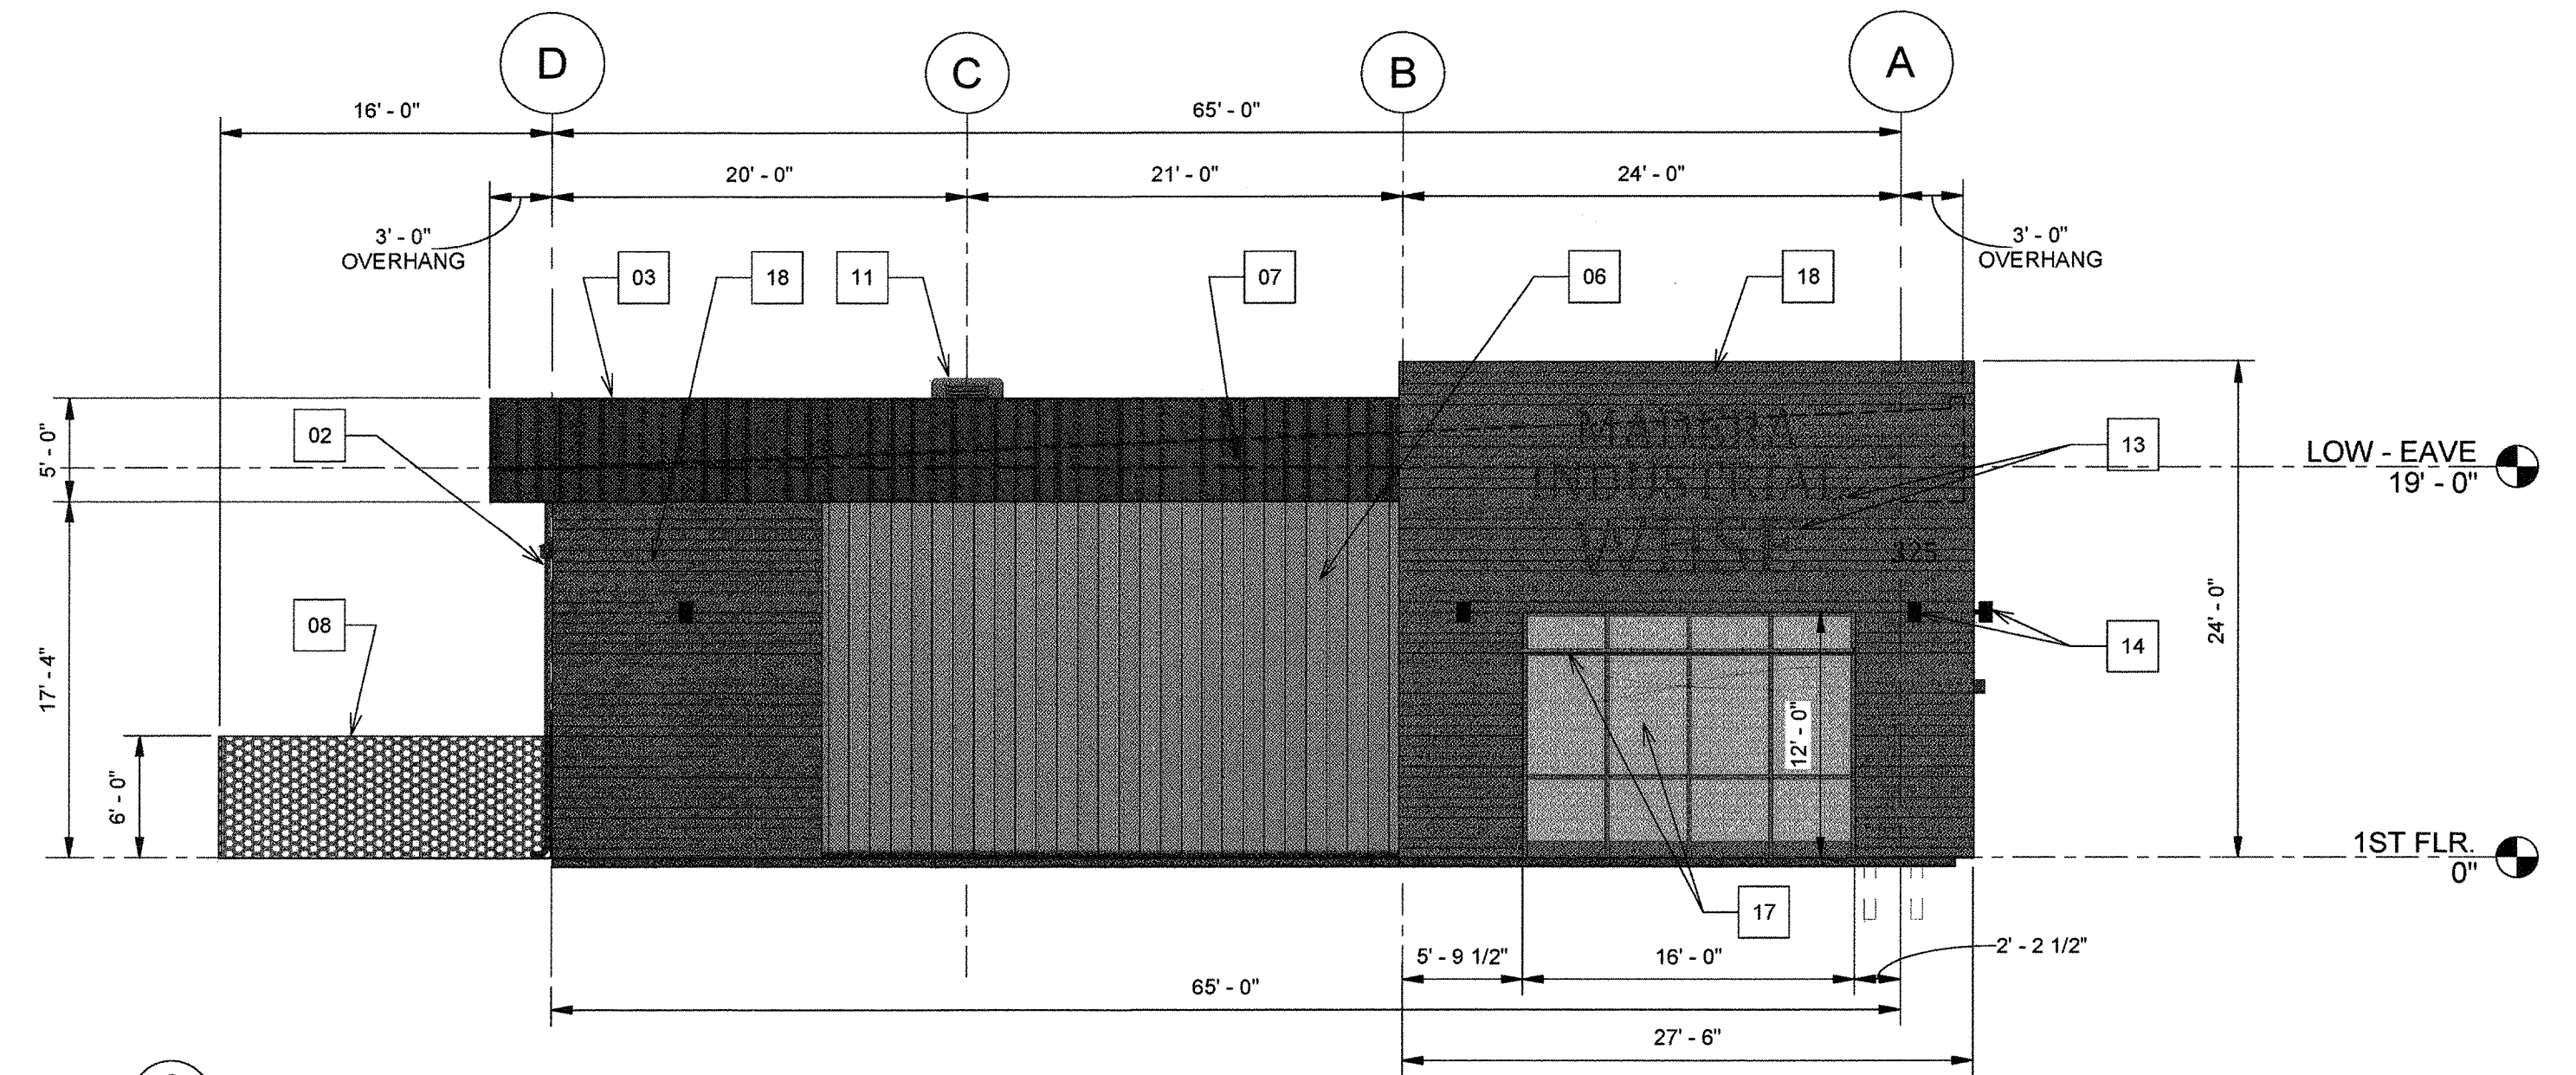

2 BLDG. A - WEST ELEVATION  
A5.0A  
1/8" = 1'-0"

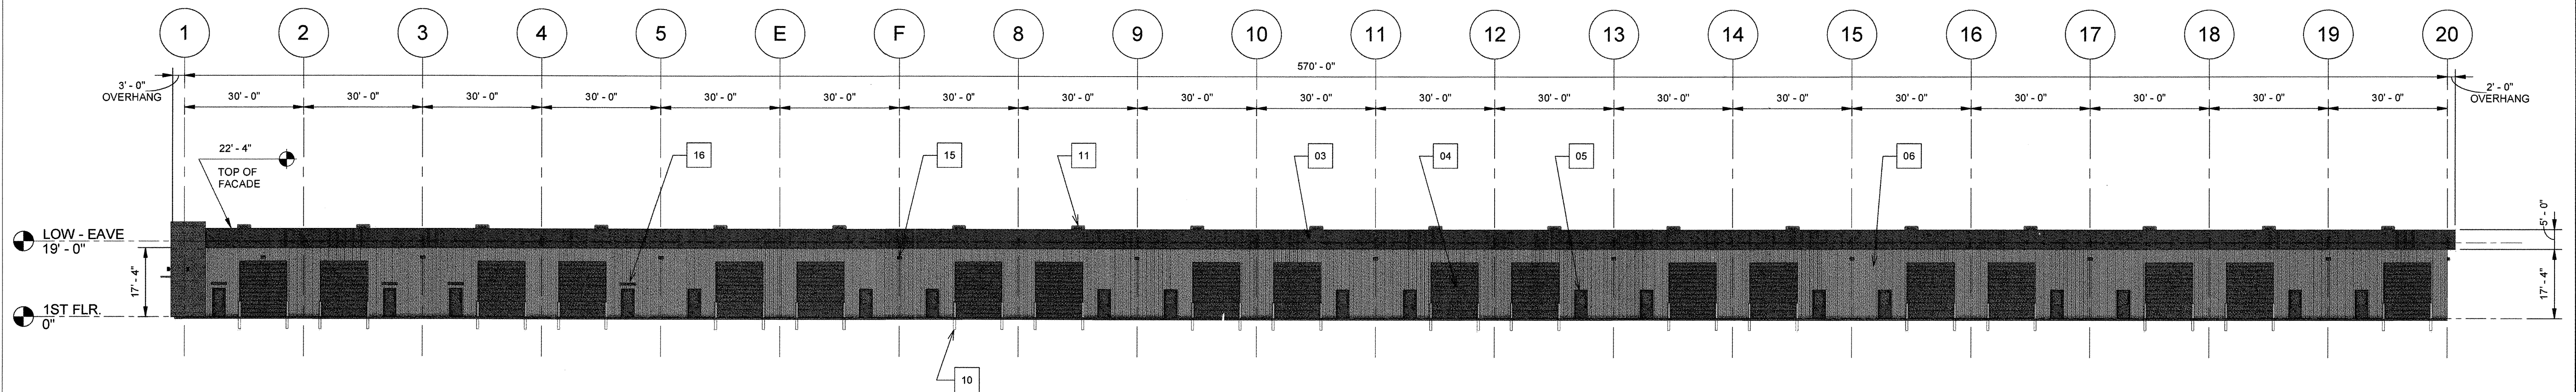

3 BLDG. A - SOUTH ELEVATION  
A5.0A  
1" = 20'-0"

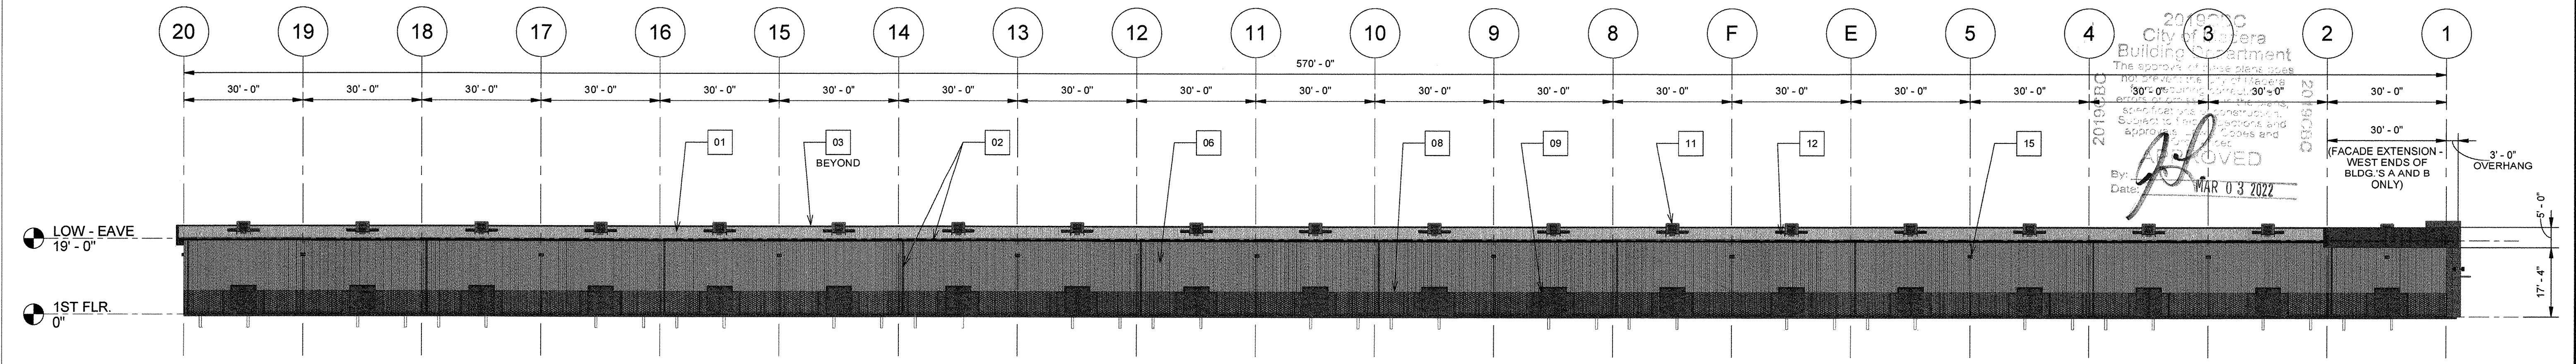

4 BLDG A - NORTH ELEVATION  
A5.0A  
1" = 20'-0"



WHSE  
[PARTNERS]

DATE	REVISION	PLAN CHECK RESPONSE
11/17/2021	2	PLAN CHECK RESPONSE



EXTERIOR ELEVATIONS - BLDG. A  
FOR  
LEASE FLEX. / WAREHOUSE BUILDINGS  
MADERA INDUSTRIAL WHSE, LLC  
S. SCHNOOR AVENUE, MADERA, CA

JOB NUMBER	21107
DESIGNED BY	RT
DRAWN BY	LM
DATE	9/17/2021
SHEET NUMBER	A5.0A




# ELEVATION KEYNOTES

- 01 24 GA. R-PANEL ROOF DECK BY PEMB MANUF. (COOL ROOF / WHITE COLOR TO MEET T24 ENERGY CODE AS APPLICABLE)
- 02 GUTTER AND DOWNSPOUT PER PEMB MANUFACTURER (COLOR TO MATCH WALL PANELS)
- 03 PROJECTED FACADE 26 GA. R-PANEL PER PEMB MANUFACTURER (STANDARD BLUE COLOR PER MANUFACTURER)
- 04 12x14' OVERHEAD DOORS - STANDARD GREY COLOR
- 05 3'x7' WALK-DOOR / ENTRANCE (PAINTED BLUE COLOR TO MATCH BLDG. FACADE PANEL)


- 06 REVERSE RIB 26 GA. R-PANEL AT ALL EXTERIOR WALLS PER PEMB MANUF. (STANDARD GREY COLOR)
- 07 ROOF SLOPE BEYOND (1/2" / FT.)
- 08 8' TALL CHAINLINK FENCE AT YARDS W/ PRIVACY SLATS
- 09 DOUBLE-LEAF 10' WIDE ACCESS IN CHAIN LINK FENCE AT YARDS
- 10 NEW 4"x4'-0" SAFETY BOLLARD (PAINTED SAFETY YELLOW)

- 11 ROOFTOP MOUNTED EVAPORATIVE COOLING UNIT FOR SHOP / WAREHOUSE AREA
- 12 (1) 4'x8' SKY-LIGHT EACH UNIT
- 13 BACK-LIGHT BUILDING SIGNAGE
- 14 ARCH. WALL LIGHT
- 15 LED WALL PACK FOR SITE LIGHTING AS REQ'D. PER ELECTRICAL ENGINEER


- 16 DOOR CANOPY (TYP. OF 4)
- 17 OPAQUE STOREFRONT SYSTEM W/ INTEGRAL SUNSHADE
- 18 HORIZONTAL RIBBED PANEL

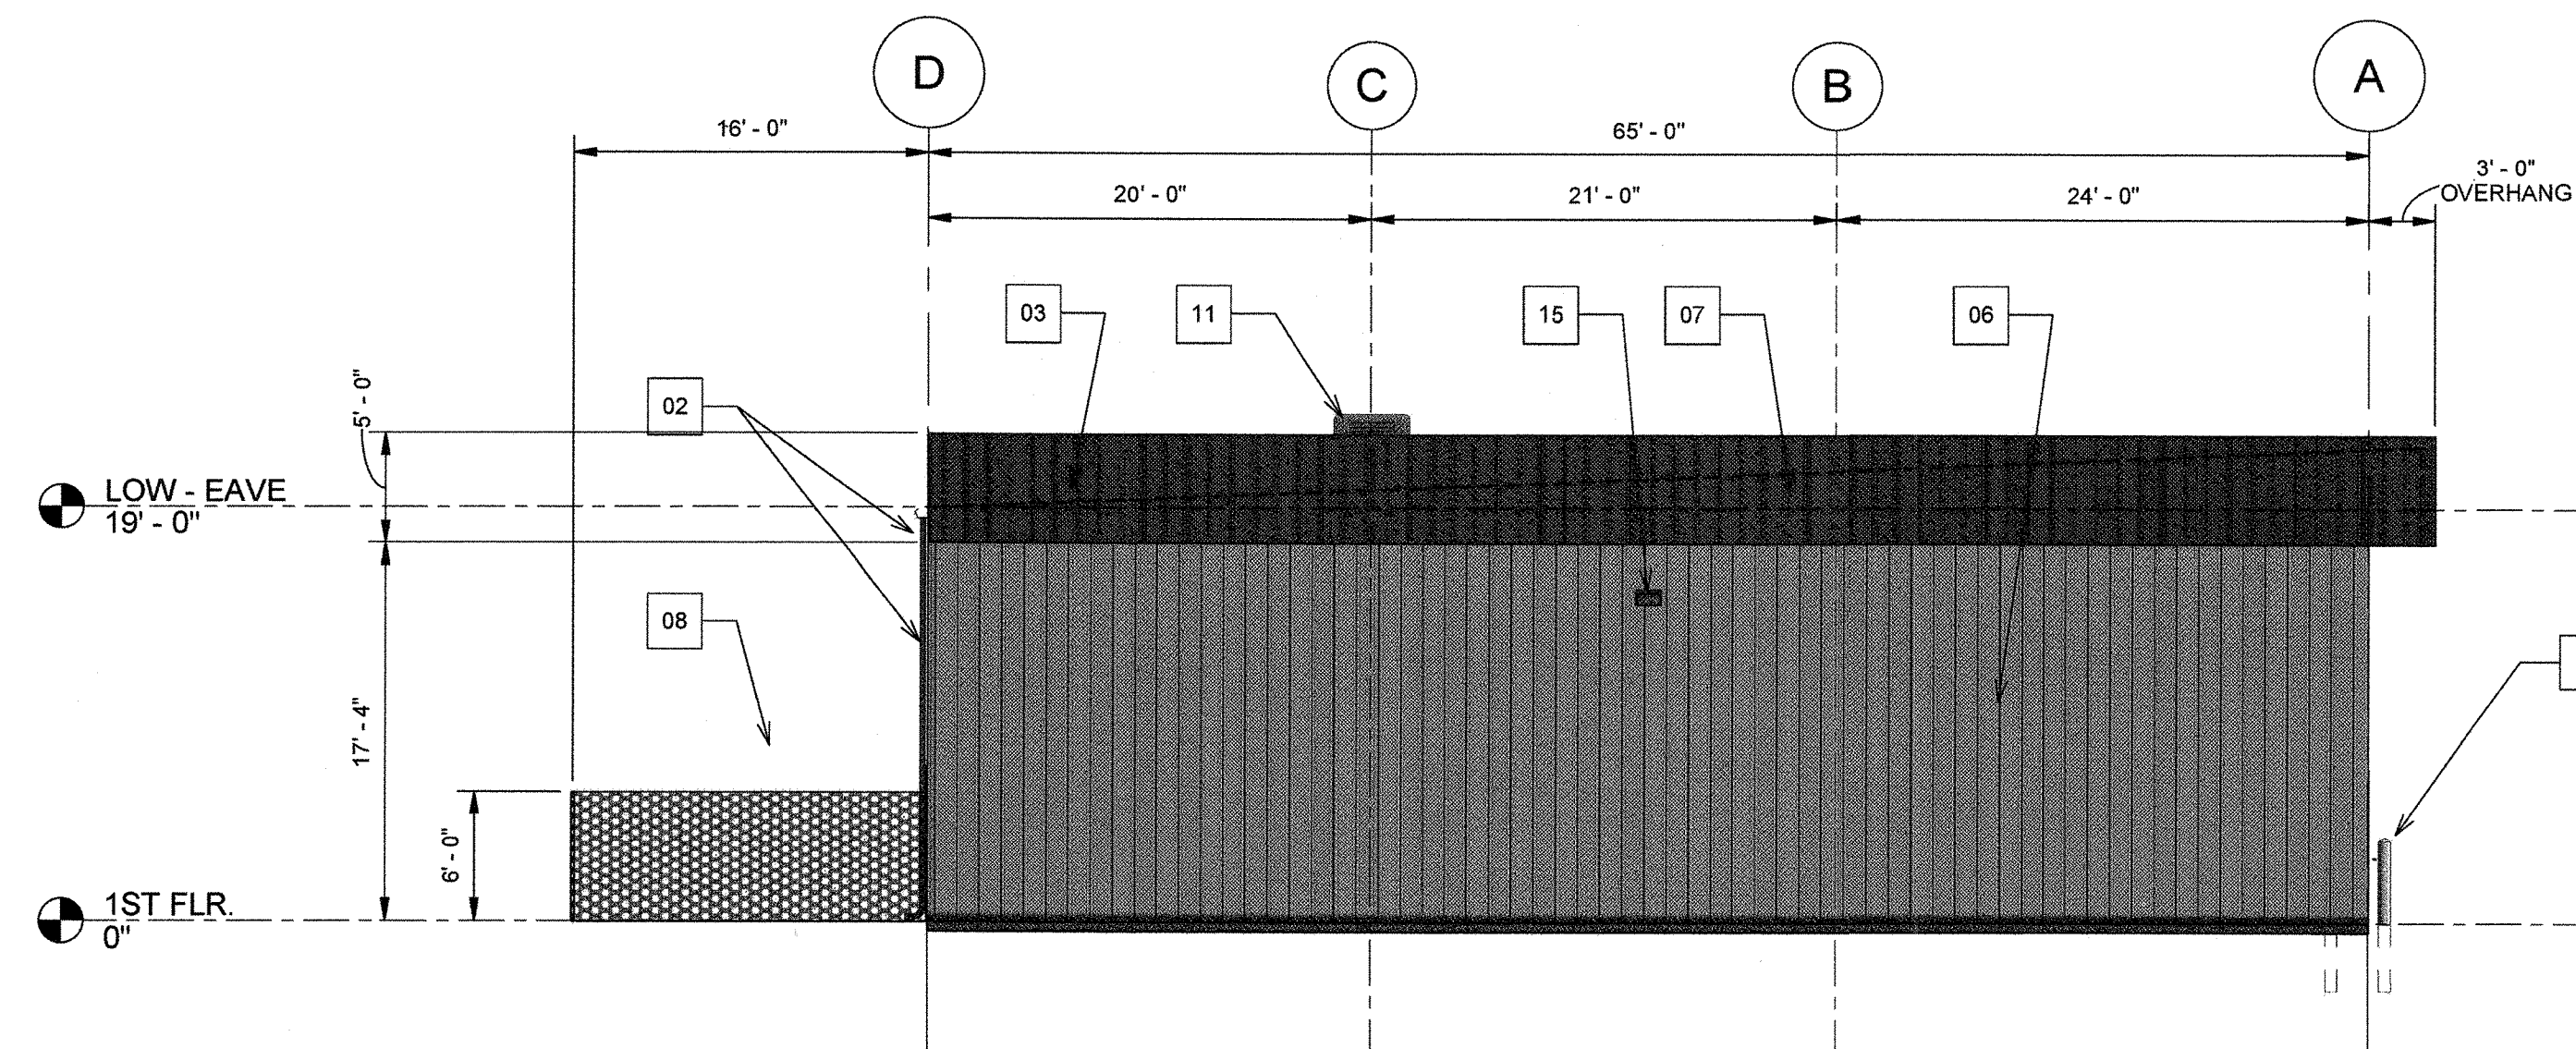


1 BLDG B - EAST ELEVATION  
A5.0B / 1/8" = 1'-0"

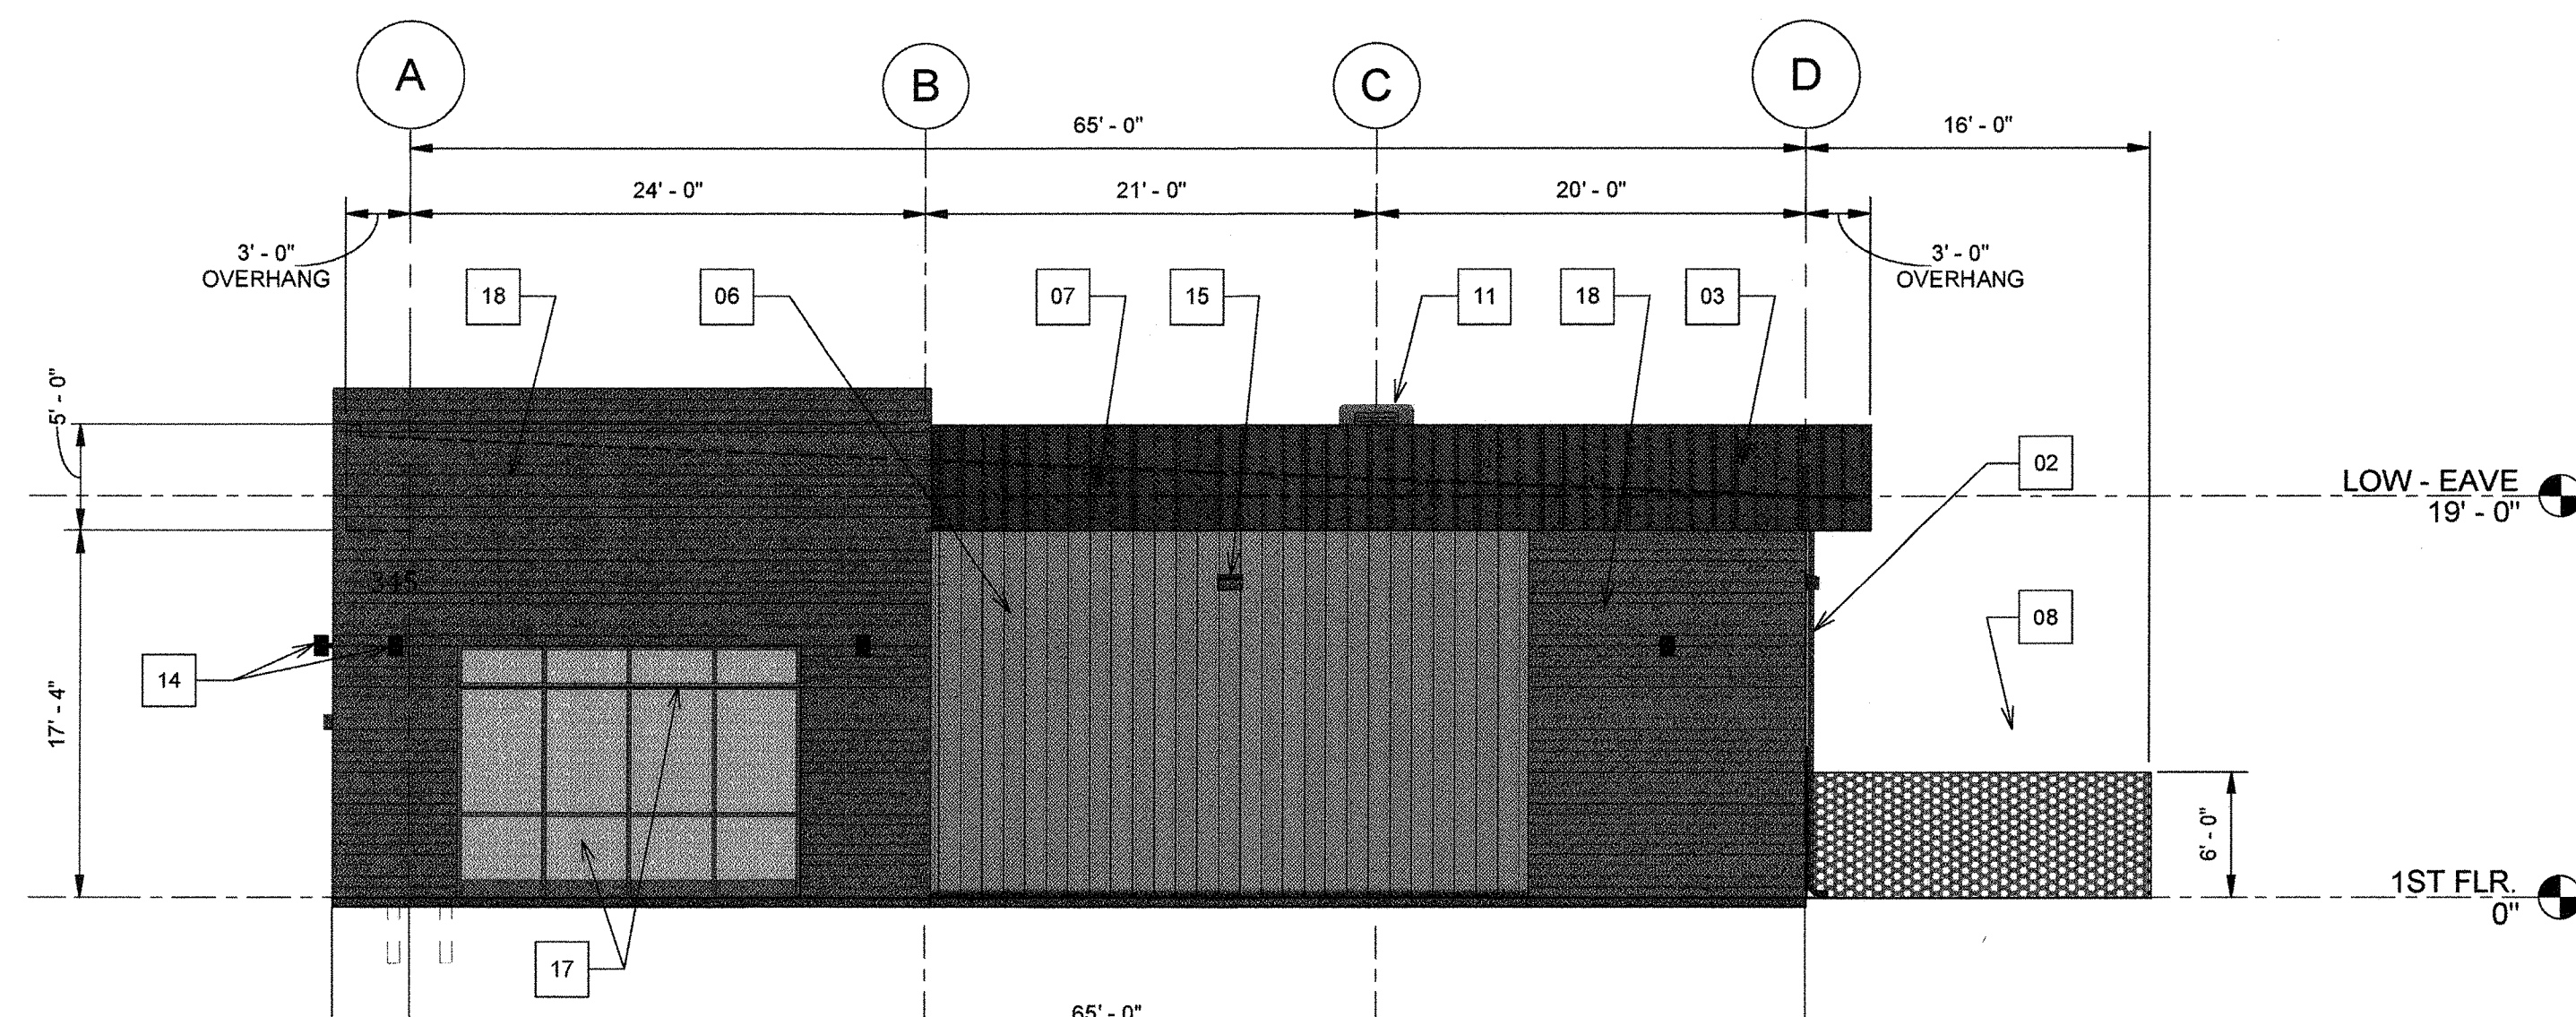

2 BLDG B - WEST ELEVATION  
A5.0B / 1/8" = 1'-0"

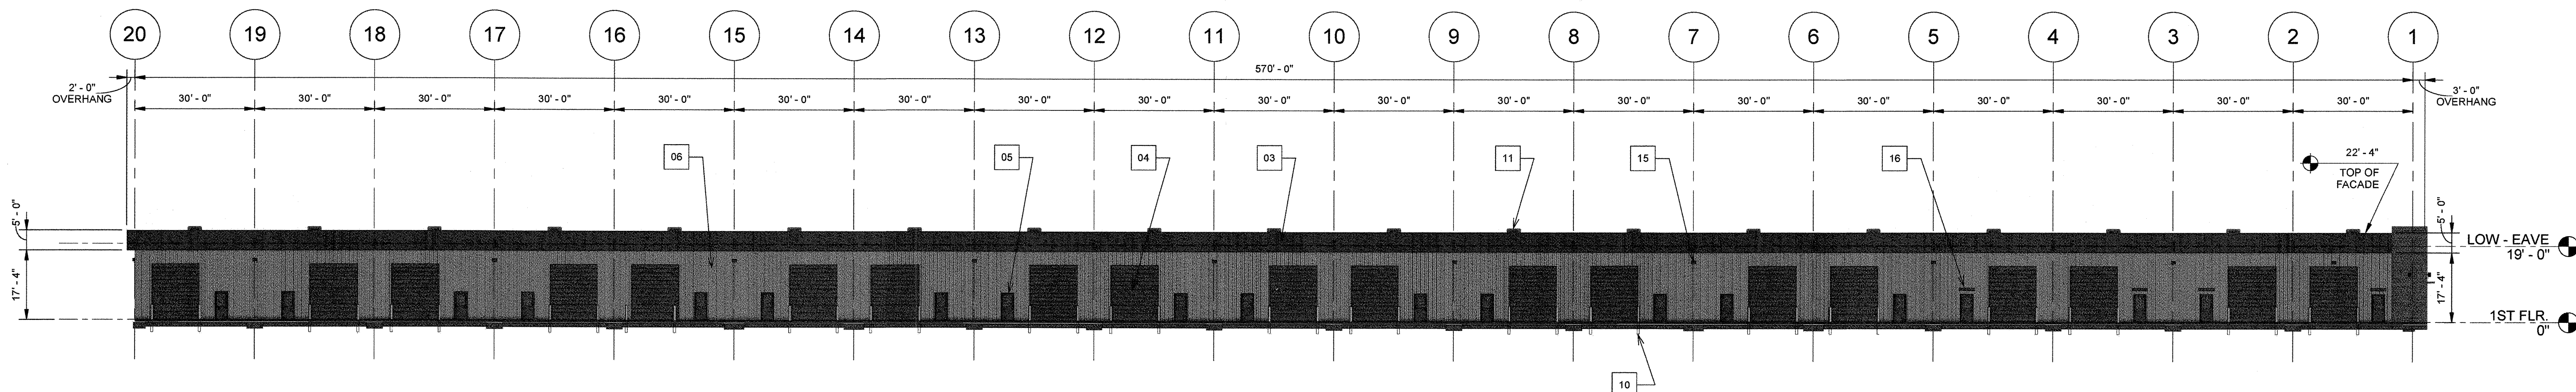

3 BLDG B - NORTH ELEVATION  
A5.0B / 1" = 20'-0"

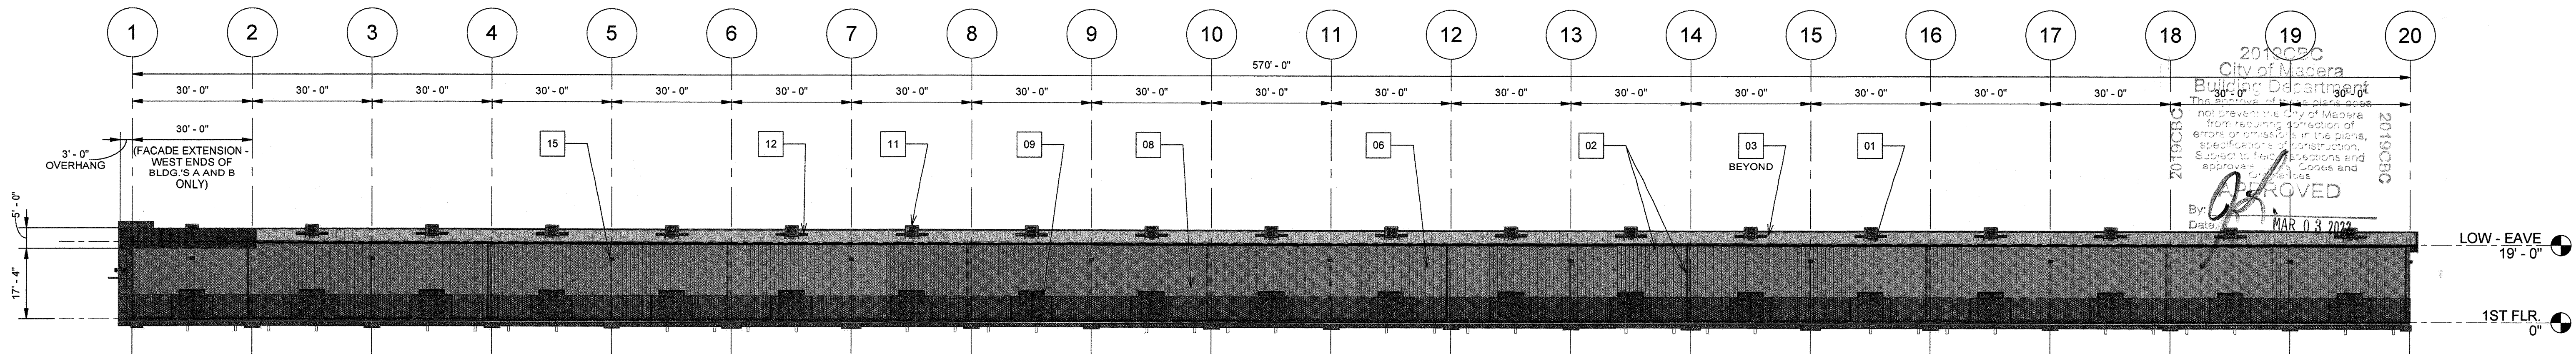


4 BLDG B - SOUTH ELEVATION  
A5.0B / 1" = 20'-0"




# ELEVATION KEYNOTES


- |  |   |   |
|--|---|---|
| 01 24 GA. R-PANEL ROOF DECK BY PEMB MANUF. (COOL ROOF / WHITE COLOR TO MEET T24 ENERGY CODE AS APPLICABLE) | 06 REVERSE RIB 26 GA. R-PANEL AT ALL EXTERIOR WALLS PER PEMB MANUF. (STANDARD GREY COLOR) | 11 ROOFTOP MOUNTED EVAPORATIVE COOLING UNIT FOR SHOP / WAREHOUSE AREA |
| 02 GUTTER AND DOWNSPOUT PER PEMB MANUFACTURER (COLOR TO MATCH WALL PANELS)                                 | 07 ROOF SLOPE BEYOND (1/2" / FT.)   | 12 (1) 4'x8' SKY-LIGHT EACH UNIT                                      |
| 03 PROJECTED FACADE 26 GA. R-PANEL PER PEMB MANUFACTURER (STANDARD BLUE COLOR PER MANUFACTURER)            | 08 6' TALL CHAINLINK FENCE AT YARDS W/ PRIVACY SLATS                                      | 13 BACK-LIGHT BUILDING SIGNAGE (UNDER SEPARATE PERMIT)                |
| 04 12'x14' OVERHEAD DOORS - STANDARD GREY COLOR  | 09 DOUBLE-LEAF 10' WIDE ACCESS IN CHAIN LINK FENCE AT YARDS                               | 14 ARCH. WALL LIGHT   |
| 05 3'x7' WALK-DOOR / ENTRANCE (PAINTED BLUE COLOR TO MATCH BLDG. FACADE PANEL)                             | 10 NEW 4"Øx4'-0" SAFETY BOLLARD (PAINTED SAFETY YELLOW)                                   | 15 LED WALL PACK FOR SITE LIGHTING AS REQ'D. PER ELECTRICAL ENGINEER  |

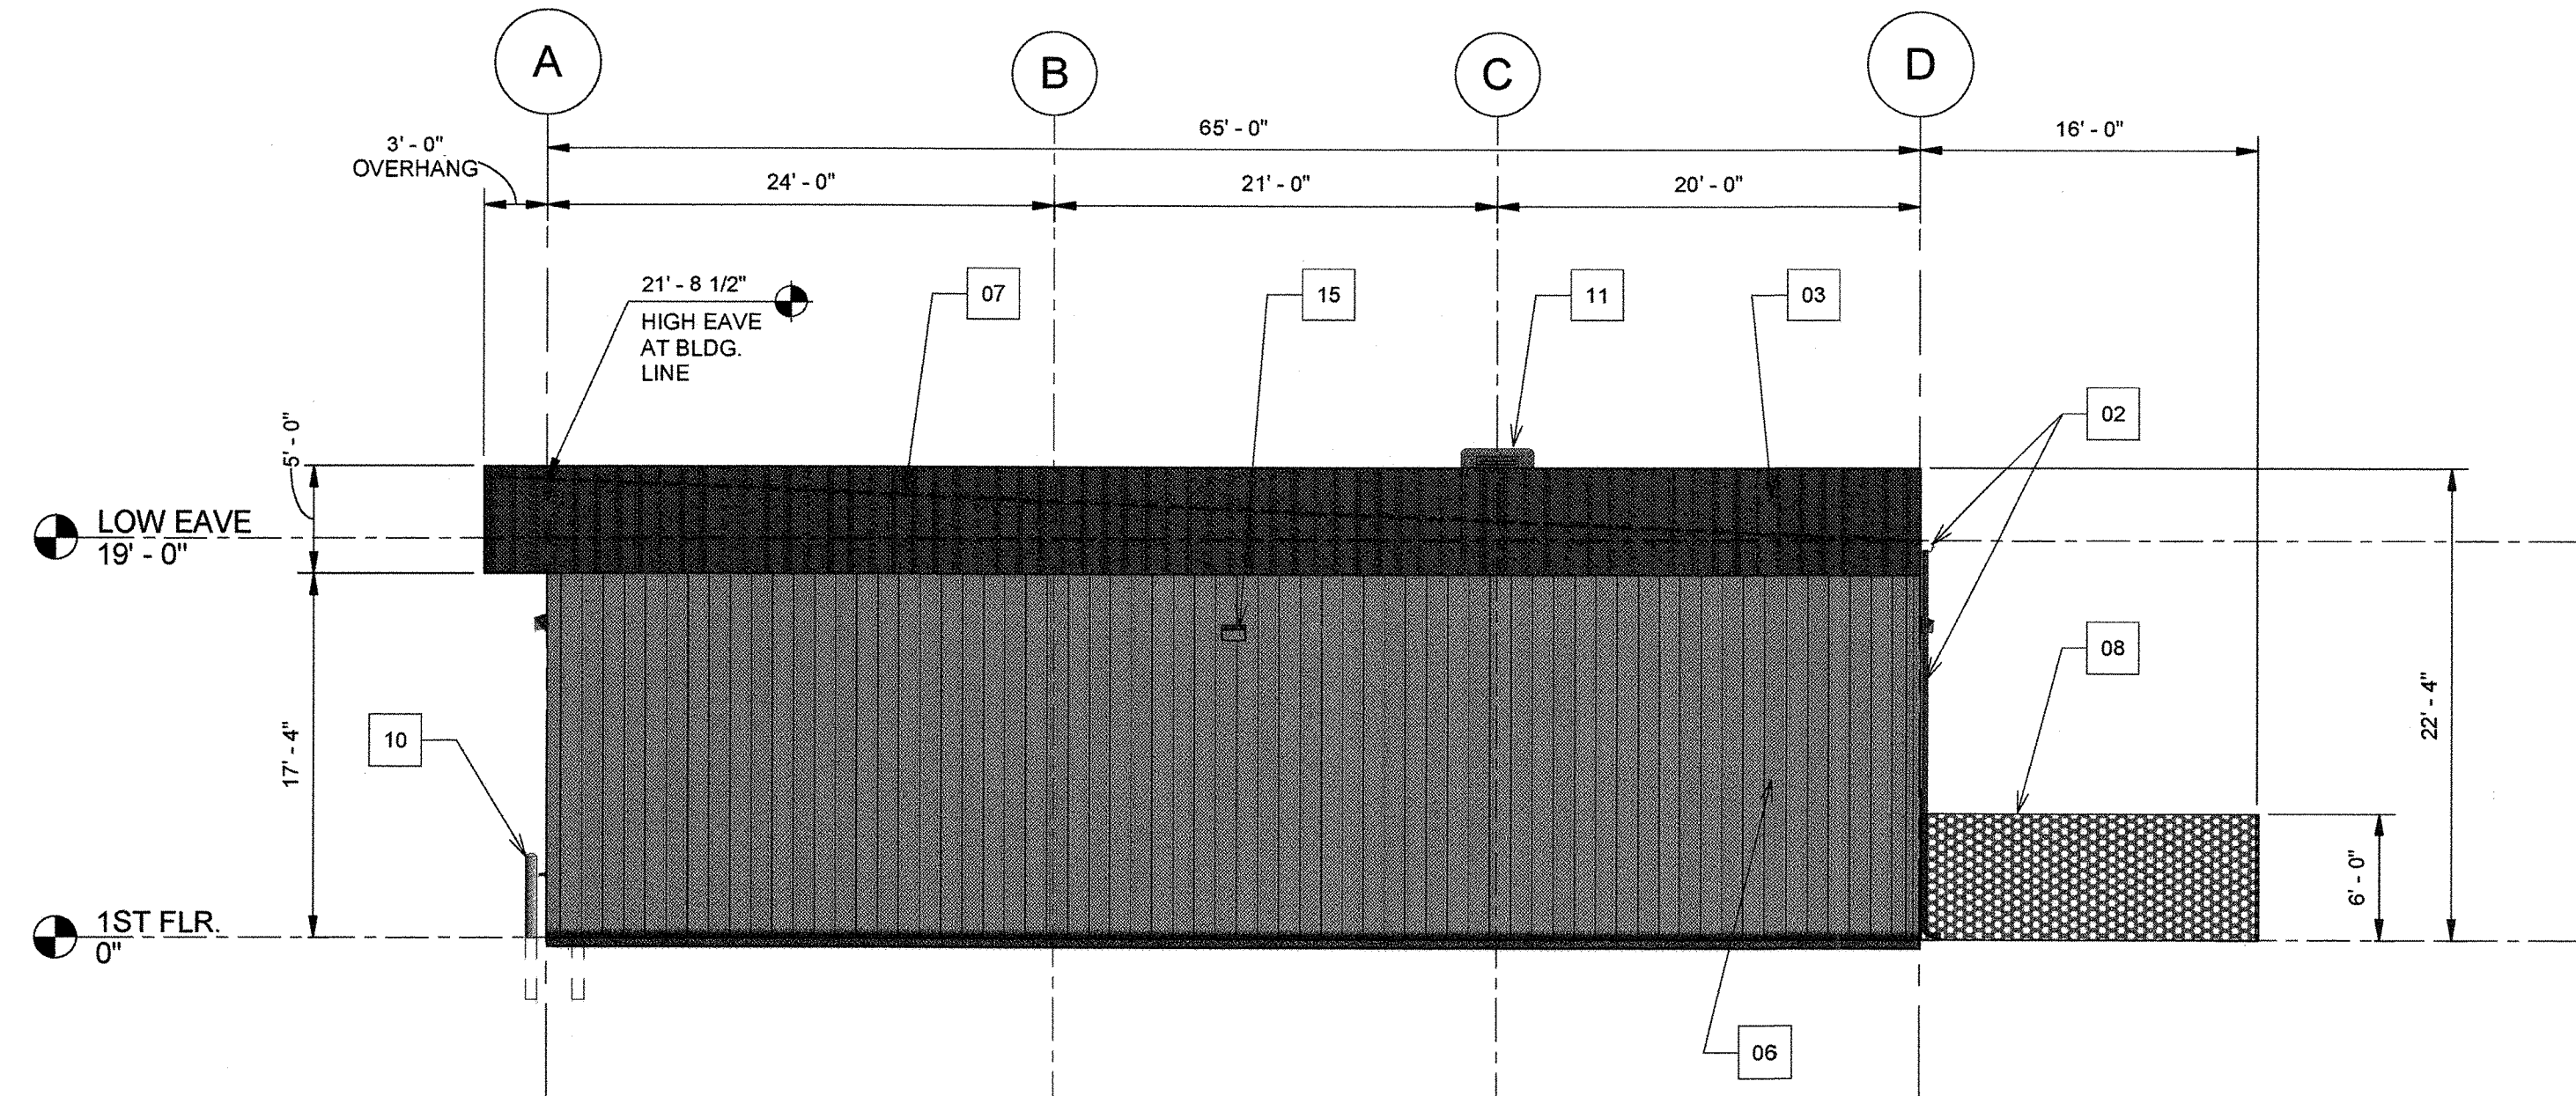


1 BLDG. C - EAST ELEVATION  
1/8" = 1'-0"

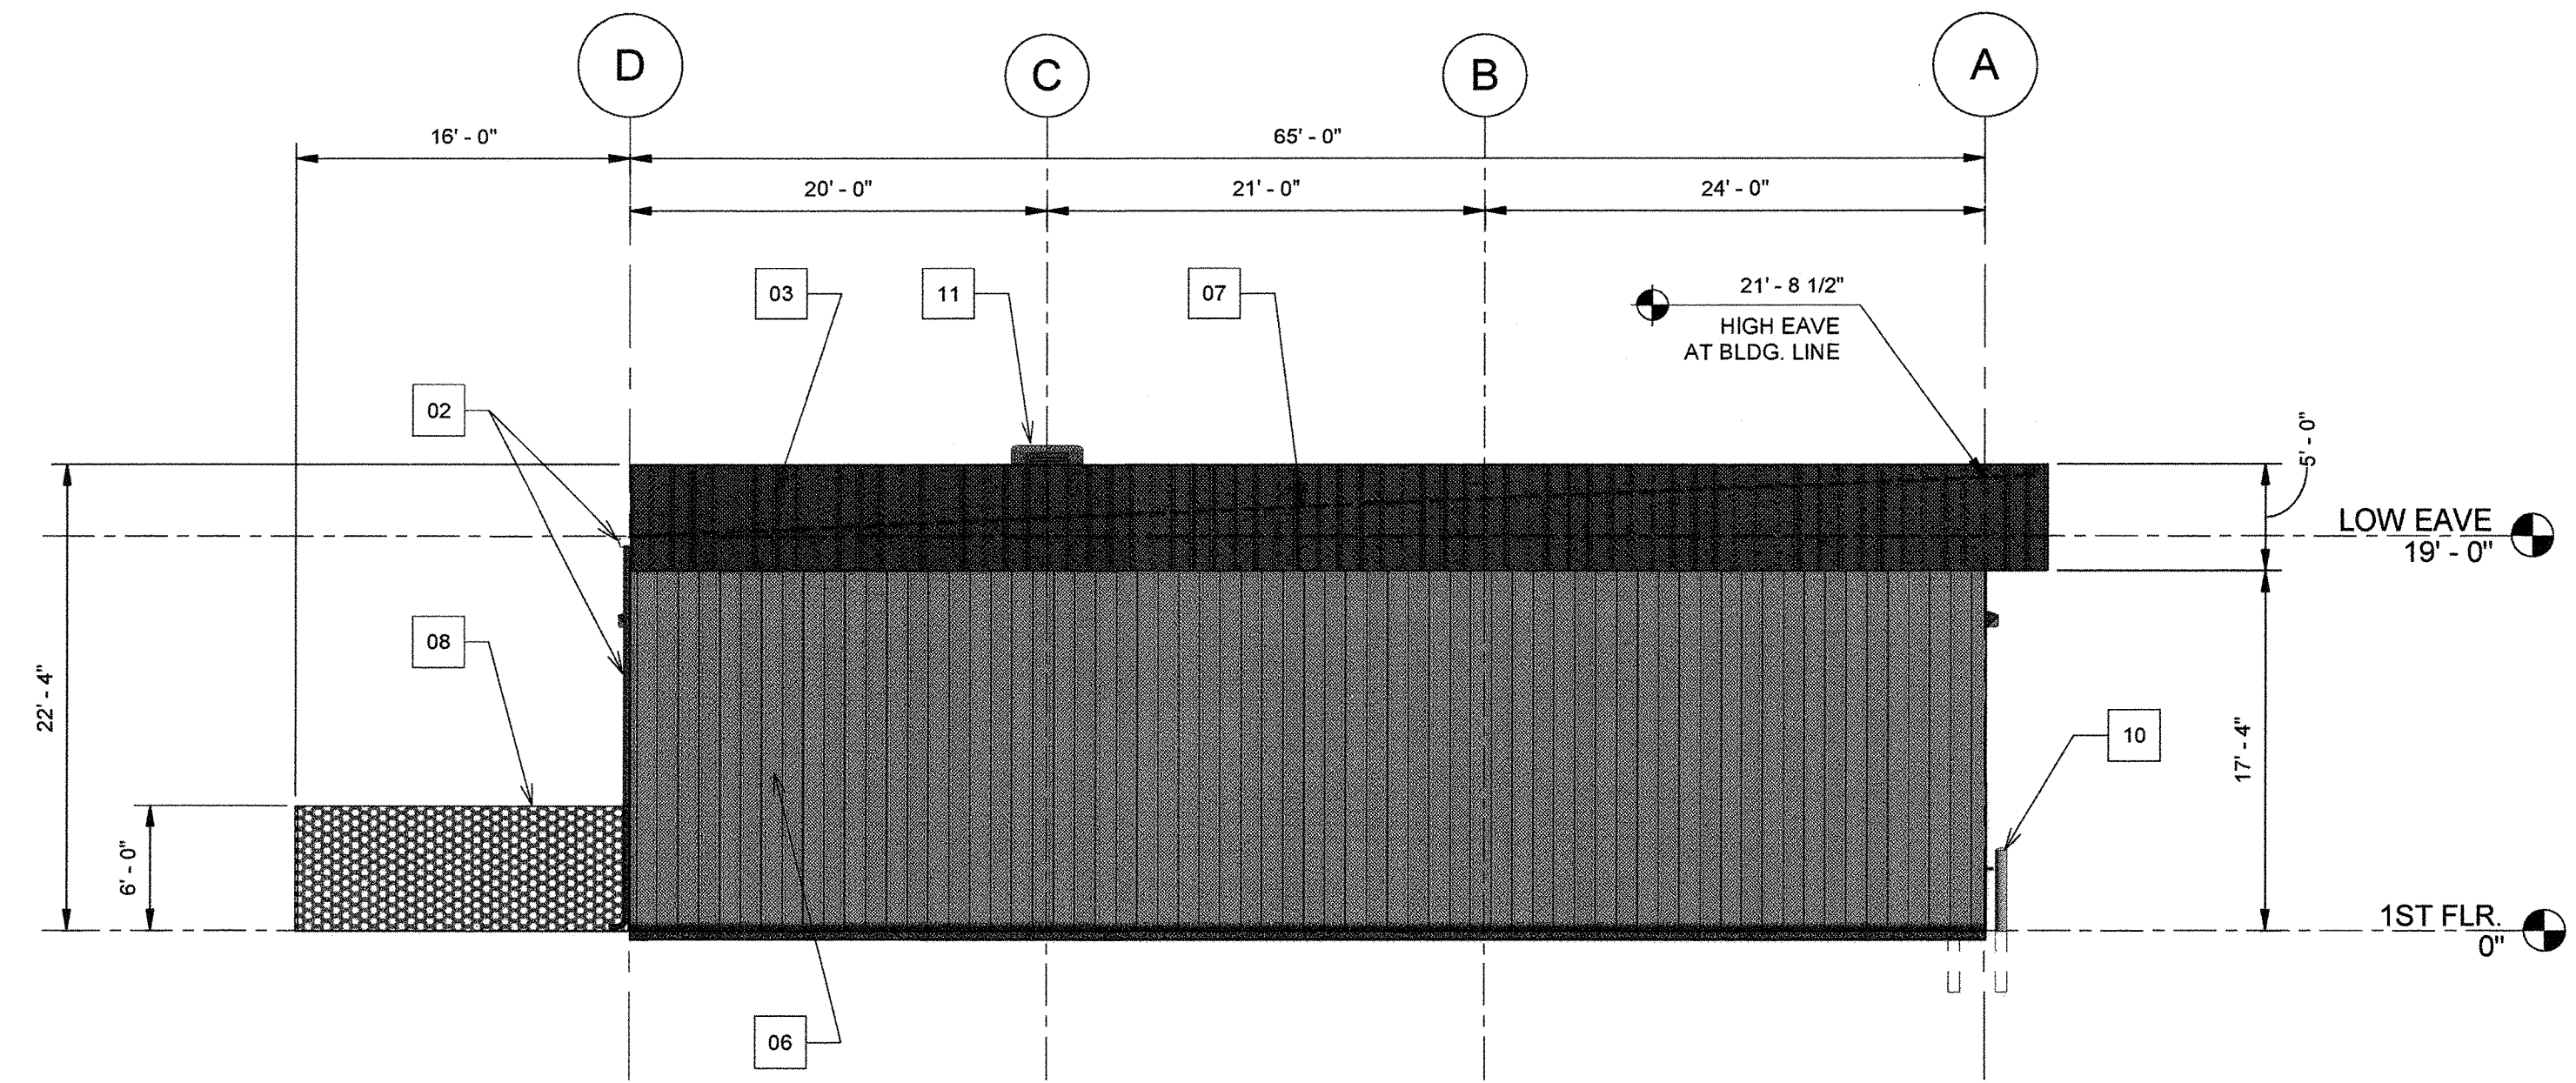

2 BLDG. C - WEST ELEVATION  
1/8" = 1'-0"

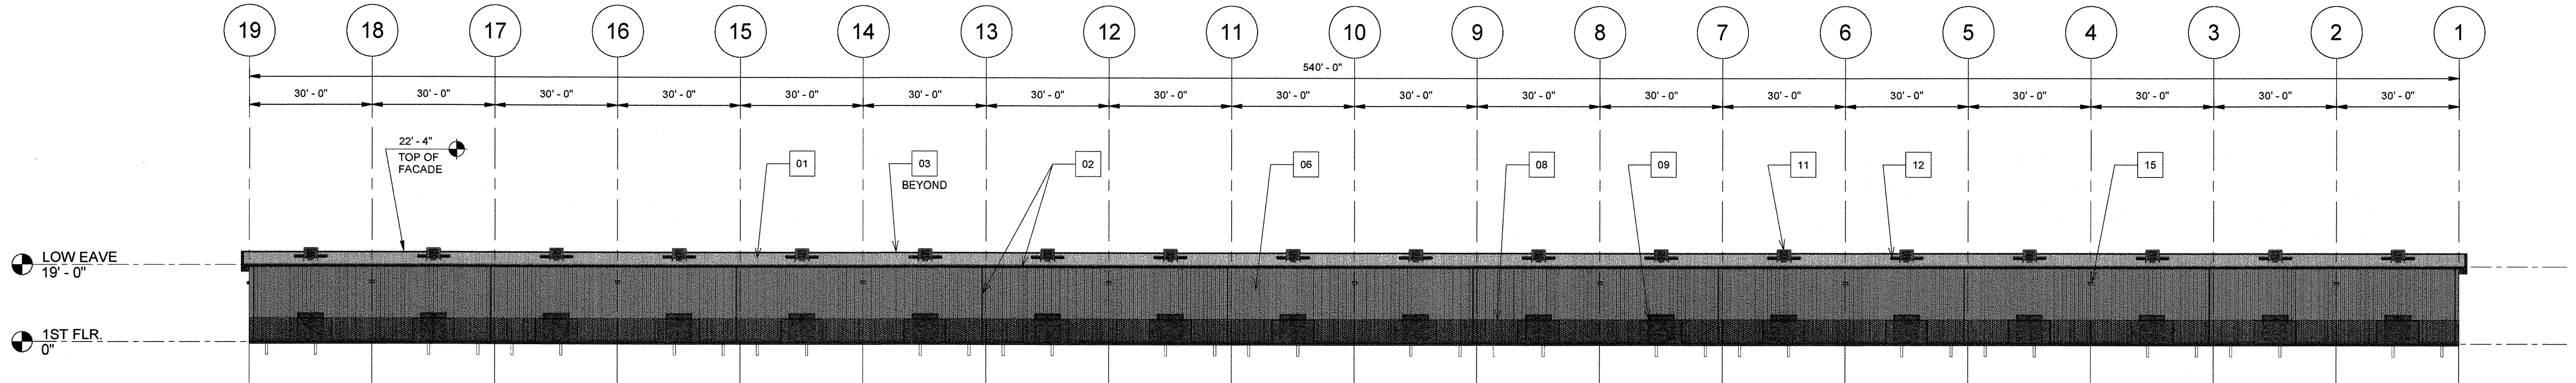

3 BLDG C - NORTH  
1" = 20'-0"

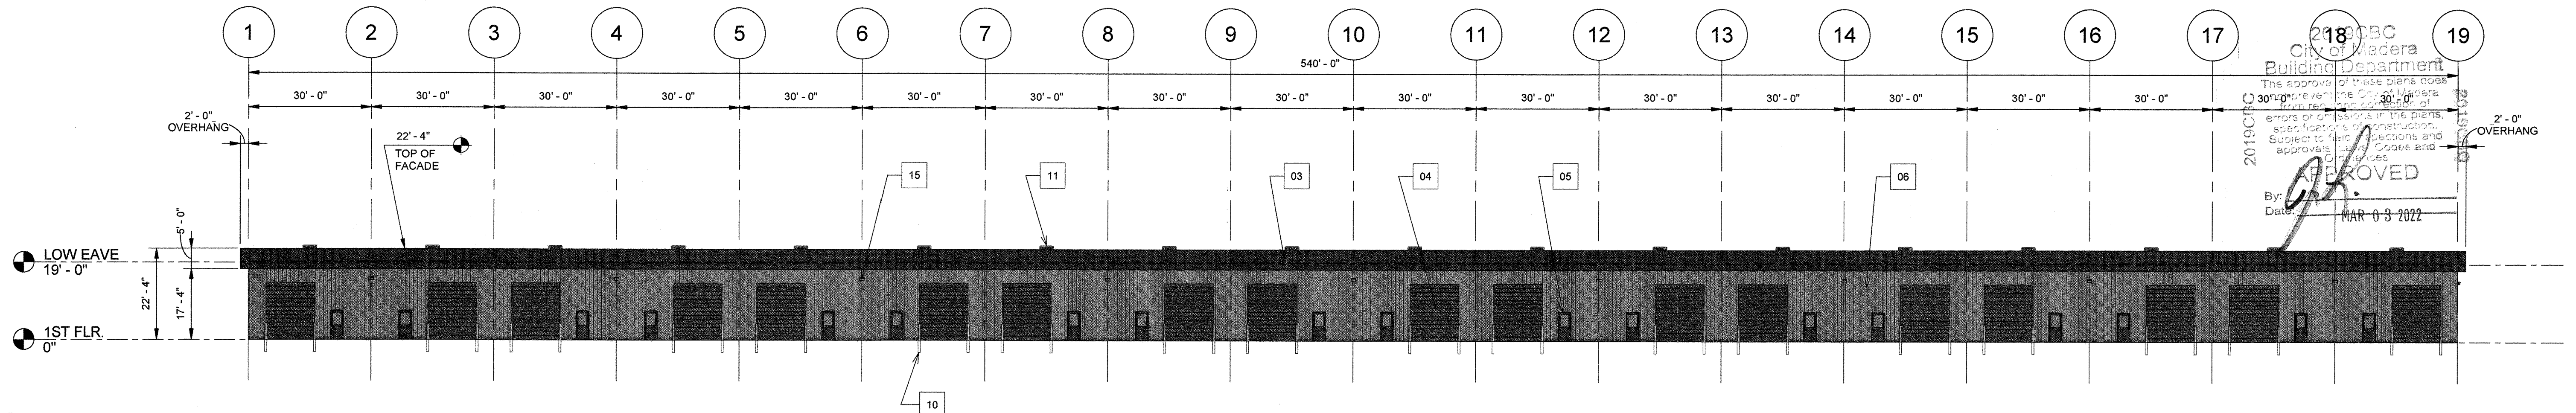

4 BLDG C - SOUTH  
1" = 20'-0"




# ELEVATION KEYNOTES

- 01 24 GA. R-PANEL ROOF DECK BY PEMB MANUF. (COOL ROOF / WHITE COLOR TO MEET T24 ENERGY CODE AS APPLICABLE)
- 02 GUTTER AND DOWNSPOUT PER PEMB MANUFACTURER (COLOR TO MATCH WALL PANELS)
- 03 PROJECTED FACADE 26 GA. R-PANEL PER PEMB MANUFACTURER (STANDARD BLUE COLOR PER MANUFACTURER)
- 04 12"x14" OVERHEAD DOORS - STANDARD GREY COLOR
- 05 3'x7' WALK-DOOR / ENTRANCE (PAINTED BLUE COLOR TO MATCH BLDG. FACADE PANEL)


- 06 REVERSE RIB 26 GA. R-PANEL AT ALL EXTERIOR WALLS PER PEMB MANUF. (STANDARD GREY COLOR)
- 07 ROOF SLOPE BEYOND (1/2" / FT.)
- 08 6' TALL CHAINLINK FENCE AT YARDS W/ PRIVACY SLATS
- 09 DOUBLE-LEAF 10' WIDE ACCESS IN CHAIN LINK FENCE AT YARDS
- 10 NEW 4"x4"x0" SAFETY BOLLARD (PAINTED SAFETY YELLOW)

- 11 ROOFTOP MOUNTED EVAPORATIVE COOLING UNIT FOR SHOP / WAREHOUSE AREA
- 12 (1) 4'x8' SKY-LIGHT EACH UNIT
- 13 BACK-LIGHT BUILDING SIGNAGE (UNDER SEPARATE PERMIT)
- 14 ARCH. WALL LIGHT
- 15 LED WALL PACK FOR SITE LIGHTING AS REQ'D. PER ELECTRICAL ENGINEER


- 16 LOADING DOCK PER PLAN (SLOPE / GRADE PER CIVIL DRAWINGS)

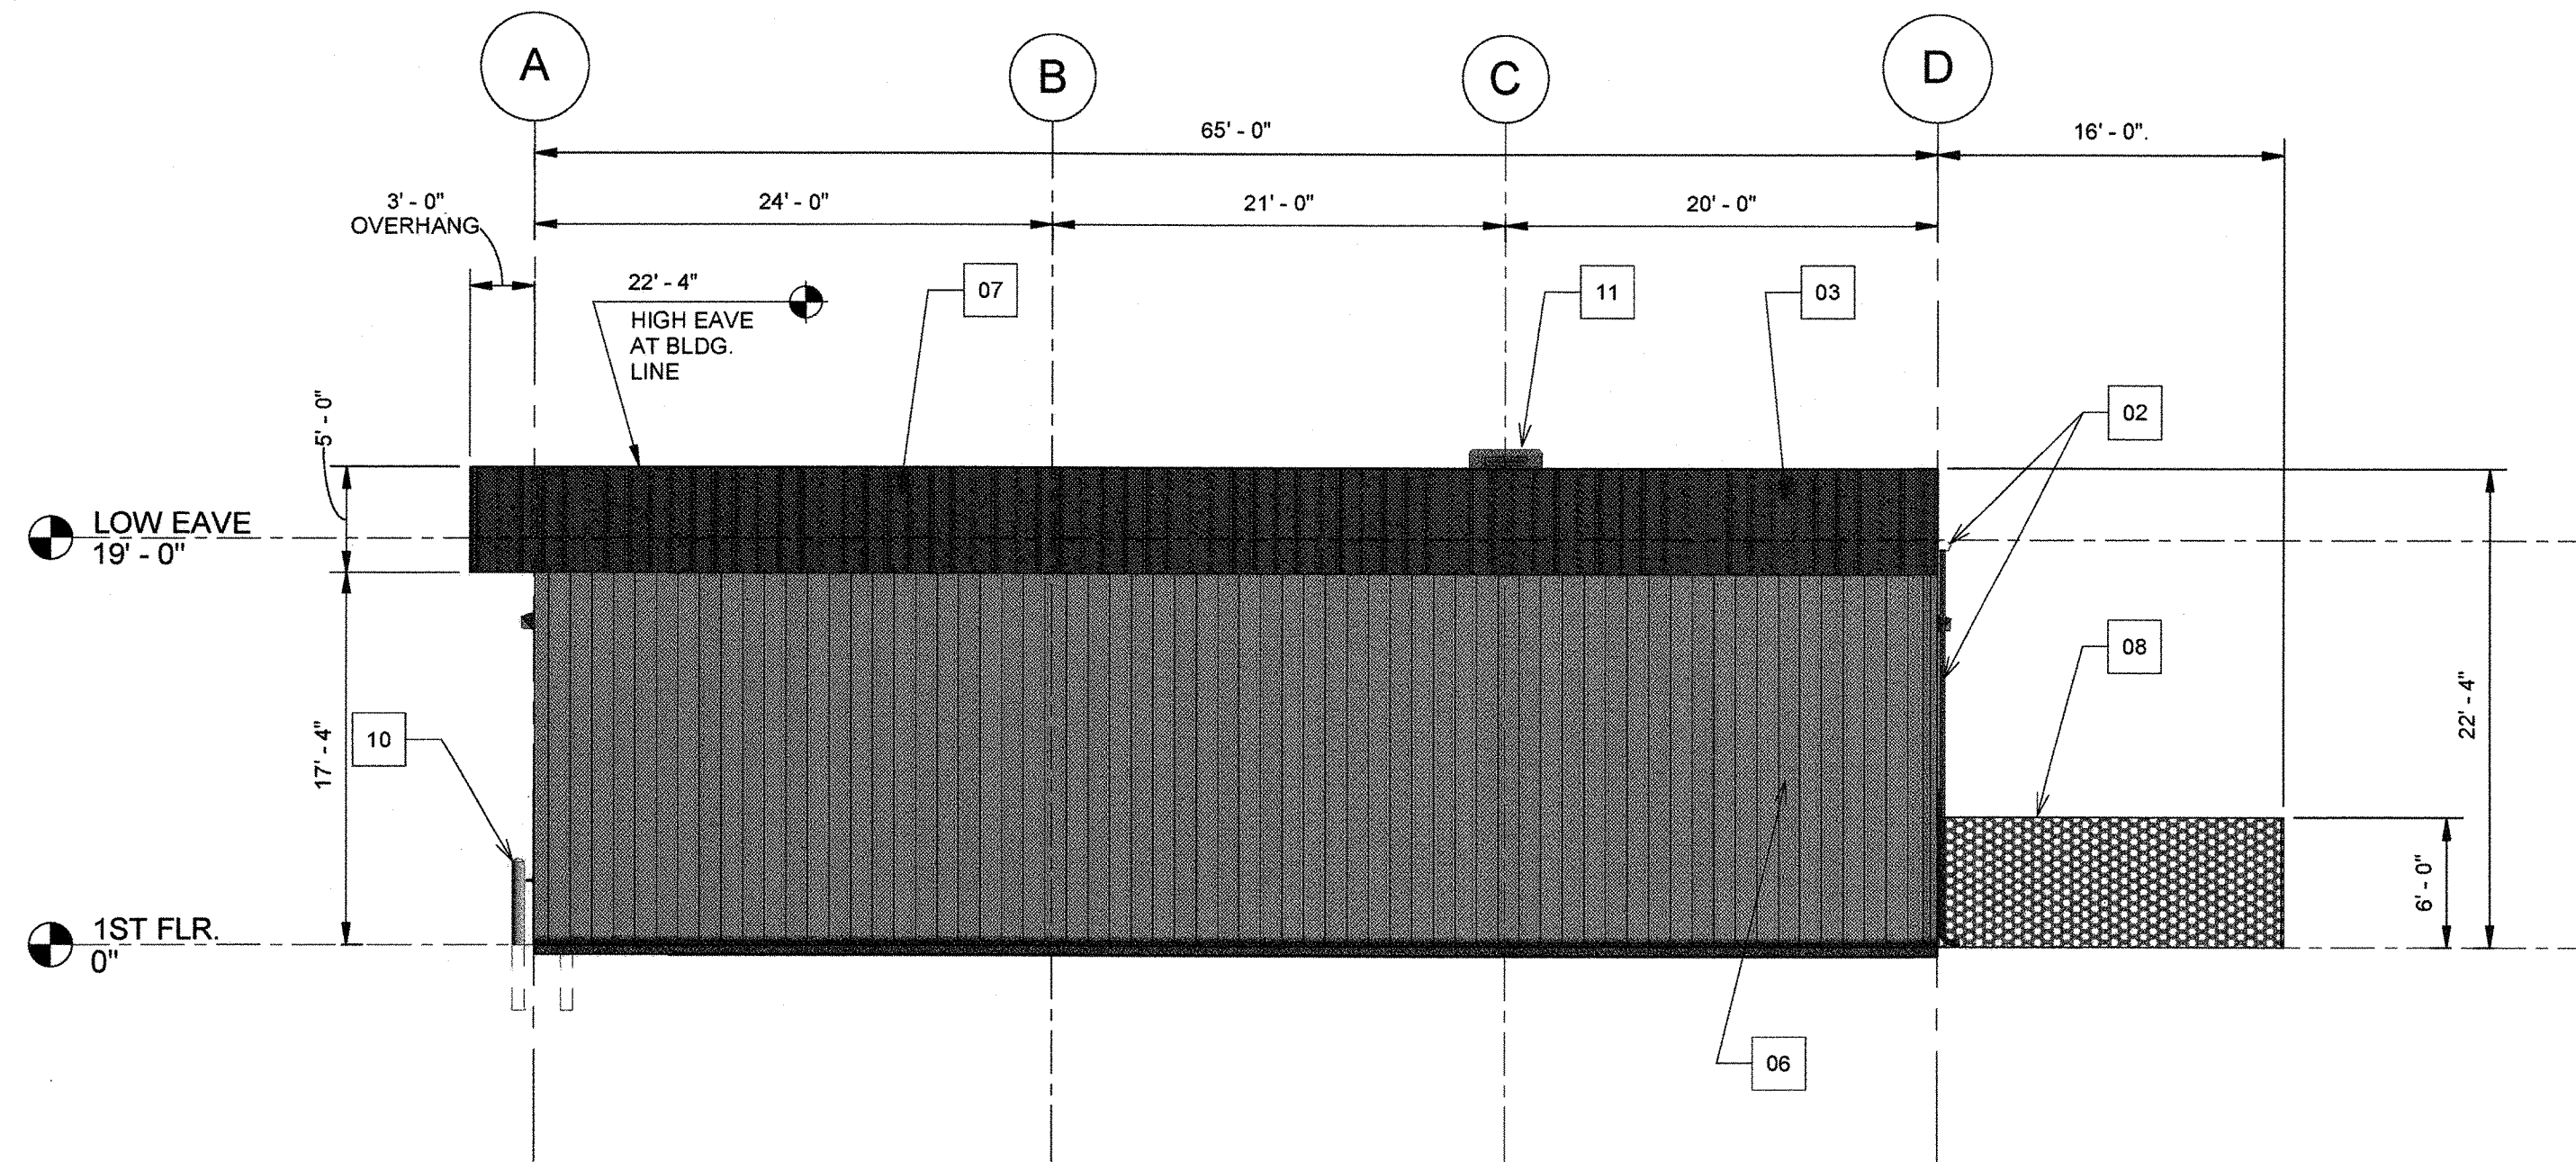


1 BLDG D - WEST  
1/8" = 1'-0"

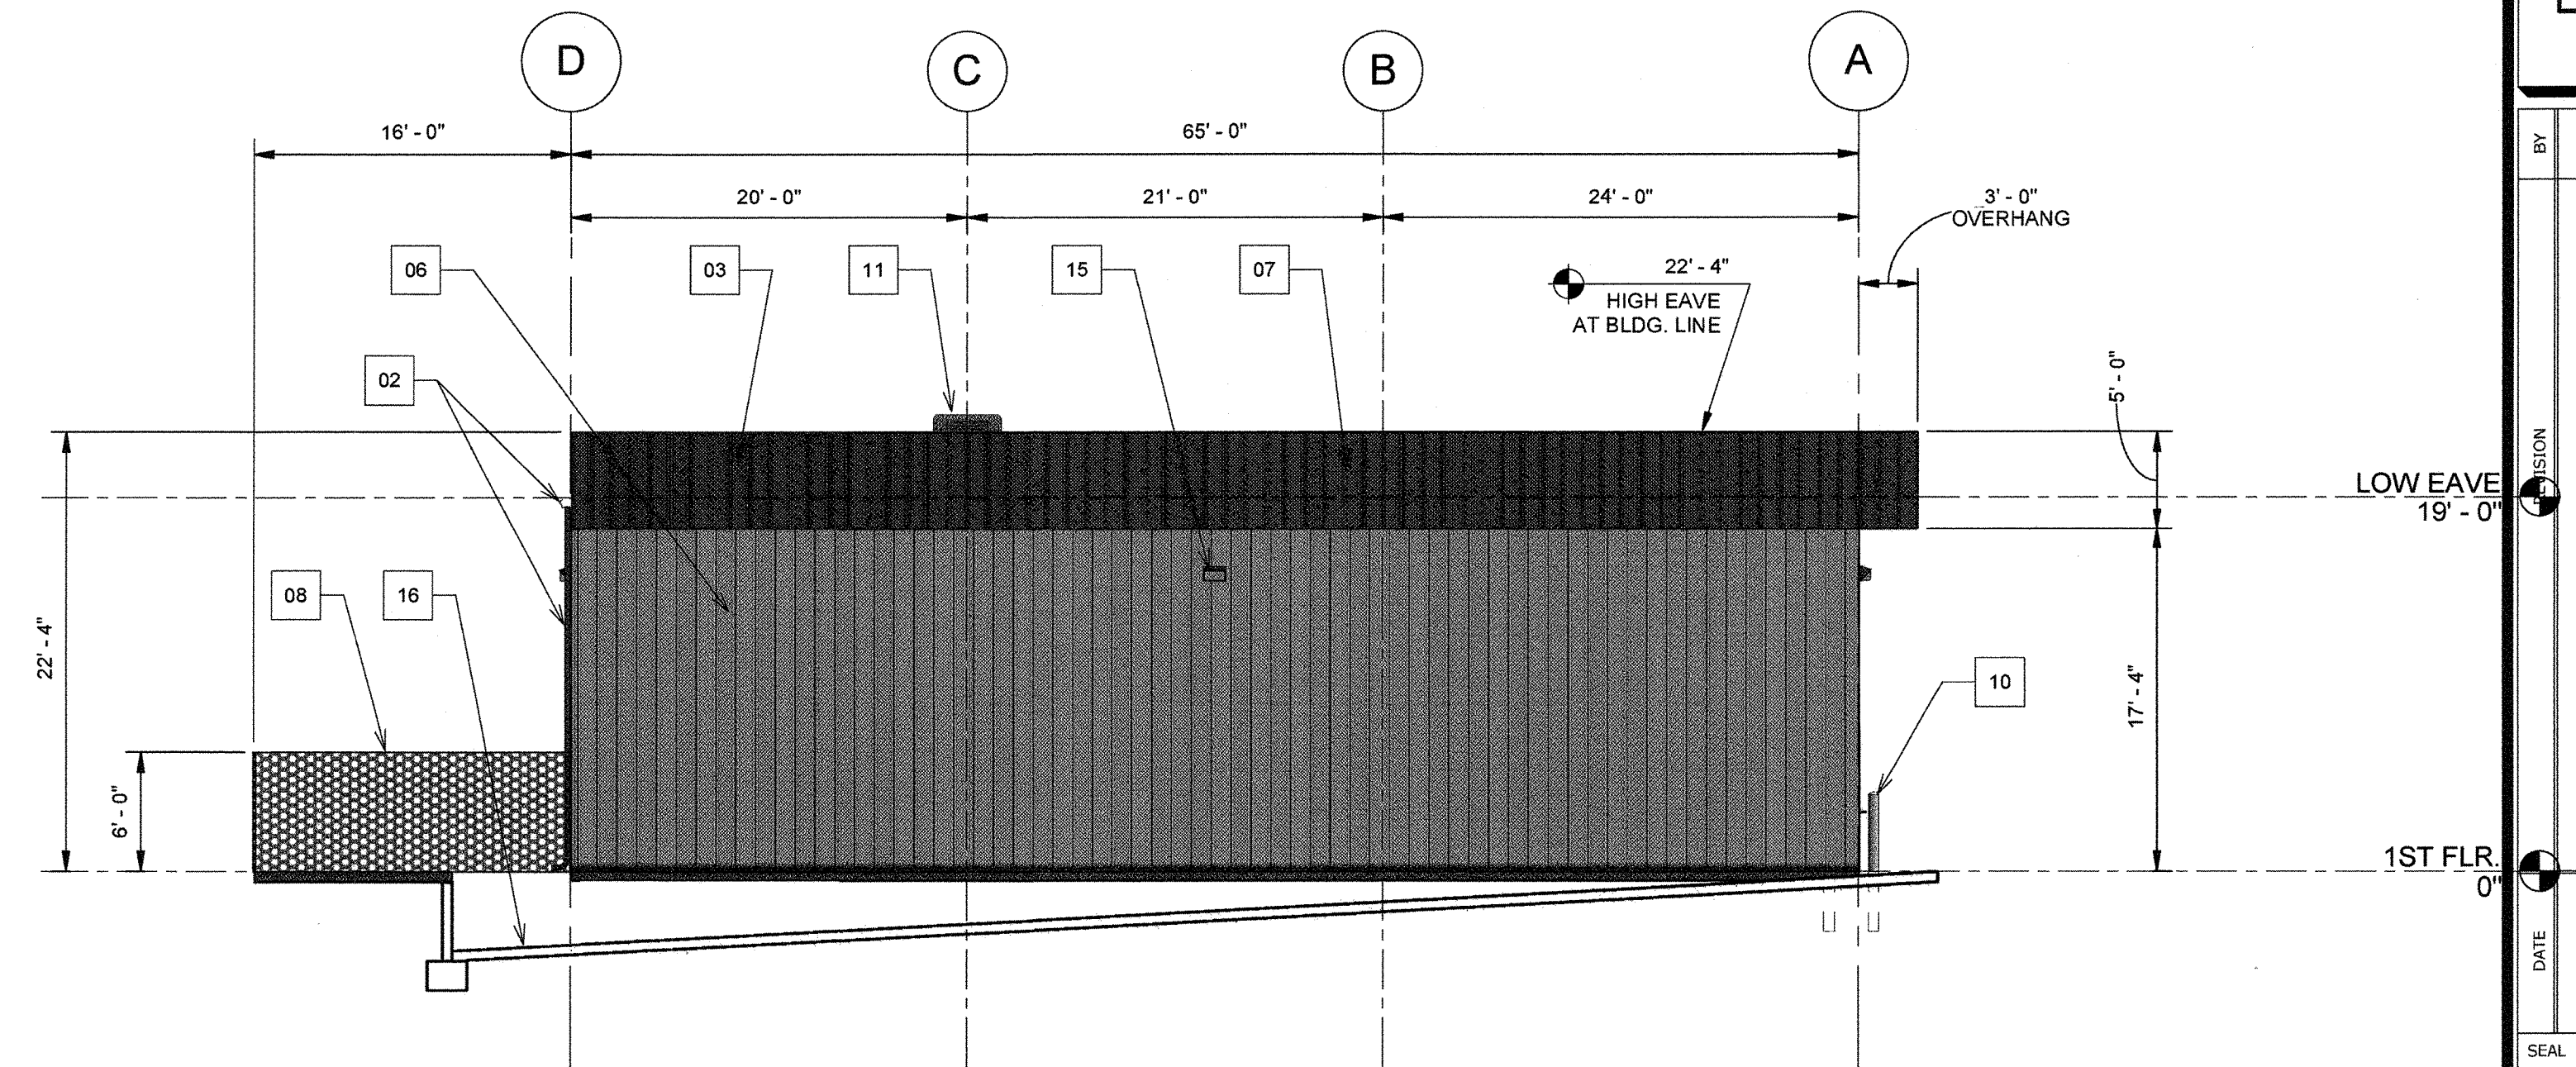

2 BLDG D - EAST  
1/8" = 1'-0"

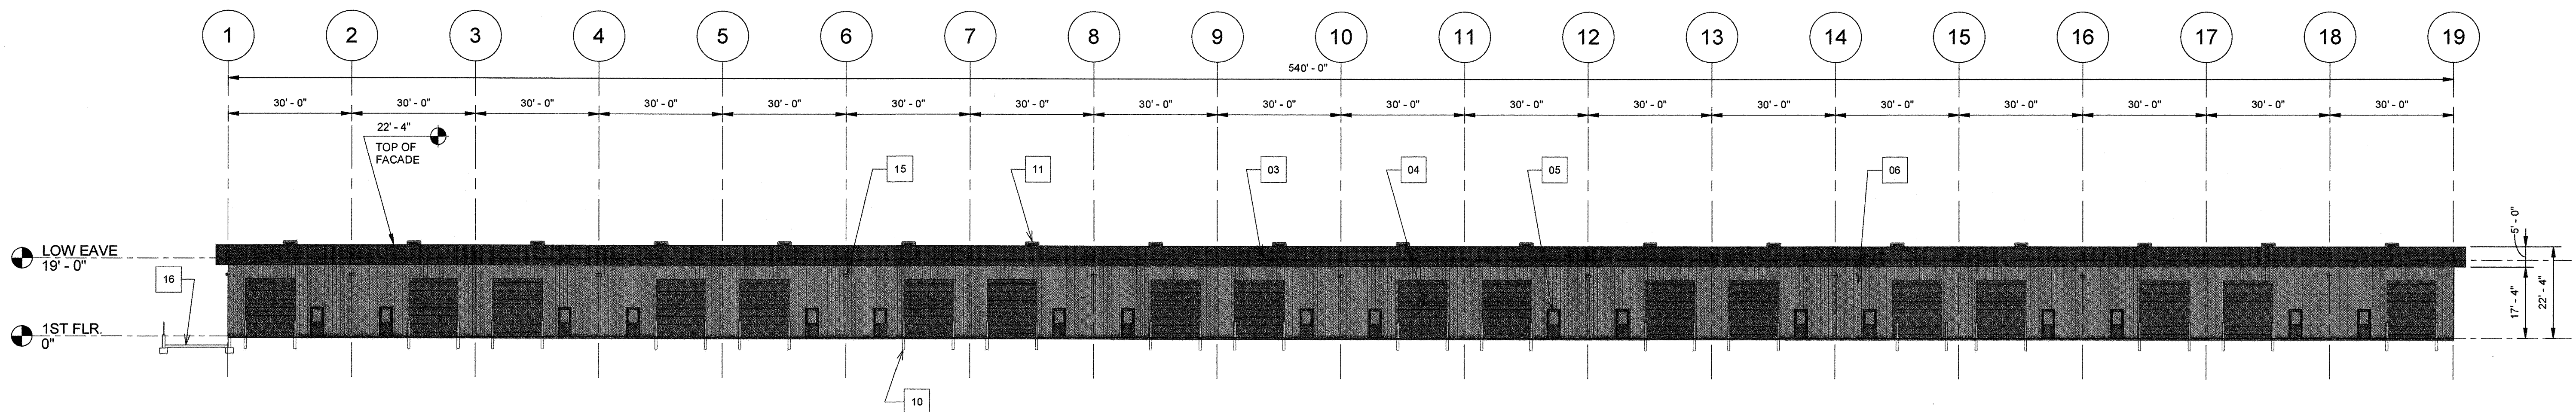

3 BLDG D - NORTH  
1" = 20'-0"

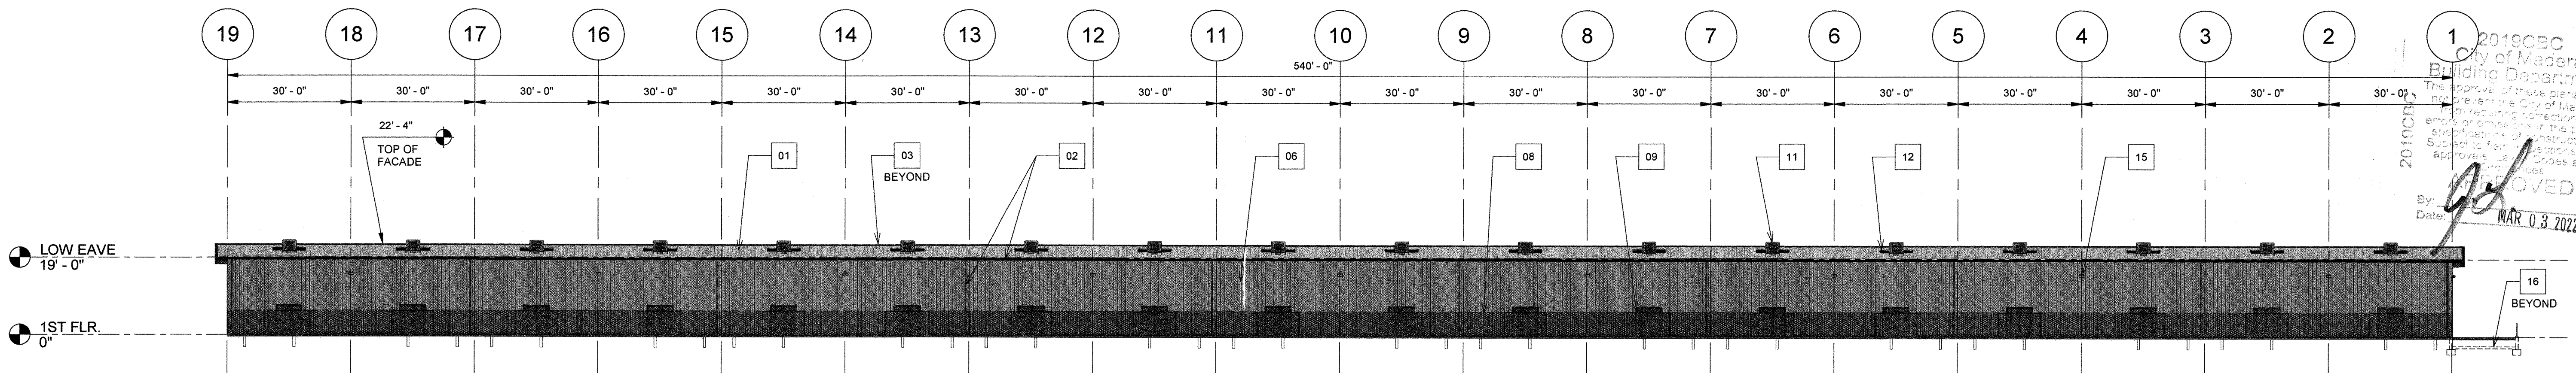


4 BLDG D - SOUTH  
1" = 20'-0"



WHSE  
[PARTNERS]

BY: [Signature]  
DATE: [Date]  
SEAL: [Seal]  
ANY INFORMATION OR DATA ON THIS DRAWING IS NOT INTENDED TO BE SUITABLE FOR REUSE BY ANY PERSON, FIRM, CORPORATION, OR ANY OTHERS ON EXTENSIONS OF THIS PROJECT OR FOR ANY USE ON ANY OTHER PROJECT. ANY REUSE WITHOUT WRITTEN VERIFICATION AND ADAPTATION BY THE ENGINEER FOR THE SPECIFIC PROJECT IS PROHIBITED. THE USER'S SOLE RISK AND WITHOUT LIABILITY OR LEGAL EXPOSURE TO THE ENGINEER.

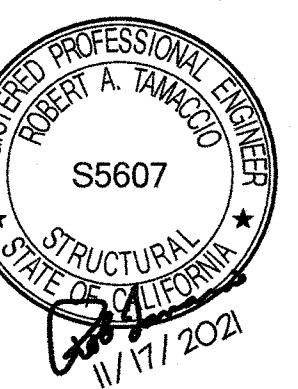


EXTERIOR ELEVATIONS - BLDG. D  
FOR  
LEASE FLEX. / WAREHOUSE BUILDINGS  
MADERA INDUSTRIAL WHSE, LLC  
S. SCHNOOR AVENUE, MADERA, CA


JOB NUMBER: 21107  
DESIGNED BY: RT  
DRAWN BY: LM  
DATE: 9/17/2021  
SHEET NUMBER: A5.0D

City of Madera  
Building Department  
The approval of these plans does not constitute the City of Madera endorsing or guaranteeing the construction of the project. The City of Madera is not responsible for the construction of the project.  
By: [Signature]  
Date: MAR 03 2022



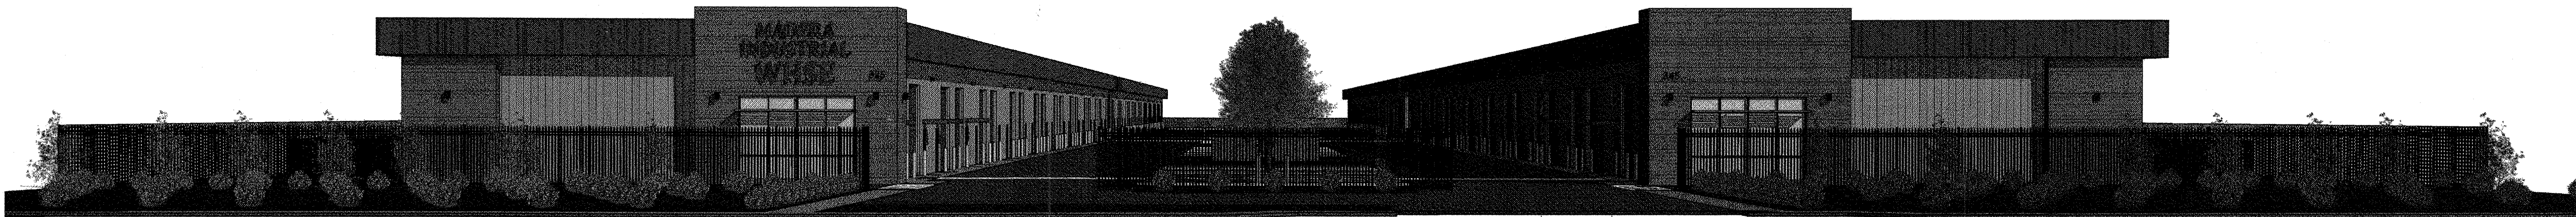

1  
A5.1 CONCEPT VIEW 1

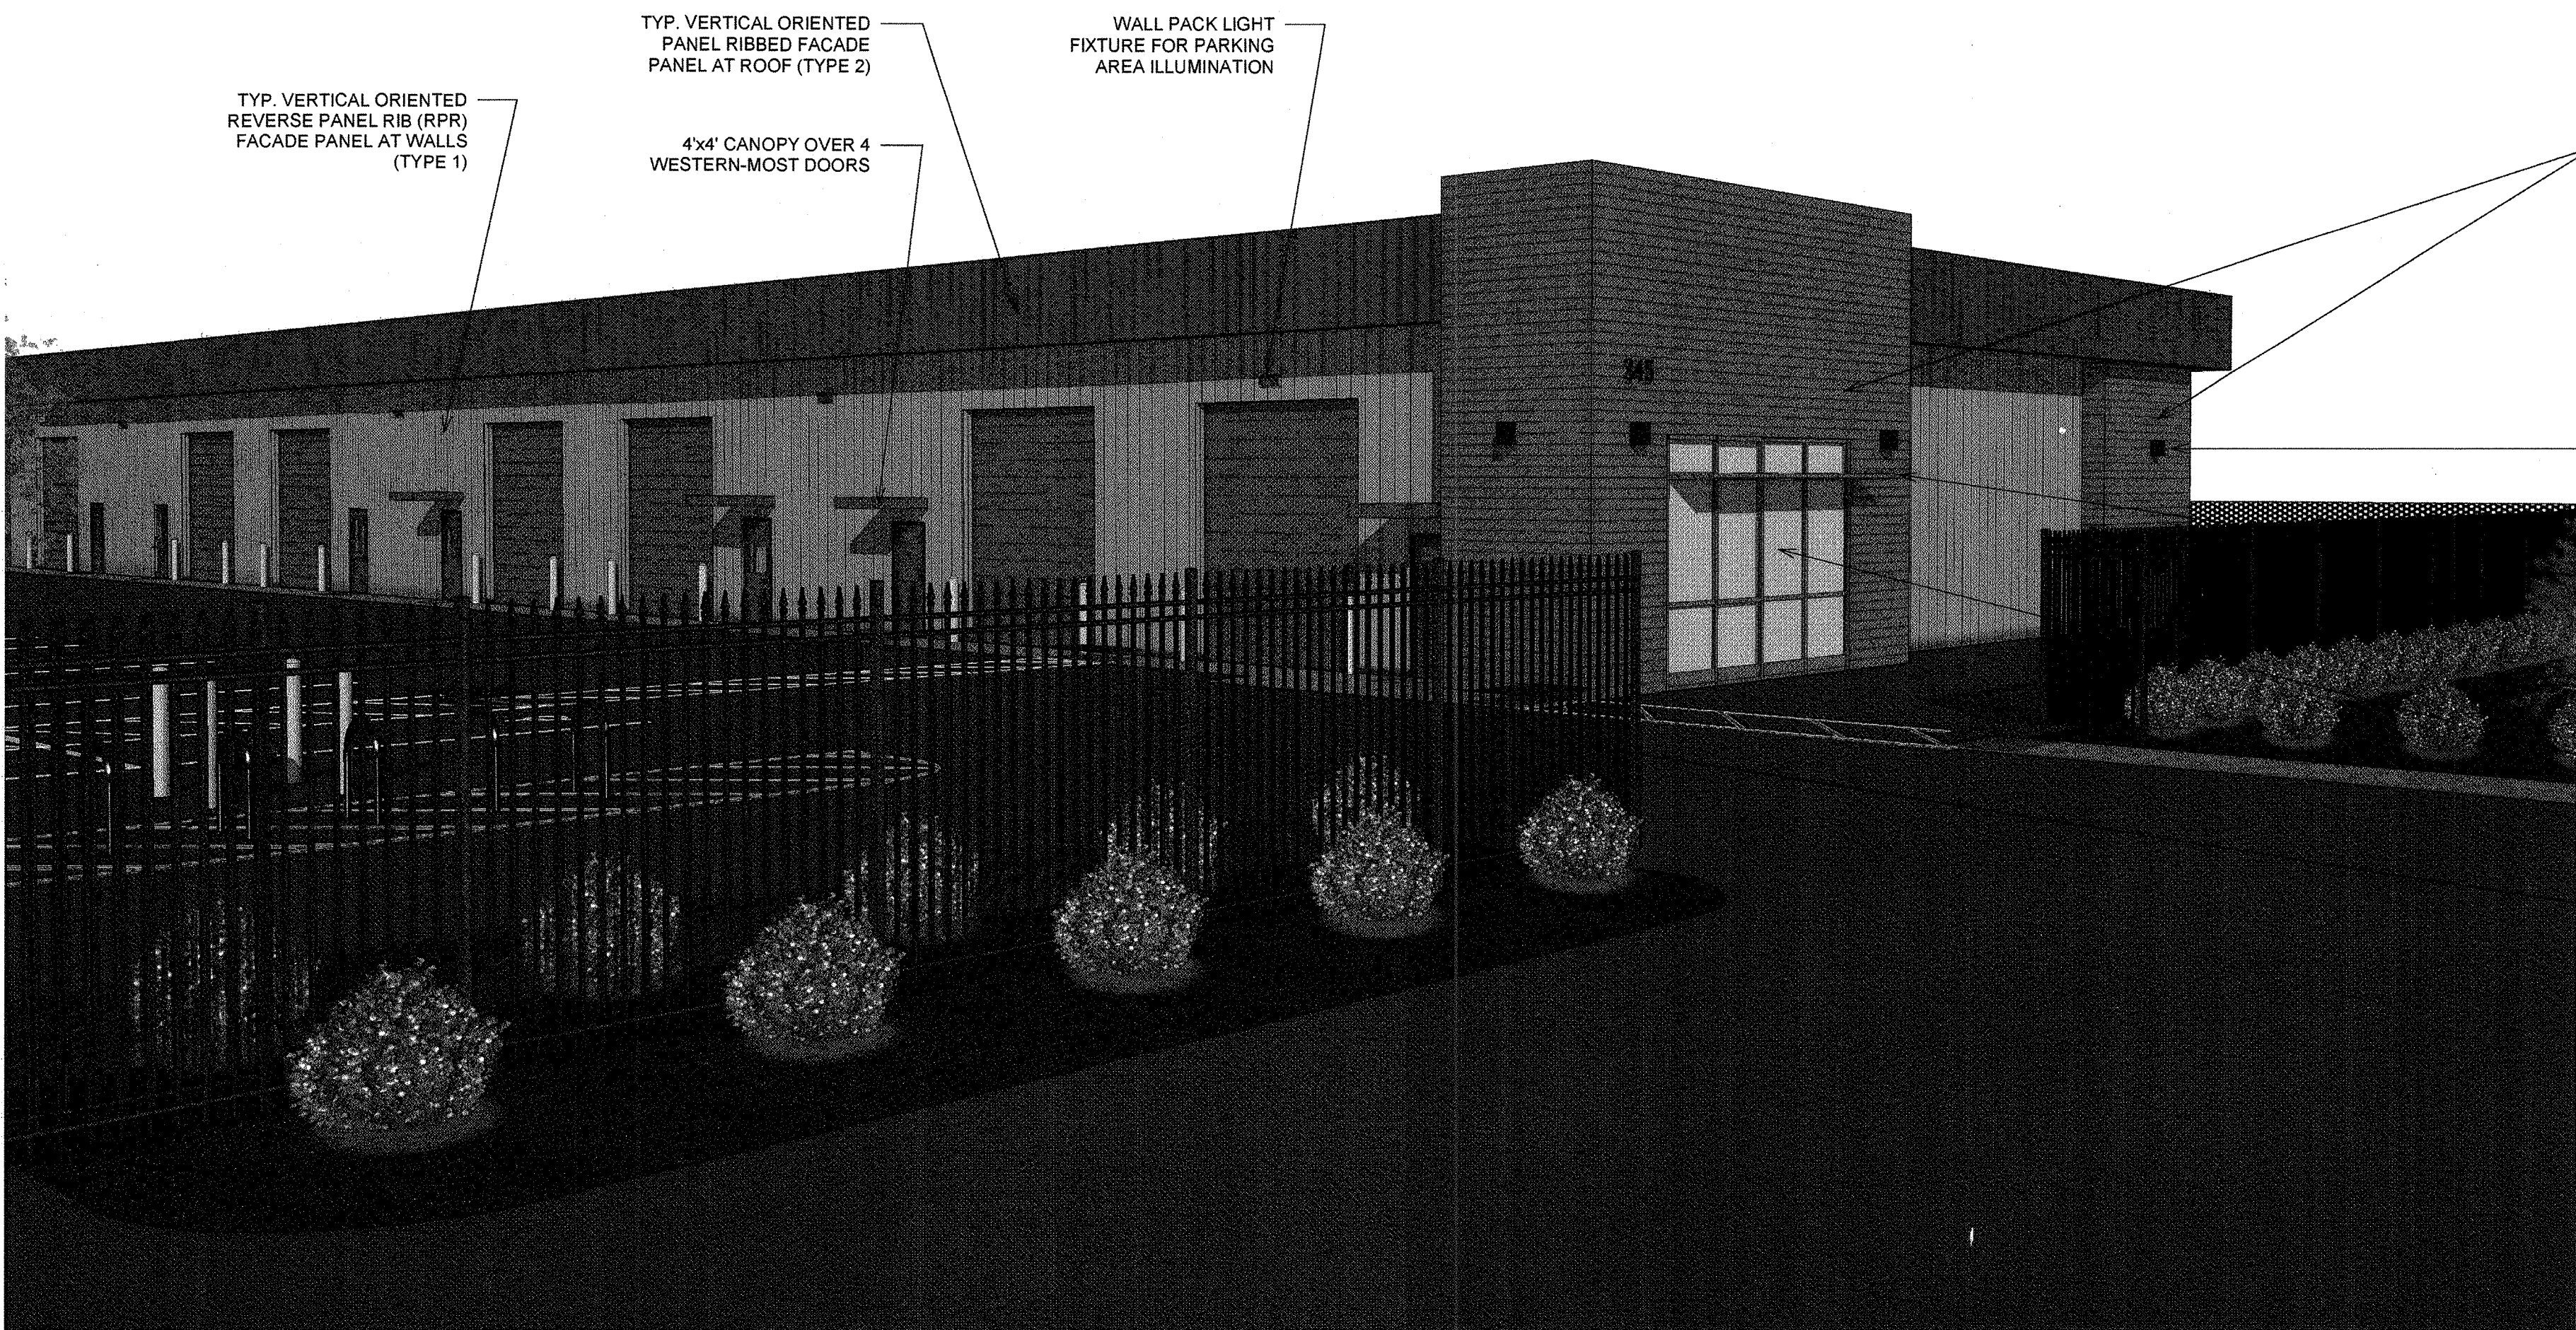


2  
A5.1 CONCEPT VIEW 2

**PANEL TYPES:**

- TYPE 1 - RPR WALL PANEL  
TYPE 2 - VERTICAL RIBBED FACADE PANEL AT ROOF  
TYPE 3 - PBD RIBBED PANEL (ORIENTED HORIZONTAL)

2019CBC  
City of Madera  
Building Department  
The approval of these plans does not prevent the City of Madera from requiring correction of errors or omissions in the plans, specifications, construction, or materials. Subject to field inspections and approvals, the City of Madera reserves the right to require changes and approvals.  
APPROVED  
By: [Signature]  
Date: MAR 03 2022

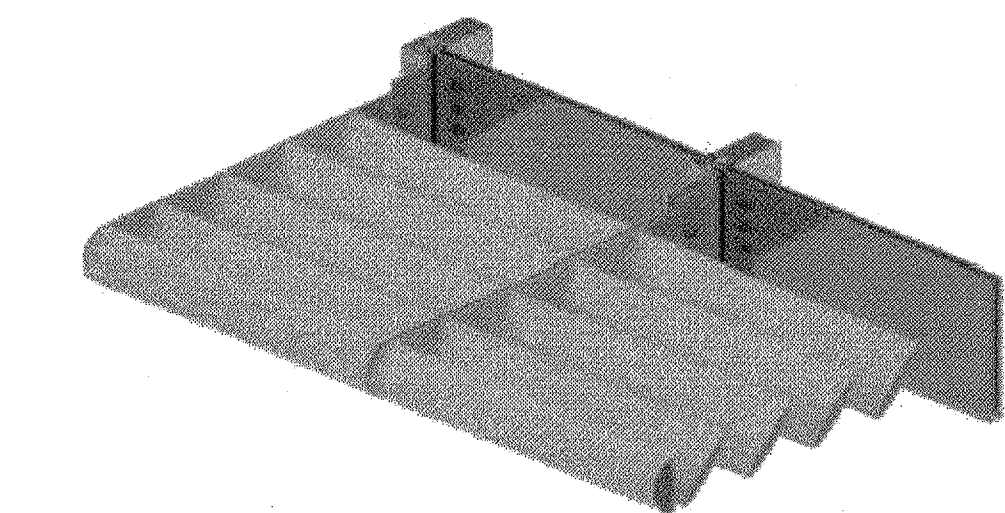

Outrigger :Angled Round  
Louwer :Airfoil  
Fascia :Closed 4" Bullnose

24" SUNSHADE (ANNODIZED ALUMINUM)




WHSE  
[PARTNERS]

BY	REVISION	PLAN CHECK RESPONSE
	2	

DATE 11/17/2021


ANY INFORMATION OR DATA ON THIS DRAWING IS NOT INTENDED TO BE SUITABLE FOR REUSE BY ANY PERSON, FIRM, CORPORATION, OR ANY OTHERS ON EXTENSIONS OF THIS PROJECT OR FOR ANY USE ON ANY OTHER PROJECT. ANY REUSE WITHOUT WRITTEN VERIFICATION AND ADAPTATION BY THE ENGINEER FOR THE SPECIFIC PROJECT INTENDED WILL BE AT THE USER'S SOLE RISK AND WITHOUT LIABILITY OR LEGAL EXPOSURE TO THE ENGINEER.

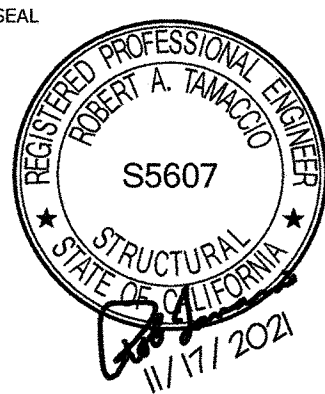

PROJECT ISOMETRIC VIEWS  
LEASE FLEX. / WAREHOUSE BUILDINGS  
FOR  
MADERA INDUSTRIAL WHSE, LLC  
S. SCHNOOR AVENUE, MADERA, CA

JOB NUMBER	21107
DESIGNED BY	RT
DRAWN BY	LM
DATE	9/17/2021
SHEET NUMBER	A5.1



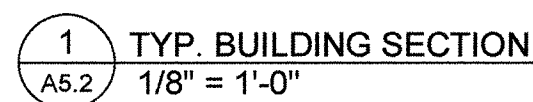

**W H S E**  
[PARTNERS]

JOB NUMBER	21107
DESIGNED BY	RT
DRAWN BY	CD
DATE	11/17/2021

SHEET NUMBER

A5.2

2


2019CRC  
City of Medera  
Building Department  
The approval of these plans does not preclude the City of Medera from requiring correction of errors or omissions in the plans. Specifications of the jurisdiction. Subject to field inspections and approvals of the Codes and Ordinances.

APPROVED


By: [Signature]  
Date: [Signature] MAR 03 2022




1. SEE METAL STUD FRAMING PLAN AND DETAILS FOR FRAMING REQUIREMENTS (SHEET A6.2).
2. UNLESS UL LISTED WALL ASSEMBLY FOR FIRE RESISTANCE CALLED OUT, PROVIDE MIN. #6x1-1/4" BUGLE HEAD SCREWS WITH MAX. 8" O.C. EDGE SPACING AND 12" O.C. MAX. FIELD SPACING AT GYP. BOARD PANELS TO FRAMING.
3. TAPE ALL GYP. BOARD JOINTS AND PROVIDE LEVEL OF FINISH IN ACCORDANCE WITH PROJECT REQUIREMENTS (PROVIDE MIN. LEVEL 4 FINISH OR AS APPROVED BY DBKO DESIGN-BUILD UNLESS NOTED OTHERWISE ON PLANS).
4. FULLY WATERSEAL ALL FACED INSULATION JOINTS IN ACCORDANCE WITH THE MANUFACTURER'S INSTRUCTIONS FOR A WATER- AND AIR-TIGHT SEAL. PROVIDE AIR AND AIR BARRIER USING COMPATIBLE TAPES AND SEALANTS. SEAL/CAULK AROUND ALL PENETRATIONS AS REQ'D. FOR AIR AND WATER-TIGHTNESS.

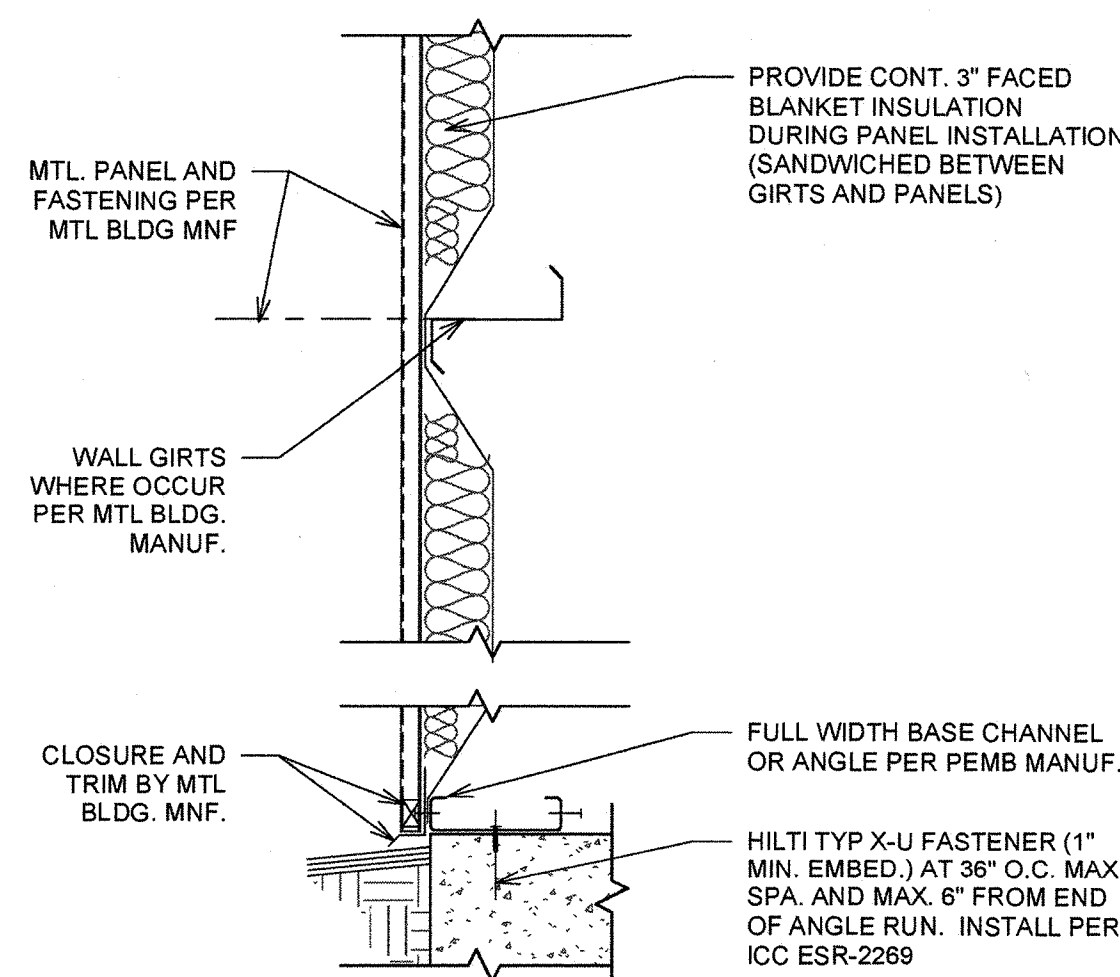


**TYPE 1**  
TYPICAL EXTERIOR  
WAREHOUSE PEMB  
WALL

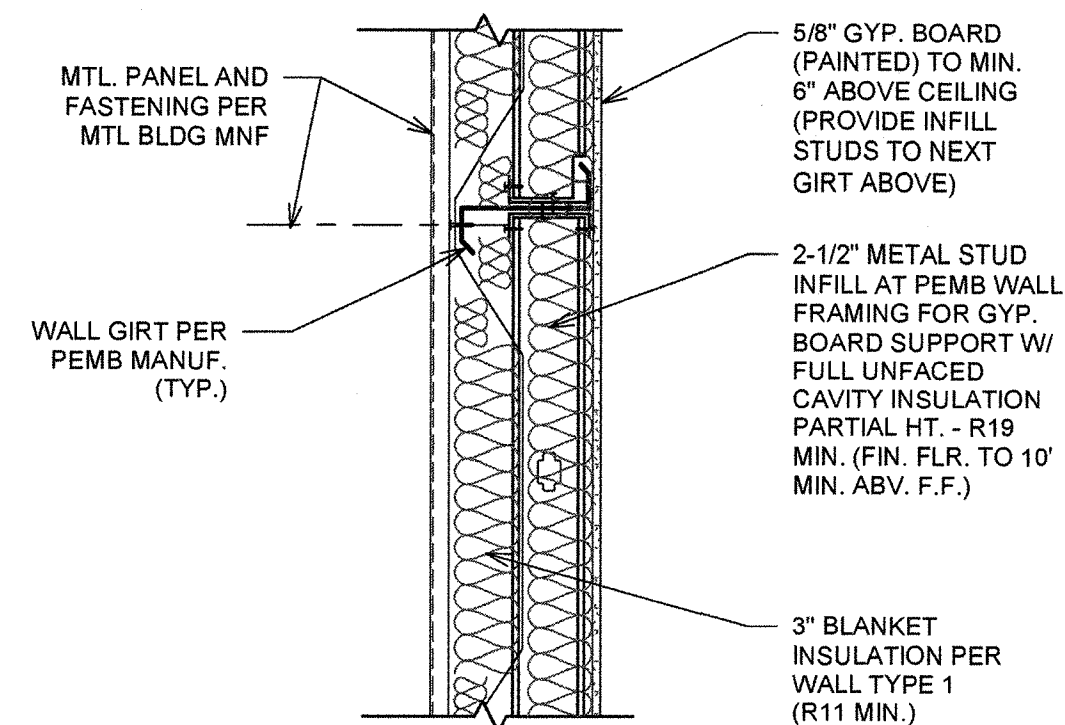


**TYPE 1A**  
TYPICAL EXT. OFFICE  
WALL AT ADMIN. AREA  
(ALONG GRID A)

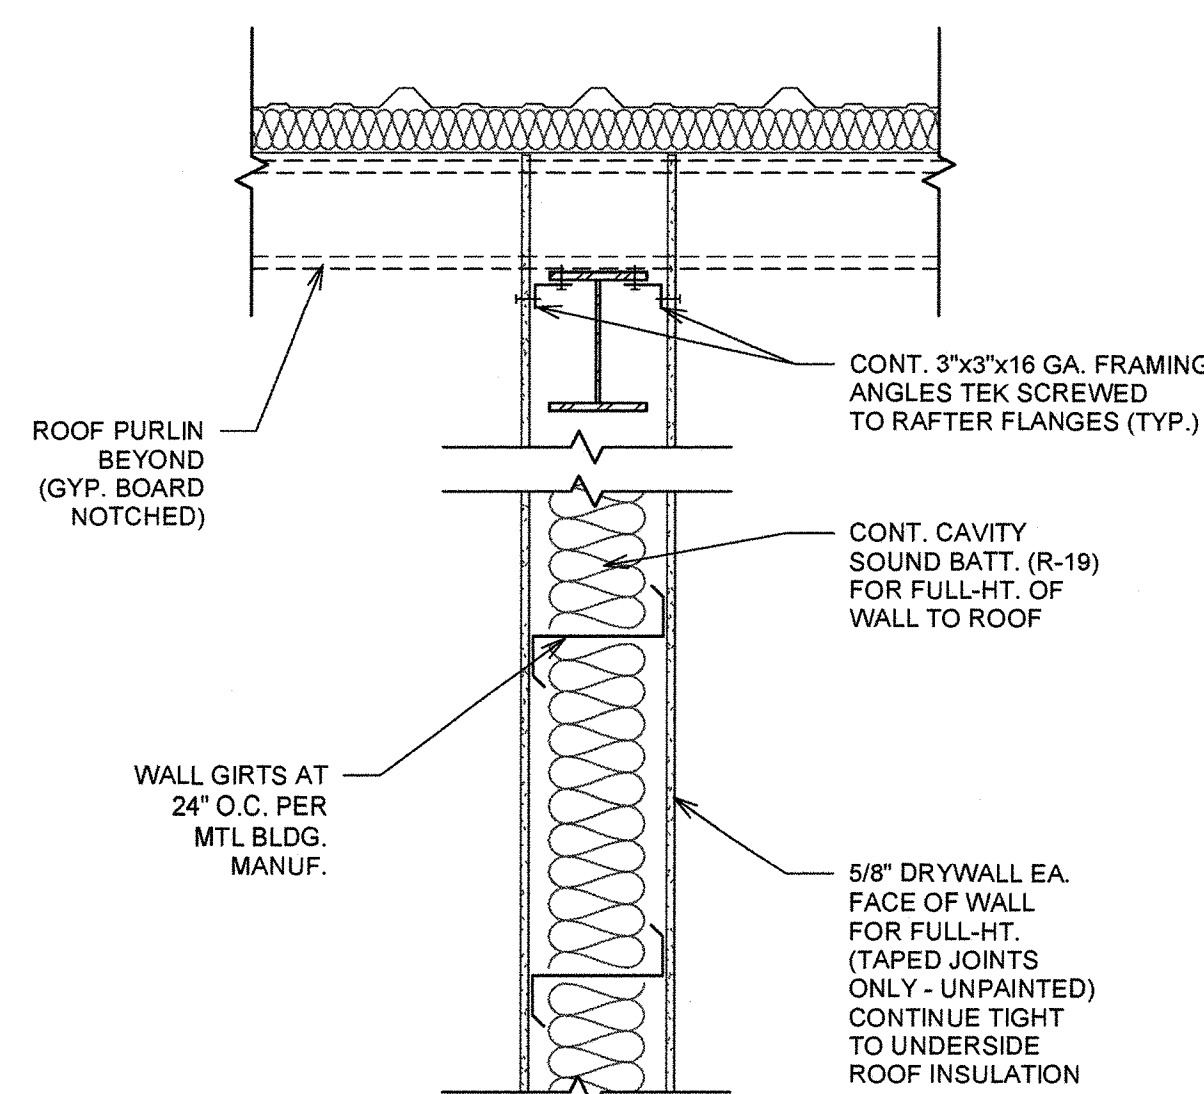


**TYPE 2**  
TYPICAL INTERIOR  
WAREHOUSE PEMB  
PARTITION WALL

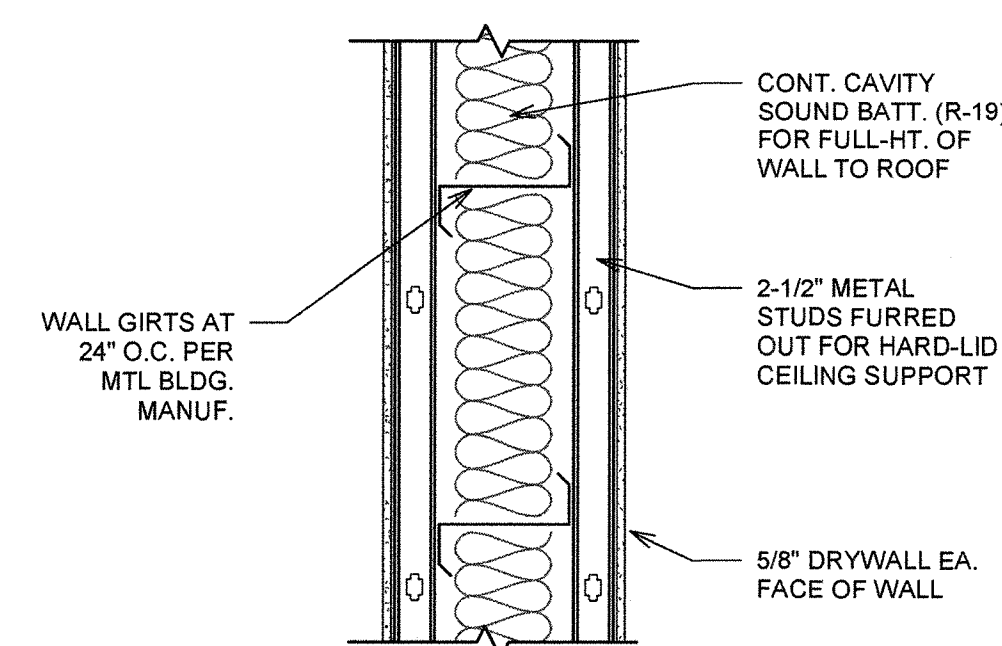


**TYPE 2A**  
TYPICAL INTERIOR  
PEMB PARTITION  
WALL AT OFFICE

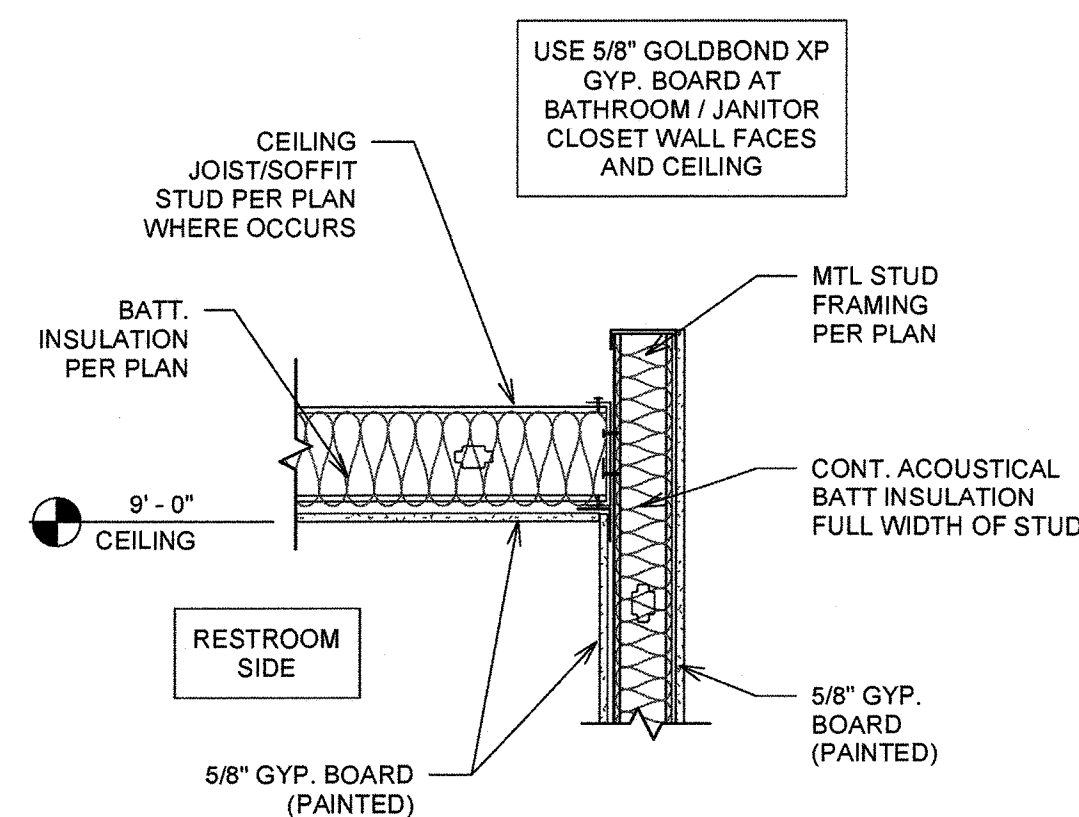

**TYPE 3**  
**WALLS AT RESTROOMS**

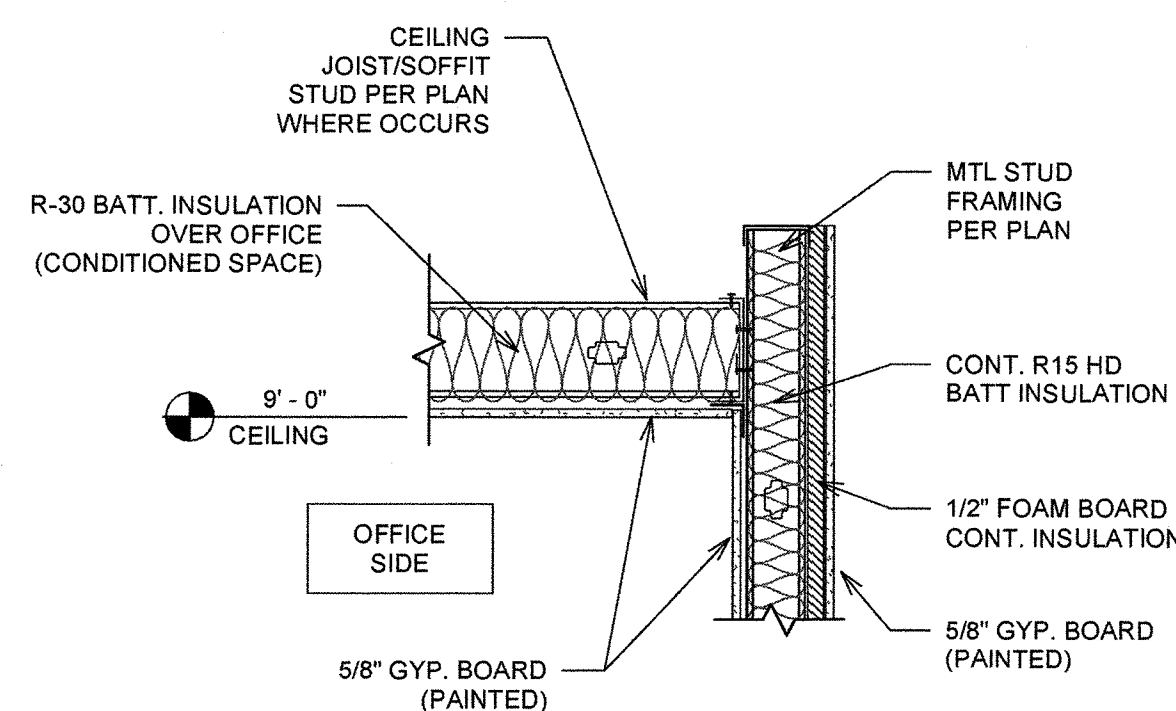

**TYPE 3A**  
WALLS AT OFFICE

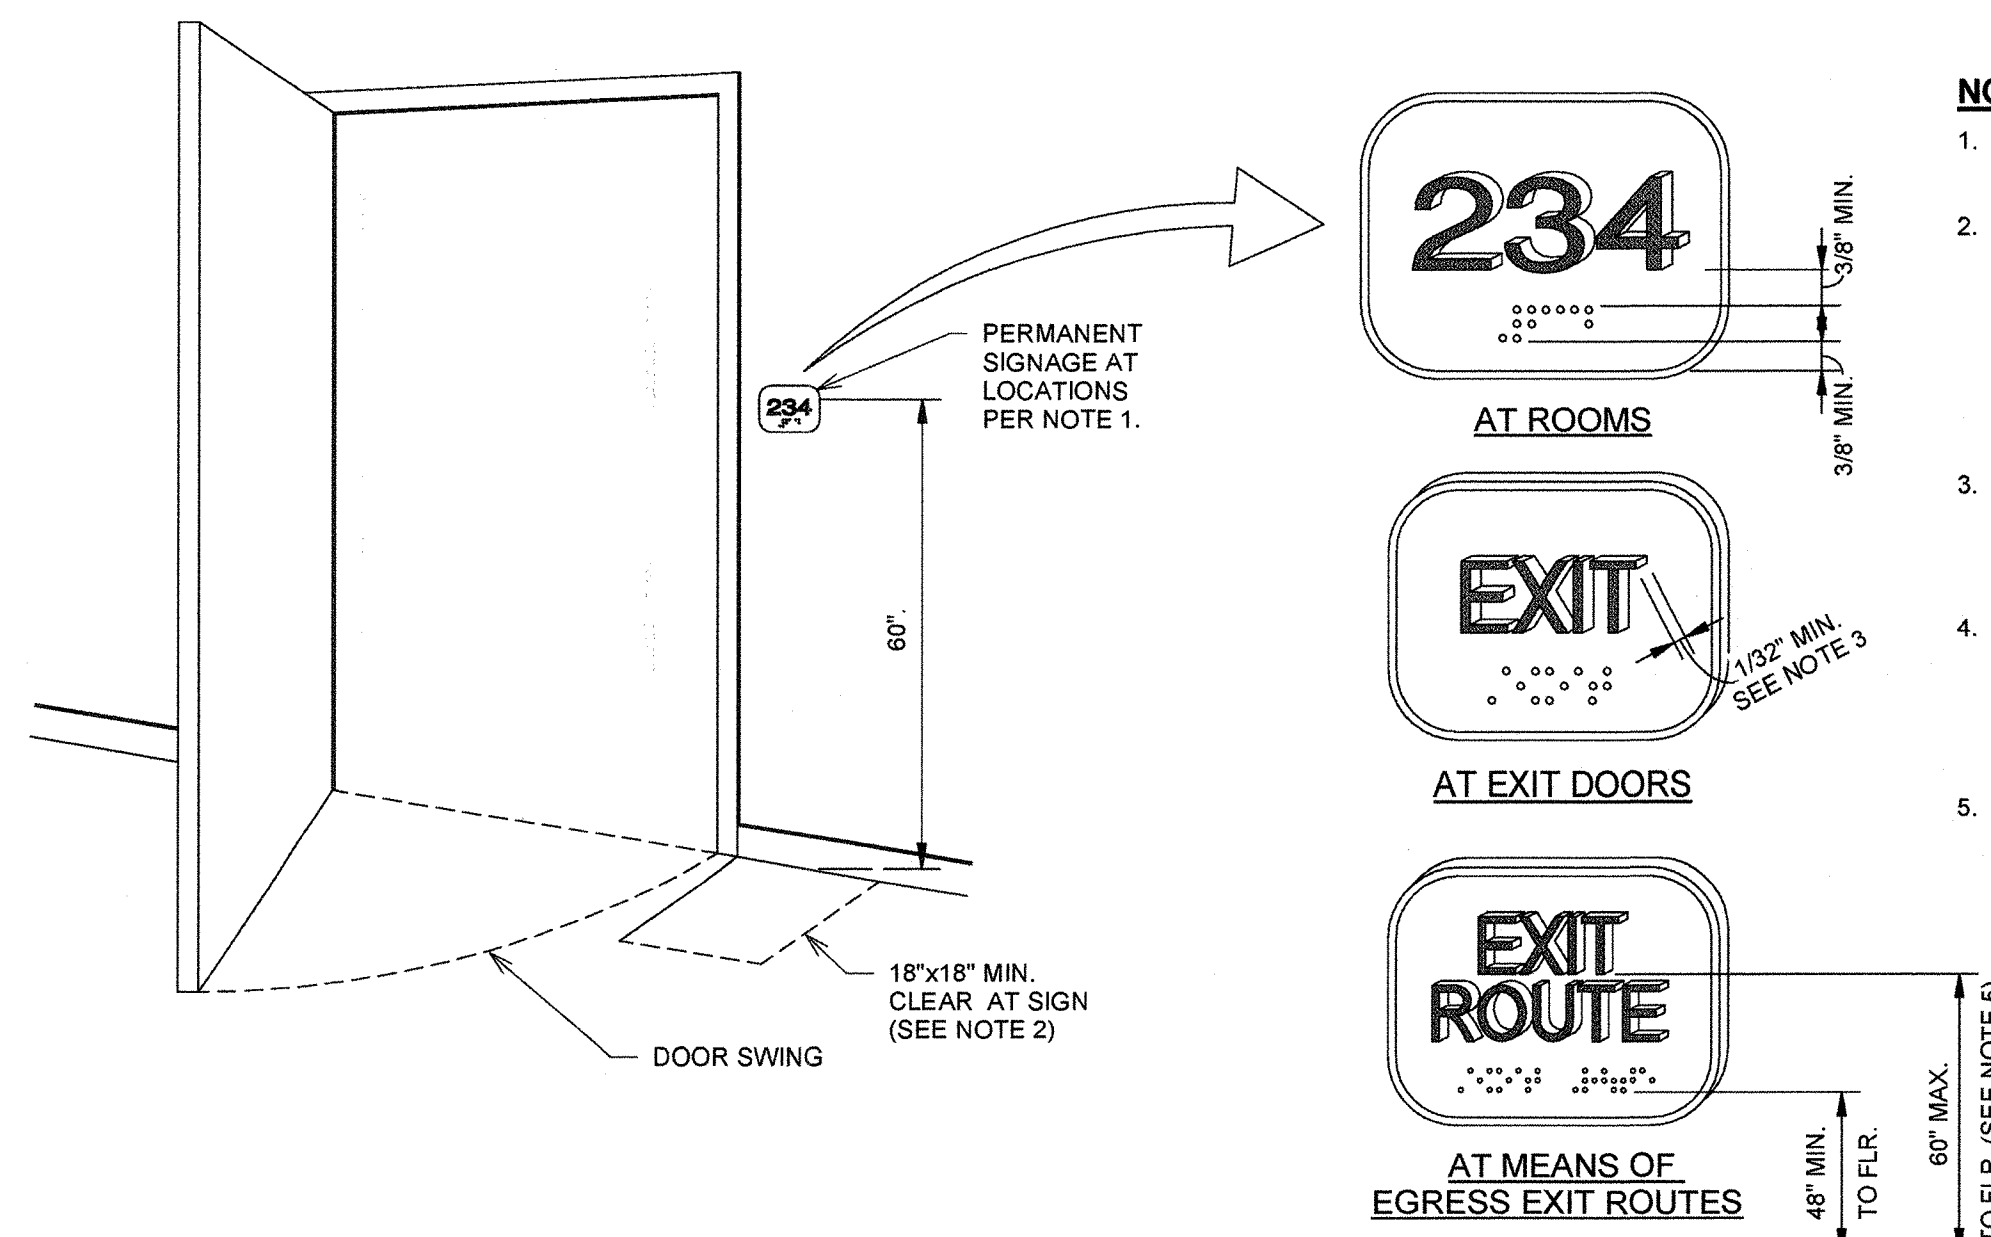

2 INTERIOR DOOR SIGN DETAIL  
A6.0 1/2" = 1'-0"


DOOR SCHEDULE										
MARK	QUANTITY	DOOR CONSTRUCTION	FRAME TYPE	FRAME FINISH	HEIGHT	WIDTH	THICKNESS	TYPE	HARDWARE SET	COMMENTS
1A	74	H.M.	STL/AL	PT	7' - 0"	6' - 0"	1 3/4"	B	GROUP 4	YARD ACCESS DOOR
1B	74		PRE	PRE	14' - 0"	12' - 0"		C		OVERHEAD DOOR
1C	74	H.M.	STL/AL	PT	7' - 0"	3' - 0"	1 3/4"	A1	GROUP 1	OFFICE EXT. DOOR (SEE NOTE 10)
1D	74	H.M.	STL/AL	PT	7' - 0"	3' - 0"	1 3/4"	A	GROUP 2	OFFICE INT. DOOR (SEE NOTE 10)
1E	74	H.M.	STL/AL	PT	7' - 0"	3' - 0"	1 3/4"		GROUP 3	RESTROOM DOOR

1. CONFIRM SIZE AND MATERIALS WITH DBKO. NOTE:

H.M. = HOLLOW METAL  
PT = PAINT (APPR. BY DBKO)  
H.C. = HOLLOW CORE.  
ST = STEEL / ALUMN (APPR. BY DBKO)  
S.C. = SOLID CORE  
WOOD = PLAIN SLICED CHERRY WOOD  
PRE = PREFINISHED

2. DOORS SHALL BE READILY DISTINGUISHABLE FROM ADJACENT CONSTRUCTION AND FINISHES. MIRRORS OR SIMILAR REFLECTIVE MATERIALS ARE NOT TO BE USED ON DOORS (CBC 1008.1).
3. DOOR OPENING PUSH/PULL FORCE NOT TO EXCEED 5 LBS (CBC 1008.1.3 AND CBC11B-404.2.9).
4. VERIFY THAT FLOOR ELEVATION ON EITHER SIDE OF DOOR IS LEVEL AND THE SAME ELEVATION (CBC 1008.1.5) AND THAT THRESHOLD MEETS CBC 1008.1.7 WHERE PROVIDED.

- A. EGRESS DOORS ARE TO BE READILY OPENABLE FROM EGRESS SIDE WITHOUT USE OF A KEY OR SPECIAL KNOWLEDGE/EFFORT.
- B. HARDWARE (DOOR HANDLES, PULLS, LATCHES, LOCKS, ETC.) SHOULD BE LEVER, PANIC HARDWARE, PUSH-PULL, ETC. AS REQUIRED SO AS NOT TO REQUIRE TIGHT GRASPING, TIGHT PINCHING, OR TWISTING OF THE WRIST.
- C. HARDWARE HEIGHT IS TO BE BETWEEN 34 AND 44 INCHES.

6. WHERE GLAZING PROVIDED IN DOORS, USE SAFETY GLAZING COMPLYING W/ IBC 2406.
7. PROVIDE BLOCKING IN WALL BEHIND WALL-MOUNTED DOOR STOPS PER  

8. CLOSERS ON DOORS ARE TO COMPLY W/ CBC 11B-404.2.8.
9. THE BOT. 10" OF THE PUSH SIDE OF ALL MAN DOORS TO HAVE A SMOOTH/FLAT SURFACE.
10. ALL EXTERIOR DOORS AT CONDITIONED SPACES TO BE INSULATED (MIN. R-5).

**HARDWARE SETS**  
NOTE - VERIFY HARDWARE FINISH WITH DBKO CONSTRUCTION

EACH SHALL HAVE:


EACH SHALL HAVE:  
3 HINGES  
1 ENTRANCE/OFFICE LOCK W/ ACCESS. LEVER EA. SIDE  
1 CLOSER  
1 THRESHOLD  
1 DOOR BOTTOM  
1 WEATHERSTRIP SET PER LEAF (OMIT AT INT. DOORS)  
1 KICKPLATE (PUSH SIDE - TYP. ALL DOOR TYPES)  
1 RAIN DRIP CAP

EACH SHALL HAVE:

EACH SHALL HAVE:  
3 HINGES  
1 ACCESS LEVER EA. SIDE (NON-LOCKING)  
1 WALL STOP  
1 KICKPLATE (PUSH SIDE)  
3 SILENCERS

EACH SHALL HAVE:  
3 HINGES  
1 PRIVACY LOCK  
1 CLOSER  
1 WALL STOP  
3 SILENCERS  
1 KICKPLATE

EACH SHALL HAVE:  
6 HINGES  
1 ENTRANCE LOCK  
2 FLUSH BOLTS  
1 DUSTPROOF STR  
2 WALL STOPS  
2 WEATHERSTRIP S  
2 RAIN DRIP CAP  
2 KICKPLATES

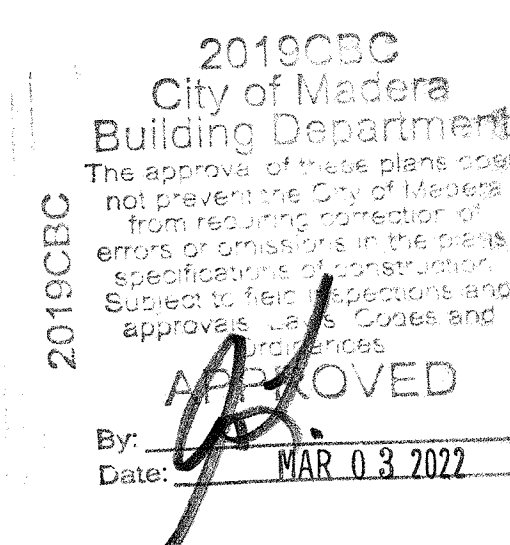

1. TACTILE SIGNAGE REQUIRED AT ALL EXIT DOORS AND ROOMS/SPACES WITH PERMANENT SIGNAGE
2. PERMANENT SIGNAGE TO BE INSTALLED ON THE WALL ADJACENT TO THE LATCH SIDE OF THE DOOR (INACTIVE LEAF SIDE AT DOUBLE DOOR) WITH ONE INACTIVE LEAF OR AT THE RIGHT SIDE OF A DOUBLE DOOR WITH BOTH LEAFS ACTIVE). MOUNTING LOCATION MUST PERMIT A PERSON TO APPROACH WITHOUT ENCOUNTERING PROTRUDING OBJECTS OR HAVING TO STAND IN THE SWING PATH OF THE DOOR. PROJ.3.1 MIN. 18"X18" CLEAR FLOOR SPACE CENTERED ON SIGN (CBC 11B-703.4.2).
3. LETTERS AND NUMBERS ARE TO BE RAISED 1/32" UPPER CASE, SANS SERIF TYPE AND ARE TO BE MIN. 5/8" HIGH BUT NO GREATER THAN 1" HIGH. SEE TAS SECTION 703.2 FOR ADDITIONAL REQUIREMENTS.
4. PROVIDE MATCHING GRADE II BRAILLE. LITERARY BRAILLE STANDARD DIMENSIONS ARE TO COMPLY WITH TEXAS ACCESSIBILITY STANDARD FIGURE 703.1.1 AND BE SEPARATED MINIMUM 3/8" FROM ADJACENT TACTILE CHARACTERS AND DECORATIVE BORDERS/TRIM.
5. MOUNTING HEIGHT REQUIREMENTS FOR ALL SIGNS PER "EXIT ROUTE" SIGNAGE BELOW (48" TO ABOVE FIN. FL. TO BASELINE OF LOWEST BRAILLE CELLS AND 60" MAX ABOVE FIN. FL. TO BASELINE OF HIGHEST ROW OF RAISED CHARACTERS).

**W H S E**  
[PARTNERS]

DATE	REVISION	BY
11/17/2021	2	PIAN CHECK RESPONSE

SEA



**DETAILS**

**LEASE FLEX. / WAREHOUSE BUILDINGS**

**FOR**

**MADERA INDUSTRIAL WHSE., LLC**

**S. SCHNOOR AVENUE, MADERA, CA**

JOB NUMBER 21107

DESIGNED BY RT


DRAWN BY LM

DATE 9/17/2021

SHEET NUMBER


A6.0



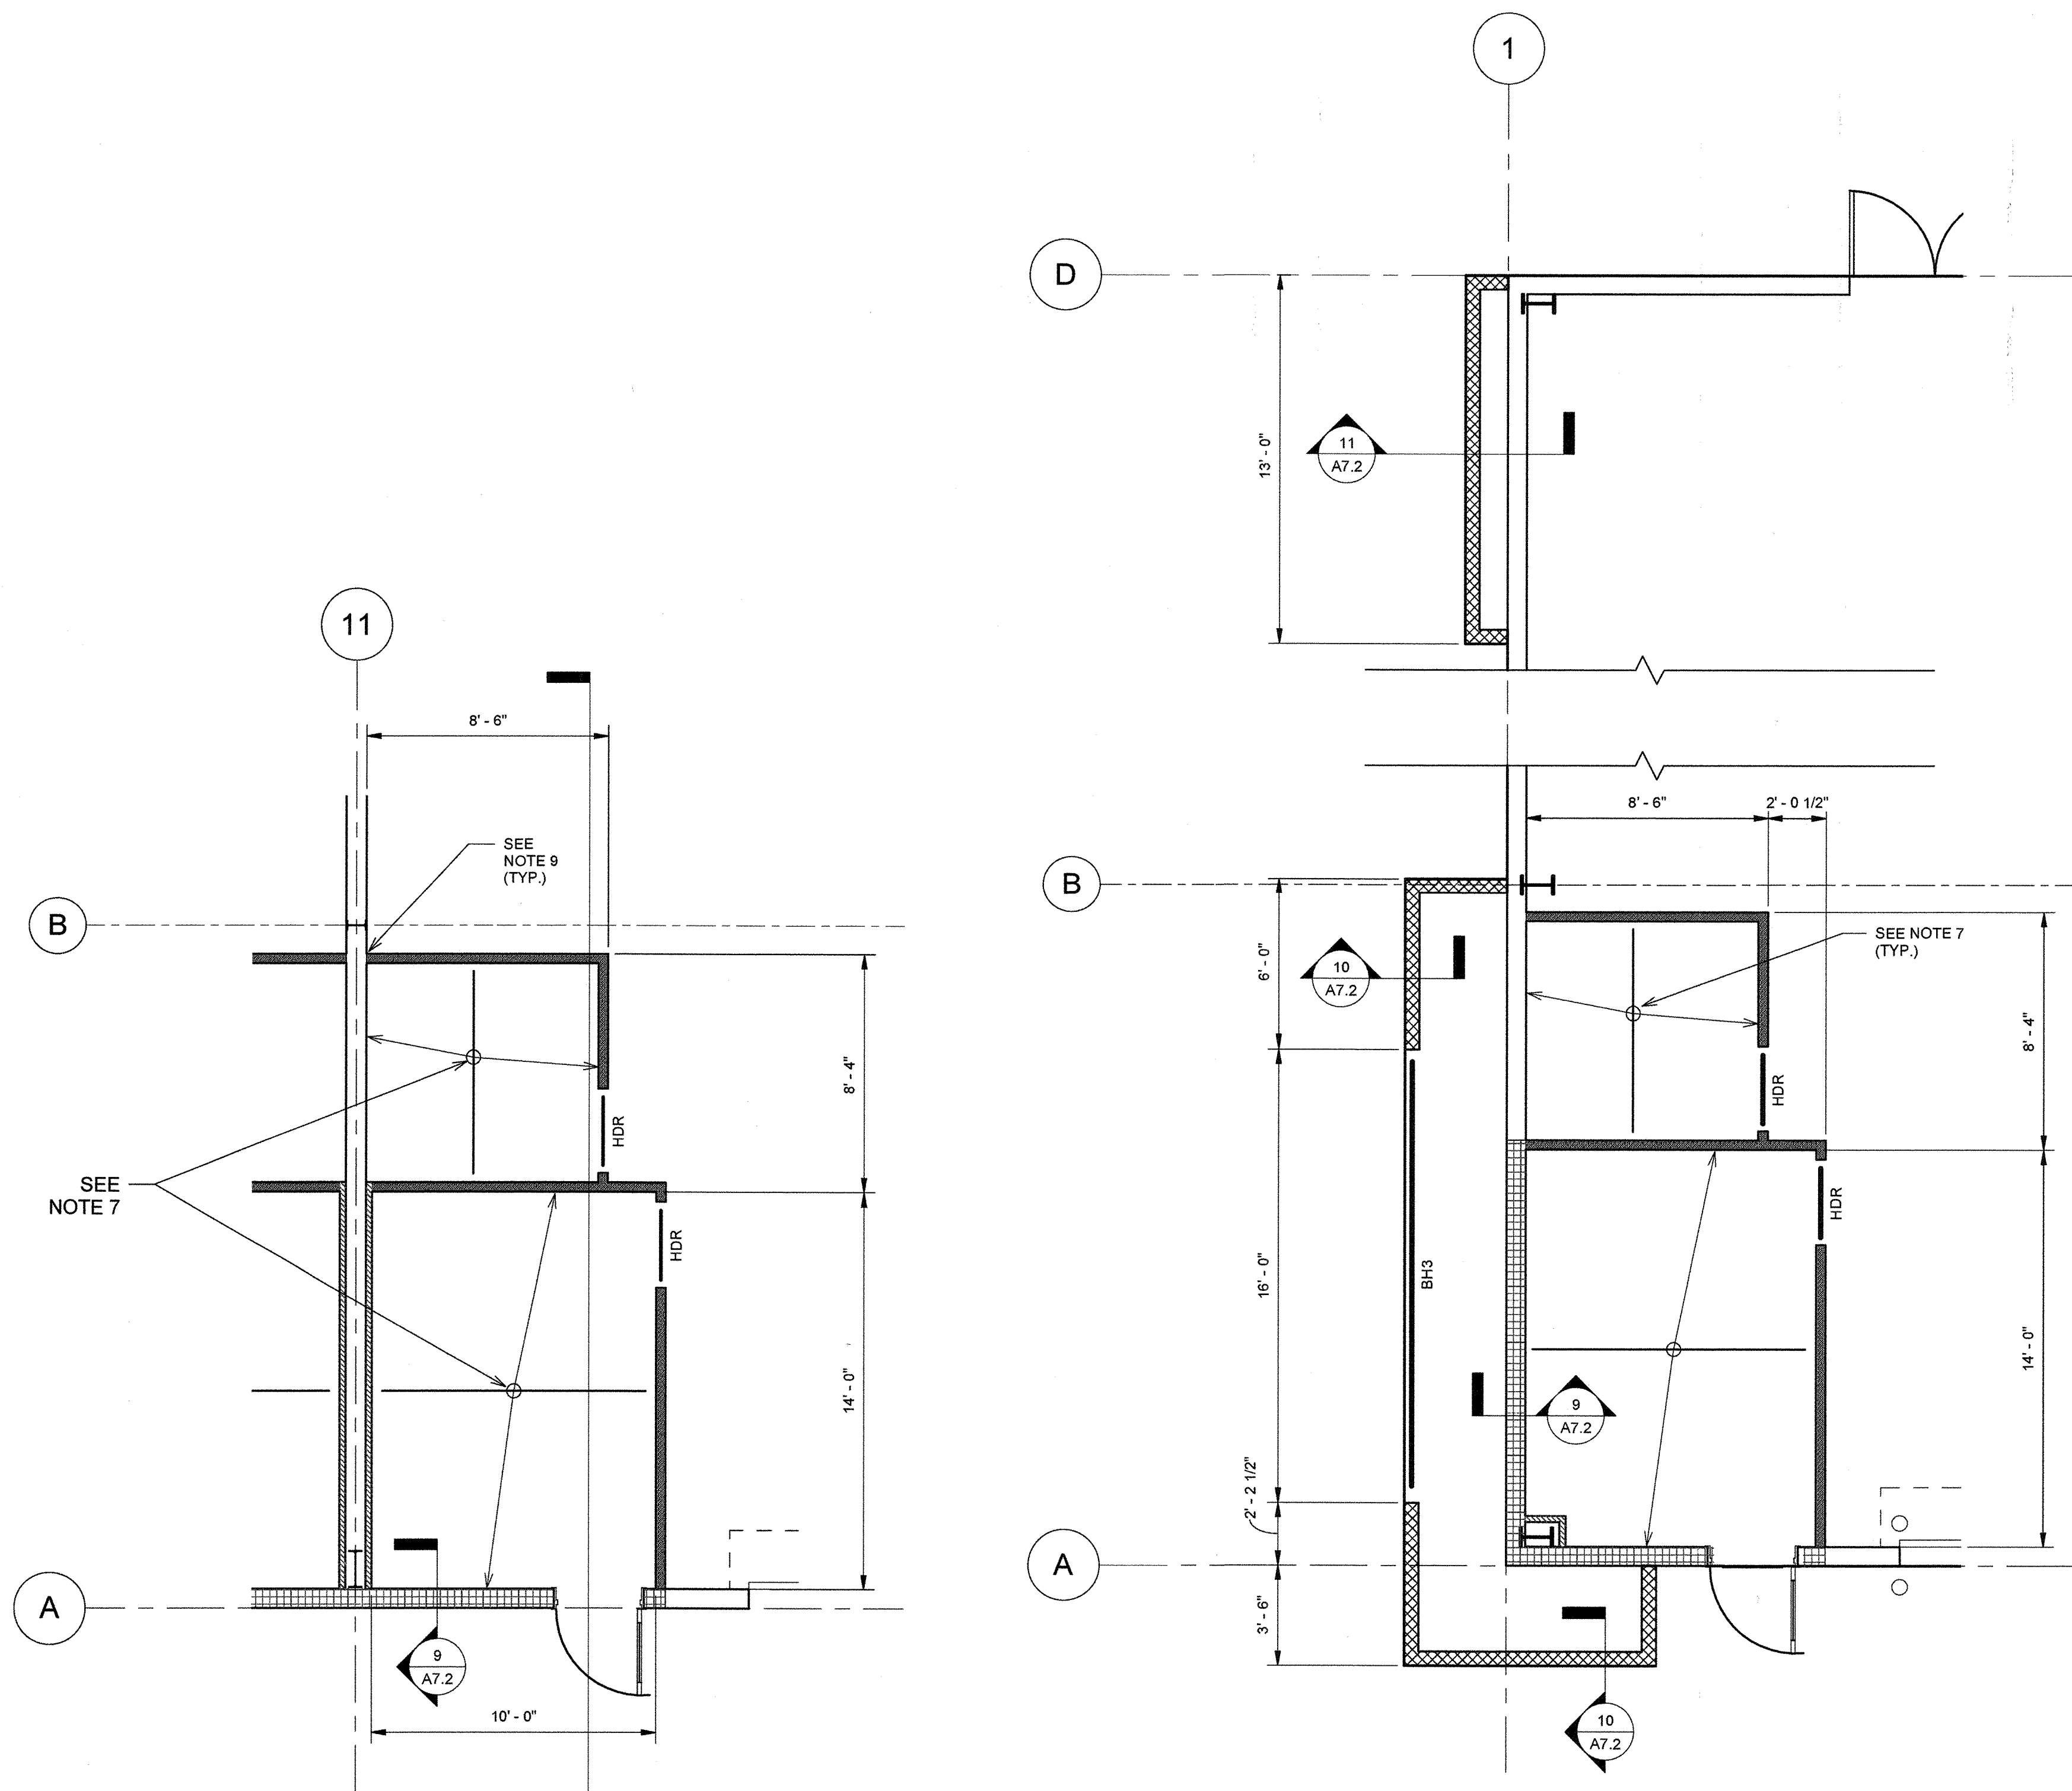

**1** TYP. METAL STUD FRAMING PLAN AT OFFICE/RESTROOM AREAS (ALL BUILDINGS)  
A7.0 1/4" = 1'-0"

**2** METAL STUD FRAMING AT WEST END OF BLDG. A (OPP. HAND BLDG. B)  
A7.0 1/4" = 1'-0"

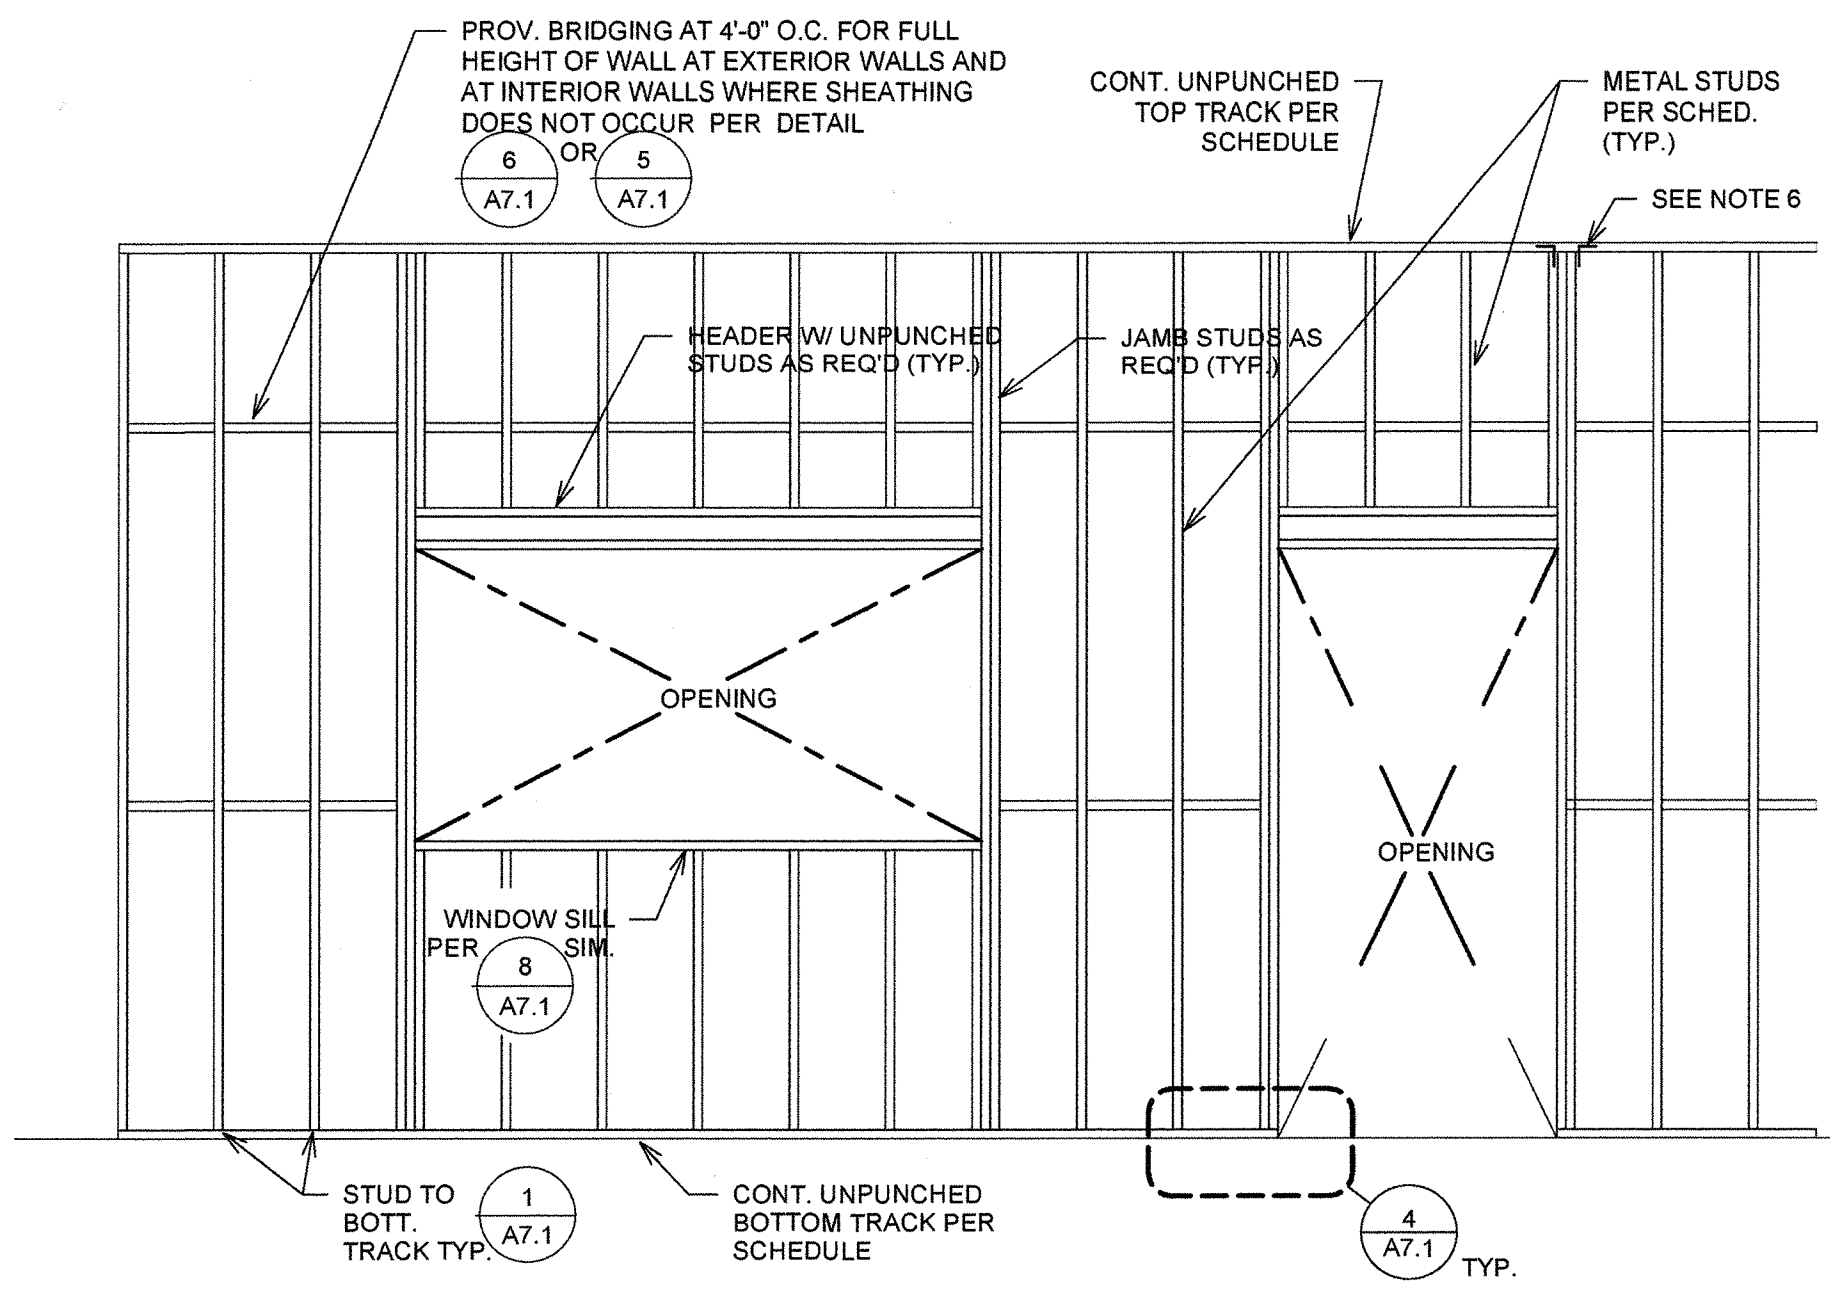

METAL STUD WALL SCHEDULE						
TYPE	DESCRIPTION	STUD SIZE	SPACING	TOP TRACK	BOT. TRACK	OPENING HEADER
A	6" EXT. WALLS	600S162-43	16"	600T125-43	600T125-43	SEE NOTE 6
B	EXT. WALLS (INFILL@PEMB)	250S125-33	24"	250T125-33	250T125-33	N/A - OPENINGS PER PEMB MNF.
C	3-5/8" INTERIOR WALLS	362S125-33	24"	362T125-33	362T125-33	SEE NOTE 6
D	2-1/2" FURRING WALLS	250S125-33	24"	250T125-33	250T125-33	SEE NOTE 6


- NOTES:**
- ALL METALS IDENTIFIED SHALL BE PROVIDED BY "SSMA APPROVED SUPPLIER" PER ICC REPORT ESR-3064P. REFER TO THE REPORT FOR ALL REQUIREMENTS AND INFORMATION NOT LISTED OR SHOWN HERE. SEE NOTES THIS SHEET FOR MATERIAL STRENGTH REQUIREMENTS AND OTHER TYPICAL METAL STUD NOTES.
  - WEAK AXIS TORSIONAL BRIDGING (WEB BRACING IS REQUIRED AT 4'-0" PER 5 A7.1 OR 6 A7.1 AT ALL EXTERIOR WALLS AND INTERIOR WALLS THAT ARE SHEATHED W/ GYP. ON ONE SIDE ONLY (INSULATION BOARD DOES NOT QUALIFY AS SHEATHING).
  - CONTINUOUS SUPPORT REQUIRED FOR EACH FLANGE (BOTH SIDES) USING MIN. 1/2" THICK GYPSUM WALL BOARD WITH MIN. #6 SCREW ATTACHED AT 12" O.C. MAX. SPACING DIRECTLY TO STUD FLANGE (SEE NOTE 2).
  - TOP AND BOTTOM TRACKS ARE TO BE UNPUNCHED. TOP TRACK SPLICES PER DETAIL 10 A7.1 BOTTOM TRACK FASTENED PER DETAIL 4 A7.1
  - TOPS OF ALL NON-BEARING WALLS TO BE BRACED TO STRUCTURE PER APPLICABLE DETAILS.
  - FOR HEADERS AT INTERIOR WALLS W/ HORIZONTAL OPENING LESS THAN OR EQUAL TO 4'-0", SEE 8 A7.1 FOR ALL OTHER OPENINGS, PROVIDE HEADER PER 7 A7.1

**3** METAL STUD WALL SCHEDULE  
A7.0 1" = 1'-0"

**METAL STUD FRAMING PLAN NOTES:**


- COLD-FORMED SECTIONS ARE TO MEET THE STANDARD SECTION CRITERIA AS SET BY THE STEEL STUD MANUFACTURERS ASSOCIATION (SSMA) AND ESR-3064P.
  - MATERIAL: ASTM A1003-13 STRUCTURAL GRADE 50 OR 33 OR ASTM A653 SS W/ MIN. G40 COATING PER THE TABLE BELOW
- | GAUGE | MILS | DESIGN THICKNESS | YIELD STRESS | ULTIMATE STRESS |
|-------|------|------------------|--------------|-----------------|
| 12    | 97   | 0.1017           | 50 KSI       | 65 KSI          |
| 14    | 68   | 0.0713           | 50 KSI       | 65 KSI          |
| 16    | 54   | 0.0566           | 50 KSI       | 65 KSI          |
| 18    | 43   | 0.0451           | 33 KSI       | 45 KSI          |
| 20    | 33   | 0.0346           | 33 KSI       | 45 KSI          |
| 25    | 18   | 0.0188           | 33 KSI       | 45 KSI          |
- SSMA SECTION DESIGNATION: MEMBER DEPTH; STYLE; FLANGE WIDTH; THICKNESS (I.E. 600S162-43) MEMBER DEPTH - DEPTH OF SECTION IN 1/100TH INCHES; 600=6" STYLE - S=STUD, T=TRACK, U=CHANNEL, F=FURRING CHANNEL FLANGE WIDTH - FLANGE WIDTH IN 1/100TH INCHES; 162= 1 5/8" THICKNESS - MIN BASE METAL THICKNESS IN 1/100TH OF AN INCH; 54=.054"=16 GA. (THICKNESS REPRESENTS 95% OF DESIGN THICKNESS)
- WELDING**  
WELD PER AWS D-1.3, AISI SECTION E2. DO NOT WELD SECTIONS THINNER THAN 16 GA (54 MILS)

- SLOTTED CLIPS, ANGLES AND TRACKS**  
INSTALL FASTENERS IN THE CENTER OF THE SLOT AND BACKED OFF 1/4 TURN TO PREVENT HIGH CLAMPING FORCES AND ALLOW SLIPPAGE (SEE FIGURE BELOW) OR USE STAND-OFF WASHER PER MANUFACTURER'S INSTRUCTIONS.

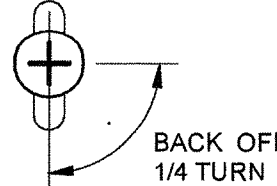


- FASTENERS AND CONNECTIONS**  
MINIMUM SPACING BETWEEN CENTER OF SCREWS IN COLD-FORMED SECTIONS IS TO BE THREE TIMES THE SCREW DIAMETER. MINIMUM EDGE DISTANCE IS TO BE ONE-AND-A-HALF TIMES THE SCREW DIAMETER.

- FOR WALL STUD SIZES AND FRAMING REQUIREMENTS, SEE METAL STUD WALL SCHEDULE PER 3 A7.0
- PROVIDE JOIST FRAMING AT GYP. BOARD CEILINGS PER 1 A7.2
- PROVIDE TRACK BACKING AT WALL MOUNTED EQUIPMENT/FIXTURES/CASEWORK COMPONENTS PER 3 A7.2 COORDINATE LOCATIONS WITH OTHER TRADES BEFORE SHEATHING WALLS.
- WHERE METAL STUD WALLS TERMINATE AT PEMB WALLS, PROVIDE (2) #8 SCREWS THRU END STUD WEB TO EA. INTERIOR GIRT FLANGE.

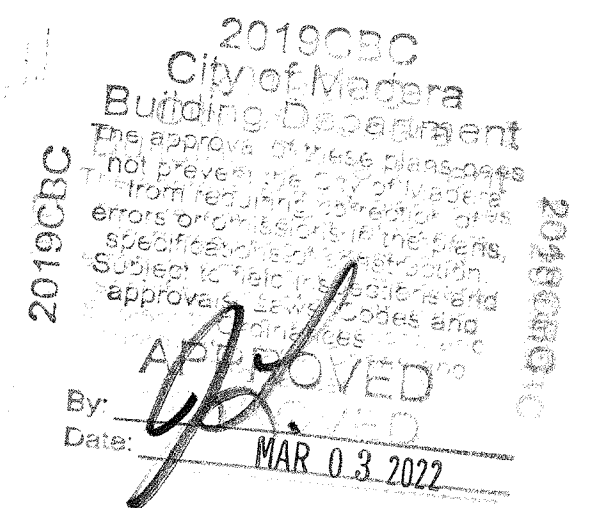




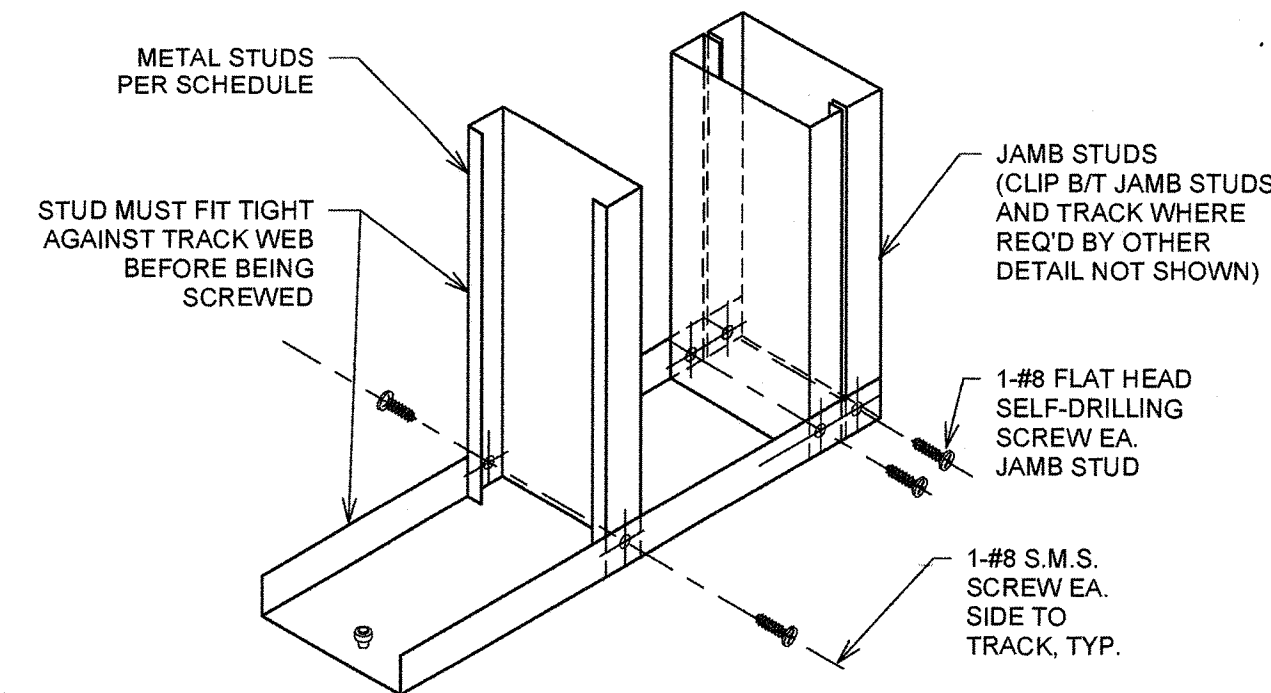


1  
A7.1  
TYPICAL STUD AND TRACK CONNECTION  
1" = 1'-0"


J1 - TYP DBL STUD JAMB

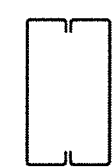


2  
A7.1  
TYPICAL JAMB STUDS  
1" = 1'-0"

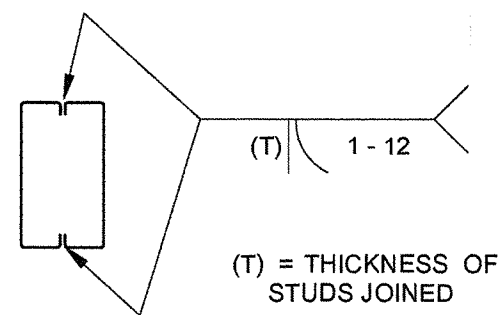

J2 - WELDED JAMB

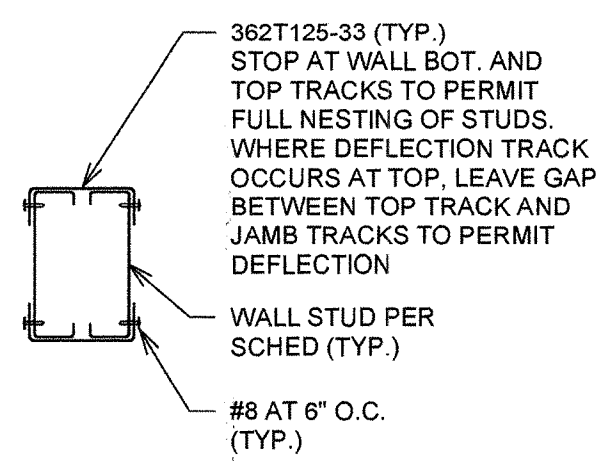


J3 - BOXED JAMB

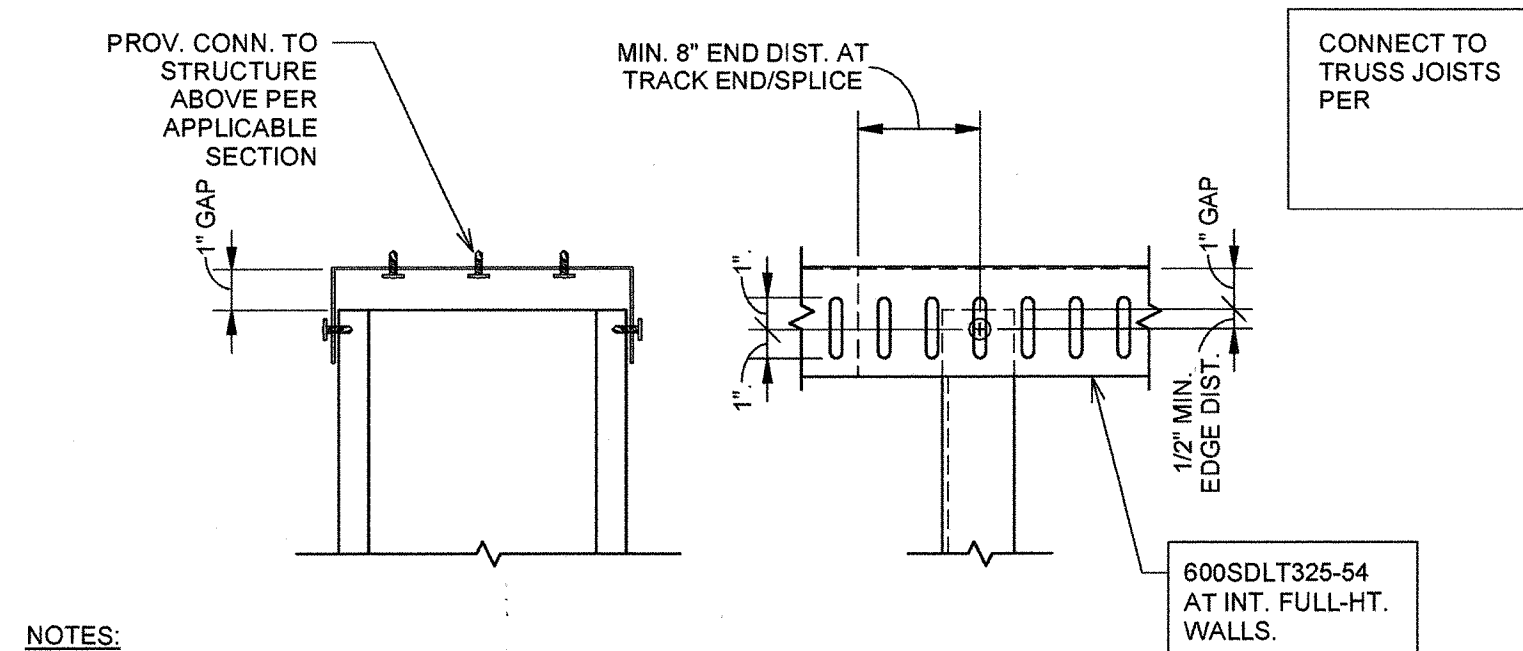


- NOTES:
1. LOCATE SCREW AT MID-HEIGHT OF VERT. SLOT. BACK OFF 1/4" TURN FROM TIGHT FOR SLIP. STAND OFF BUSHING OPTIONAL PER GENERAL METAL STUD NOTES. ONE SCREW PER SLOT.
  2. TRACK SIZE AND GAUGE AS NOTED - SLOTTED DEEP LEG TRACKS PER SCAFFO (WWW.SCAFFO.COM) - IAPMO ER-0283.
  3. FASTENER SPACING PER WALL TYPE.

3  
A7.1  
TYP. DEFLECTION TRACK AT TOP OF FULL-HT. WALLS  
3" = 1'-0"

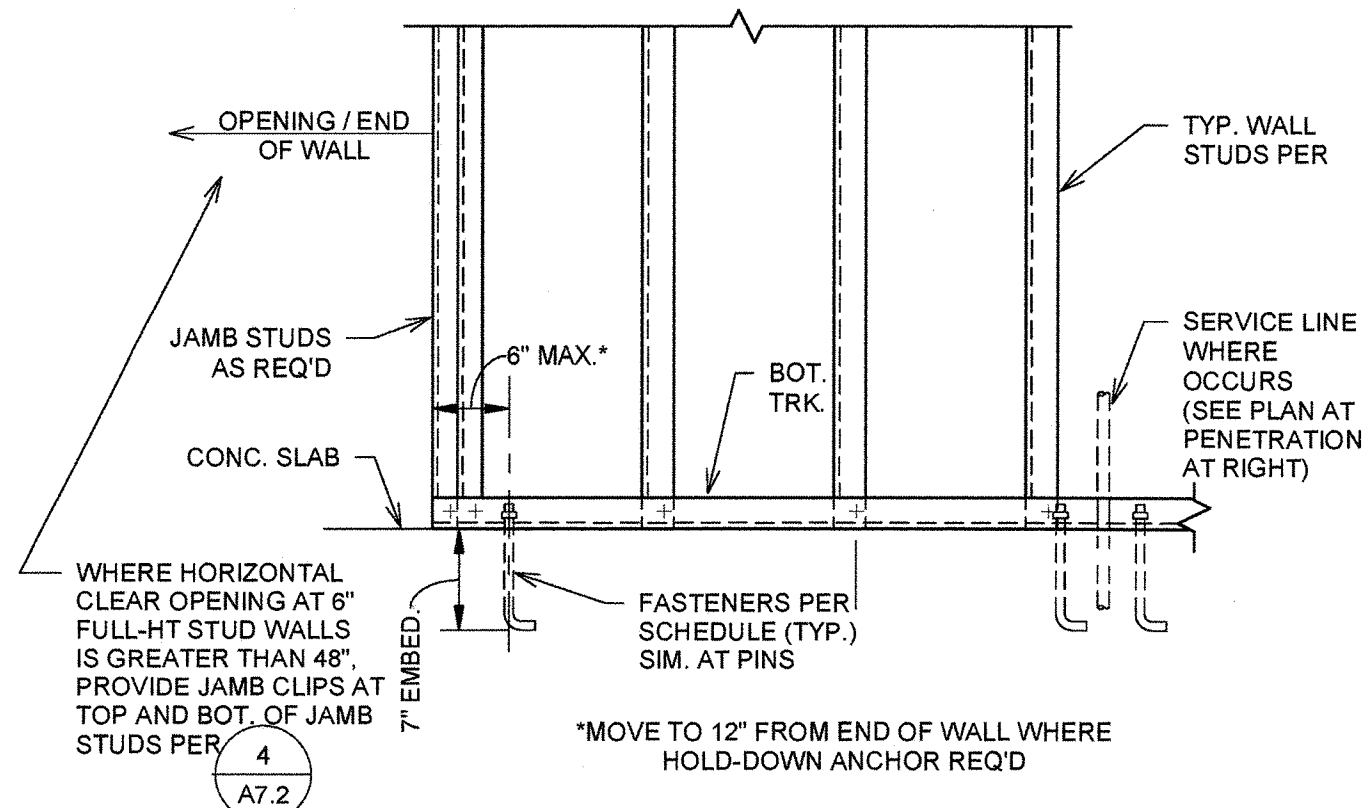


4  
A7.1  
BOTTOM TRACK CONNECTION SCHEDULE  
1" = 1'-0"


BOTTOM TRACK FASTENER SCHEDULE	
EXTERIOR NON-BRG WALLS (UNLESS NOTED OTHERWISE)	3/8"Ø F1554 GR. 36 THREADED RODS W/ HILTI HY 200 EPOXY (2-3/8" MIN. EMBED.) AT 48" O.C. MAX. SPACING AND 6" FROM TRACK ENDS. INSTALL PER ICC ESR-3187
INTERIOR NON-BRG PARTITIONS (UNLESS NOTED OTHERWISE)	HILTI X-U POWDER ACTUATED FASTENER AT 32" O.C. MAX. SPA. (16" MAX. SPACING AT EXTERIOR WALLS AND FULL-HT. 8" STUD WALLS) AND 6" FROM TRACK ENDS. INSTALL PER ICC ESR-2269 W/ 1-1/4" MIN. EMBED. INTO SLAB

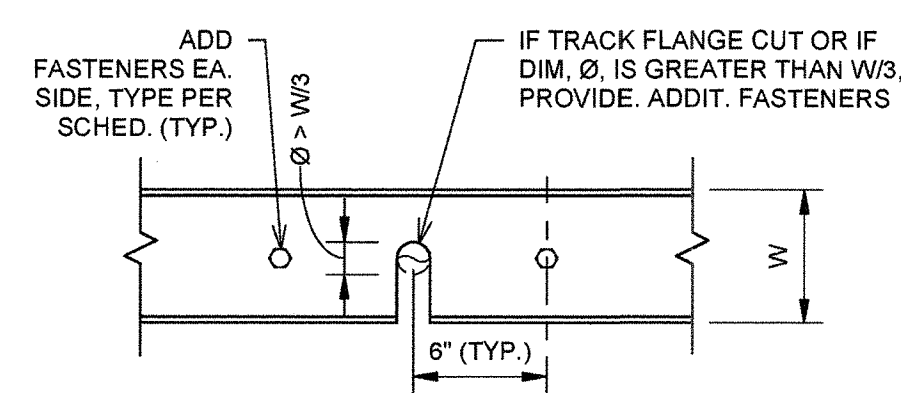


PLAN VIEW AT TRACK PENETRATION

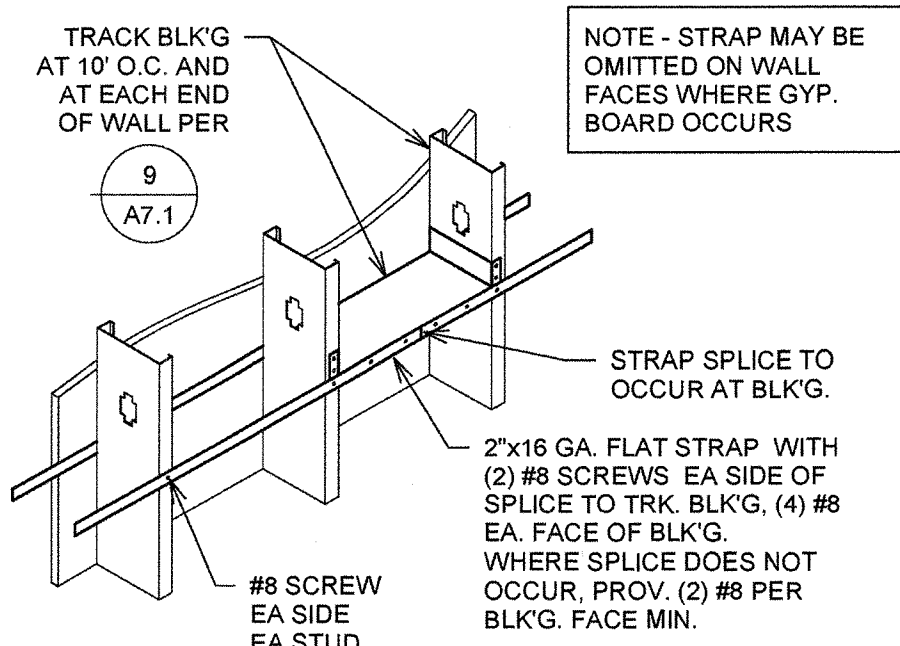


6  
A7.1  
FLAT STRAP LATERAL BRACING  
3/4" = 1'-0"

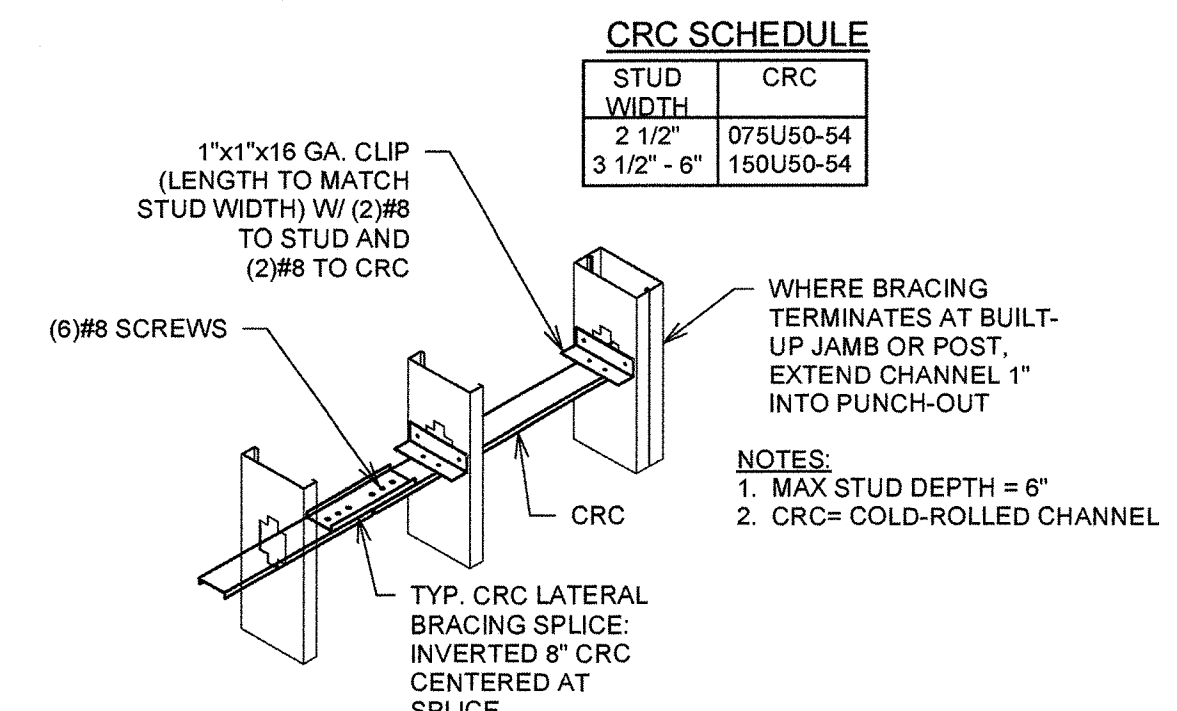


5  
A7.1  
COLD-ROLLED CHANNEL BRACING  
3/4" = 1'-0"

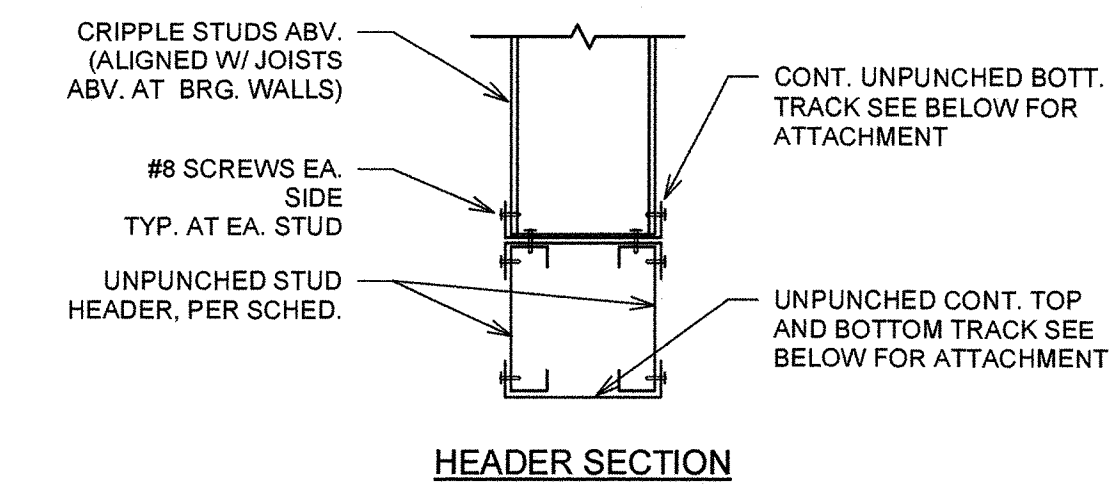


HEADER SECTION

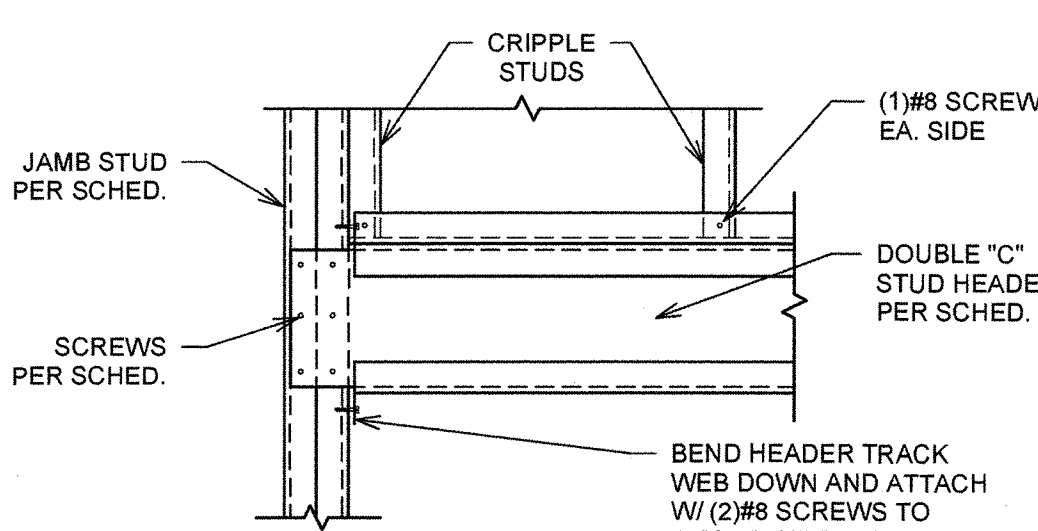


HEADER ELEV. AT CONN. TO JAMB STUDS

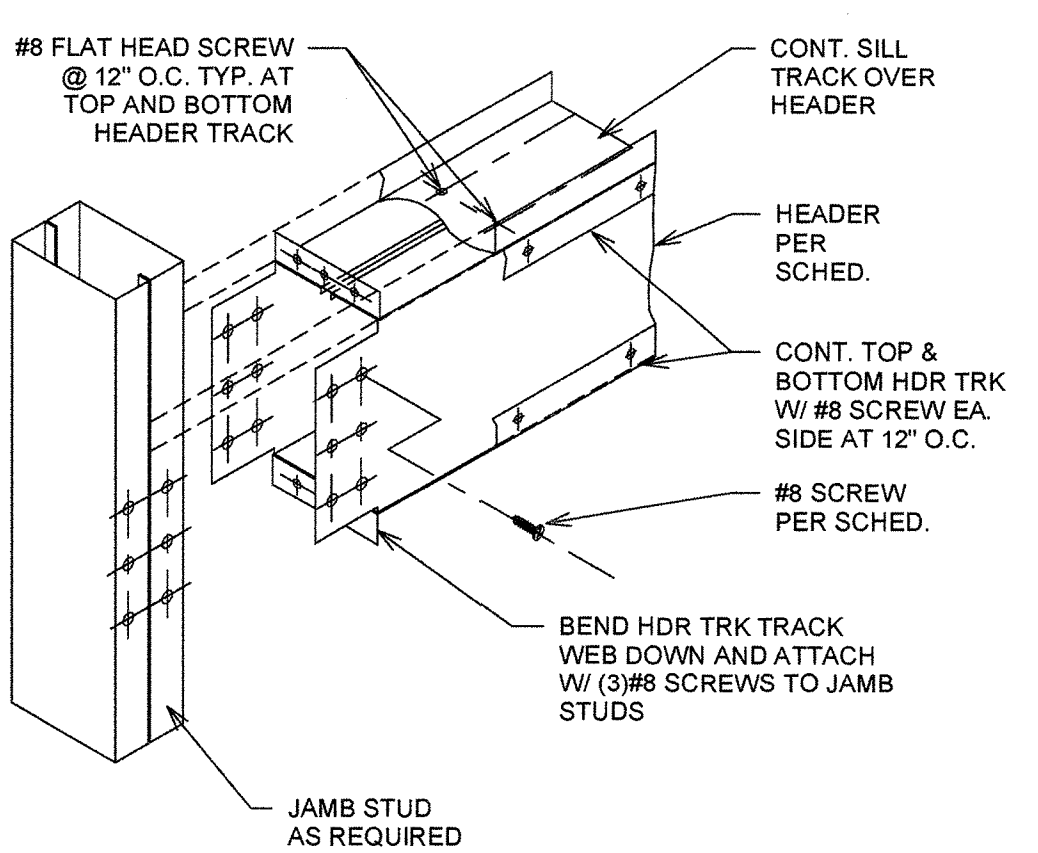

ISOMETRIC CONN. VIEW

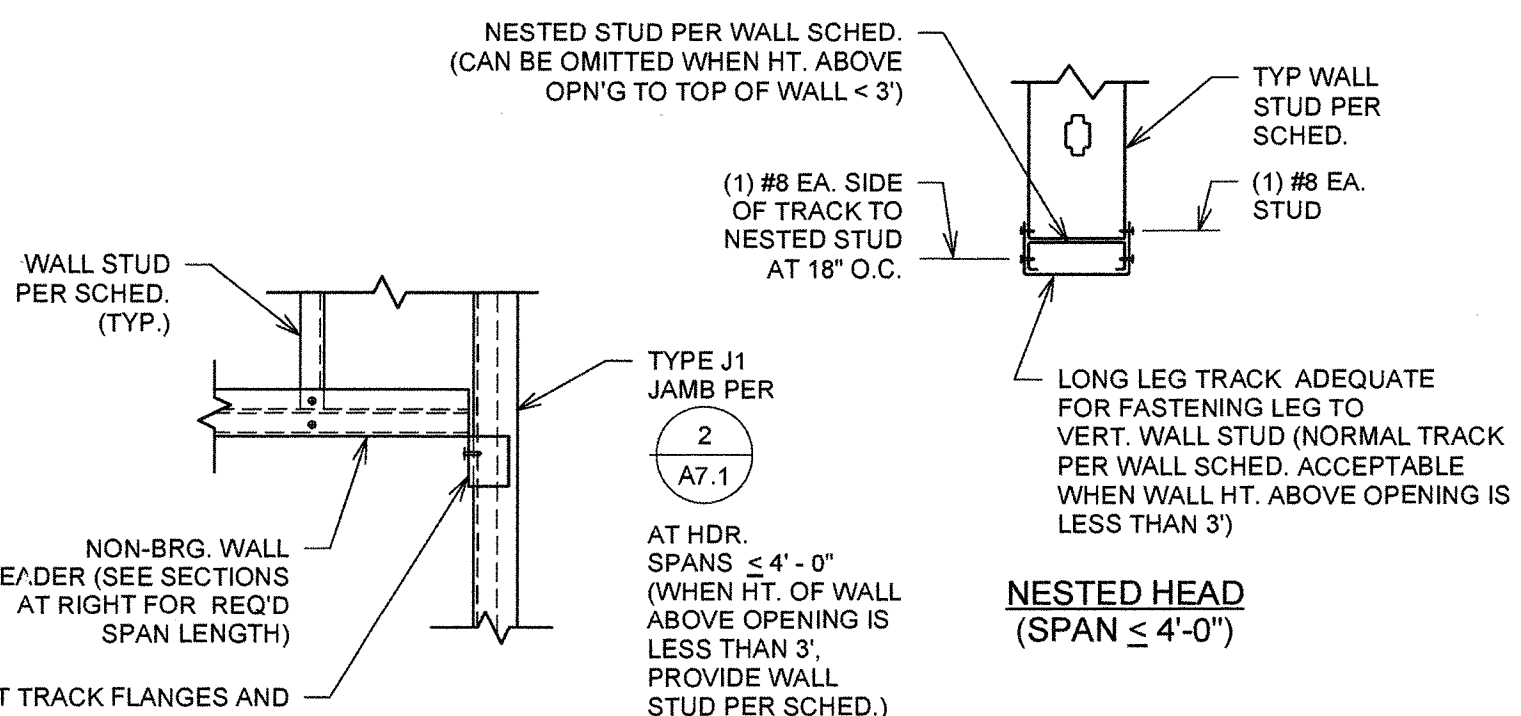


ELEVATION AT NON-BEARING WALL HEADER

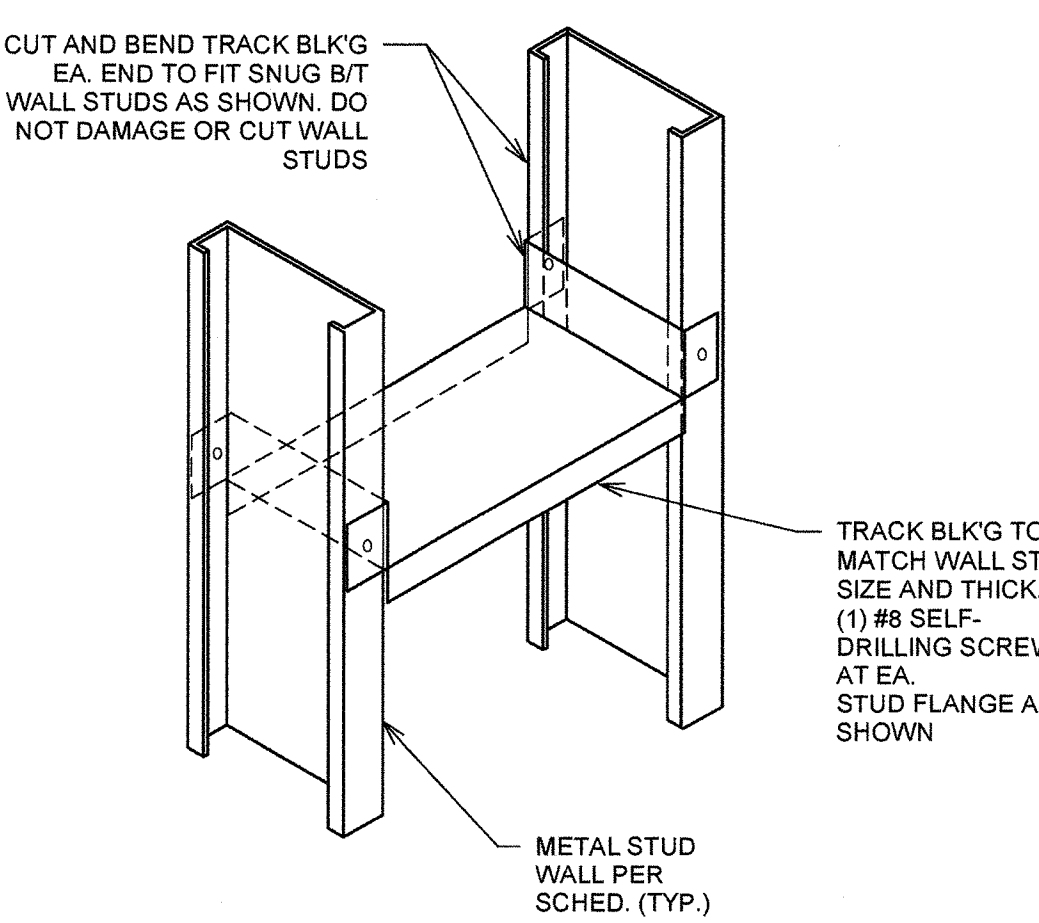


9  
A7.1  
TYPICAL STUD BLOCKING DETAIL  
1" = 1'-0"

8  
A7.1  
MTL STUD - TYPICAL HEADER AT NON-BRG. WALLS2  
1" = 1'-0"

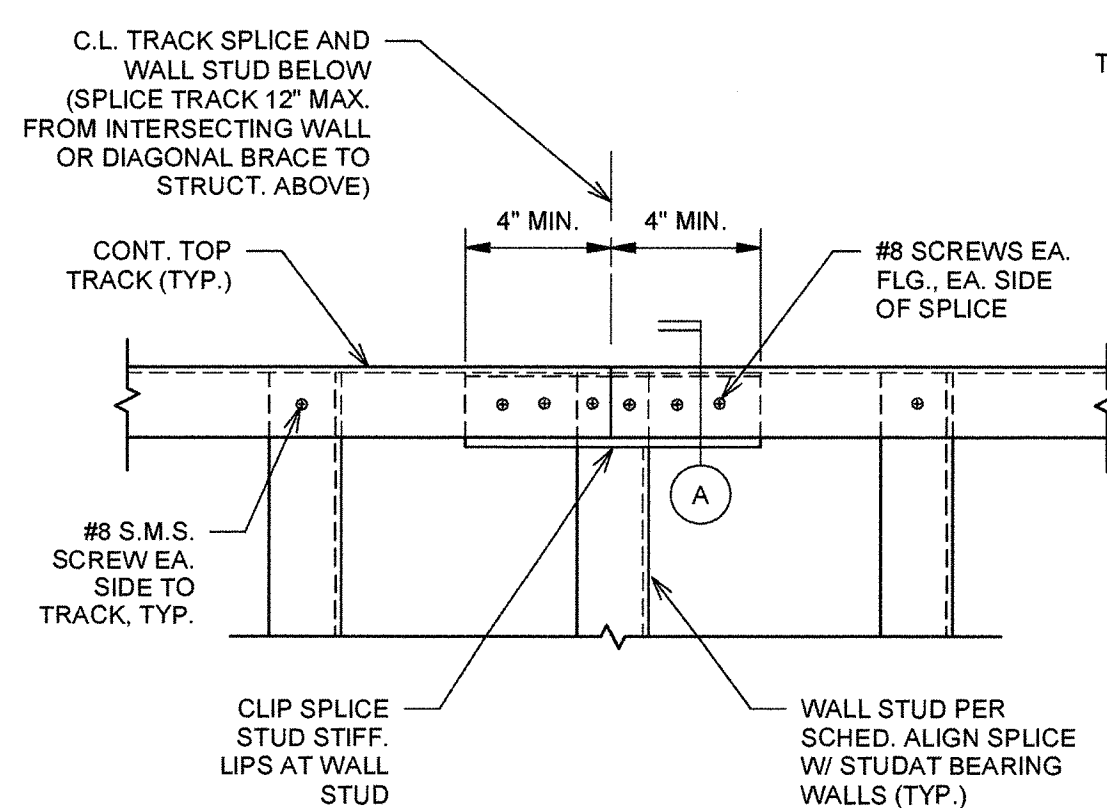

ELEVATION

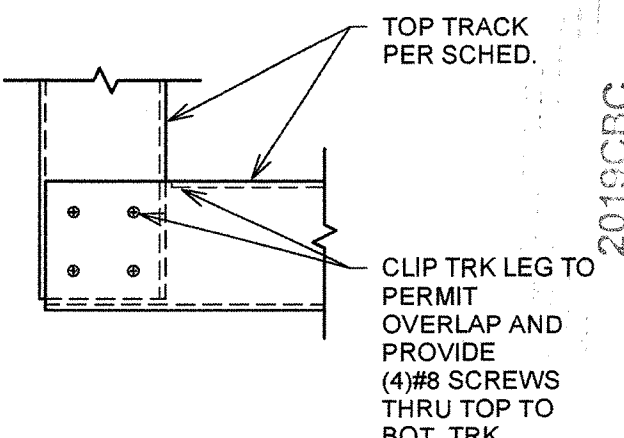

PLAN AT CORNER INTERSECTION

METAL STUD WALL BOX HEADER (BH) SCHEDULE						
MARK	OPENING SIZE	STUDS***	TRACKS**	TOTAL NO. OF SCREWS EA. END OF BOX HEADER*	PROFILE	REQ'D. JAMB STUDS PER 2 A7.1
BH1	0'-0" TO 4'-0"	(2) 600SYYY-YY	(2) 600T125-XX (UNPUNCHED)	(4) #8 SELF-DRILLING SCREWS (16 TOTAL)		NESTED JAMB STUD TYPE J1
BH2	4'-0" TO 10'-0"	(2) 600SYYY-YY	(2) 600T125-XX (UNPUNCHED)	(8) #8 SELF-DRILLING SCREWS (32 TOTAL)		(2) JAMB STUDS TYPE J2 / J3
BH3	10'-0" TO 16'-0"	(2) 800S162-54	(2) 600T125-54 (UNPUNCHED)	(8) #10 SELF-DRILLING SCREWS (32 TOTAL)		(2) JAMB STUDS TYPE J2 / J3

\*DIST. SCREWS EVENLY EA. SIDE OF BOX HEADER TO EA. JAMB STUD


\*\* "XX" = MATCH WALL BOT. TRACK THICKNESS PER SCHED.

\*\*\* "YYY-YY" = MATCH STUD SIZE AND THICKNESS PER WALL SCHED.


7  
A7.1  
BOX HEADER SCHEDULE (EXTERIOR WALLS)  
1" = 1'-0"

10  
A7.1  
TYP. TOP TRACK SPLICE  
3/4" = 1'-0"




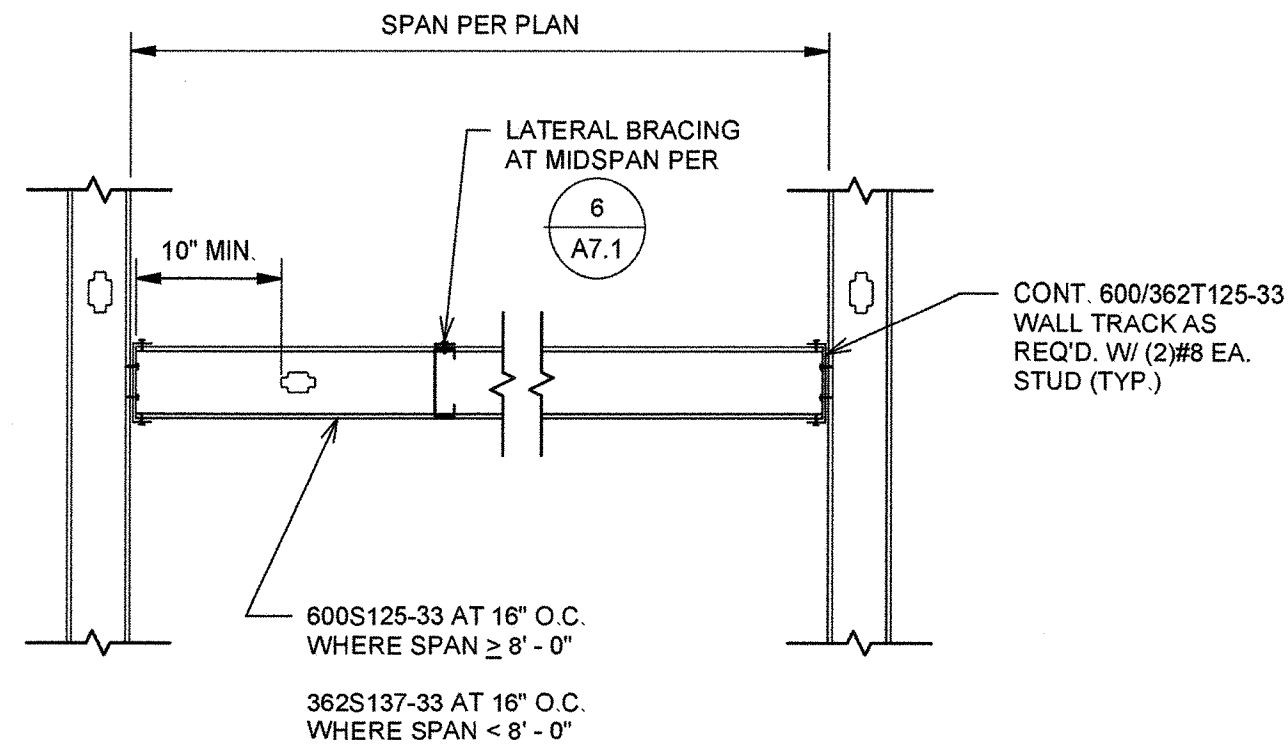


1 CEILING JOISTS AT GYP. BOARD CEILING  
3/4" = 1'-0"

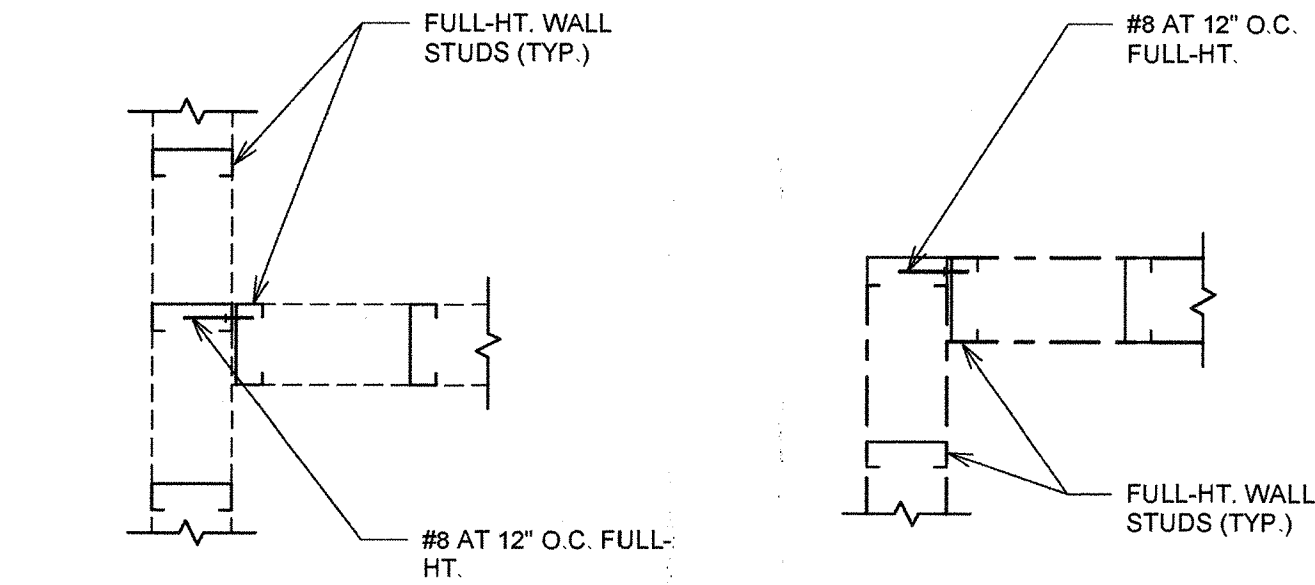


2 TYP. WALL INTERSECTION DETAIL AT CORNERS/INTERSECTIONS  
1" = 1'-0"

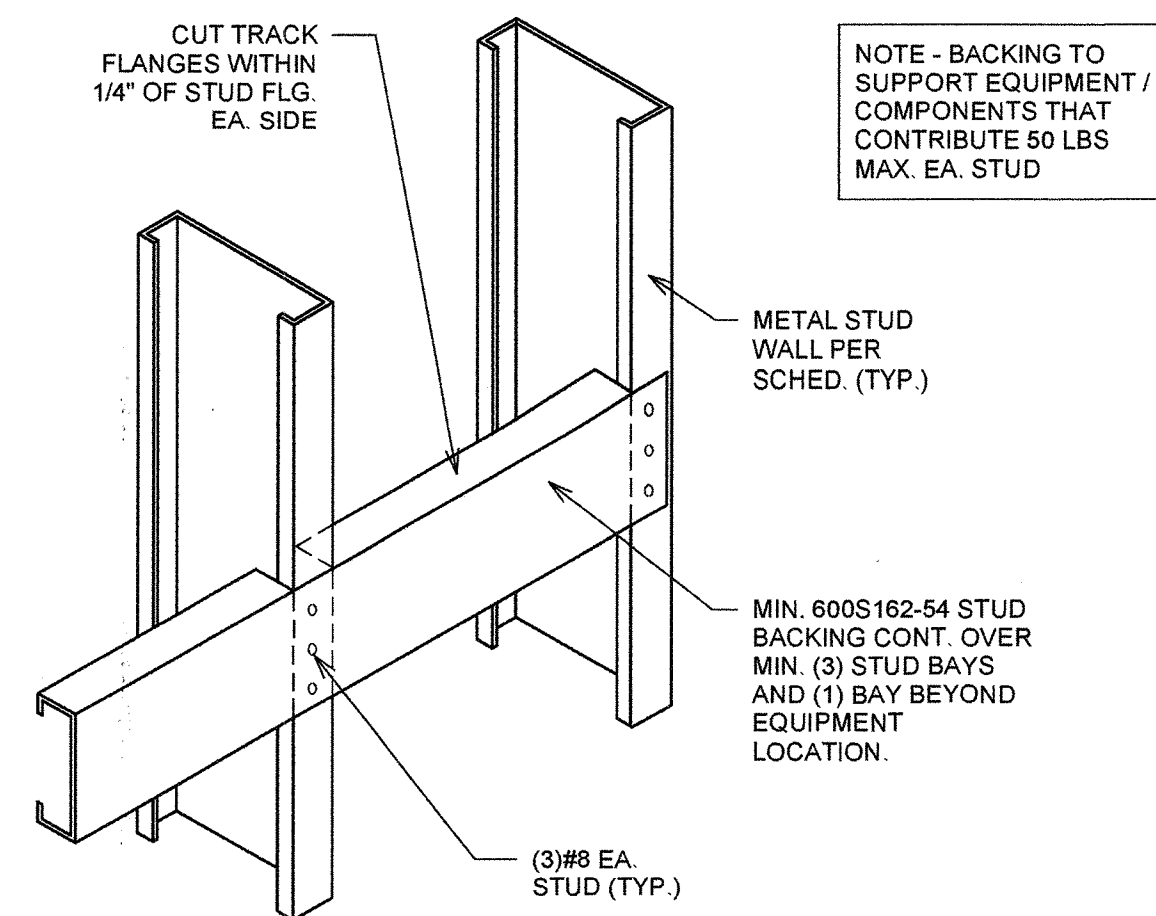


3 TYPICAL TRACK BACKING AT WALL MOUNTED EQUIPMENT  
1" = 1'-0"

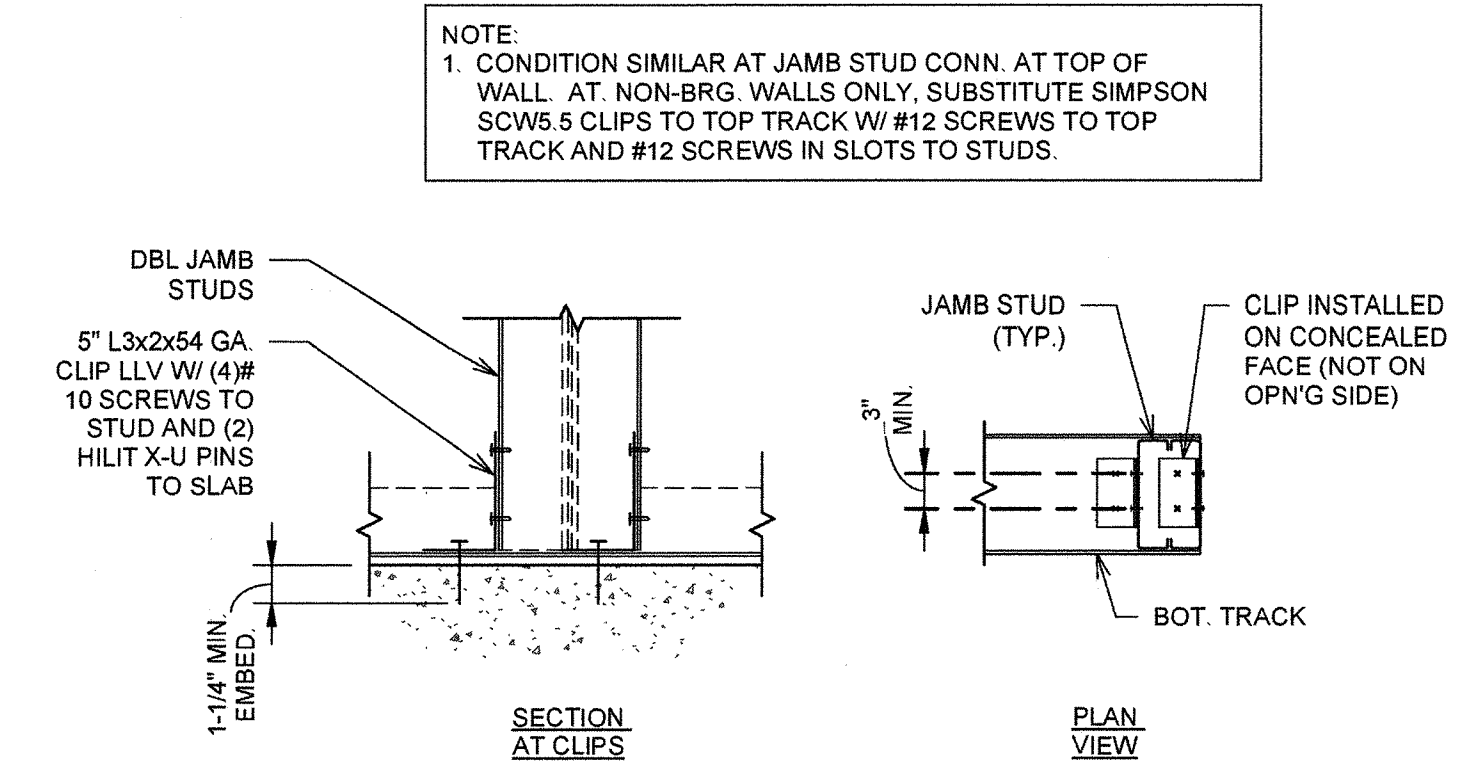


4 JAMB CLIP DETAIL  
3/4" = 1'-0"

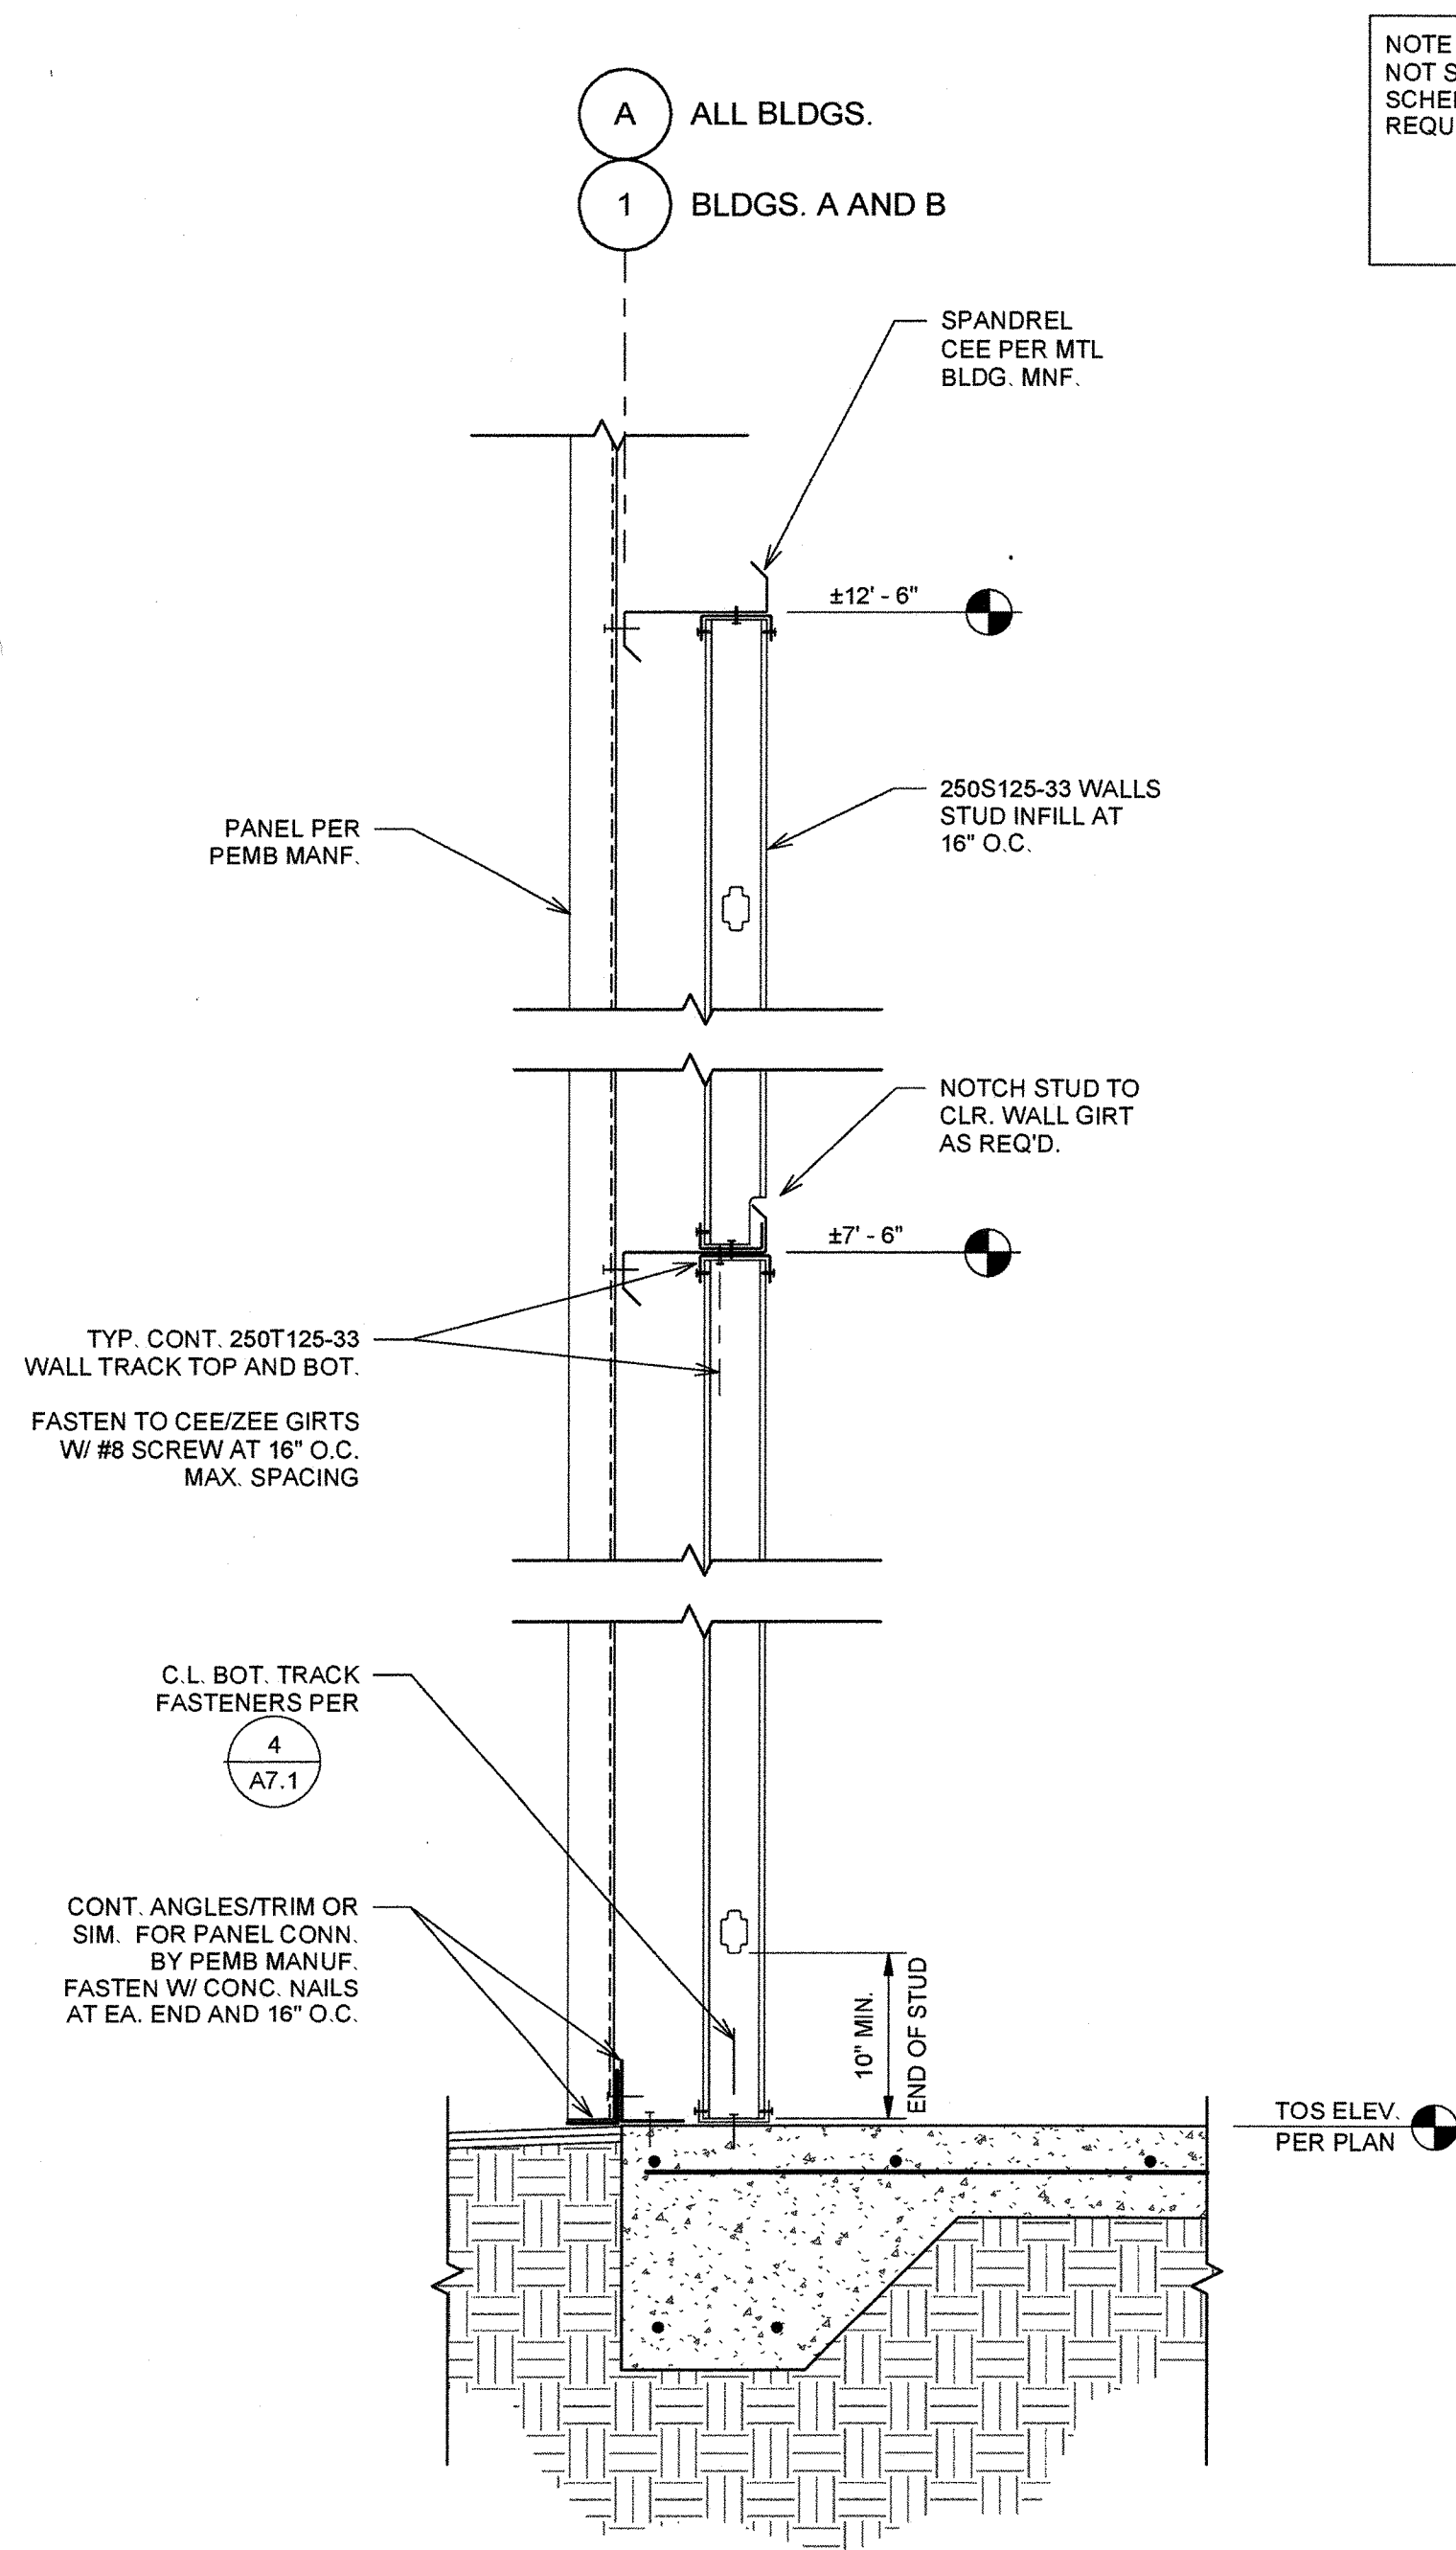

9 TYP. EXT. WALL AT OFFICE ALONG GRID A (ALL BLDGS.)  
1" = 1'-0"

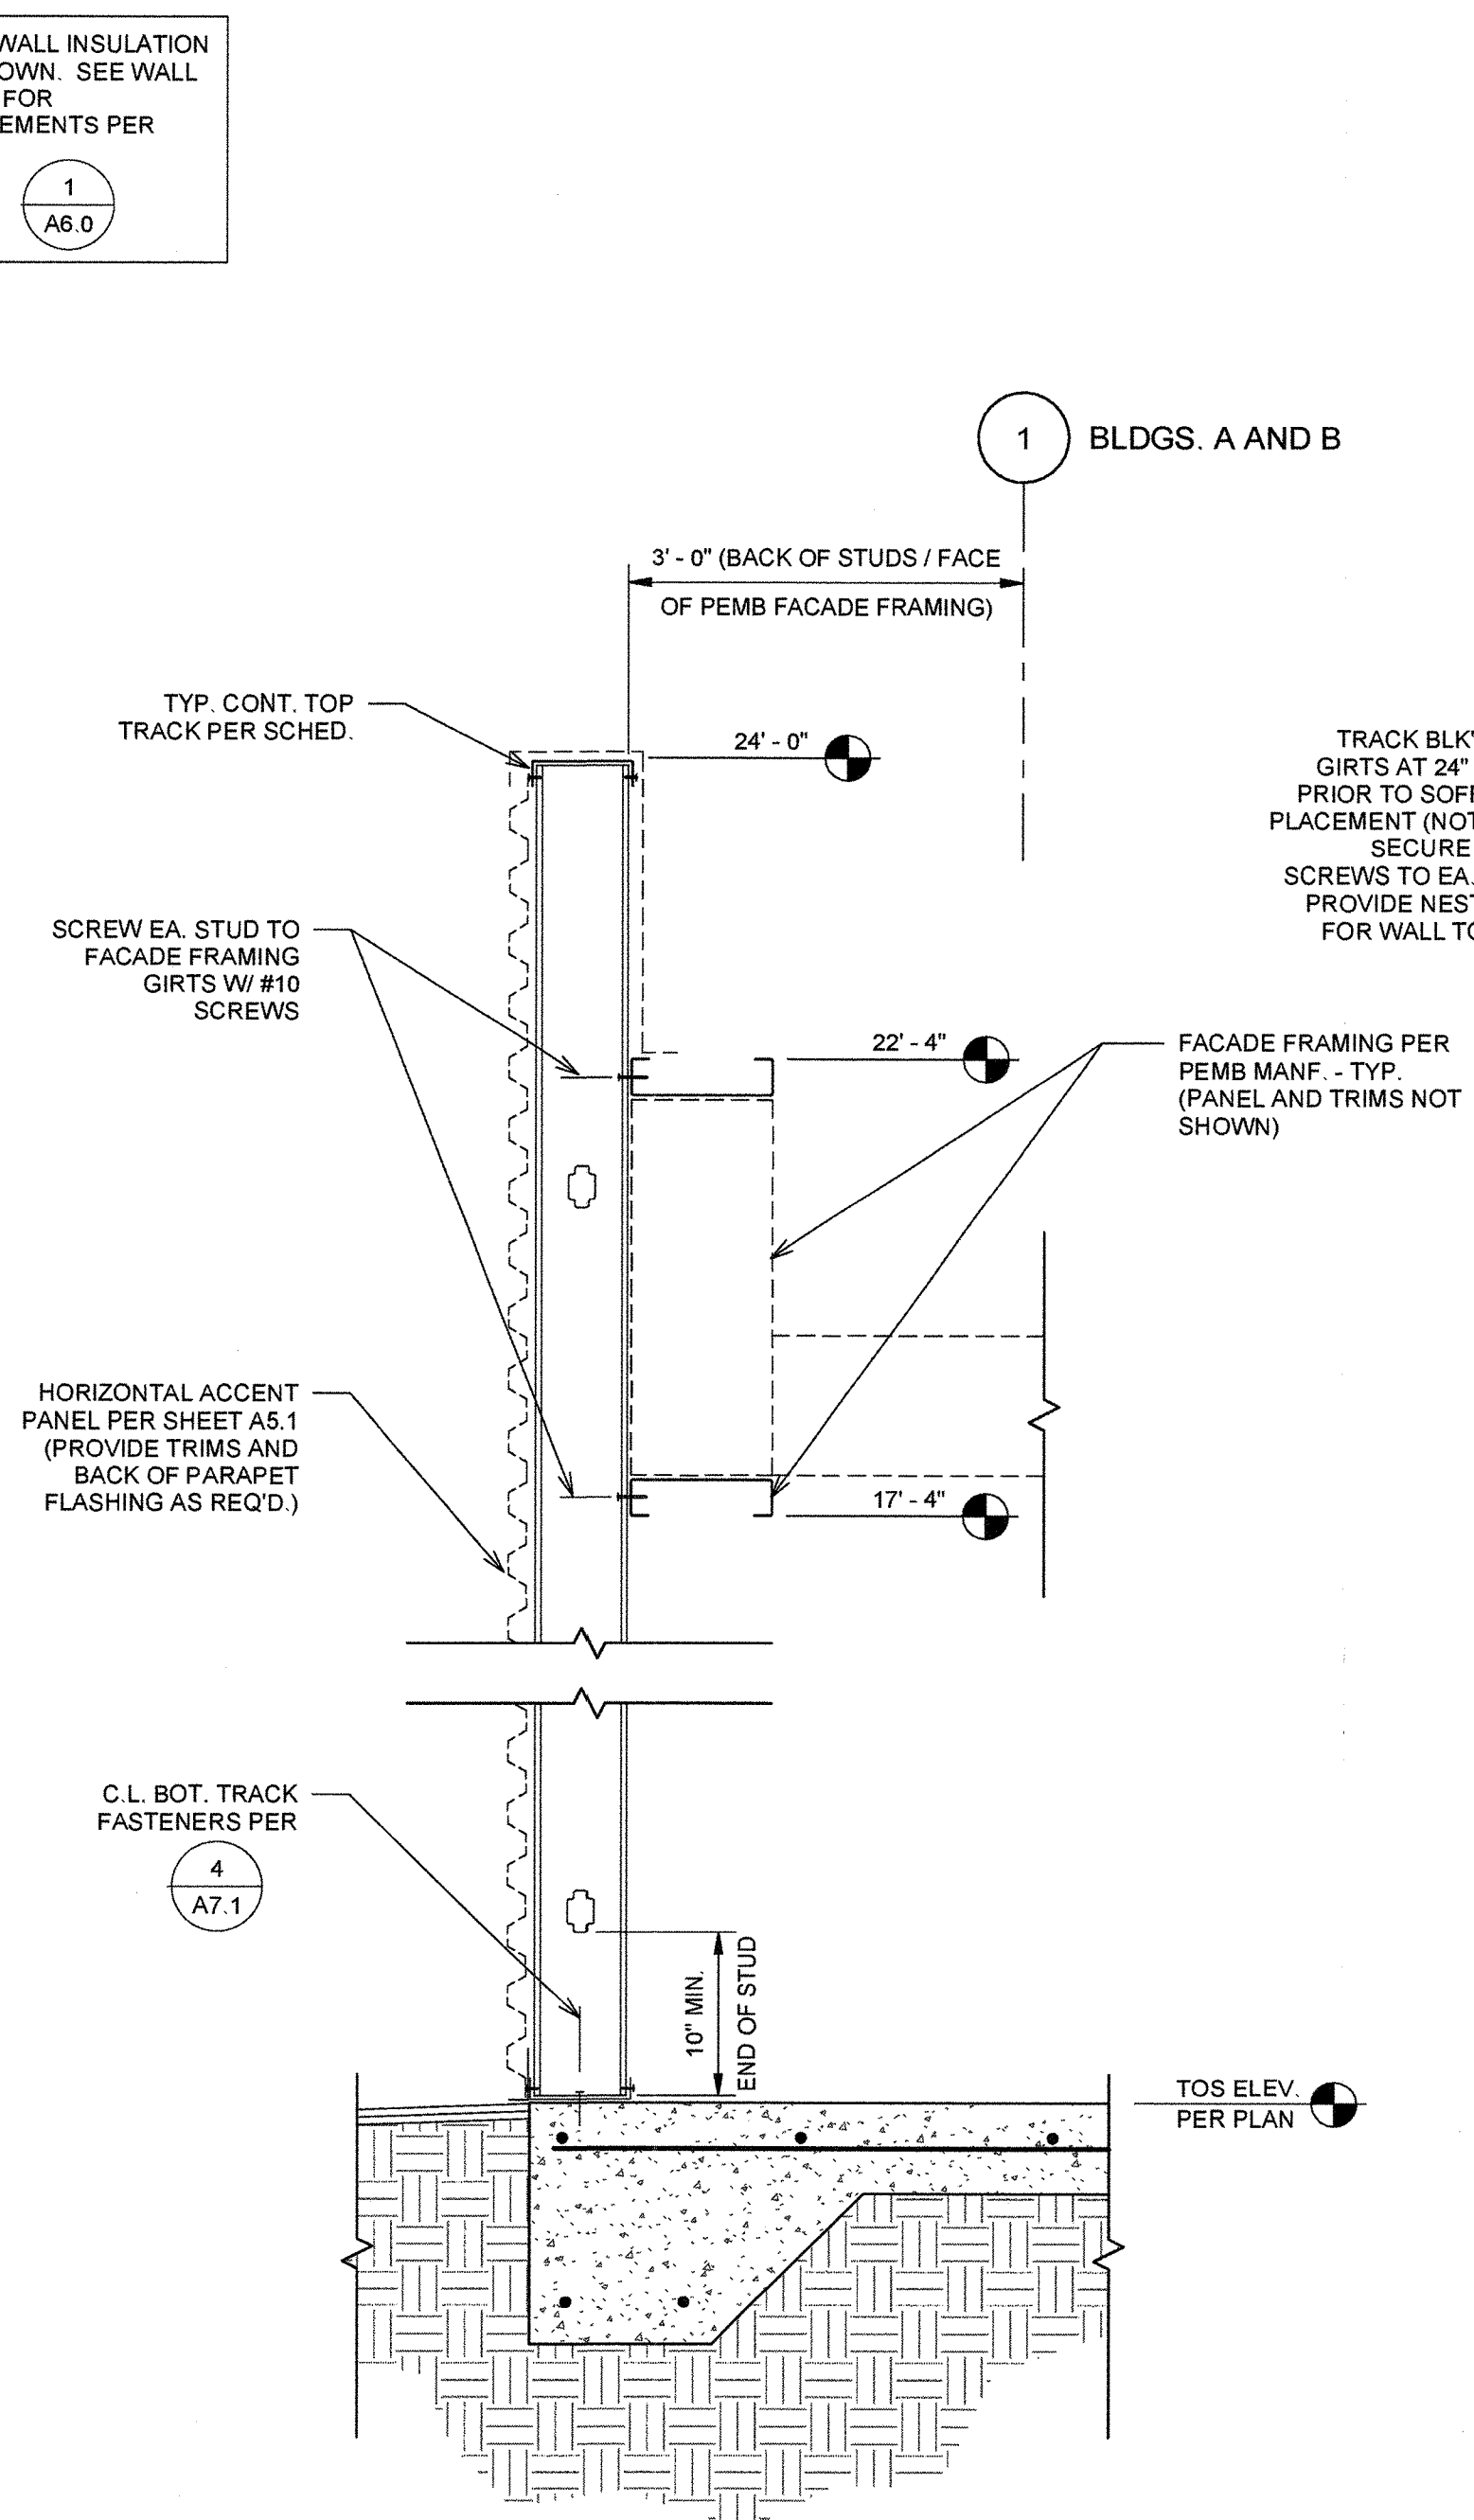

10 ACCENT WALL DETAIL AT WEST END - BLDG. A AND B  
1" = 1'-0"

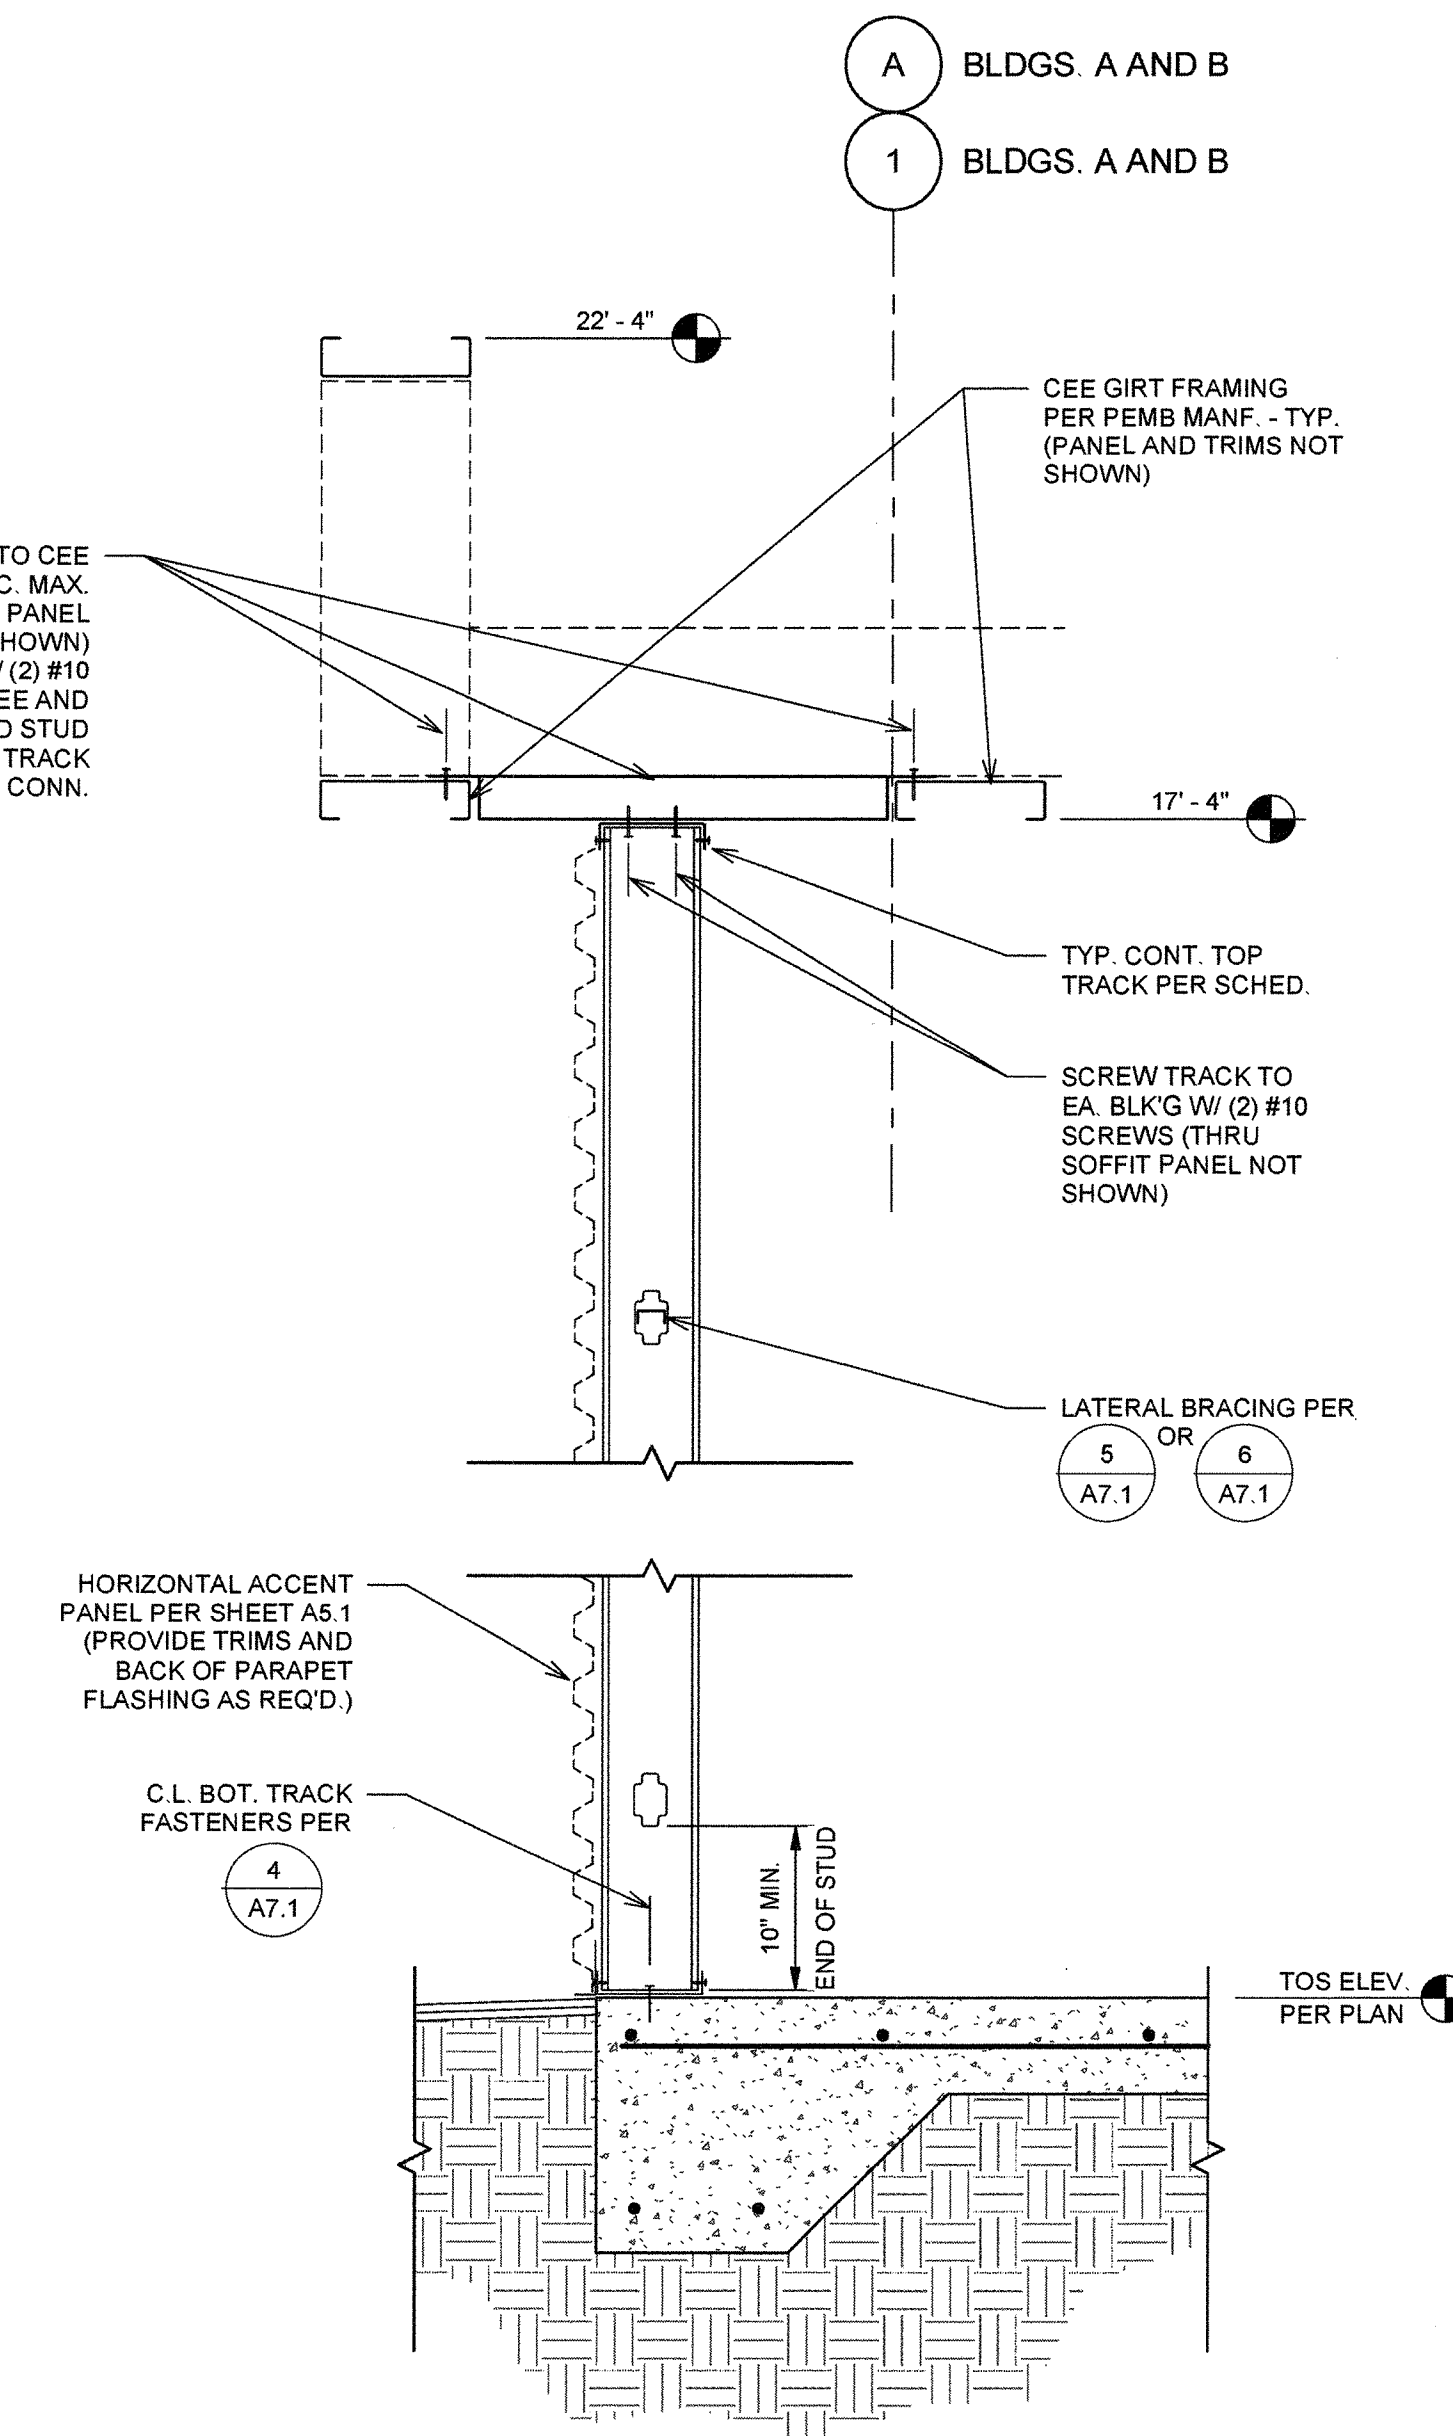


11 ACCENT WALL DETAIL AT WEST END - BLDG. A AND B  
1" = 1'-0"

NOTE - WALL INSULATION NOT SHOWN. SEE WALL SCHED. FOR REQUIREMENTS PER

1 A6.0

BY	REVISION	DATE

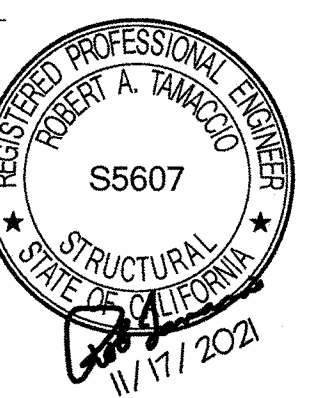

**FRAMING DETAILS (CONT.)**

LEASE FLEX. / WAREHOUSE BUILDINGS

FOR

MADERA INDUSTRIAL WHSE, LLC

S. SCHNOOR AVENUE, MADERA, CA

2019CBC  
City of Madera  
Building Department  
The approval of these plans does not prevent the City of Madera from requiring correction of errors or omissions in the plans, specifications or construction. Subject to the City's review and approval of the plans.

APPROVED

By: [Signature]  
Date: MAR 03 2022

JOB NUMBER	21107
DESIGNED BY	RT
DRAWN BY	LM
DATE	9/17/2021
SHEET NUMBER	A7.2



GENERAL NOTES:

DESIGN CRITERIA

CODE: 2019 CALIFORNIA BUILDING CODE (W/ CITY OF MADERA AMENDMENTS)  
AISC 360-10, DESIGN SPECIFICATION FOR STRUCTURAL STEEL BUILDINGS  
AISC 341-10, SEISMIC PROVISIONS FOR STEEL BUILDINGS  
MBMA DESIGN MANUALS (LATEST EDITIONS)

GRAVITY LOADS

ROOF COLLATERAL DEAD LOAD..... 5 PSF  
ROOF LIVE LOAD..... 20 PSF

WIND LOADS

BUILDING CLASSIFICATION..... II  
BASIC WIND SPEED, V<sub>ULT</sub>..... 94 MPH  
WIND EXPOSURE..... C  
TOPOGRAPHIC FACTOR, K<sub>z</sub>..... 1.0

SEISMIC LOADS

SEISMIC IMPORTANCE FACTOR, I<sub>e</sub>..... 1.0  
OCCUPANCY CATEGORY..... II  
SOIL SITE CLASS..... D  
SPECTRAL RESPONSE COEFFICIENT, S<sub>s</sub>..... 0.608  
SPECTRAL RESPONSE COEFFICIENT, S<sub>1</sub>..... 0.237  
SITE COEFFICIENT, F<sub>a</sub>..... 1.314  
SPECTRAL RESPONSE COEFFICIENT, S<sub>0s</sub>..... 0.332  
SEISMIC DESIGN CATEGORY..... D

STRUCTURAL SYSTEM (PRE-ENGINEERED BLDG. BY OTHERS)

R..... 3.5 / 3.25 (OMRF / OCBF)  
Q<sub>a</sub>..... 3.0 / 2.0  
C<sub>a</sub>..... 3.0 / 3.25  
ρ..... 1.3 / 1.3

GENERAL CONDITIONS

- THE CONTRACTOR SHALL EXAMINE THE STRUCTURAL DRAWINGS AND SHALL NOTIFY THE STRUCTURAL ENGINEER IN WRITING OF ANY DISCREPANCIES FOUND BEFORE PROCEEDING WITH THE WORK. THE CONTRACTOR SHALL VERIFY ALL DIMENSIONS, ELEVATIONS AND SITE CONDITIONS BEFORE STARTING WORK.
- ALL OMISSIONS OR CONFLICTS BETWEEN THE VARIOUS ELEMENTS OF THE WORKING DRAWINGS SHALL BE BROUGHT TO THE ATTENTION OF THE ARCHITECT AND THE STRUCTURAL ENGINEER BEFORE PROCEEDING WITH ANY WORK SO INVOLVED.
- SPECIFIC NOTES AND DETAILS SHALL TAKE PRECEDENCE OVER GENERAL NOTES AND TYPICAL DETAILS. WHERE THE NOTES, DRAWINGS, AND/OR SPECIFICATIONS DIFFER, THE MORE STRINGENT REQUIREMENT SHALL APPLY.
- IF A SPECIFIC DETAIL IS NOT SHOWN FOR ANY PART OF THE WORK, THE CONSTRUCTION SHALL BE THE SAME AS FOR SIMILAR WORK.
- WORKING DIMENSIONS SHALL NOT BE SCALED FROM PLANS, SECTIONS, OR DETAILS ON THESE DRAWINGS.
- THE CONTRACTOR SHALL IMMEDIATELY NOTIFY THE ARCHITECT AND THE STRUCTURAL ENGINEER OF ANY CONDITION THAT, IN HIS OPINION, MIGHT ENDANGER THE STABILITY OF THE STRUCTURE OR CAUSE DISTRESS TO THE STRUCTURE.
- THE CONTRACTOR SHALL SUPERVISE AND DIRECT HIS WORK AND HE SHALL BE SOLELY RESPONSIBLE FOR CONSTRUCTION MEANS, METHODS, TECHNIQUES, SEQUENCES AND PROCEDURES. PROVIDE ADEQUATE SHORING AND BRACING OF ALL STRUCTURAL MEMBERS DURING CONSTRUCTION. NOTIFY ENGINEER OF ALL FIELD CHANGES PRIOR TO INSTALLATION.
- REFER TO THE ARCHITECTURAL DRAWINGS FOR INFORMATION NOT COVERED BY THESE GENERAL NOTES OR THE STRUCTURAL DRAWINGS OR APPROVED BY THE STRUCTURAL ENGINEER OF RECORD.
- ALL CONSTRUCTION SHALL BE DONE WITH MATERIALS, METHODS, AND WORKMANSHIP ACCEPTED AS GOOD PRACTICE BY THE CONSTRUCTION INDUSTRY AND IN CONFORMANCE WITH THE PROVISIONS OF THE CBC AND STANDARDS REFERENCED THEREIN.
- PIPES, DUCTS, SLEEVES, OPENINGS, POCKETS, CHASES, BLOCK-OUTS, ETC., SHALL NOT BE PLACED IN SLABS, FOUNDATIONS, ETC., NOR SHALL ANY STRUCTURAL MEMBER BE CUT FOR SUCH ITEMS, UNLESS SPECIFICALLY DETAILED ON THESE STRUCTURAL DRAWINGS.
- ALTERNATE ASSEMBLIES AND MATERIALS WILL BE CONSIDERED FOR REVIEW. ENGINEER MAY REQUEST PAYMENT FOR REVIEW.
- VERIFY ALL DIMENSIONS IN FIELD AND PROVIDE ADEQUATE SHORING AND BRACING OF ALL STRUCTURAL MEMBERS DURING CONSTRUCTION. NOTIFY ENGINEER OF ALL FIELD CHANGES PRIOR TO INSTALLATION. DISCREPANCIES FOUND BETWEEN STRUCTURAL DRAWINGS AND OTHER DOCUMENTS ARE TO BE NOTED IN WRITING TO THE ENGINEER PRIOR TO CONSTRUCTION.

JOBSITE SAFETY

- THE ENGINEER (DBKO DESIGN+BUILD) HAS NOT BEEN RETAINED OR COMPENSATED TO PROVIDE DESIGN AND/OR CONSTRUCTION REVIEW SERVICES RELATED TO THE CONTRACTOR'S SAFETY PRECAUTIONS OR TO MEANS, METHODS, TECHNIQUES, SEQUENCES OR PROCEDURES FOR THE CONTRACTOR TO PERFORM THEIR WORK. THE UNDERTAKING OF PERIODIC SITE VISITS BY THE ENGINEER SHALL NOT BE CONSTRUED AS SUPERVISION OF ACTUAL CONSTRUCTION NOR MAKE THE ENGINEER RESPONSIBLE FOR PROVIDING A SAFE PLACE FOR THE PERFORMANCE OF WORK BY THE CONTRACTOR, SUBCONTRACTORS, SUPPLIERS OR THEIR EMPLOYEES, OR FOR ACCESS, VISITS, USE, WORK, TRAVEL, OR OCCUPANCY BY ANY PERSON. THE CONTRACTOR AND/OR HIS REPRESENTATIVES ARE RESPONSIBLE FOR JOB SITE SAFETY AS WELL AS ACTIVITIES RELATED TO MEANS, METHODS, TECHNIQUES, SEQUENCES AND PROCEDURES OF CONSTRUCTION.

FOUNDATION

STRUCTURAL DESIGN COMPLIES WITH MINIMUM REQUIREMENTS PER SOILS REPORT NUMBER 1-221-0369 PREPARED BY SALEM ENGINEERING GROUP, INC. DATED APRIL 28, 2021.

ALLOWABLE BEARING PRESSURE ON PAD FOOTINGS: 2,000 PSF

CONCRETE

- CONCRETE SHALL CONFORM TO THE INDICATED REFERENCE CODES AND STANDARDS EXCEPT AS MODIFIED BELOW:

ACI-301 - "STANDARD SPECIFICATIONS FOR STRUCTURAL CONCRETE"  
ACI-318 - "BUILDING CODE REQUIREMENTS FOR STRUCTURAL CONCRETE"  
ACI-308R - "HOT WEATHER CONCRETING"  
ACI-306R - "COLD WEATHER CONCRETING"  
ACI-304 - "GUIDE FOR MEASURING, MIXING, TRANSPORTING AND PLACING CONCRETE"

- CONCRETE MIX SPECIFICATIONS

LOCATION	MIN F <sub>c</sub> (PSI)	TEST AGE (DAYS)	MAX W/C RATIO (a)	AIR (b)	MAX. ALLOW. AGGREGATE (d)	NOTES
SLABS-ON-GRADE	3,500	28	0.48	--	1-1/2" @ 8" SOG	USE MAX. SIZE - WELL GRADED MIX, NORMAL WEIGHT
FOOTINGS	3,000	28	0.50	--	1-1/2"	NORMAL WEIGHT

- FLY ASH MAY BE ADDED TO ANY OF THE MIX DESIGNS SPECIFIED. MAXIMUM FLY ASH ADDED SHALL BE LIMITED TO 25% OF THE TOTAL WEIGHT OF CEMENTITIOUS MATERIAL.
  - TOTAL AIR CONTENT IS SPECIFIED IN THE TABLE ABOVE. AIR CONTENT TOLERANCE SHALL BE ± 1.5 % AND SHALL BE MEASURED AT THE POINT OF PLACEMENT. (AFTER PUMPING IF APPLICABLE) ALL CONCRETE EXPOSED TO THE WEATHER SHALL HAVE AN APPROVED ADMIXTURE TO ENTRAIN AIR - 5% TOTAL AIR REQUIRED. CONCRETE THAT CAN BE SUBJECT TO FREEZING AND THAWING DURING CONSTRUCTION SHALL BE AIR ENTRAINED.
  - WATER/CEMENT (W/C) RATIO SHALL BE BASED ON THE TOTAL CEMENTITIOUS MATERIAL. CEMENTITIOUS MATERIALS INCLUDE CEMENT, FLY ASH, SILICA FUME, AND BLAST FURNACE SLAG.
  - FOR SLABS-ON-GRADE, USE WELL GRADED MIX WITH THE MAX. AGGREGATE SIZE SPECIFIED USED IN THE MIX DESIGN. FOR ALL OTHERS, USE OF SMALLER AGGREGATE THAN INDICATED IS PERMITTED.
  - USE TYPE II CEMENT IN ALL CONCRETE IN CONTACT WITH SOIL.
- ALL CONCRETE MIXES SHALL SATISFY THE MORE STRINGENT OF THE MIX SPECIFICATIONS REQUIREMENTS. FOR EXAMPLE: A MIX WITH THE SPECIFIED W/C RATIO MAY RESULT IN A STRENGTH GREATER THAN THE F<sub>c</sub> REQUIRED.
  - MIXING: COMPLY WITH ACI-301. DO NOT EXCEED THE AMOUNT OF WATER SPECIFIED IN THE APPROVED MIX. PROPORTIONS OF AGGREGATE TO CEMENT SHALL BE SUCH AS TO PRODUCE A DENSE, WORKABLE MIX, WHICH CAN BE PLACED WITHOUT SEGREGATION OR EXCESS FREE SURFACE WATER.
  - CONCRETE PROPORTIONS SHALL BE DETERMINED IN ACCORDANCE WITH THE PROVISIONS OF ACI 318, SECTION 5.2. ESTABLISH PROPORTIONS ON THE BASIS OF FIELD EXPERIENCE OR TRIAL MIXTURES OR BOTH. THE CONCRETE PERFORMANCE MIX SHALL INCLUDE THE AMOUNTS OF CEMENT, FINE AND COARSE AGGREGATE, WATER AND ADMIXTURES AS WELL AS THE WATER CEMENT RATIO, SLUMP, CONCRETE YIELD AND SUBSTANTIATING STRENGTH DATA IN ACCORDANCE WITH IBC 1905.3.
  - PROVIDE A 3/4 INCH CHAMFER AT ALL EXPOSED CONCRETE EDGES, UNLESS INDICATED OTHERWISE ON ARCHITECTURAL OR STRUCTURAL DRAWINGS.
  - SLUMP SHALL BE DETERMINED BY THE CONTACTOR. THE MIX DESIGN SHALL INDICATE THE SLUMP AND IT SHALL BE MEASURED AT THE JOBSITE WITH A TOLERANCE PER SPECS. GREATER SLUMP MAY BE ACHIEVED BY USING APPROVED ADMIXTURES. DO NOT ADD WATER TO THE MIX UNLESS SPECIFICALLY ALLOWED BY THE MIX DESIGN. TOTAL WATER (BATCH AND SITE ADDED) MAY NOT EXCEED THE WATER IN THE APPROVED MIX DESIGN.
  - ACCELERATED SET, OR HIGH EARLY STRENGTH MAY BE ACHIEVED BY USING APPROVED ADMIXTURES. ALL ADMIXTURES SHALL BE CHLORIDE FREE.
  - CURING: REFERENCE ACI 308 - STANDARD PRACTICE FOR CURING CONCRETE AND ACI-301 SECTION 5 - STANDARD SPECIFICATIONS FOR STRUCTURAL CONCRETE. THE CURING SHALL BE SUCH THAT THE MOISTURE CONTENT AND TEMPERATURE IS MAINTAINED IN A MANNER TO DEVELOP THE DESIRED STRUCTURAL PROPERTIES AND DURABILITY OF THE CONCRETE.

- SLABS-ON-GRADE - APPLY A LIQUID MEMBRANE-FORMING CURING COMPOUND. APPLY AS SOON AS PRACTICAL AFTER FINISHING IN ACCORDANCE WITH MANUFACTURER'S REQUIREMENTS. LIQUID MEMBRANE CURING COMPOUNDS ARE TO BE COMPATIBLE WITH FUTURE FLOOR FINISHES OR BE REMOVED PRIOR TO APPLICATION OF THE FLOOR FINISHES.
- JOINTING: PROVIDE ADEQUATE JOINTING TO MINIMIZE EFFECTS OF VOLUME CHANGE. JOINTS SHOWN MAY BE ADJUSTED AT CONTRACTOR'S OPTION, WITH PRIOR APPROVAL FROM ENGINEER.
  - NON-SHRINK GROUT SHALL BE CEMENT BASED AND HAVE A MINIMUM COMPRESSIVE STRENGTH OF F<sub>c</sub> = 5,000 PSI AT 28 DAYS WHEN TESTED IN ACCORDANCE WITH ASTM C109.
  - SUBMIT REPORTS SHOWING THAT AGGREGATE IN CONCRETE HAS BEEN TESTED FOR AND DEMONSTRATES NEGLIGIBLE POTENTIAL FOR ALKALI REACTIVITY.
  - THE CONTRACTOR IS TO HAVE A MINIMUM OF 2 WORKING VIBRATORS PRIOR TO ANY CONCRETE PLACEMENT. WHEN CONCRETE IS GREATER THAN OR EQUAL TO 12 INCHES IN DEPTH, IT SHALL BE VIBRATED TO THE FULL DEPTH IN ACCORDANCE WITH ACI STANDARDS.
  - SUBMIT COLD AND HOT WEATHER PROTECTION PLANS TO THE STRUCTURAL ENGINEER OF RECORD FOR APPROVAL PRIOR TO THE PLACEMENT OF ANY CONCRETE.
  - PROVIDE CONCRETE SLABS-ON-GRADE WITH MINIMUM FLOOR FLATNESS/LEVELNESS NUMBERS IN ACCORDANCE W/ASTM E1155 AS SHOWN BELOW. CONCRETE CONTRACTOR PLACING SLAB-ON-GRADE TO PROVIDE F-NUMBER TESTING IN ACCORDANCE WITH ASTM E1155 UPON REQUEST BY DBKO. CRITERIA MINIMUMS AS FOLLOWED: F<sub>MIN</sub> = 35, F<sub>LMIN</sub> = 25

REINFORCING STEEL

- REFERENCE STANDARDS: ACI "DETAILING MANUAL" (SP-66); CRSI MANUAL OF STANDARD PRACTICE (MSP-1)
- MATERIALS: REINFORCING STEEL, TYPICAL: ASTM A615, GRADE 60. REINFORCING STEEL INDICATED ON DRAWINGS "TO BE WELDED" SHALL CONFORM TO ASTM A706, GRADE 60.
- LAP SPLICES: LAP ALL CONTINUOUS REINFORCING BARS PER APPLICABLE SCHEDULE. PROVIDE CORNER BARS FOR ALL HORIZONTAL REINFORCEMENT.
- MINIMUM CONCRETE COVER:

CAST AGAINST EARTH:  
FOOTINGS..... 3 INCHES  
SLABS..... 2 INCHES

CAST AGAINST FORMED SURFACES:  
WEATHER FACE - #6 BARS AND SMALLER..... 1-1/2 INCHES  
#6 BARS AND LARGER..... 2 INCHES

INTERIOR FACE - SLABS AND WALLS..... 3/4 INCH  
BEAMS AND COLUMNS..... 1-1/2 INCHES

EXPOSED SURFACES:  
COLUMNS  
TO TIES..... 1-1/2 INCHES  
TO MAIN REINFORCING..... 2 INCHES  
WALLS..... 3/4 INCHES

SLABS  
INTERIOR..... 3/4 INCHES  
EXTERIOR..... 1 INCH

REINFORCING STEEL WELDING

- REFERENCE STANDARDS: "ANSI/AWS D1.4 STRUCTURAL WELDING CODE - REINFORCING STEEL."
- MATERIALS: GRADE 60 (ASTM A706). ALL GRADE 60 WELDED REINFORCING BARS WILL BE REJECTED UNLESS A MILL CERTIFICATE IS SUBMITTED TO THE ENGINEER OF RECORD INDICATING COMPLIANCE WITH ASTM A706. USE ONLY CERTIFIED WELDERS. USE ONLY FRESH E70XX ELECTRODES (AWS A5.1 OR A5.5).
- BENDS IN WELDED REINFORCING STEEL ARE TO COMPLY WITH ACI STANDARDS. BENDS MUST NOT OCCUR WITHIN 3" OF ANY WELD. PROVIDE SPECIAL INSPECTION PER CBC.

EPOXY ADHESIVES - CONCRETE

- EPOXY ADHESIVE SHALL BE HILTI HIT HY 200 (ICC REPORT #ESR-3187) OR SIMPSON SET-X EQUAL (ICC REPORT #ESR-2508).
- INSTALLATION AND SPECIAL REQUIRED INSPECTION PER ICC REPORT.
- DO NOT DISTURB ROD BETWEEN SPECIFIED GEL TIME AND CURE TIME.
- CONTINUOUS SPECIAL INSPECTION OF INSTALLATION REQUIRED.

STRUCTURAL AND MISCELLANEOUS STEEL

FABRICATION AND ERECTION OF STEEL SHALL BE IN ACCORDANCE WITH THE FOLLOWING AMERICAN INSTITUTE OF STEEL CONSTRUCTION (AISC) STANDARDS AND SPECIFICATIONS:

- MANUAL OF STEEL CONSTRUCTION, 14TH EDITION
- CODE OF STANDARD PRACTICE FOR STEEL BUILDINGS AND BRIDGES, LATEST EDITION.
- SPECIFICATION FOR STRUCTURAL JOINTS USING ASTM A325 OR A490 BOLTS.

STEEL SHALL CONFORM TO THE FOLLOWING STANDARDS:

TUBE COLUMNS - ASTM A500, GRADE B (F<sub>y</sub> = 46,000 PSI)  
WIDE FLANGE COLUMNS AND BEAMS - ASTM A992, GR50  
ALL OTHER STEEL - ASTM A36 (F<sub>y</sub> = 36,000 PSI)  
BOLTS - ASTM A325 - PRETENSION UNLESS NOTED OTHERWISE (STEEL-TO-STEEL CONNECTIONS)  
ASTM A307 (FASTENERS EMBEDDED IN MASONRY)

STRUCTURAL STEEL WELDING

- CONFORM TO THE AWS CODES D1.1 AND D1.3., AND USE ONLY CERTIFIED WELDERS.
- WELDS NOT SPECIFIED ARE TO BE 1/4" CONTINUOUS FILLET MINIMUM.
- USE DRY E70 ELECTRODES.
- ALL FIELD WELDING TO BE DONE BY AWS CERTIFIED WELDERS.

WELDED HEADED STUDS

- WELDED HEADED STUDS SHALL BE MADE FROM COLD DRAWN BAR STOCK CONFORMING TO THE REQUIREMENTS OF ASTM A108. MECHANICAL PROPERTIES SHALL BE IN ACCORDANCE WITH AWS D1.1, SECTION 7.
- STUDS SHALL BE MANUFACTURED BY NELSON (OR APPROVED EQUAL). EMBEDMENT ANCHORS SHALL BE NELSON HEADED ANCHORS WITH FLUXED ENDS (OR APPROVED EQUAL).
- STUDS SHALL BE AUTOMATICALLY END WELDED WITH SUITABLE STUD WELDING EQUIPMENT IN THE SHOP AT SPACINGS INDICATED ON THE DRAWINGS. ALL WELDS SHALL BE MADE IN ACCORDANCE WITH RECOMMENDATIONS OF THE MANUFACTURER AND AWS D1.1 SECTION 7.

STEEL DECK AND CONNECTIONS

DECK SHALL APPLY TO THE FOLLOWING CODES AND STANDARDS:

- AISI "SPECIFICATIONS FOR THE DESIGN OF COLD-FORMED STEEL STRUCTURAL MEMBERS"
- AWS D1.3-89 "SPECIFICATIONS FOR WELDING SHEET STEEL IN STRUCTURES"
- ASTM AS DESIGNATED
- EVALUATION REPORT ER-0217 (IAPMO)

DECK INSTALLATION:

- POSITION ON SUPPORTING STEEL FRAMEWORK AND ADJUST TO FINAL POSITION WITH ENDS BEARING MINIMUM OF 2 INCHES ON SUPPORTING MEMBERS.
- PLACE UNITS END-TO-END BEFORE PERMANENTLY FASTENING.
- ALIGN RIBS OVER ENTIRE LENGTH

SHOP DRAWINGS

SUBMIT TWO SETS OF PRINTS AND ONE SET OF REPRODUCIBLES FOR REVIEW PRIOR TO FABRICATION FOR THE FOLLOWING:

- STRUCTURAL AND MISCELLANEOUS STEEL (EMBEDS, BOLLARDS, LADDERS, ETC.)
- CONCRETE REINFORCEMENT
- PRE-ENGINEERED METAL BUILDING DRAWINGS AND CALCULATIONS

SUBMITTALS

SUBMIT FOR REVIEW PRIOR TO INSTALLATION/FABRICATION FOR:  
A) CONCRETE INSERTS  
B) EPOXY ADHESIVES

SPECIAL INSPECTIONS

- THE SPECIAL INSPECTOR/QC SPECIALIST FOR ALL WORK OUTLINED IN THE CALIFORNIA BUILDING CODE SECTION 1704 SHALL BE A QUALIFIED PERSON WHO SHALL DEMONSTRATE HIS COMPETENCE TO THE SATISFACTION OF THE BUILDING OFFICIAL FOR INSPECTION OF THE PARTICULAR TYPE OF CONSTRUCTION OR OPERATION REQUIRING SPECIAL INSPECTION, AND SHALL BE CHARGED WITH THE DUTIES AND RESPONSIBILITIES AS OUTLINED IN CBC 1704.
- THE OWNER, CONTRACTOR, SPECIAL INSPECTOR OR INSPECTION AGENCY AND PROJECT ENGINEER AND/OR ARCHITECT SHALL COMPLETE THE SPECIAL INSPECTION AND TESTING AGREEMENT TO THE SATISFACTION OF THE GOVERNING BUILDING DEPARTMENT.
- THE SPECIAL INSPECTOR SHALL BE RESPONSIBLE FOR COMPLETING, MAINTAINING AND RESUBMITTING ALL SPECIAL INSPECTION LOGS AND FORMS AS REQUIRED BY THE BUILDING DEPARTMENT. ALL LOGS AND REPORTS ARE TO BE COMPLETED WITHIN ONE WEEK OF INSPECTIONS PERFORMED.
- CONTRACTOR RESPONSIBILITY: EACH CONTRACTOR OR SUB-CONTRACTOR RESPONSIBLE FOR THE CONSTRUCTION ITEMS OF THE WIND AND/OR SEISMIC RESISTING SYSTEM THAT ARE LISTED IN THE TABLE BELOW SHALL SUBMIT A WRITTEN STATEMENT OF RESPONSIBILITY TO THE BUILDING OFFICIAL AND THE OWNER PRIOR TO THE COMMENCEMENT OF WORK REQUIRING SPECIAL INSPECTION. THE CONTRACTOR'S STATEMENT OF RESPONSIBILITY SHALL CONTAIN THE FOLLOWING:
  - ACKNOWLEDGEMENT OF AWARENESS OF THE SPECIAL REQUIREMENTS CONTAINED IN THE SPECIAL INSPECTIONS TABLE BELOW.
  - ACKNOWLEDGEMENT THAT CONTROL WILL BE EXERCISED TO OBTAIN CONFORMANCE WITH THE CONSTRUCTION DOCUMENTS APPROVED BY THE BUILDING OFFICIAL.
  - PROCEDURES FOR EXERCISING CONTROL WITHIN THE CONTRACTOR'S ORGANIZATION, THE METHOD AND FREQUENCY OF REPORTING AND THE DISTRIBUTION OF THE REPORTS
  - IDENTIFICATION AND QUALIFICATIONS OF THE PERSON(S) EXERCISING SUCH CONTROL AND THEIR POSITION(S) IN THE ORGANIZATION.

GEOTECHNICAL

SPECIAL INSPECTION BY GEOTECHNICAL ENGINEER OF RECORD IS TO BE PROVIDED IN COMPLIANCE WITH CBC SECTION 1705.6 FOR THE FOLLOWING ITEMS AS APPLICABLE:

-SITE EXCAVATION, GRADING, BACKFILL, SUBGRADE PREPARATION  
-VERIFICATION OF SOIL BEARING CAPACITY  
-PLACEMENT OF STRUCTURAL FILL AND SOIL COMPACTION  
-PLACEMENT AND COMPACTION OF FOUNDATION AND RETAINING WALL BACKFILL

VERIFICATION AND INSPECTION	TYPE OF INSPECTION	CBC REFERENCE
TAKE CONCRETE CYLINDERS AS REQUIRED. VERIFY SLUMP, STRENGTH, AIR CONTENT, PLACEMENT, AND TEMP.	CONTINUOUS	TABLE 1704.4 ITEMS 4, 5, AND 6
INSPECTION OF REINFORCING STEEL AT CONCRETE CONSTRUCTION, INCLUDING PLACEMENT OF REINFORCING STEEL FOR COVER, SIZE, LOCATION AND GRADE	PERIODIC	TABLE 1704.4 ITEM 1
INSPECTION OF CONCRETE FOR PROPER PLACEMENT TECHNIQUES	CONTINUOUS	SECTIONS 1905.9, 1905.10, 1914.7, AND 1914.8
FABRICATION AND ERECTION OF STRUCTURAL STEEL	PERIODIC	AISC 360-10, SECT. N5.7
WELDING OF STRUCTURAL STEEL FOR SINGLE PASS FILLET WELDS < 5/16", AND FLOOR/ROOF DECK WELDS	PERIODIC	AISC 360-10, SECT. N5.4 AISC 341-10, SECT. J6
HIGH STRENGTH BOLTING (PRETENSIONED)	PERIODIC	AISC 360-10, SECT. N5.6 AISC 341-10, SECT. J7
COLD-FORMED STEEL DECK	PERIODIC	CBC TABLE 1705.2.2 ITEM 1
EPOXY ANCHORS	CONT.	CBC TABLE 1705.3 ITEM 4 ICC ESR-3187


ABBREVIATIONS

AB	ANCHOR BOLT	FND	FOUNDATION	OSF	OUTSIDE FACE
ALT	ALTERNATE	FG	FINISHED GRADE	PEMB	PRE-ENGINEERED METAL BLDG.
APPROX	APPROXIMATE	FLFR	FLUSH FRAMED	PSF	POUNDS PER SQUARE FOOT
BTM/BOT	BOTTOM	FLG	FLANGE	PSI	POUNDS PER SQUARE INCH
BRG	BEARING	FLR	FLOOR	R	RADIUS
BTW	BETWEEN	FP	FULL PENETRATION	REF	REFERENCE
B/T	BETWEEN	FT	FOOT	REINF	REINFORCEMENT
CJ	CONTROL JOINT	FTG	FOOTING	REQD	REQUIRED
CLR	CLEAR	FS	FAR SIDE	S	SLOPE
CMU	CONCRETE MASONRY UNIT	GA	GAUGE	SCH'D	SCHEDULED
COL	COLUMN	GALV	GALVANIZED	SEC	SECTION
CONC	CONCRETE	GR	GRADE	SF	SQUARE FOOT
CONN	CONNECTION	HDG	HOT-DIPPED GALV.	SHT	SHEET
CONST	CONSTRUCTION	HOR	HORIZONTAL	SIM	SIMILAR
CONT	CONTINUOUS	HT	HEIGHT	SPA	SPACE
CONTR	CONTRACTOR	HSS	HOLLOW STRUCT. SECTION	SPCS	SPACES
CTR	CENTER	IN	INCH	SPEC	SPECIFICATIONS
DCJ	DOWELED CONTROL JOINT	INT	INTERIOR	STND	STANDARD
DET	DETAIL	JT	JOINT	STL	STEEL
DIA	DIAMETER	LL	LIVE LOAD	STRUCT	STRUCTURAL
DIAG	DIAGONAL	LOC	LOCATION	T	TOP
DIM	DIMENSION	MAX	MAXIMUM	THK	THICK
DL	DEAD LOAD	MB	MACHINE BOLT	TOC	TOP OF CONCRETE
EA	EACH	MECH	MECHANICAL	TOD	TOP OF DECK
EF	EACH FACE	MFR/MNF	MANUFACTURER	TOS	TOP OF STEEL
ELEV	ELEVATION	MIN	MINIMUM	TOW	TOP OF WALL
EOR	ENGINEER OF RECORD	MISC	MISCELLANEOUS	TYP	TYPICAL
EQ	EQUAL	NO	NO	UNLESS NOTED OTHERWISE	
EQUIP	EQUIPMENT	NS	NEAR SIDE		
ES	EACH SIDE	NTS	NOT-TO-SCALE		
EW	EACH WAY	OC	ON-CENTER		
EXIST	EXISTING	OH	OPPOSITE HAND		
EXT	EXTERIOR	OPNG	OPENING		

STRUCTURAL INDEX OF DRAWINGS.				
SHEET NUMBER	SHEET TITLE	ISSUE DATE	CURRENT REVISION	REVISION DATE
S1.0	GENERAL NOTES	9/17/2021		
S2.0A	FOUNDATION PLAN	9/17/2021		
S2.1	CONTROL JOINT PLAN	9/17/2021	2	11/17/2021
S3.0	SECTIONS AND DETAILS	9/17/2021		
S3.1	FOUNDATION DETAILS	9/17/2021		
S3.2	LOADING DOCK DETAILS	9/17/2021		



WHSE  
[PARTNERS]

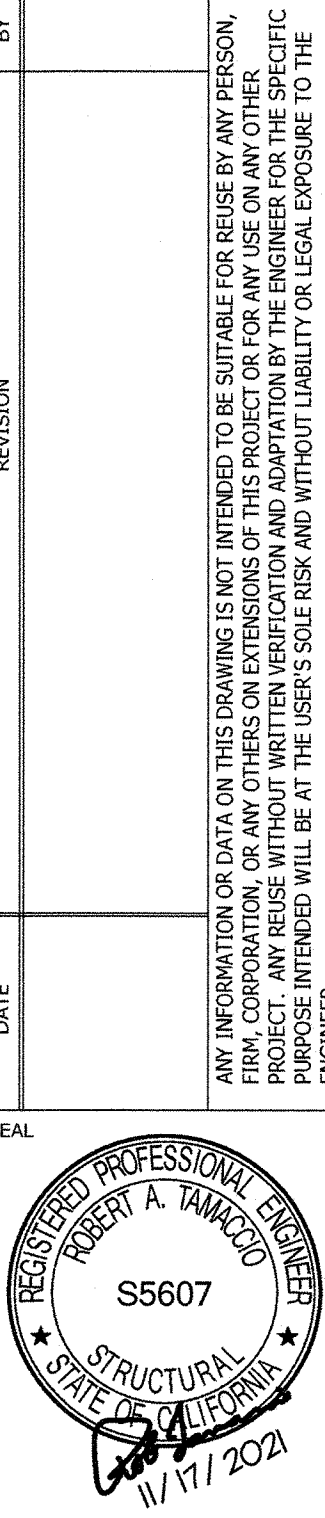


GENERAL NOTES  
FOR  
LEASE FLEX. / WAREHOUSE BUILDINGS  
MADERA INDUSTRIAL WHSE, LLC  
S. SCHNOOR AVENUE, MADERA, CA


JOB NUMBER  
21107  
DESIGNED BY  
RT  
DRAWN BY  
LM  
DATE  
9/17/2021  
SHEET NUMBER

S1.0



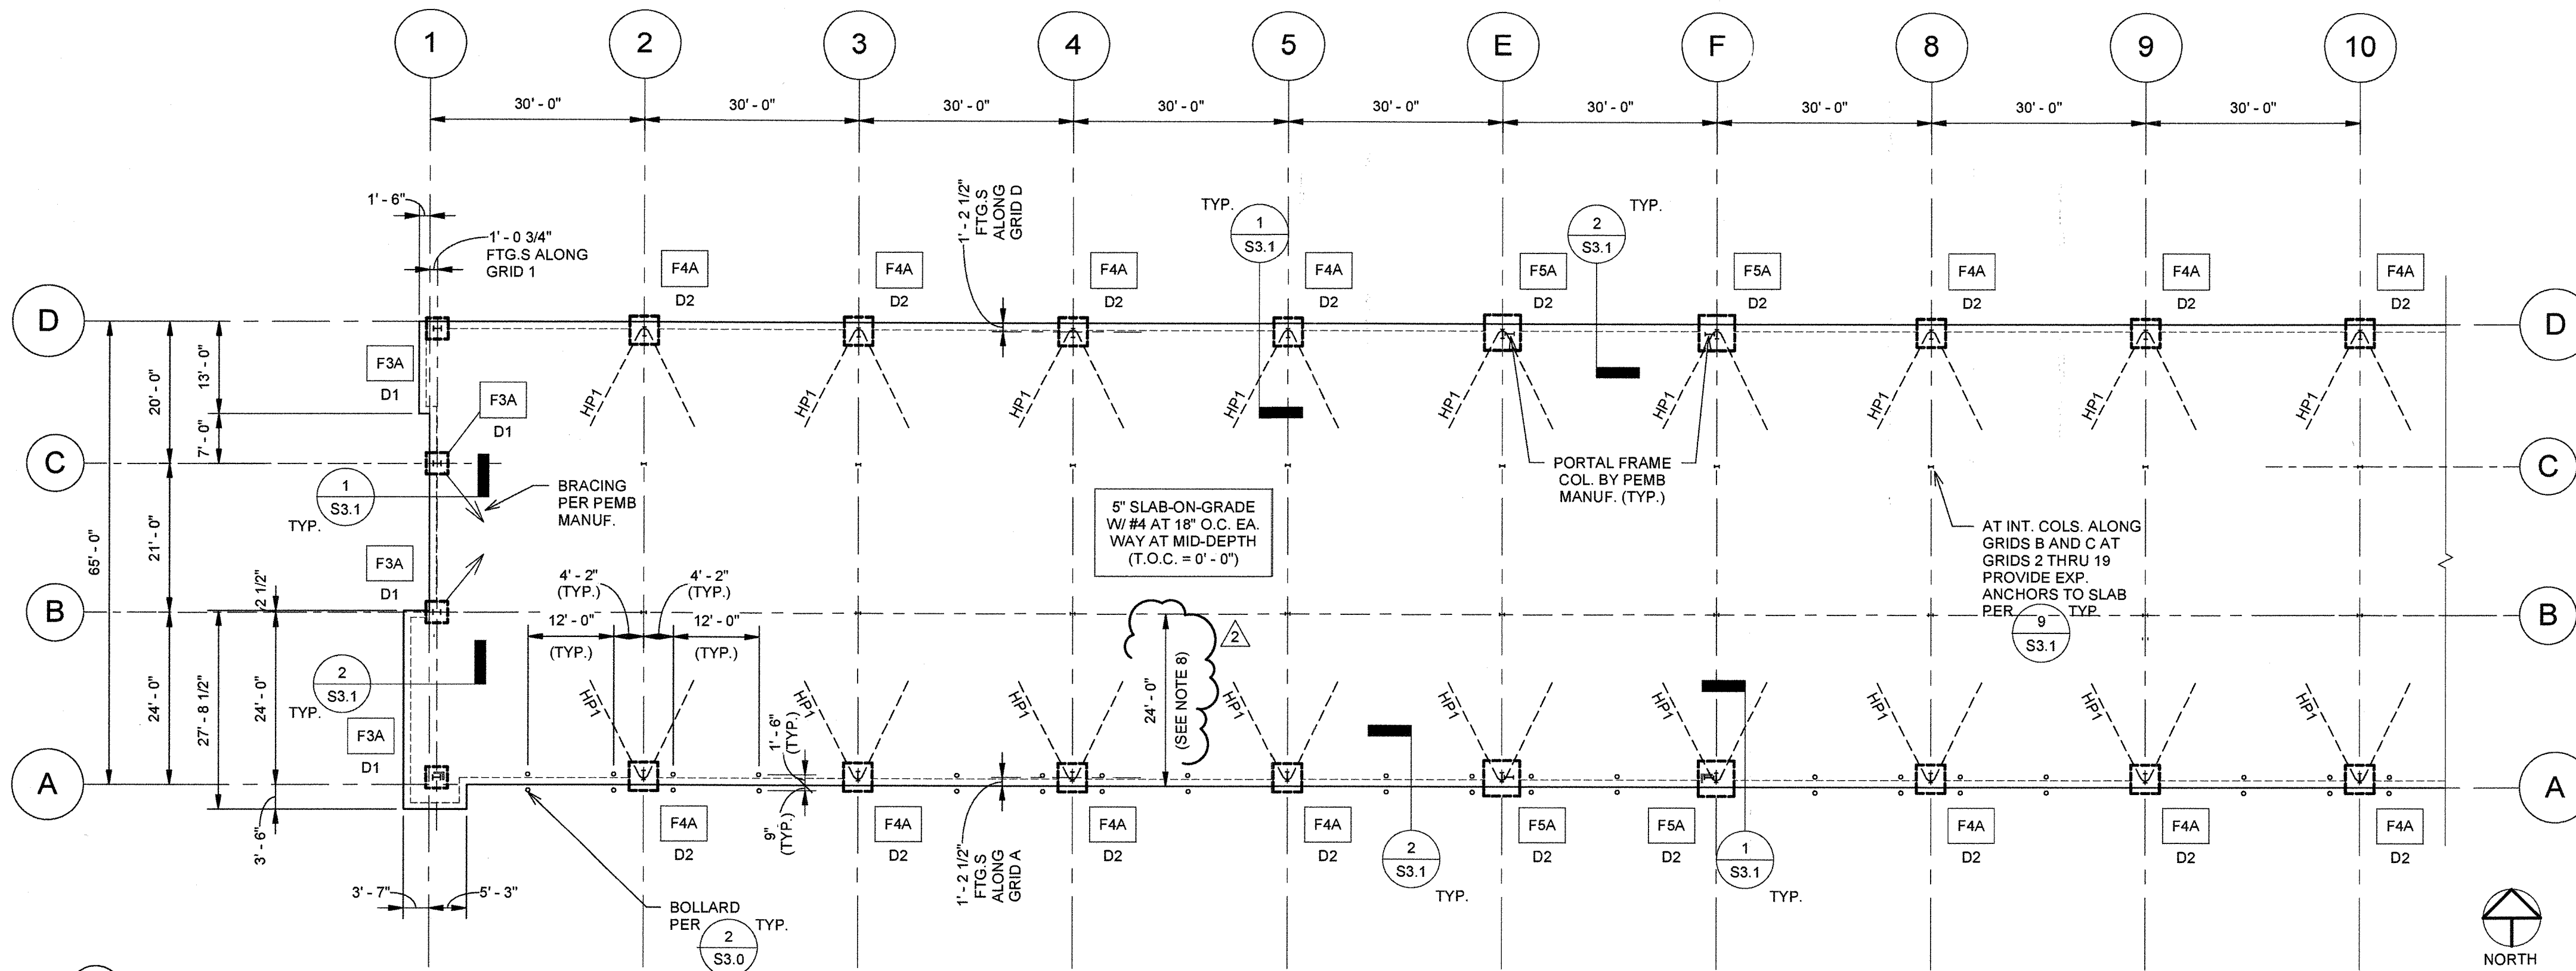

1 FOUNDATION PLAN - BLDG. A (WEST)  
S2.0A 1/16" = 1'-0"

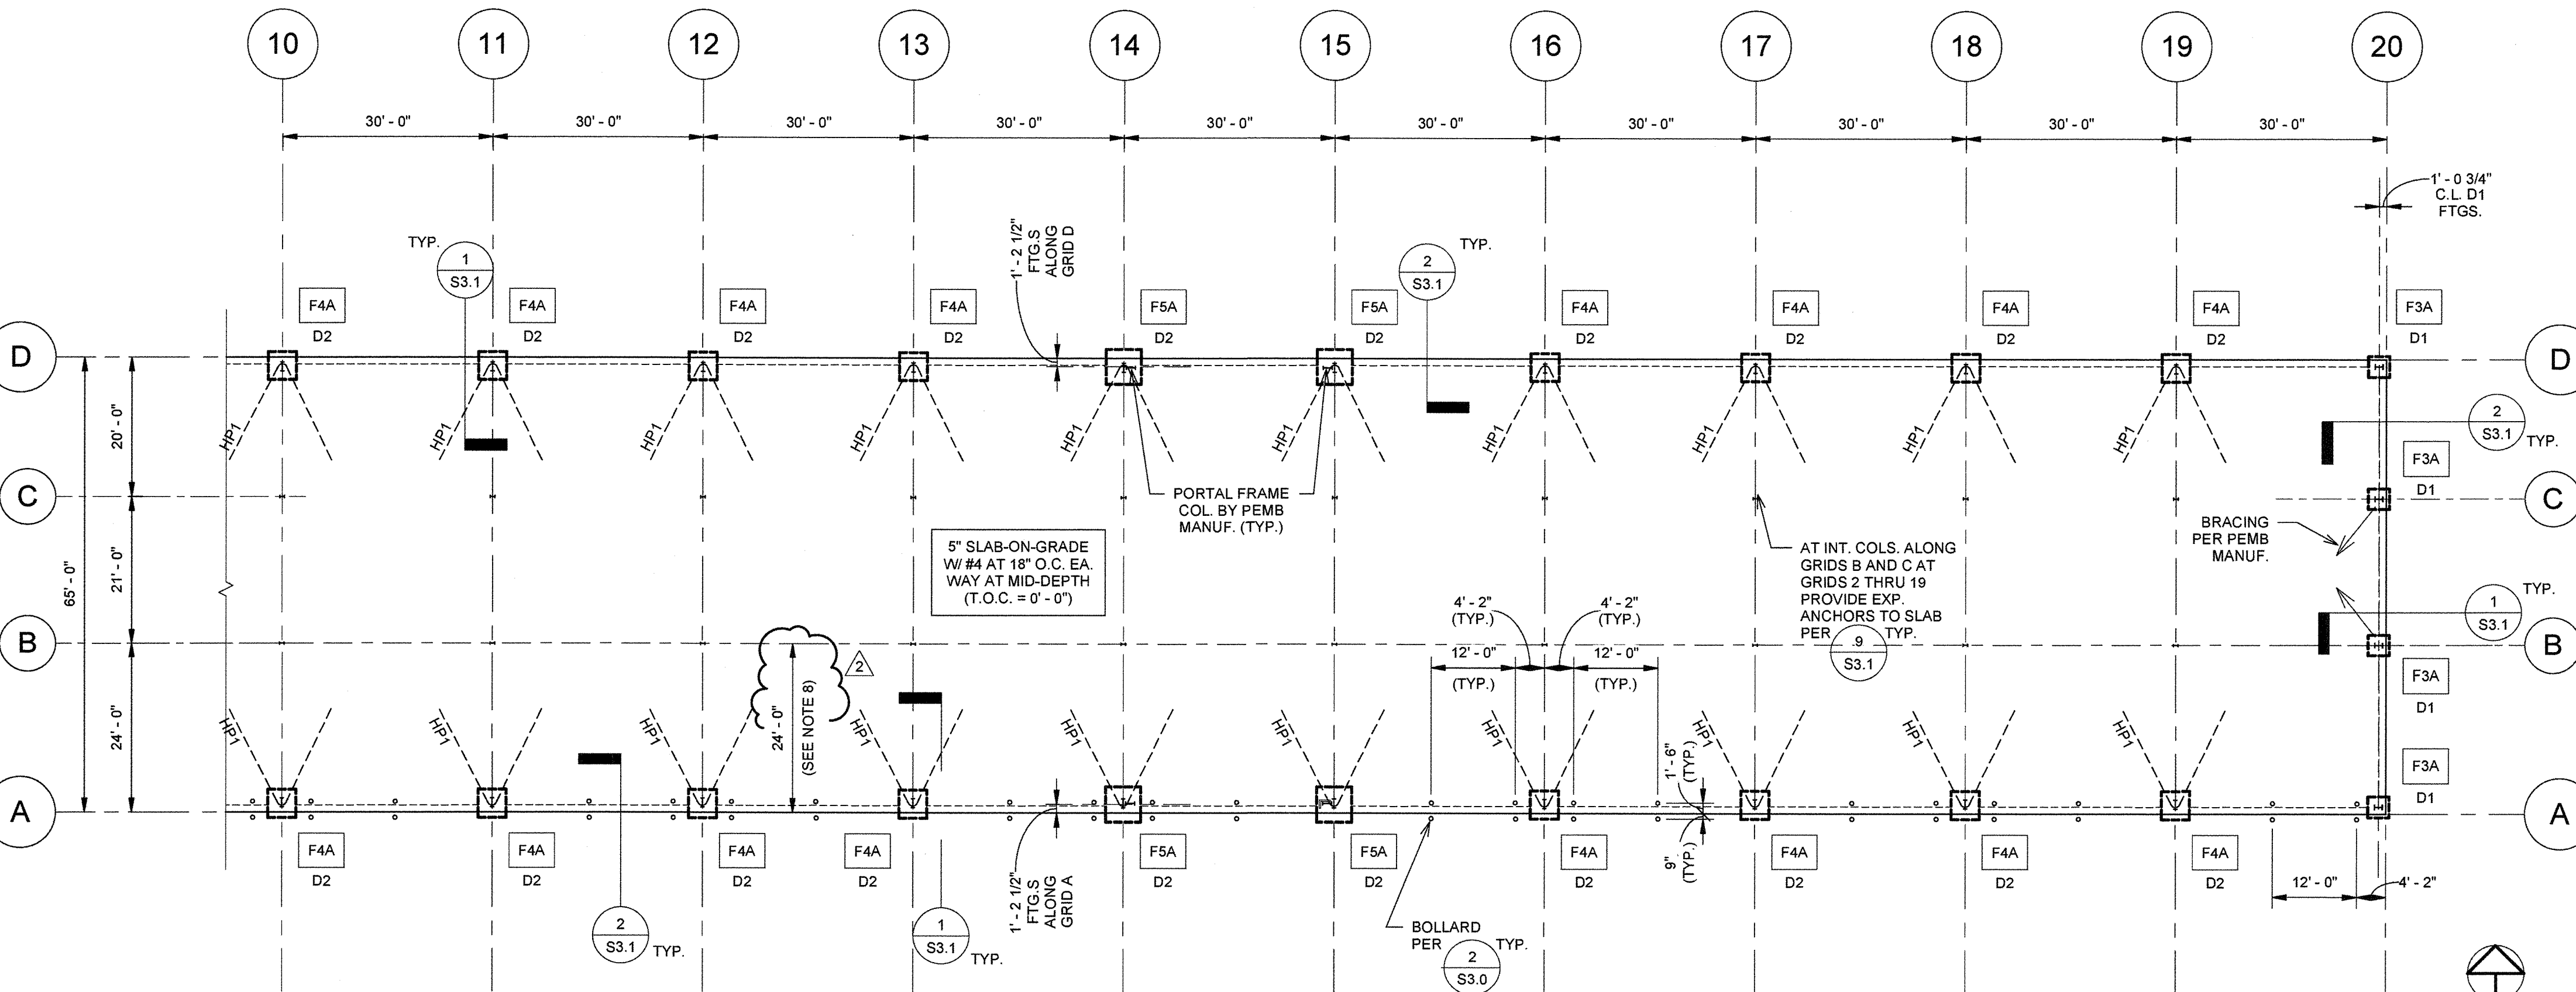

2 FOUNDATION PLAN - BLDG. A (EAST)  
S2.0A 1/16" = 1'-0"

# FOUNDATION PLAN NOTES:

- FIELD VERIFY ALL DIMENSIONS WITH EXISTING BEFORE STARTING CONSTRUCTION.
- COORDINATE SLAB PLACEMENT LOCATIONS AND PHASES WITH DBKO DESIGN+BUILD. SEE SHEET S2.2 FOR CONTROL JOINT LAYOUT. SUBMIT ALTERNATE LAYOUTS FOR APPROVAL.
- FOR SLAB-ON-GRADE SUBGRADE PREPARATION, SEE DETAIL 1 S3.0
- HP# - DENOTES HAIRPIN PER SCHED. SEE 6 S3.0
- FX DENOTES FOOTING PER SCHED.  
DX DENOTES ANCHOR BOLT SIZE AND CONFIGURATION PER PEMB DRWGS. AND EMBEDMENT PER FTG. SCHED. THIS SHEET AND APPLICABLE DETAILS  
USE F1554, GR. 36 THREADED RODS W/ HEAVY HEX NUTS AND WASHERS AS SHOWN IN DETAILS.
- AT DOOR JAMB ANCHORS, PROVIDE 1/2" Ø KWIK BOLT TZ ANCHORS PER ICC ESR-1917 W/ MIN. HOLE DEPTH OF 2'-5/8" (1/2" Ø DRILL BIT).
- TOP ELEV. THIS SIDE OF LINE DENOTES STEP FOOTING PER 5 S3.0  
TOP ELEV. THIS SIDE OF LINE
- PROVIDE 15 MIL VAPOR BARRIER BETWEEN GRIDS A AND B FOR THE FULL LENGTH OF THE BUILDING.



WHSE  
[PARTNERS]

BY	REVISION
DATE	2 PLAN CHECK RESPONSE
11/17/2021	
DATE	
11/17/2021	
DATE	
11/17/2021	



FOUNDATION PLAN  
LEASE FLEX. / WAREHOUSE BUILDINGS  
FOR  
MADERA INDUSTRIAL WHSE, LLC  
S. SCHNOOR AVENUE, MADERA, CA

2019CBC  
City of Madera  
Building Department  
The approval of these plans does not prevent the City of Madera from requiring correction of errors or omissions in the plans, specifications, construction, or materials. Subject to field inspection and approval of the City Engineer.  
APPROVED  
By: [Signature]  
Date: MAR 03 2022


## FOOTING SCHEDULE

MARK	QUANTITY	WIDTH	LENGTH	THICKNESS	TOP OF FTG. ELEV.*	BOT. OF FTG. ELEV.*	REINFORCEMENT	MIN. ANCHOR EMBED.
F3A	8	3'-0"	3'-0"	18"	-8"	-2'-2"	(3) #4 EA WAY (TOP) (4) #5 EA WAY (BOT.)	8"
F4A	28	4'-0"	4'-0"	18"	-8"	-2'-2"	(3) #4 EA WAY (TOP) (5) #5 EA WAY (BOT.)	8"
F5A	8	5'-0"	5'-0"	18"	-8"	-2'-2"	(3) #4 EA WAY (TOP) (6) #5 EA WAY (BOT.)	12"


\*NOTE - FOOTING ELEVATIONS RELATIVE TO FIN. FLR. = 0' - 0" (EL. 258.30 PER CIVIL)

S2.0A



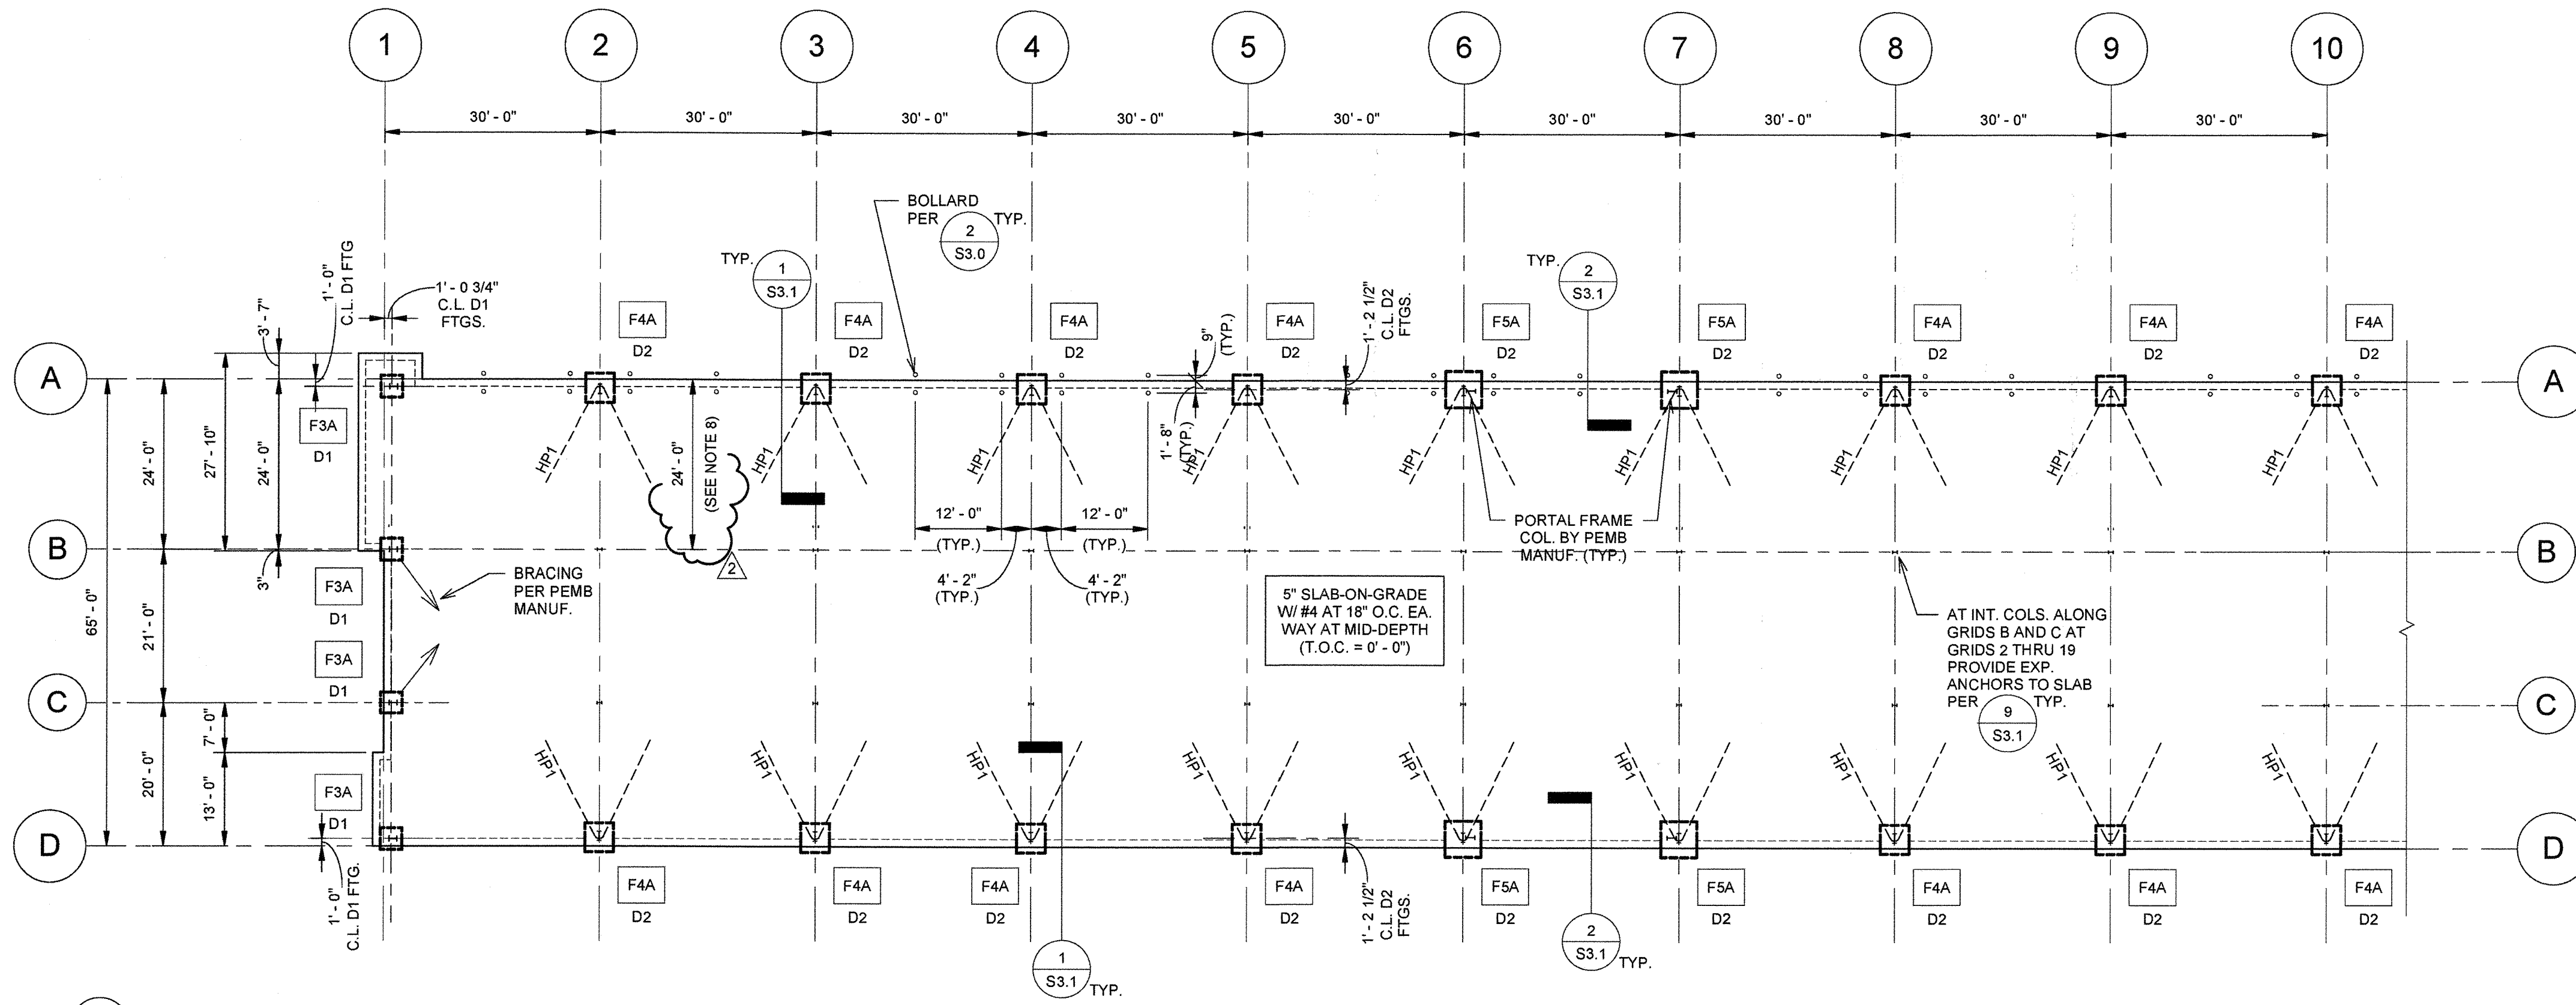

1 FOUNDATION PLAN - BLDG. B (WEST)  
1/16" = 1'-0"

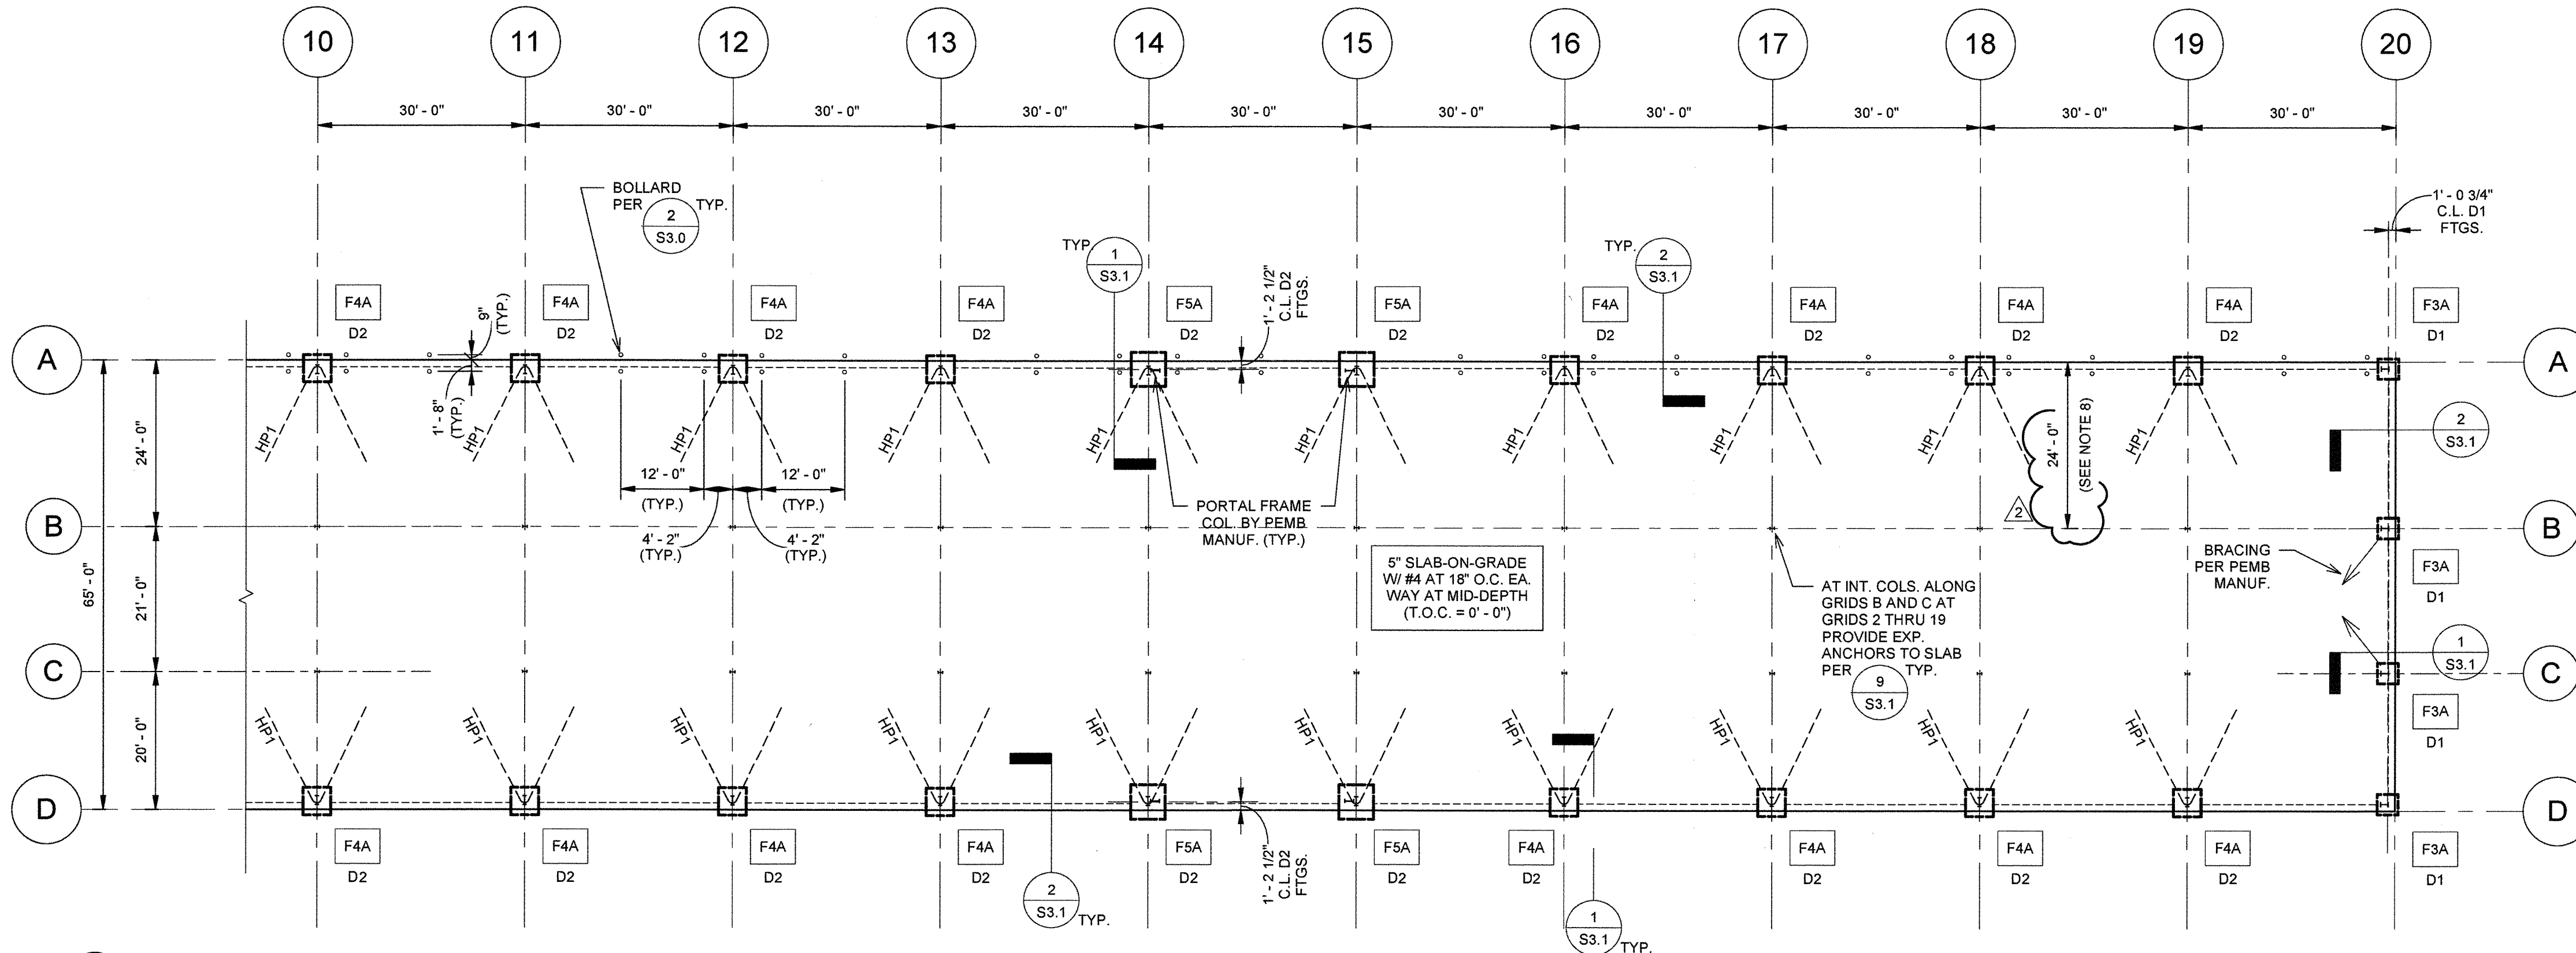

2 FOUNDATION PLAN - BLDG. B (EAST)  
1/16" = 1'-0"

FOUNDATION PLAN NOTES:

- FIELD VERIFY ALL DIMENSIONS WITH EXISTING BEFORE STARTING CONSTRUCTION.
- COORDINATE SLAB PLACEMENT LOCATIONS AND PHASES WITH DBKO DESIGN+BUILD. SEE SHEET S2.2 FOR CONTROL JOINT LAYOUT. SUBMIT ALTERNATE LAYOUTS FOR APPROVAL.
- FOR SLAB-ON-GRADE SUBGRADE PREPARATION, SEE DETAIL 1 S3.0
- HP# - DENOTES HAIRPIN PER SCHED. SEE 6 S3.0
- FX DENOTES FOOTING PER SCHED.  
DX DENOTES ANCHOR BOLT SIZE AND CONFIGURATION PER PEMB DRWS. AND EMBEDMENT PER FTG. SCHED. THIS SHEET AND APPLICABLE DETAILS  
USE F1554, GR. 36 THREADED RODS W/ HEAVY HEX NUTS AND WASHERS AS SHOWN IN DETAILS.
- AT DOOR JAMB ANCHORS, PROVIDE 1/2" Ø KWIK BOLT T.Z. ANCHORS PER ICC ESR-1917 W/ MIN. HOLE DEPTH OF 2'-5/8" (1/2" Ø DRILL BIT).
- TOF ELEV. THIS SIDE OF LINE DENOTES STEP FOOTING PER 5 S3.0  
TOF ELEV. THIS SIDE OF LINE
- PROVIDE MIN. 15 MIL VAPOR BARRIER BETWEEN GRIDS A AND B FOR THE FULL LENGTH OF THE BUILDING.

FOOTING SCHEDULE

MARK	QUANTITY	WIDTH	LENGTH	THICKNESS	TOP OF FTG. ELEV.*	BOT. OF FTG. ELEV.*	REINFORCEMENT	MIN. ANCHOR EMBED.
F3A	8	3'-0"	3'-0"	18"	-8"	-2'-2"	(3) #4 EA. WAY (TOP) (4) #5 EA. WAY (BOT.)	8"
F4A	28	4'-0"	4'-0"	18"	-8"	-2'-2"	(3) #4 EA. WAY (TOP) (5) #5 EA. WAY (BOT.)	8"
F5A	8	5'-0"	5'-0"	18"	-8"	-2'-2"	(3) #4 EA. WAY (TOP) (6) #5 EA. WAY (BOT.)	12"

\*NOTE - FOOTING ELEVATIONS RELATIVE TO FIN. FLR. = 0' - 0" (EL. 258.30 PER CIVIL)



WHSE  
[PARTNERS]

BY: [Signature]  
REVISION: 2 PLAN CHECK RESPONSE  
DATE: 11/17/2021  
SEAL: [Professional Engineer Seal - Robert A. Tawood, S5607, Structural, State of California, 11/17/2021]


FOUNDATION PLAN  
LEASE FLEX. / WAREHOUSE BUILDINGS  
FOR  
MADERA INDUSTRIAL WHSE, LLC  
S. SCHNOOR AVENUE, MADERA, CA

2019CIRC  
City of Madera  
Building Department  
The approval of these plans does not constitute a warranty of construction. The City of Madera is not responsible for errors or omissions in the plans, specifications or construction. Subject to field inspections and approvals, the City of Madera and Building Department approve these plans and specifications.  
APPROVED  
By: [Signature]  
Date: MAR 03 2022


JOB NUMBER: 21107  
DESIGNED BY: RT  
DRAWN BY: LM  
DATE: 9/17/2021  
SHEET NUMBER

S2.0B



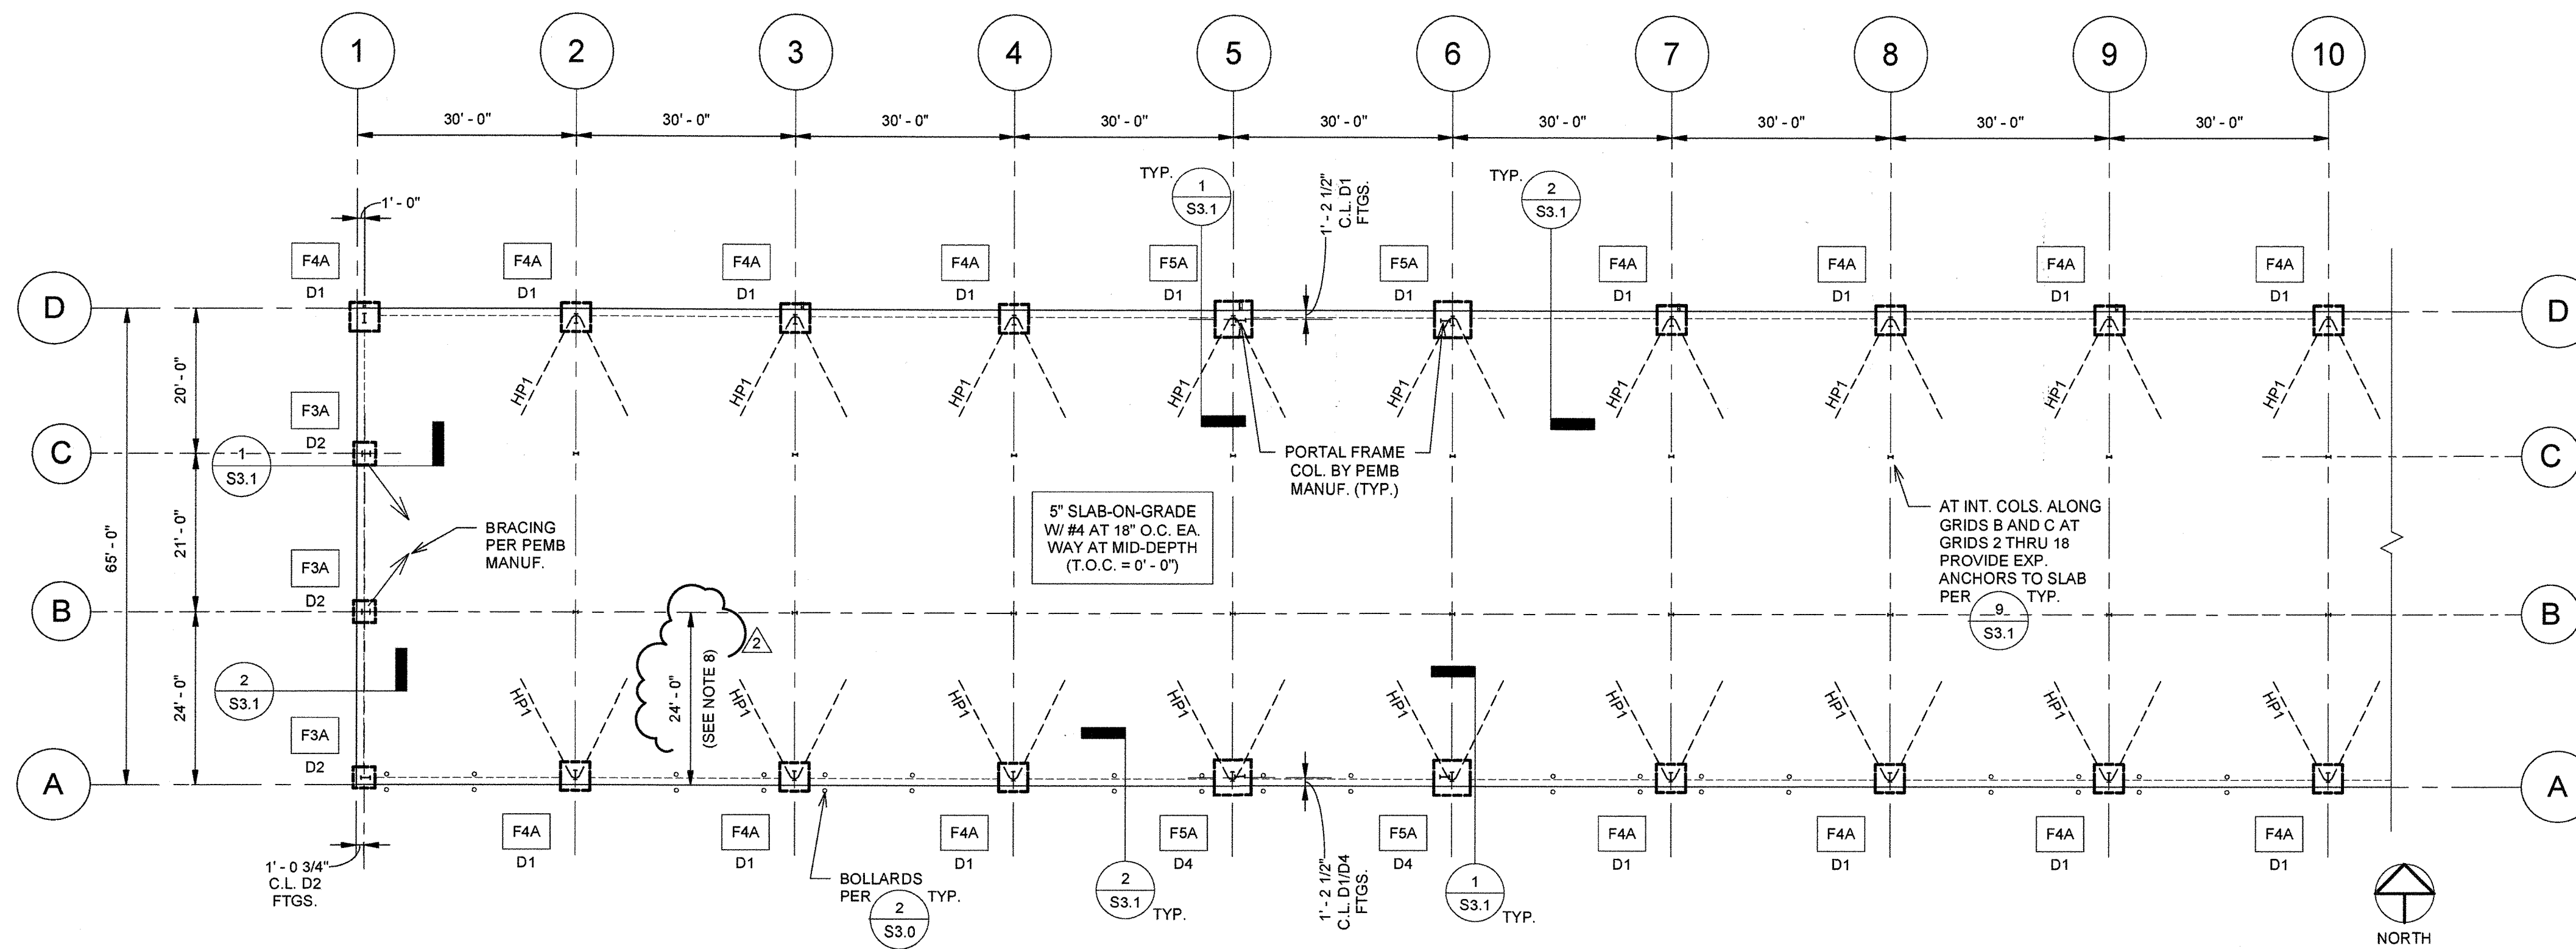

1 FOUNDATION PLAN - BLDG. C (WEST)  
S2.0C 1/16" = 1'-0"

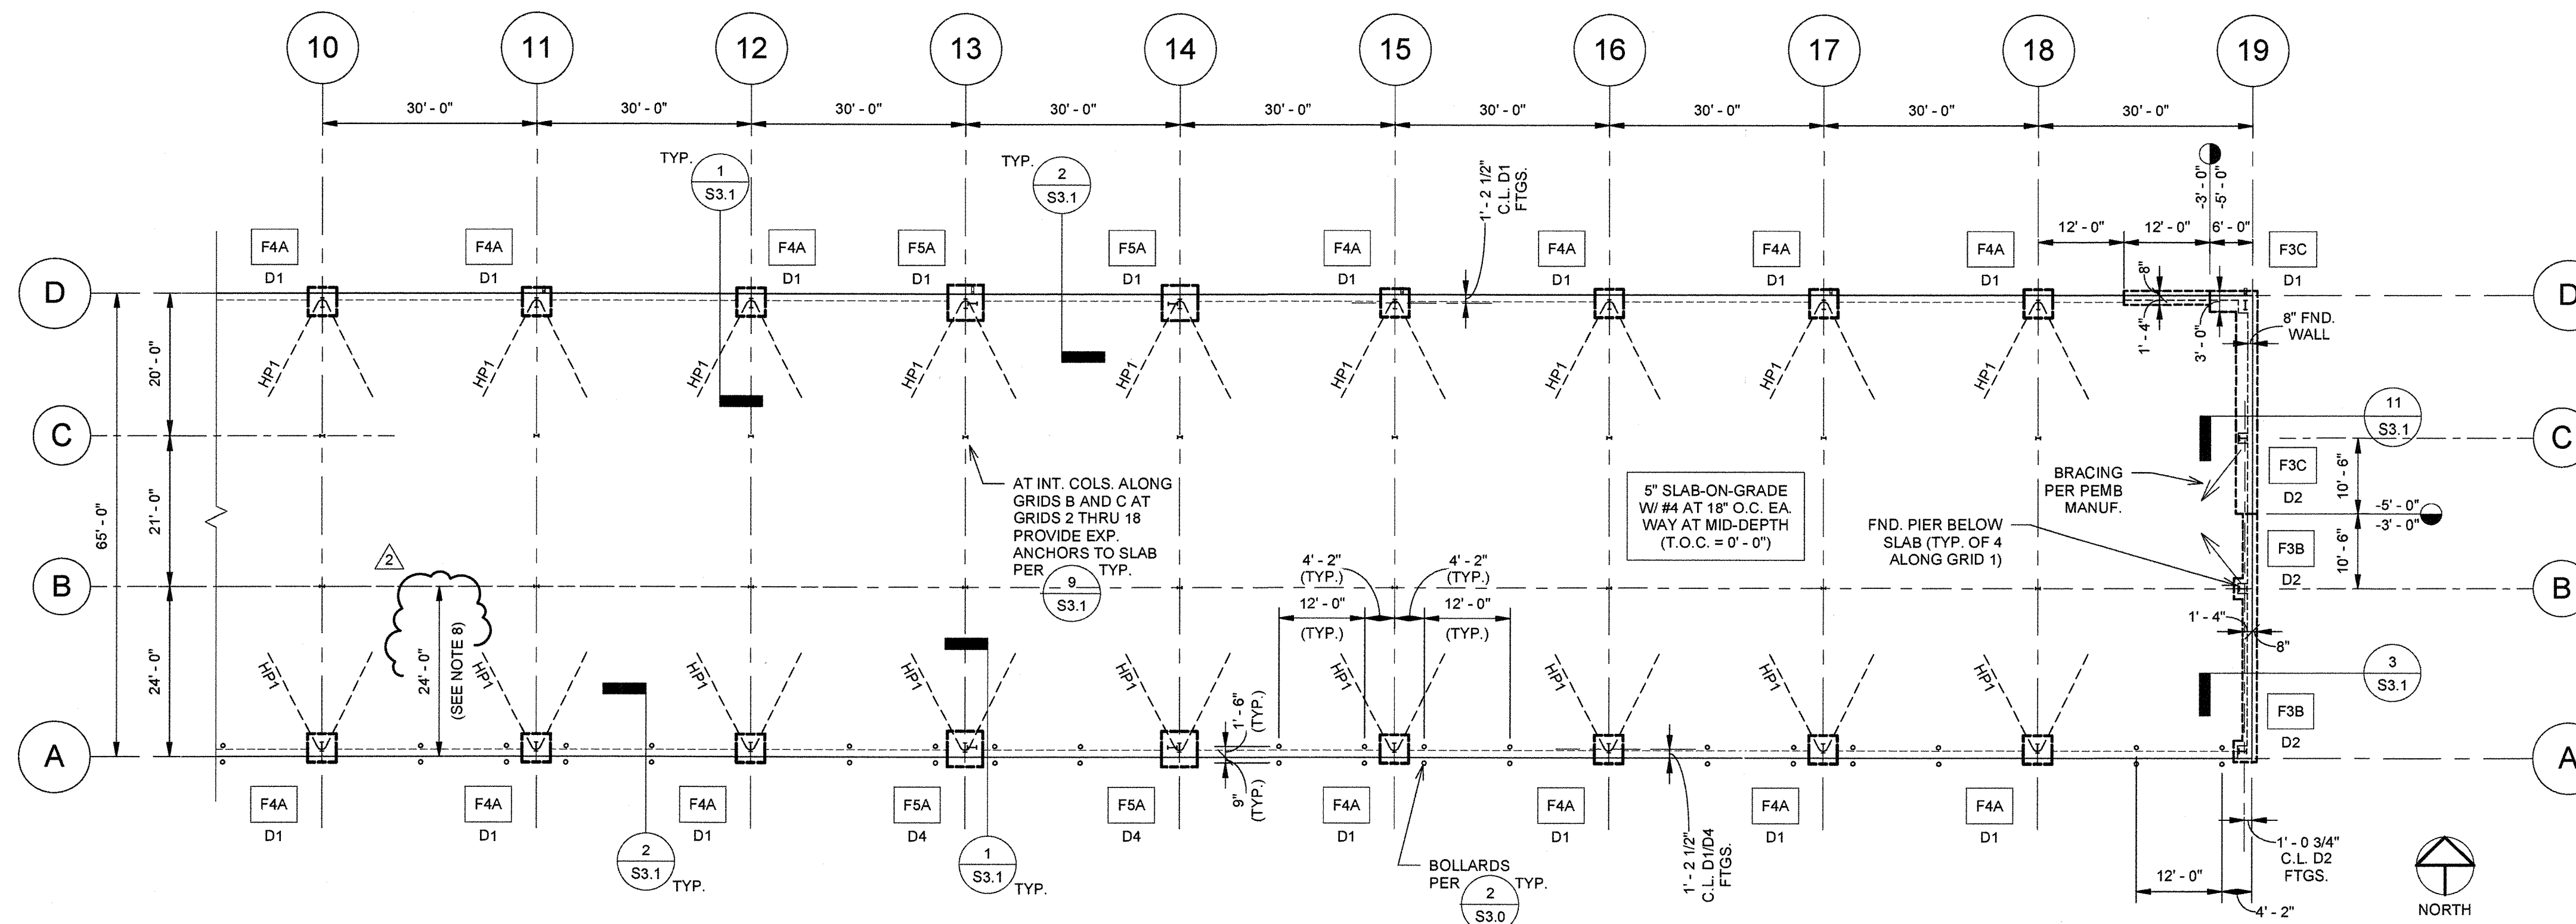

2 FOUNDATION PLAN - BLDG. C (EAST)  
S2.0C 1/16" = 1'-0"


#### FOUNDATION PLAN NOTES:

- FIELD VERIFY ALL DIMENSIONS WITH EXISTING BEFORE STARTING CONSTRUCTION.
- COORDINATE SLAB PLACEMENT LOCATIONS AND PHASES WITH DBKO DESIGN+BUILD. SEE SHEET S2.2 FOR CONTROL JOINT LAYOUT. SUBMIT ALTERNATE LAYOUTS FOR APPROVAL.
- FOR SLAB-ON-GRADE SUBGRADE PREPARATION, SEE DETAIL 1 S3.0
- HP# - DENOTES HAIRPIN PER SCHED. SEE 6 S3.0
- FX DENOTES FOOTING PER SCHED.  
DX DENOTES ANCHOR BOLT SIZE AND CONFIGURATION PER PEMB DRWGS. AND EMBEDMENT PER FTG. SCHED. THIS SHEET AND APPLICABLE DETAILS  
USE F1554, GR. 36 THREADED RODS W/ HEAVY HEX NUTS AND WASHERS AS SHOWN IN DETAILS.
- AT DOOR JAMB ANCHORS, PROVIDE 1/2" Ø KWIK BOLT TZ ANCHORS PER ICC ESR-1917 W/ MIN. HOLE DEPTH OF 2-5/8" (1/2" Ø DRILL BIT).
- DENOTES STEP FOOTING PER 5 S3.0  
TOP ELEV. THIS SIDE OF LINE  
TOP ELEV. THIS SIDE OF LINE
- PROVIDE MIN. 15 MIL VAPOR BARRIER BETWEEN GRIDS A AND B FOR THE FULL LENGTH OF THE BUILDING.


#### FOOTING SCHEDULE

MARK	QUANTITY	WIDTH	LENGTH	THICKNESS	TOP OF FTG. ELEV.*	BOT. OF FTG. ELEV.*	REINFORCEMENT	MIN. ANCHOR EMBED.
F3A	3	3'-0"	3'-0"	18"	-8"	-2'-2"	(3) #4 EA. WAY TOP (4) #5 EA. WAY (BOT.)	8"
F3B	2	3'-0"	3'-0"	16"	-3'-0"	-4'-4"	(3) #4 EA. WAY TOP (4) #5 EA. WAY (BOT.)	24"
F3C	2	3'-0"	3'-0"	16"	-5'-0"	-6'-4"	CONT. RETAINING WALL REINF.	24"
F4A	27	4'-0"	4'-0"	18"	-8"	-2'-2"	(3) #4 EA. WAY TOP (5) #5 EA. WAY (BOT.)	8"
F5A	8	5'-0"	5'-0"	18"	-8"	-2'-2"	(3) #4 EA. WAY TOP (6) #5 EA. WAY (BOT.)	12"


\*NOTE - FOOTING ELEVATIONS RELATIVE TO FIN. FLR. = 0' - 0" (EL. 258.30 PER CIVIL)

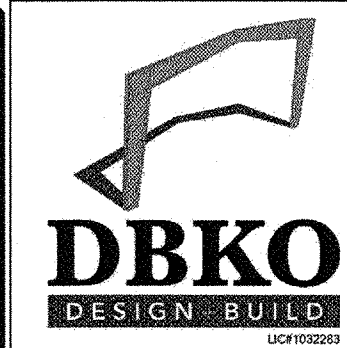

DATE	REVISION	BY
11/17/2021	2	PLAN CHECK RESPONSE


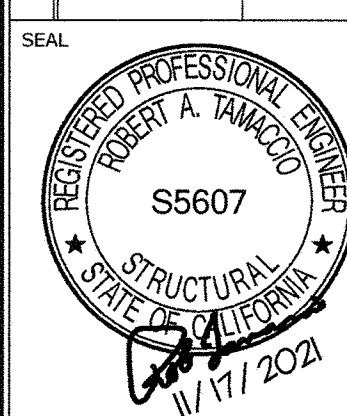


**FOUNDATION PLAN**  
FOR  
**LEASE FLEX. / WAREHOUSE BUILDINGS**  
**MADERA INDUSTRIAL WHSE, LLC**  
S. SCHNOOR AVENUE, MADERA, CA

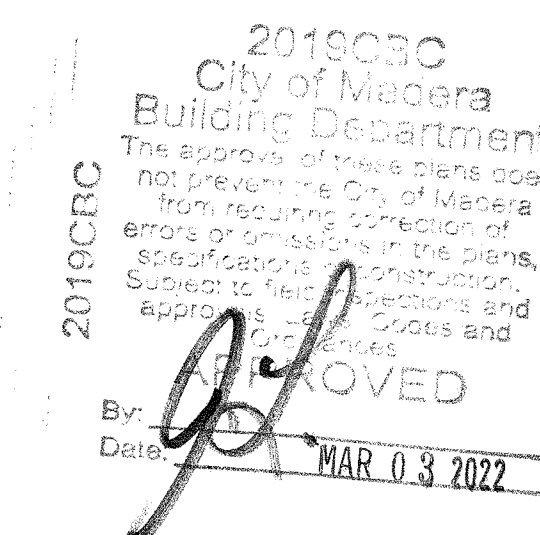



JOB NUMBER	21107
DESIGNED BY	RT
DRAWN BY	LM
DATE	9/17/2021
SHEET NUMBER	S2.0C



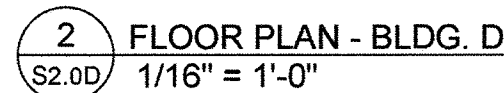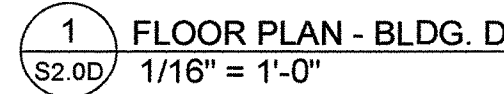

1. FIELD VERIFY ALL DIMENSIONS WITH EXISTING BEFORE STARTING CONSTRUCTION.
2. COORDINATE SLAB PLACEMENT LOCATIONS AND PHASES WITH DBKO DESIGN/CONTRACT. SEE SHEET S2.2 FOR CONTROL JOINT LAYOUT. SUBMIT ALTERNATE LAYOUTS FOR APPROVAL.
3. FOR SLAB-ON-GRADE SUBGRADE PREPARATION, SEE DETAIL
 

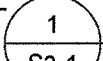
4. HP# - DENOTES HAIRPIN PER SCHED. SEE
 


5. AT LOADING DOCK, PROVIDE CONTROL JOINTS AT 10' MAX. SPACING W/ 1'-12" DEPTH SAW-CUTS. PROVIDE DBKO WITH SEPARATE PRICE TO CAULK JOINTS W/ SIKAFLEX 2C NS OR EQUAL.



MARK	QUANTITY	WIDTH	LENGTH	THICKNESS	TOP OF FTG. ELEV.*	BOT. OF FTG. ELEV*	REINFORCEMENT	MIN. ANCHOR EMBED.
F3A	3	3' - 0"	3' - 0"	18"	-8"	-2' - 2"	(3) #4 EA. WAY TOP (4) #5 EA. WAY (BOT.)	8"
F3B	2	3' - 0"	3' - 0"	16"	-3' - 0"	-4' - 4"	(3) #4 EA. WAY (TOP) (4) #5 EA. WAY (BOT.)	24"
F3C	2	3' - 0"	3' - 0"	16"	-5' - 0"	-6' - 4"	CONT. RETAINING WALL REINF.	24"
F4A	27	4' - 0"	4' - 0"	16"	-8"	-2' - 2"	(3) #4 EA. WAY TOP (5) #5 EA. WAY (BOT.)	8"
F5A	8	5' - 0"	5' - 0"	18"	-8"	-2' - 2"	(4) #4 EA. WAY (TOP) (4) #5 EA. WAY (BOT.)	12"


\*NOTE - FOOTING ELEVATIONS RELATIVE TO FIN. FLR. = 0' - 0" (EL. 258.30 PER CIVIL)



WEST END - BLDG. A  
(BLDG. B OPPOSITE HAND)

TYP. INT. BAY - BLDGS. A AND C  
(BLDG. B AND C OPPOSITE HAND)


TYP. END BAY - BLDGS. A AND C  
(BLDG. B AND C OPPOSITE HAND)

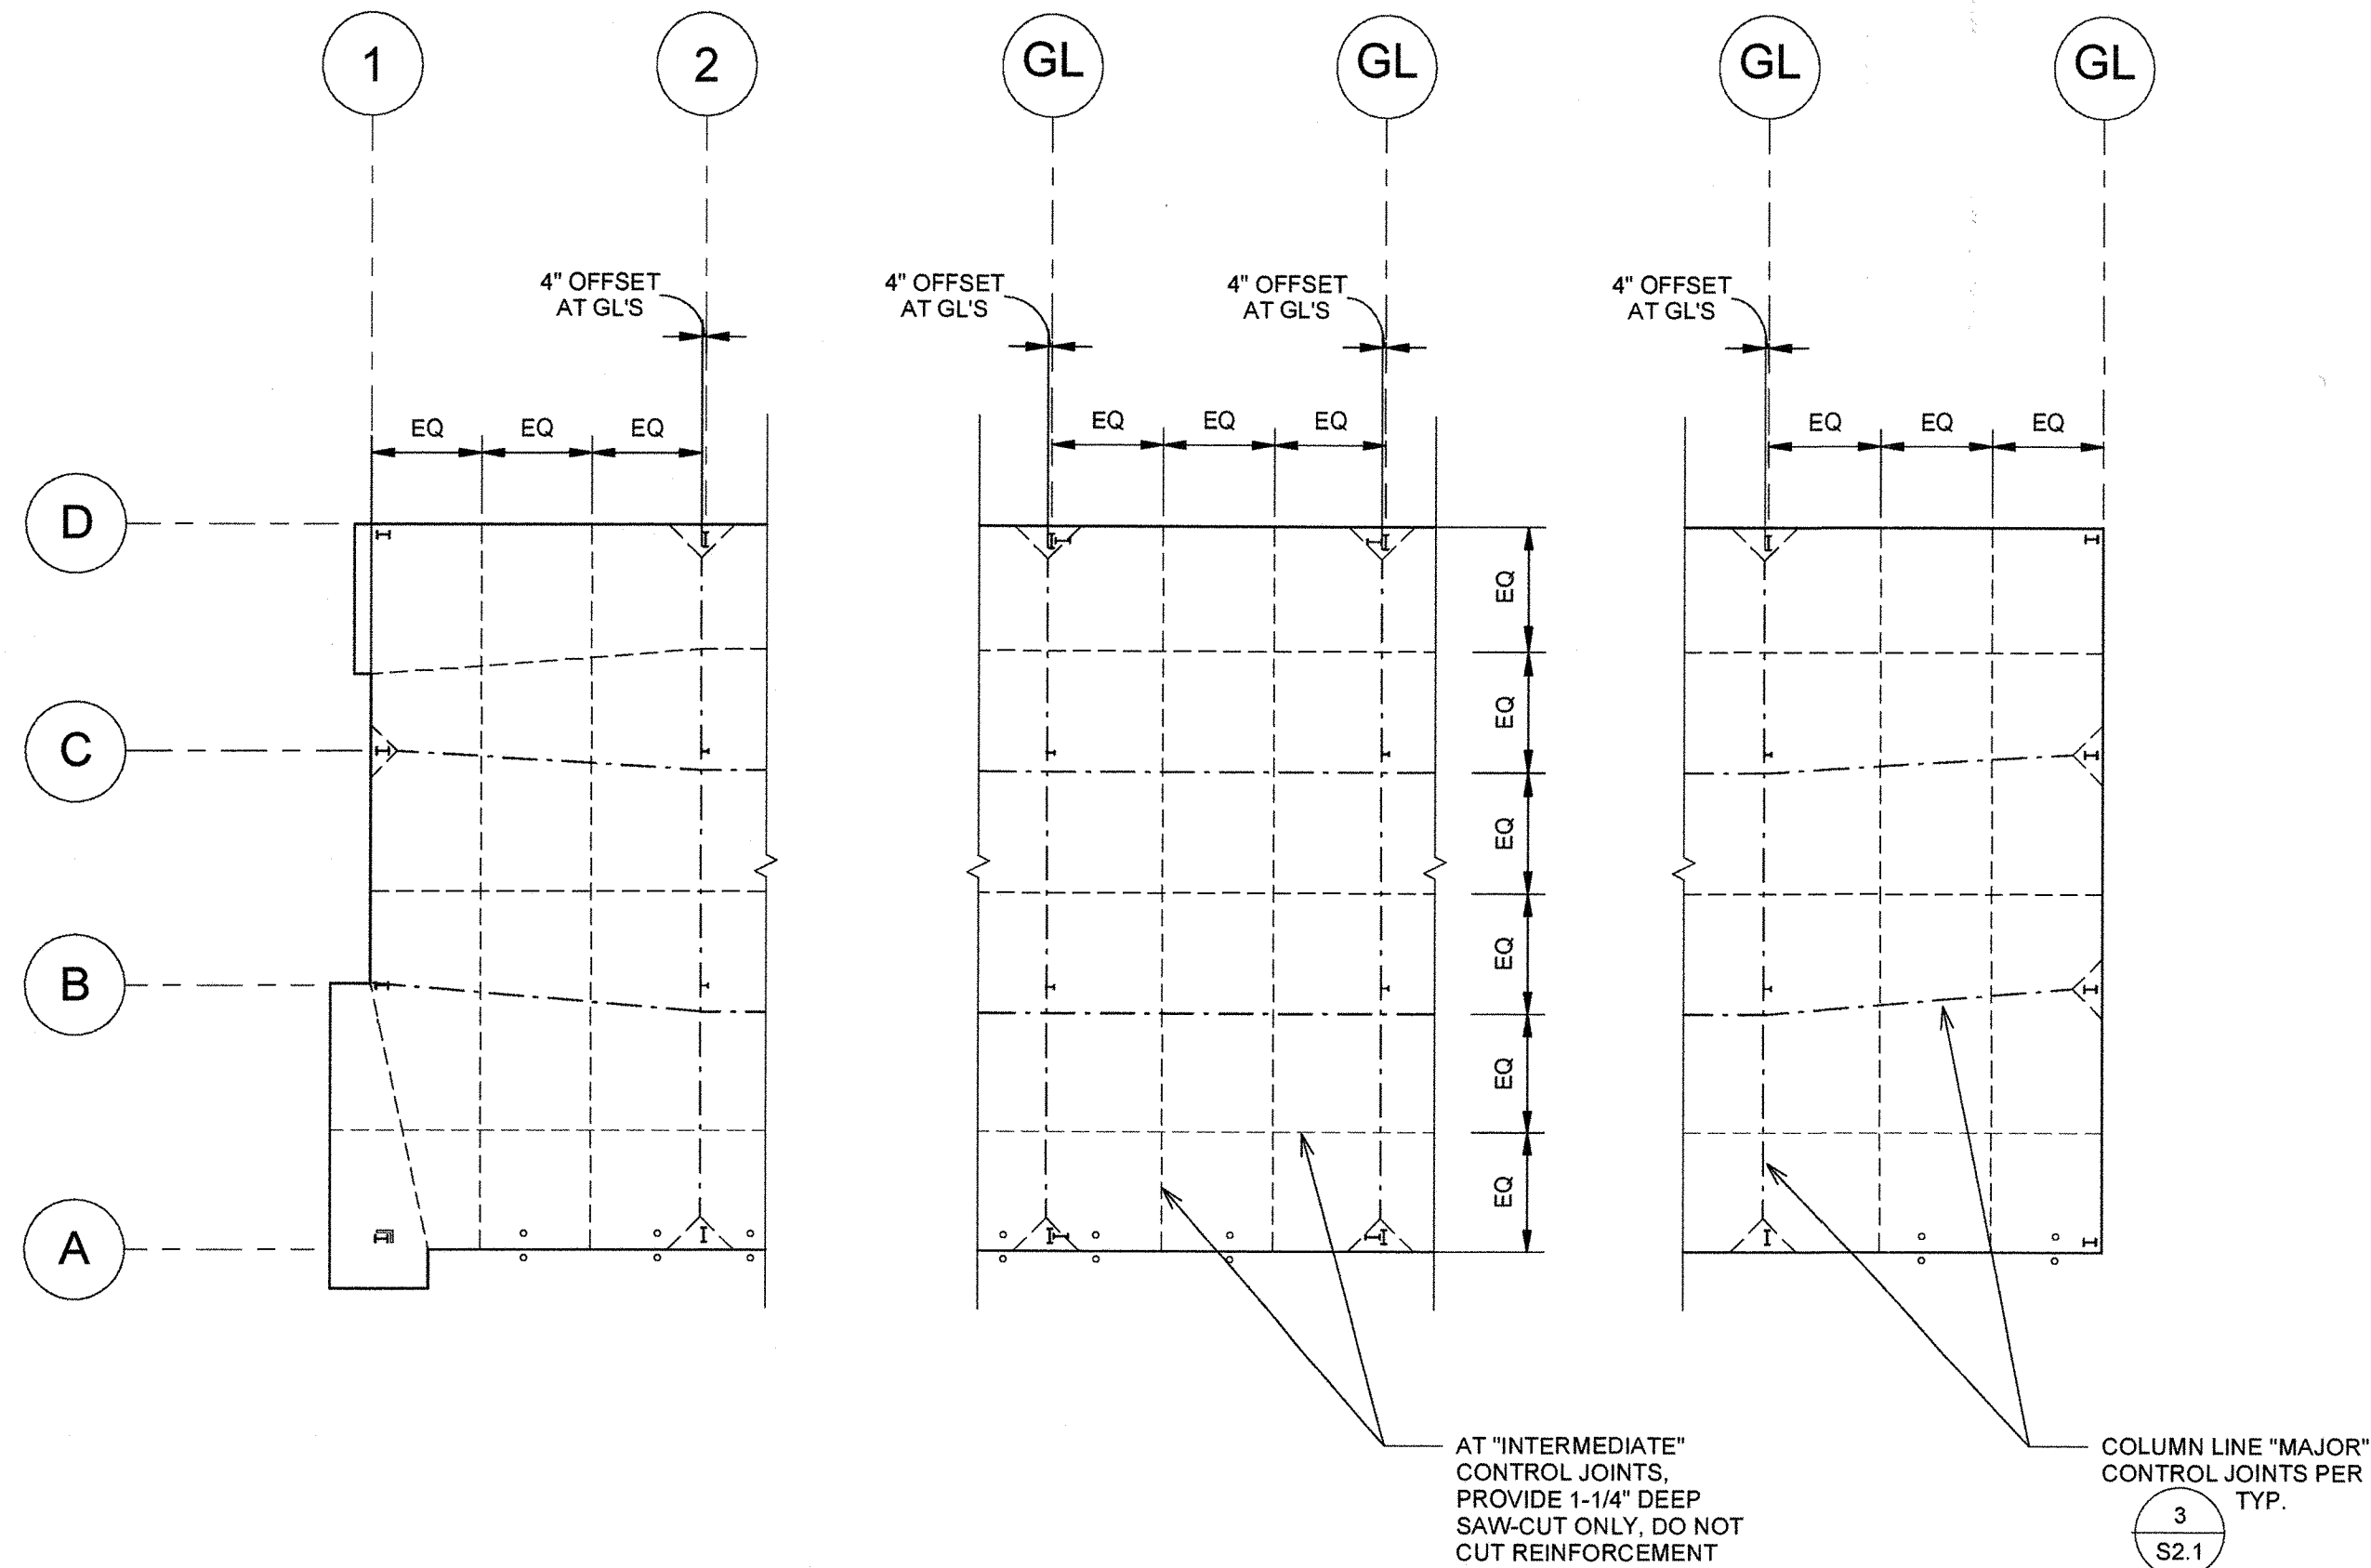

**CONTROL JOINT PLAN NOTES:**

1. SAWCUT JOINTS WITHIN 12 HOURS OF CONCRETE PLACEMENT (AVOID SPALLING).
2. DO NOT PLACE CONCRETE WHEN AMBIENT TEMPERATURE EXCEEDS 90°F OR WINDS GREATER THAN 20 MPH PRESENT.
3. SLAB CURING PER GENERAL NOTES.
4. CONSTRUCTION AND CONTROL JOINTS PER DETAILS THIS SHEET.

1 TYP. CONTROL JOINT PLAN (BLDG A SHOWN - B, C, D SIM.)  
S2.1 1/16" = 1'-0"

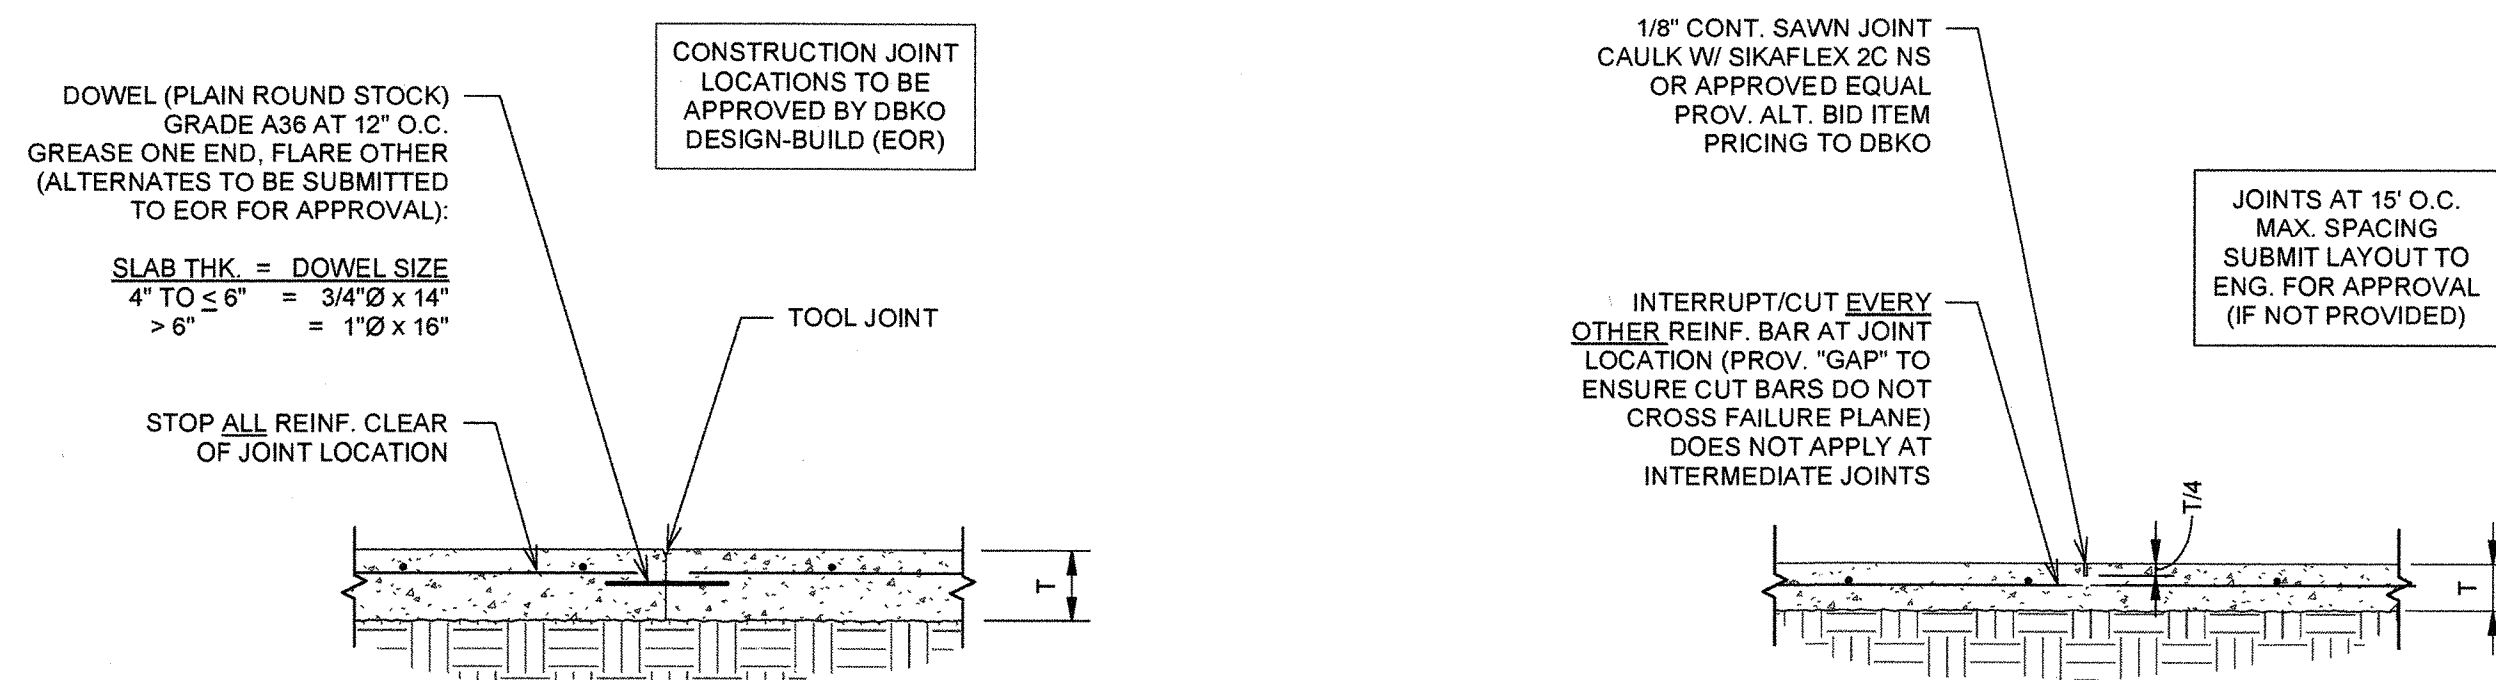

2 CONSTRUCTION JOINT DETAILS (AT CONTRACTOR'S OPTION)  
S2.1 3/4" = 1'-0"

3 INTERMEDIATE CONTROL JOINTS (SAW-CUT)  
S2.1 3/4" = 1'-0"



WHSE  
[PARTNERS]

DATE	REVISION	BY



CONTROL JOINT PLAN  
FOR  
LEASE FLEX. / WAREHOUSE BUILDINGS  
MADERA INDUSTRIAL WHSE, LLC  
S. SCHNOOR AVENUE, MADERA, CA

2019CRC  
City of Madera  
Building Department  
The approval of these plans does not prevent the City of Madera from requiring correction of errors or omissions in the plans, specifications, construction, or materials. Such corrections shall be made in accordance with the City of Madera's Codes and Ordinances.  
APPROVED  
By: [Signature]  
Date: MAR 03 2022

JOB NUMBER  
21107  
DESIGNED BY  
RT  
DRAWN BY  
LM  
DATE  
9/17/2021  
SHEET NUMBER

S2.1






ANY INFORMATION OR DATA ON THIS DRAWING IS NOT INTENDED TO BE SUITABLE FOR REUSE BY ANY PERSON, IN ANY MANNER, WITHOUT WRITTEN VERIFICATION AND ADAPTATION BY THE ENGINEER FOR THE SPECIFIC PROJECT. ANY REUSE WITHOUT WRITTEN VERIFICATION AND ADAPTATION BY THE ENGINEER FOR THE SPECIFIC PURPOSE INTENDED WILL BE AT THE USER'S SOLE RISK AND WITHOUT LIABILITY OR LEGAL EXPOSURE TO THE ENGINEER.




LEASE FLEX. / WAREHOUSE BUILDINGS  
FOR  
MADERA INDUSTRIAL WHSE, LLC  
S. SCHNOOR AVENUE, MADERA, CA


NUMBER	21107
DESIGNED BY	RT
DRAWN BY	LM
9/17/2021	
ITEM NUMBER	
S3.0	

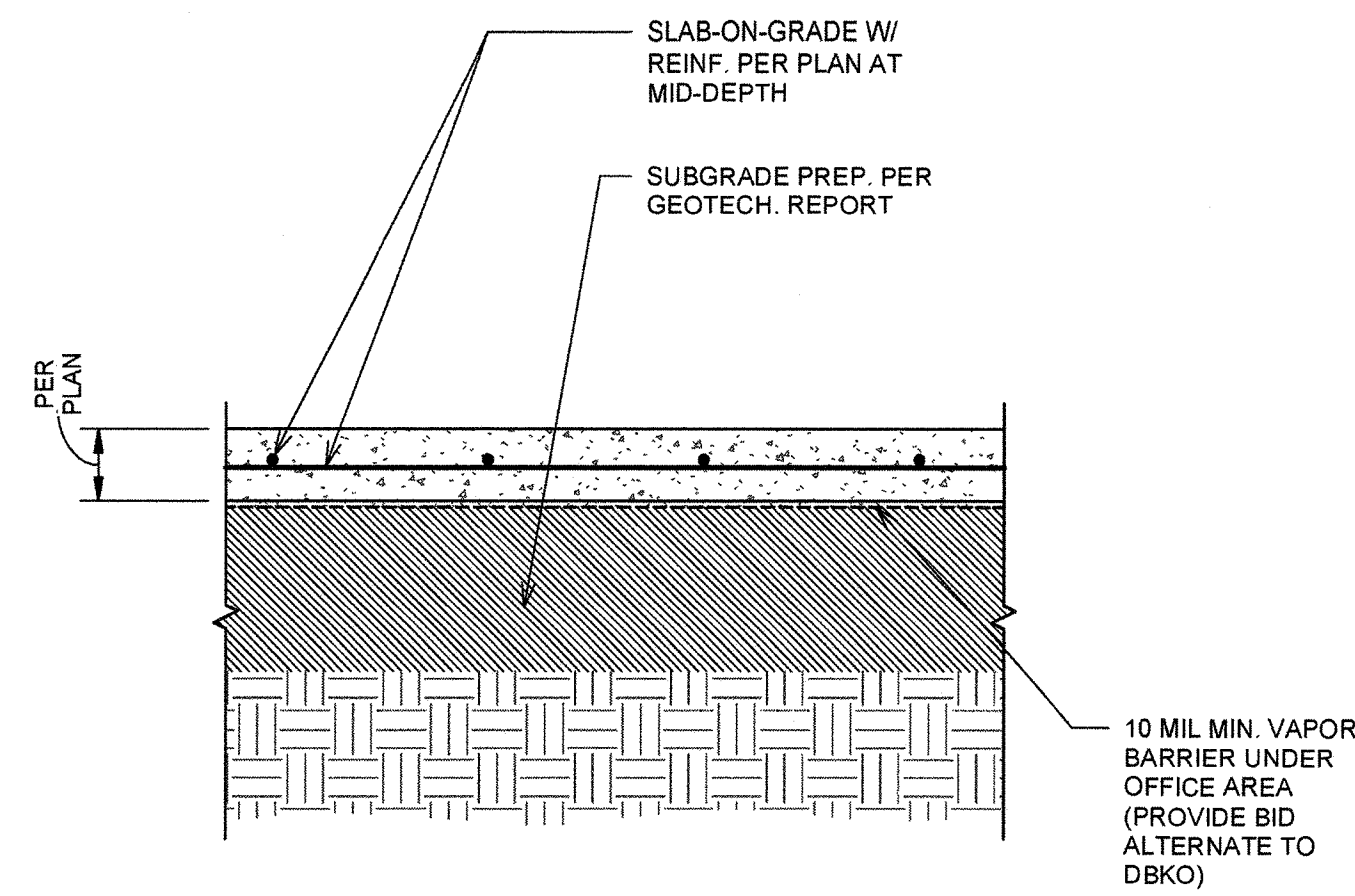


1 TYPICAL SLAB SUBGRADE SECTION  
S3.0 3/4" = 1'-0"

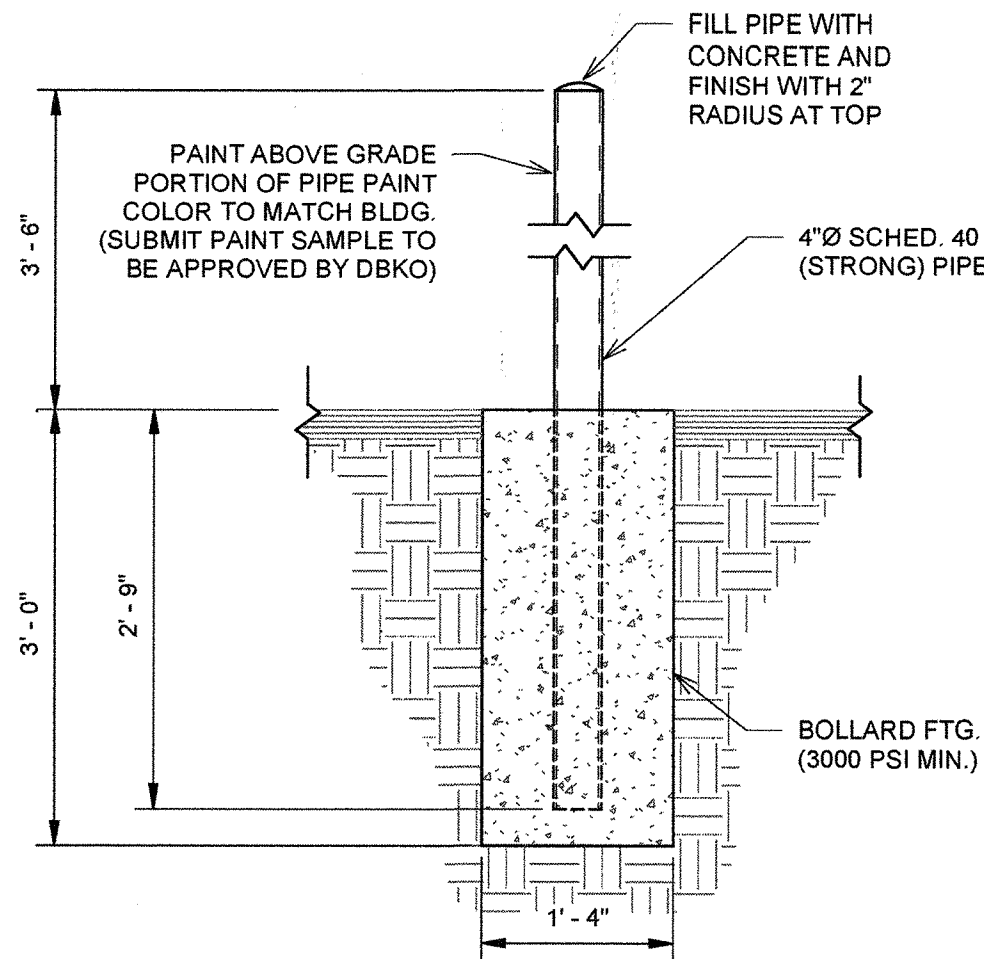

2 TYP. PIPE BOLLARD DETAIL  
S3.0 3/4" = 1'-0"

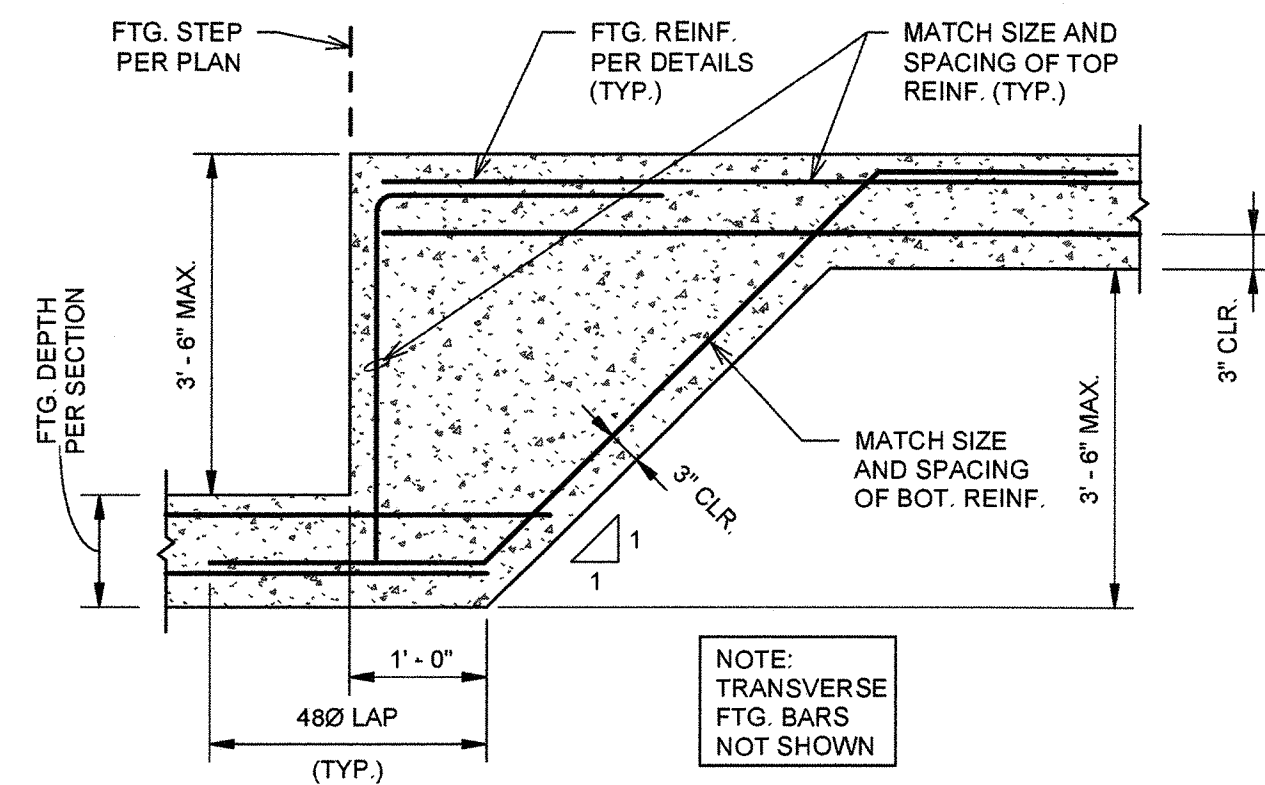

5 TYPICAL STEP FOOTING DETAIL  
S3.0 1/2" = 1'-0"

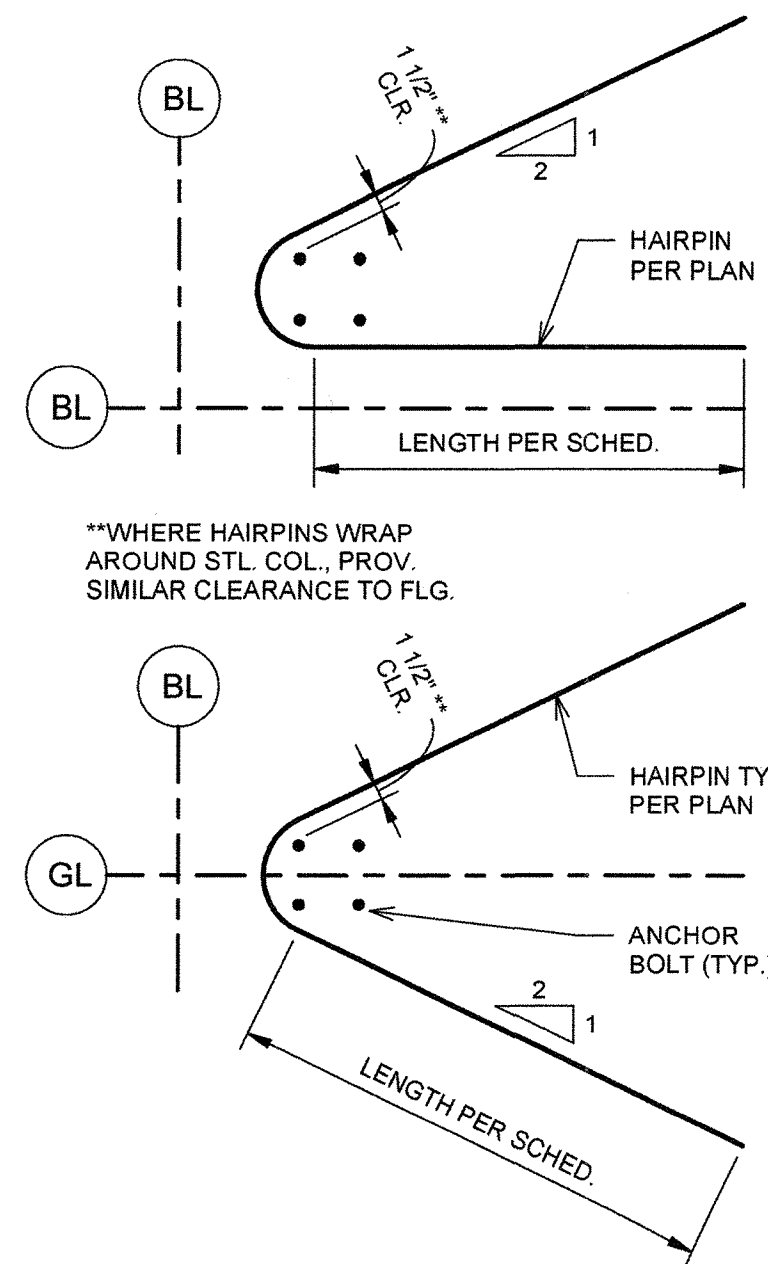

6 HAIRPIN DETAIL  
S3.0 3/4" = 1'-0"

### HAIRPIN SCHEDULE

TYPE	QUANTITY*	LENGTH
HP1	(1) #4	10' - 0"
HP2	(2) #5	15' - 0"
HP3	(2) #6	15' - 0"

\*WHERE QUANTITY GREATER THAN 1  
PROV. 1-1/2" VERT CLR. B/T ROWS.

TYPICAL  
CONDITION


fc, PSI (2)	LOCATION (4)	CASE (5)	CLASS B SPLICE LENGTH, IN.							
			#3	#4	#5	#6	#7	#8	#9	#10
3,000	OTHER	1	28	37	47	56	81	93	105	118
		2	42	56	70	84	122	139	157	177
		1	22	29	36	43	63	72	81	91
4,000	TOP	2	32	43	54	64	94	107	121	136
		1	24	32	40	48	70	80	91	102
		2	36	48	60	72	106	121	136	153
	OTHER	1	19	25	31	37	54	62	70	73
		2	28	37	47	56	81	93	105	118
5,000	TOP	1	22	29	36	43	63	72	81	91
		2	33	43	54	64	94	108	122	137
	OTHER	1	17	22	28	33	49	55	63	70
2		25	33	42	50	73	83	94	105	
6,000	TOP	1	20	26	33	40	58	66	74	83
		2	30	40	49	59	86	98	111	125
	OTHER	1	15	20	25	31	44	51	57	64
		2	23	31	38	46	66	76	85	96

## NOTES

1. WHERE SMALLER DIAMETER BARS LAP WITH LARGER DIAMETER BARS, USE LAP LENGTH FOR LARGER DIAMETER BAR.
2. "f<sub>c</sub>" VALUES IN THIS TABLE DENOTE DESIGN STRENGTH FOR NORMAL WEIGHT CONCRETE ONLY.
3. TABULATED VALUES ARE FOR GRADE 60 REINFORCEMENT. FOR HIGHER GRADE REINFORCEMENT, CONSULT EOR.
4. TOP BARS DENOTE HORIZONTAL BARS PLACED SO THAT 12" OF CONCRETE OR MORE IS CAST BELOW (I.E. - BEAM TOP BARS OR WALL REINFORCEMENT).
5. CASES 1 AND 2, PER STRUCTURAL MEMBER TYPE, CONCRETE COVER, AND BAR SPACING (CENTER-TO-CENTER) AS DEFINED BELOW:
 

CASE 1	CONC. COVER ≥ 1.0db	AND	SPA. ≥ 3.0db
CASE 2	CONC. COVER < 1.0db	OR	SPA. < 3.0db
6. FOR LIGHTWEIGHT AGGREGATE CONCRETE, MULTIPLY TABULATED VALUES BY 1.33
7. FOR EPOXY COATED BARS, MULTIPLY TABULATED VALUES BY 1.3 FOR "TOP BARS" AND 1.5 FOR "OTHERS".

**7 CONCRETE REINFORCEMENT BAR LAP SCHEDULE**  
 S3.0 3/4" = 1'-0"

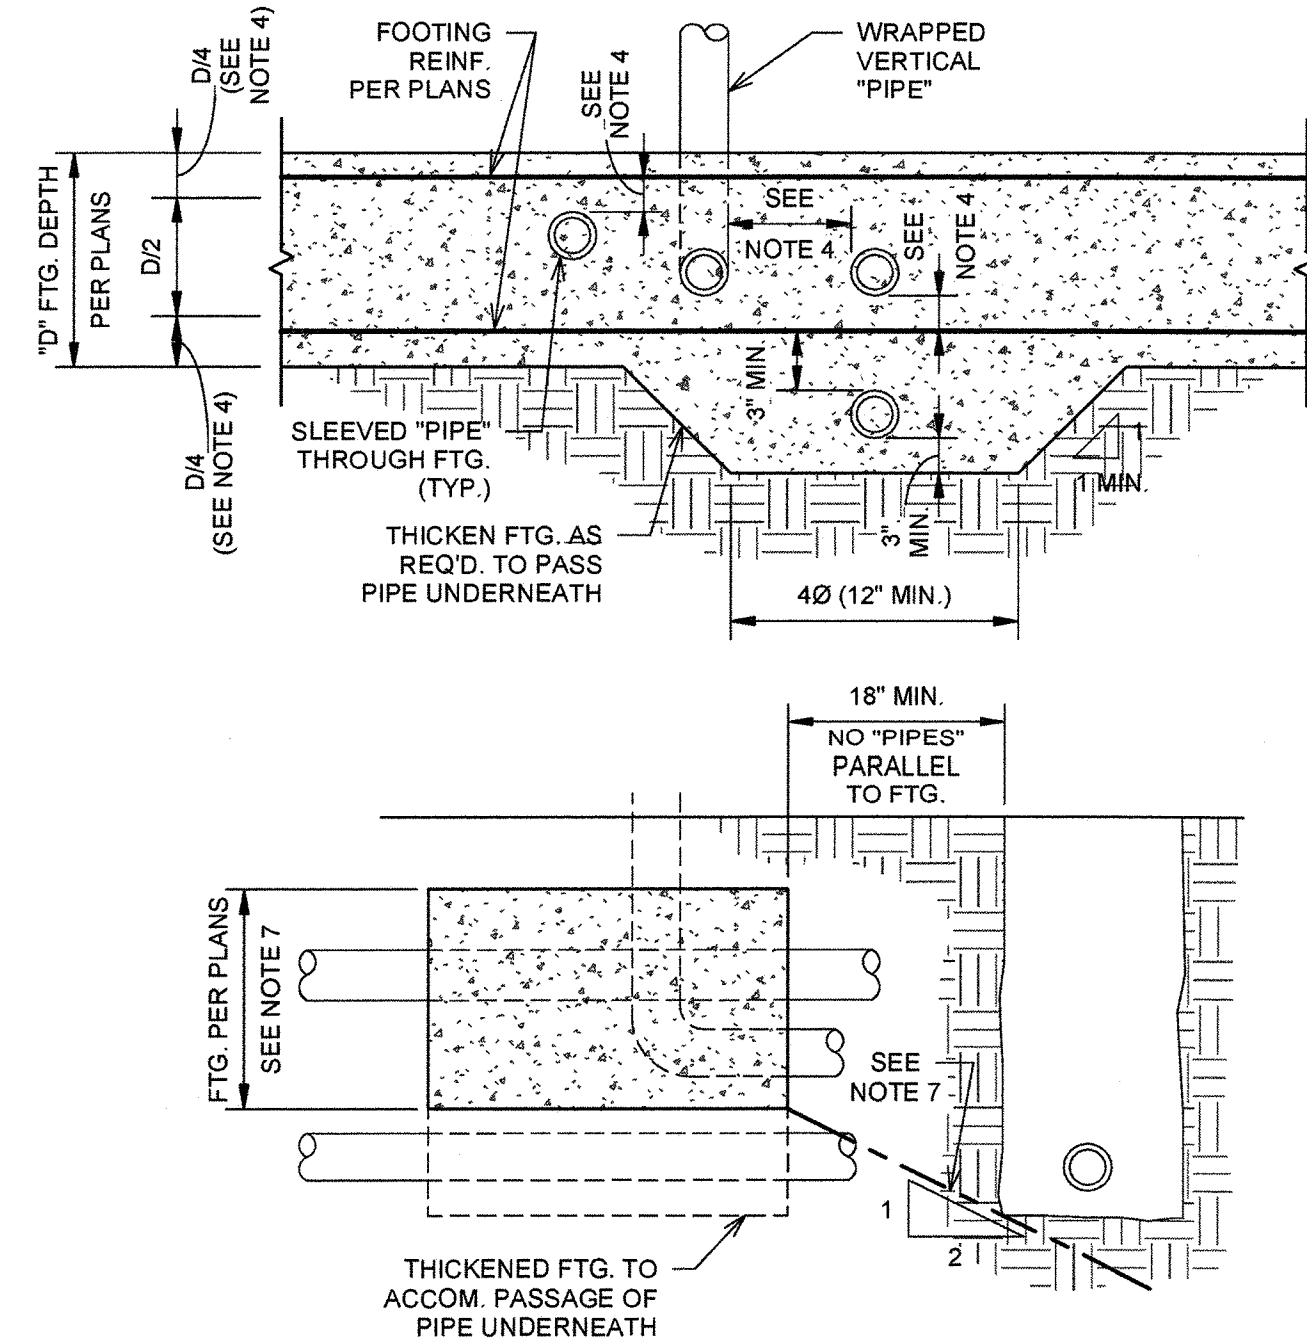


9 TYPICAL PIPE/CONDUIT AT FOOTING DETAIL  
S3.0 3/4" = 1'-0"

### PIPE THRU FOOTING NOTES

1. PROVIDE FLEXIBLE COUPLINGS AT ENTRY/EXIT POINTS AT ALL PIPES EMBEDDED IN CONCRETE.
2. NO PIPE IS PERMITTED TO RUN PARALLEL IN FOOTINGS, STEMS, OR CURBS
3. ALL PIPES TO USE PVC SLEEVES WITH AN INSIDE DIAMETER 2" LARGER THAN PIPE OUTSIDE DIAMETER. IN LIEU OF SLEEVE, PIPES MAY BE WRAPPED WITH 1/4" FOAM SHEETS, 4 LAYERS MINIMUM.
4. ALL PIPES THROUGH FOOTINGS TO BE WRAPPED OR SLEEVED. MAINTAIN 1.5" MINIMUM CLEARANCE BETWEEN WRAPS/SLEEVES AND CONCRETE REINFORCEMENT. MAINTAIN 3" MINIMUM CONCRETE COVER AROUND WRAPS/SLEEVES. NO PIPES SHALL BE PLACED WITHIN 6" OF FOOTING TOP AND BOTTOM. ALL 6" OR CONDUIT (RISERS) SHALL BE WRAPPED WITH A MINIMUM OF 20 MIL TAPE.
5. MINIMUM CLEARANCE BETWEEN "PIPES" TO BE TWO TIMES THE LARGER PIPE DIAMETER (6" MINIMUM).
6. NO HORIZONTAL PIPES ALLOWED WITHIN 2'-0" OF EACH SIDE OF STEEL COLUMNS OR HOLLOWTONS TO AVOID COMPRESSION/TENSION ZONES. NO VERTICAL PIPES ALLOWED IN SHEAR WALLS OR BRACED FRAMES.
7. PIPES PLACED PARALLEL TO FOOTINGS IN BACKFILLED TRENCHES SHALL BE PLACED ABOVE THE 1:2 SLOPED LINE SHOWN IN THE SECTION.
8. NO SLEEVES OR WRAPPED PIPE GREATER THAN 8" IN DIAMETER SHALL BE PLACED THROUGH THE FOOTING. USE THICKENED FOOTING AS SHOWN FOR LARGER PIPES.
9. ALL OTHER CONFIGURATIONS/CONDITIONS ENCOUNTERED IN THE FIELD MUST BE BROUGHT TO THE ATTENTION OF THE STRUCTURAL ENGINEER FOR FURTHER REVIEW.


6d FOR BARS #8, & SMALLER  
D = 8d FOR #9, #10, AND #11  
BARS  
10d FOR #14 AND #18 BARS  
WHERE:  
D = MINIMUM BAR BEND  
DIAMETER  
d = DIAMETER OF BAR

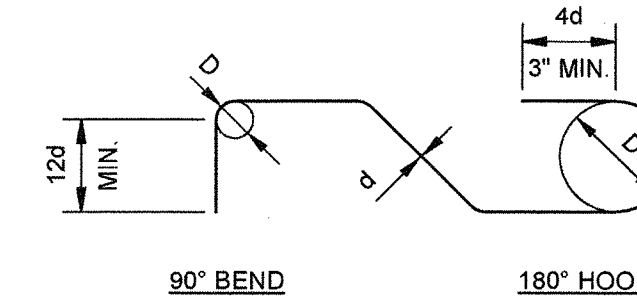

BARS OTHER THAN STIRRUPS, TIES, HOOKS & CROSS-TIES

D = 4d FOR BARS #5 & SMALLER  
6d FOR LARGER THAN #5

WHERE:  
D = MINIMUM BAR BEND  
DIAMETER  
d = DIAMETER OF BAR

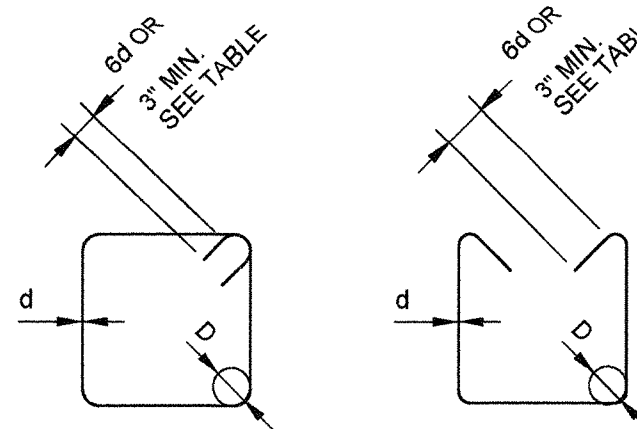

## STIRRUPS, TIES, HOOKS &amp; CROSS-TIES

MIN. BAR DIAMETER "D" AND STANDARD HOOK  
EXTENSION "L" IN INCHES

BARS OTHER THAN STIRRUPS, TIES, HOOPS AND CROSS-TIES	BAR SIZE	"D"	180° "L"	135° "L"	90° "L"
	#3	2 1/4	3 MIN.	-	4 1/2
	#4	3	3 MIN.	-	6
	#5	3 3/4	3 MIN.	-	7 1/2
	#6	4 1/2	3	-	9
	#7	5 1/4	3 1/2	-	10 1/2
	#8	6	4	-	12
	#9	9	4 1/2	-	13 1/2
	#10	10	5	-	15
	#11	11	5 1/2	-	16 1/2
STIRRUPS, TIES, HOOPS AND CROSS-TIES	#14	17 1/2	7	-	21
	#18	22 1/2	9	-	27
	#3	1 1/2	-	3 MIN.	3 MIN.
	#4	2	-	3	3
	#5	2 1/2	-	3 3/4	3 3/4
	#6	4 1/2	-	4 1/2	9
	#7	5 1/4	-	5 1/4	10 1/2
#8	6	-	6	12	


2019CBO  
City of Modesto  
Building Department  
The approval of these plans does not prevent the City of Modesto from requiring correction of errors or omissions in the plans, specifications or construction. Subject to field inspections and approvals, these Codes and Ordinances  
**APPROVED**  
By: \_\_\_\_\_  
Date: MAR 03 2022

11 REINFORCEMENT BAR BEND SCHEDULE  
S3.0 3/4" = 1'-0"




1/22/2021 2:59:49 PM


G:\Shared\Drawings\PROJECTS\2019\WHSE\Drawings\Foundations\WHSE\BLD\CA\_2021-09-17.rvt

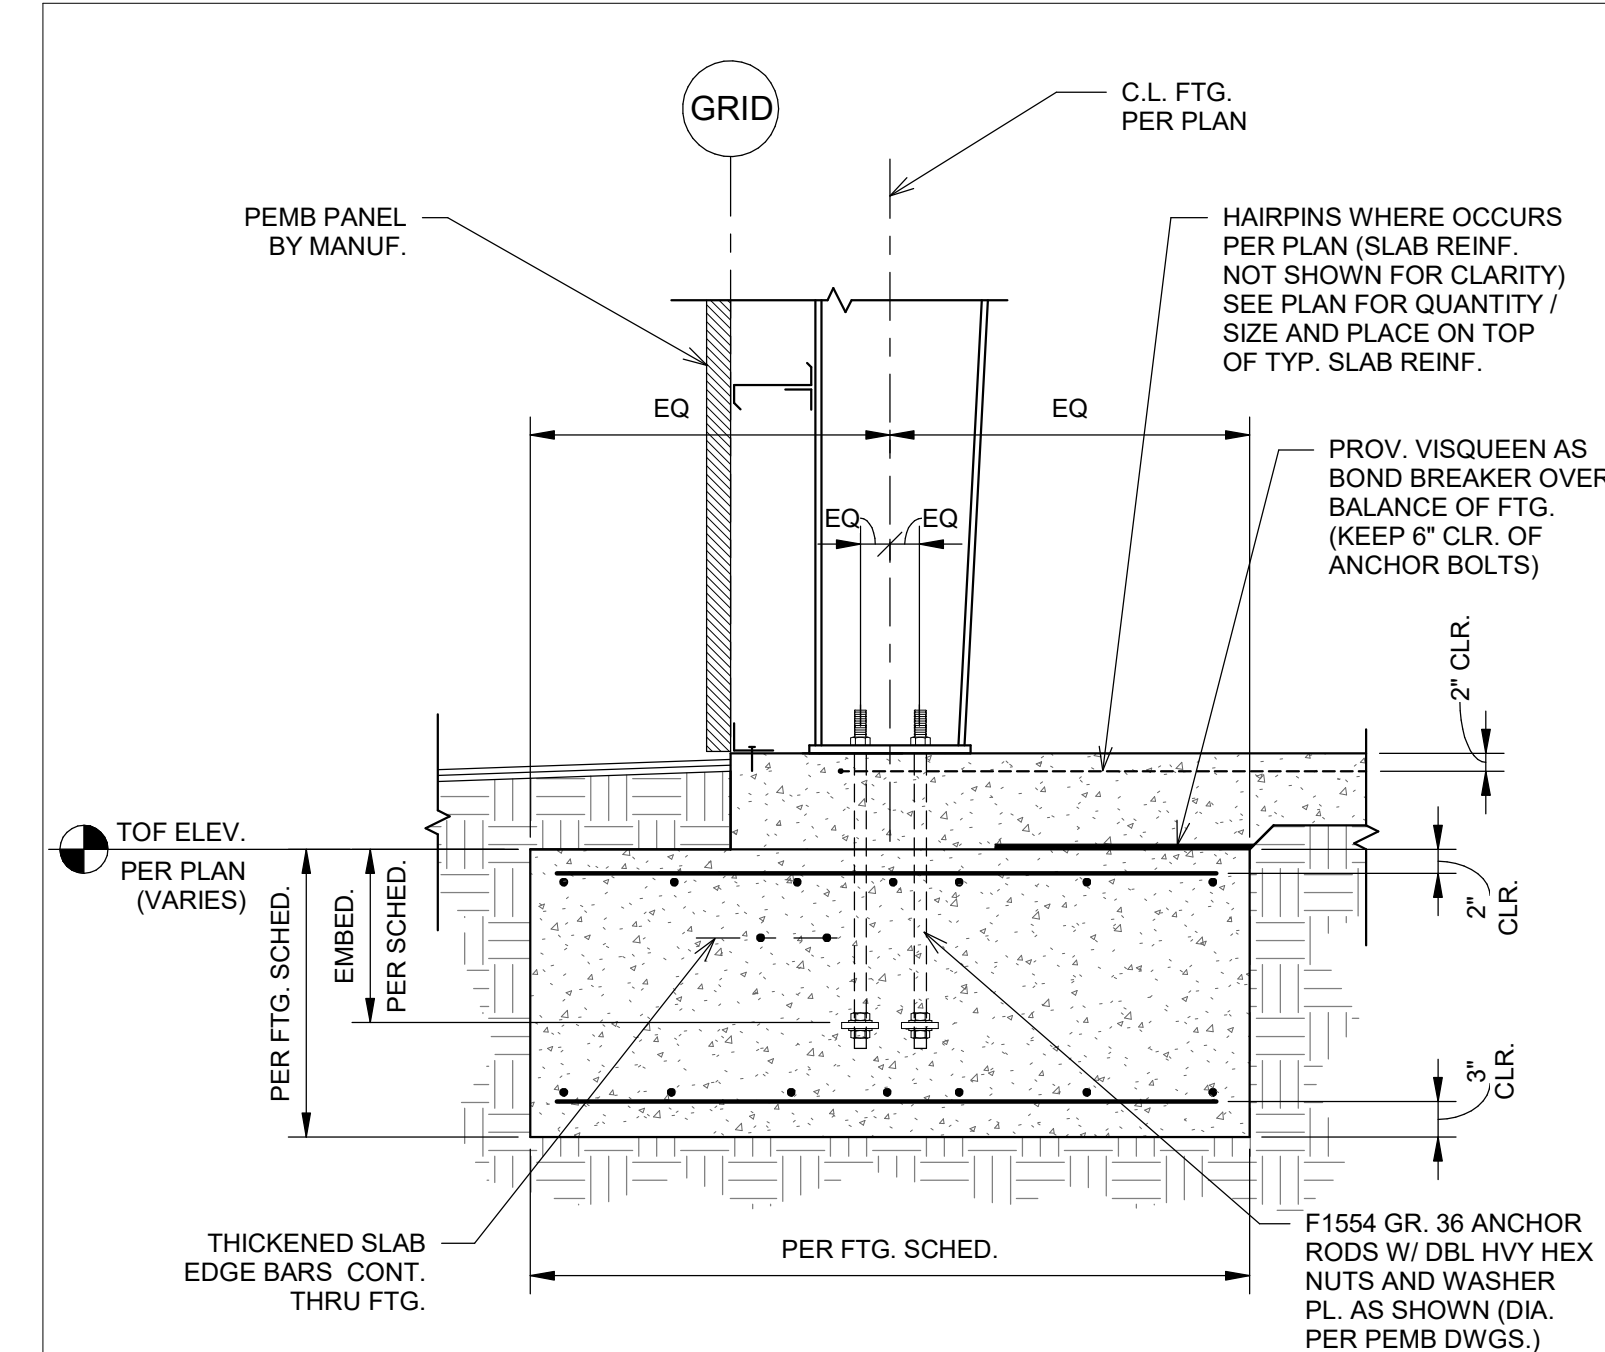


1 TYP. EXT. FOOTING SECTION  
S3.1 3/4" = 1'-0"

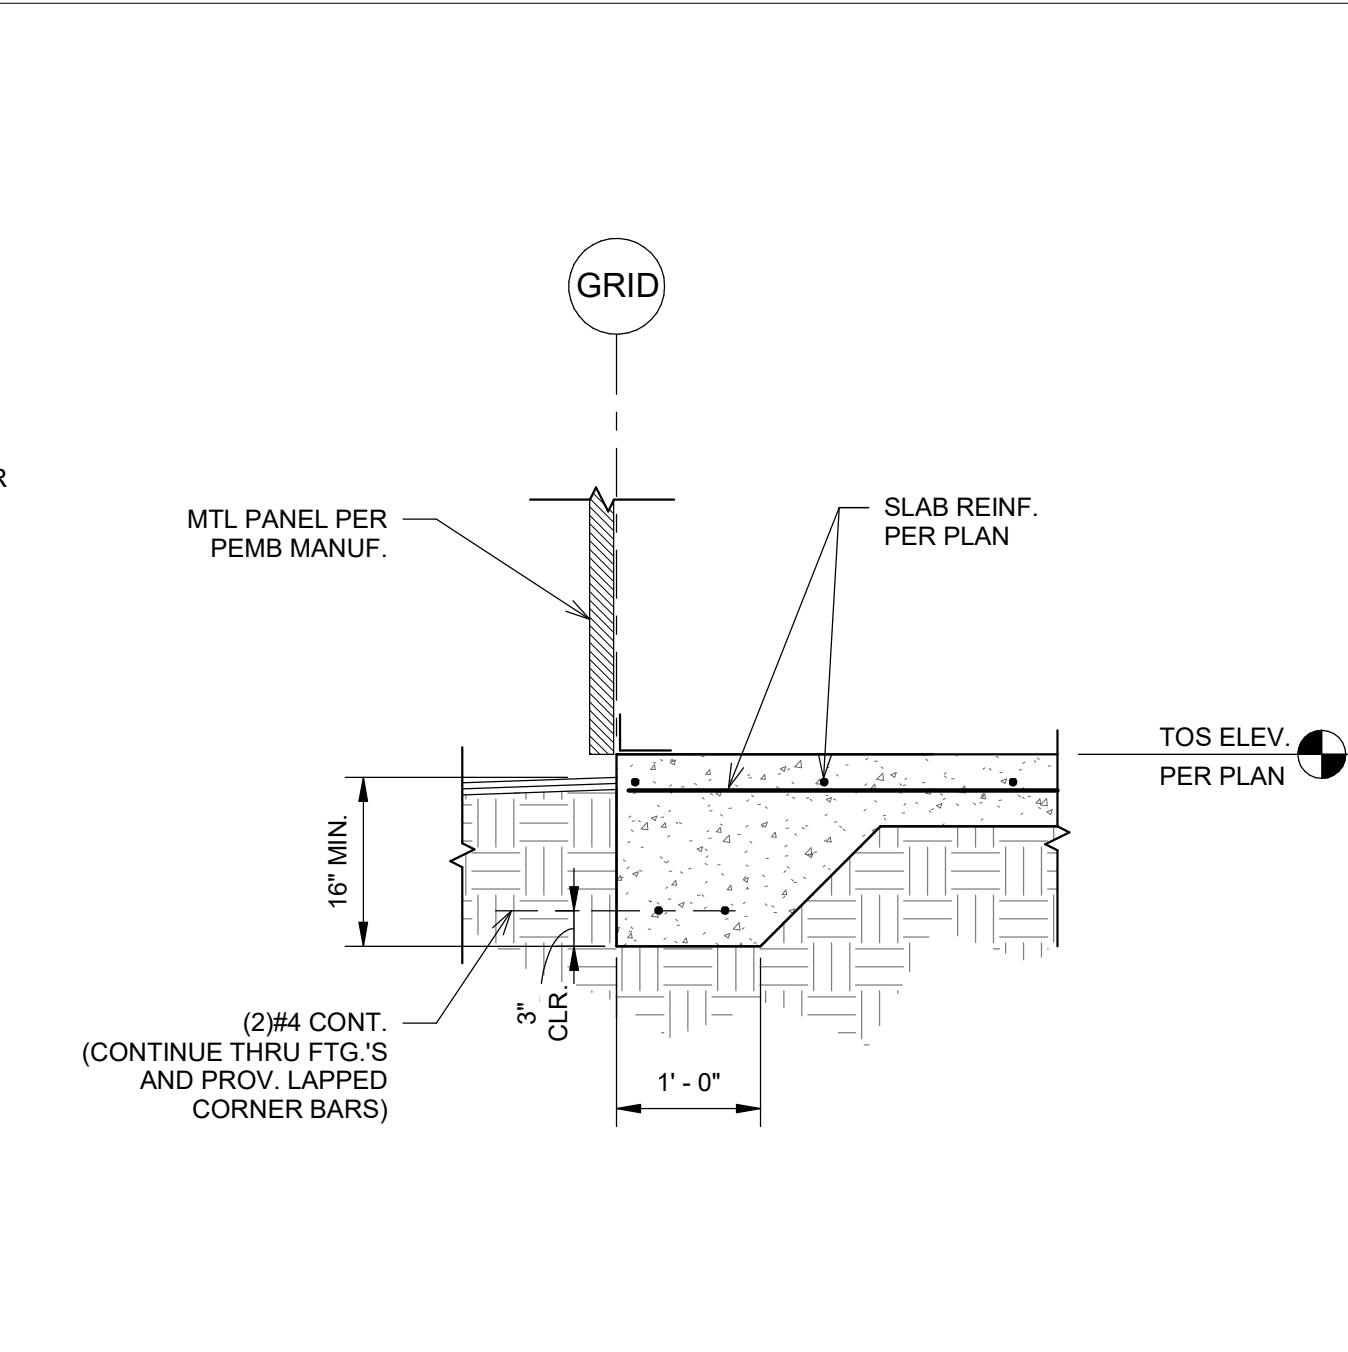


2 TYPICAL THICKENED SLAB EDGE  
S3.1 3/4" = 1'-0"

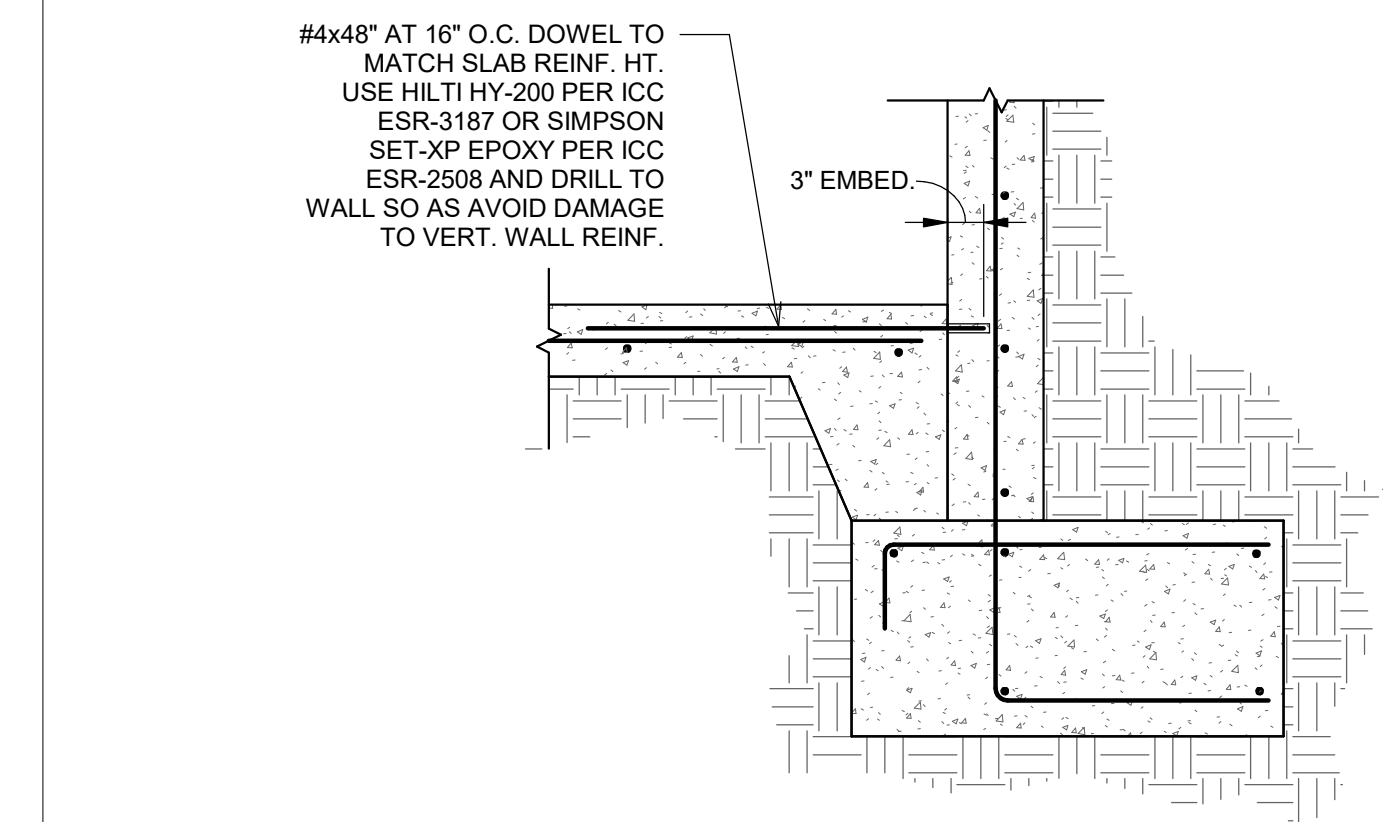


5 DOCK SLAB REINFORCEMENT DETAIL (ALTERNATE)  
S3.1 3/4" = 1'-0"

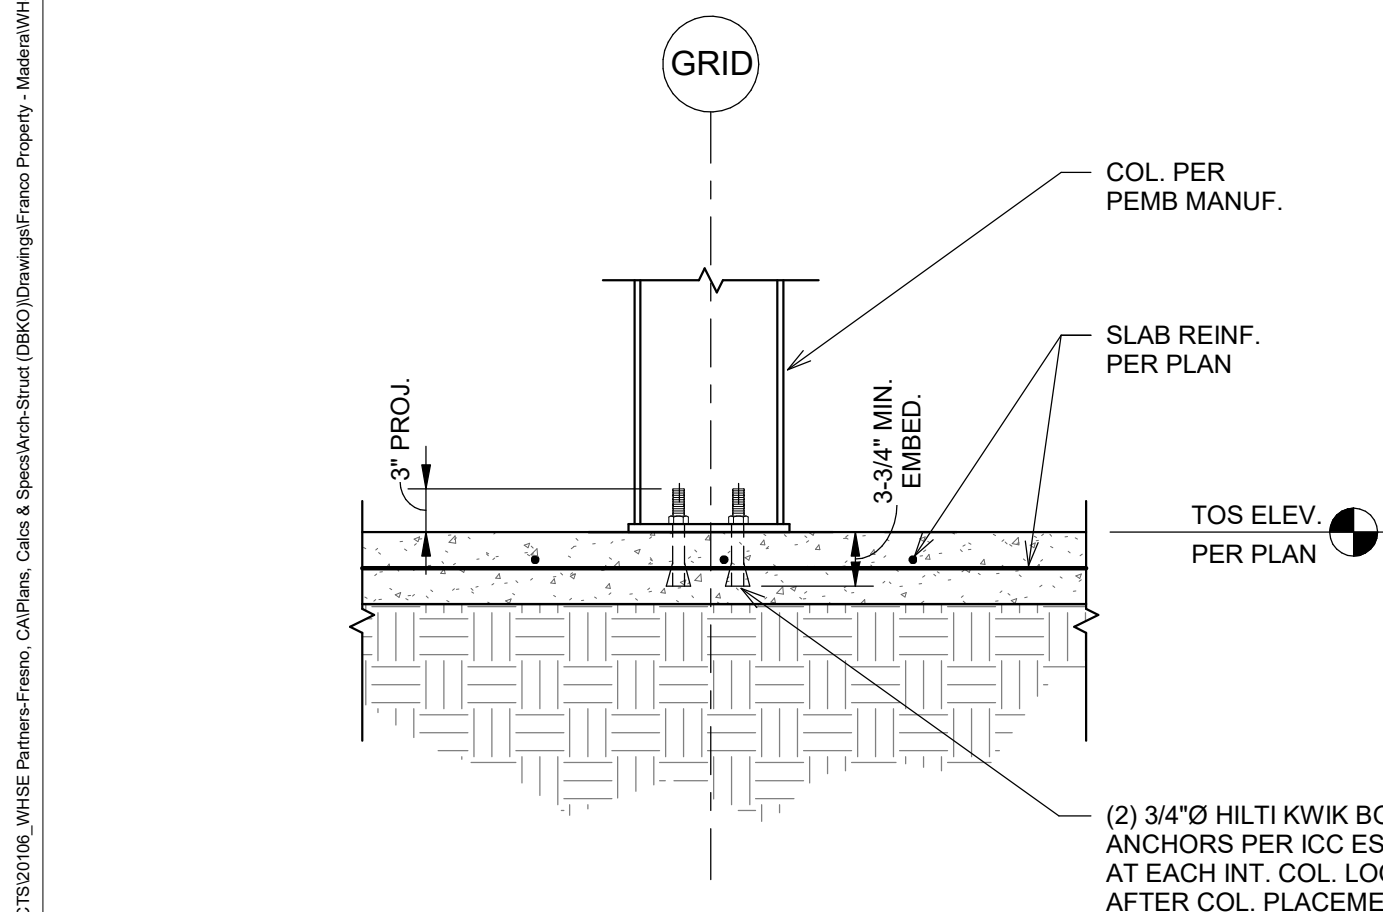


9 ANCHORAGE DETAIL AT INTERNAL PARTITION WALL COLUMNS  
S3.1 3/4" = 1'-0"

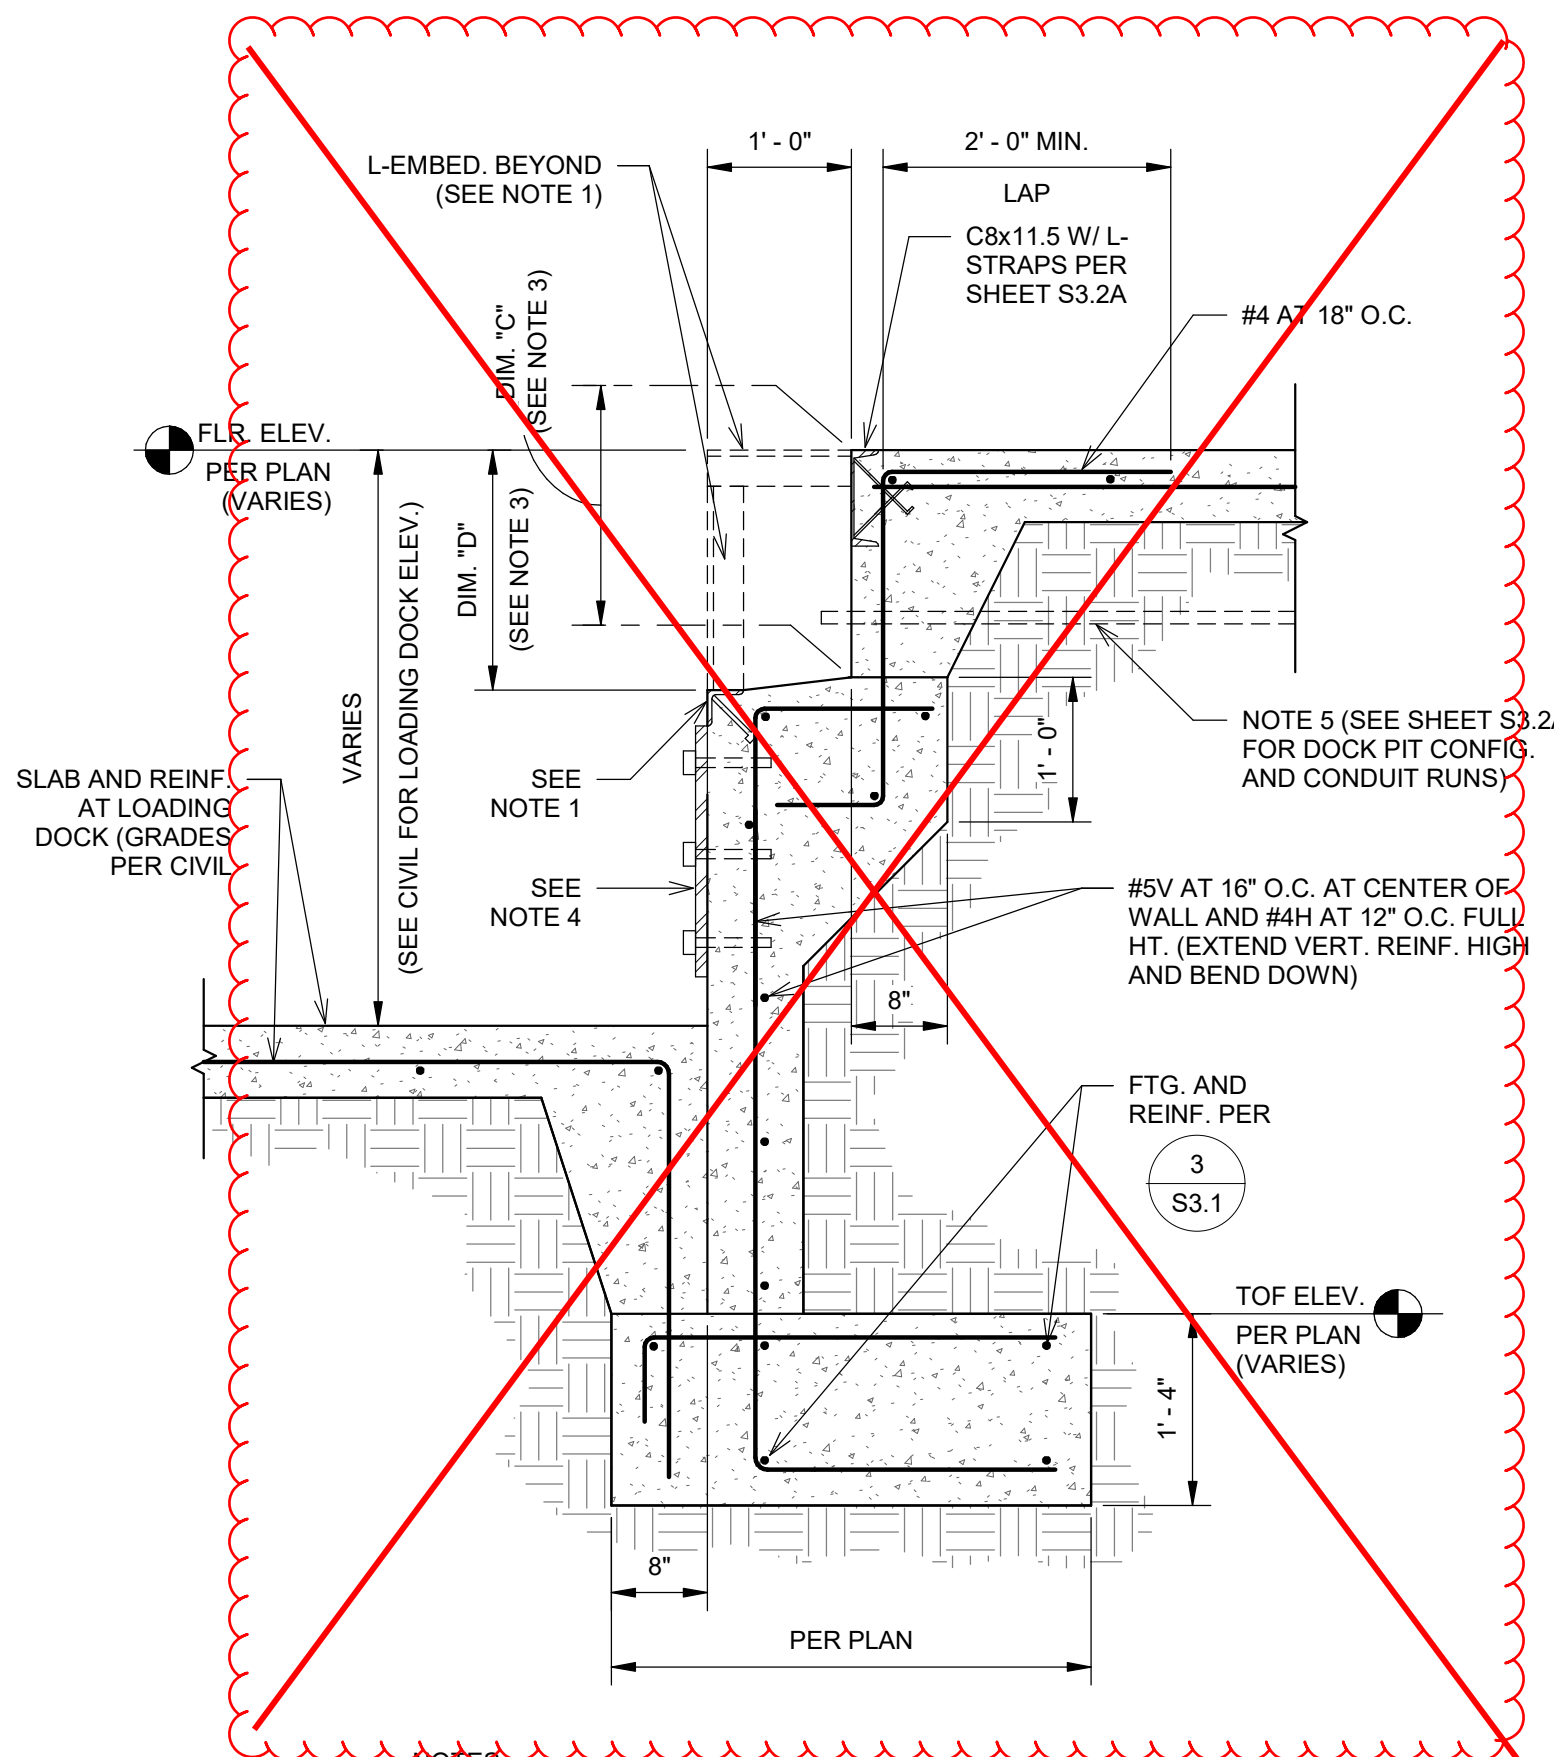


10 LEVELING PIT SECTION AT LOADING DOCK  
S3.1 3/4" = 1'-0"

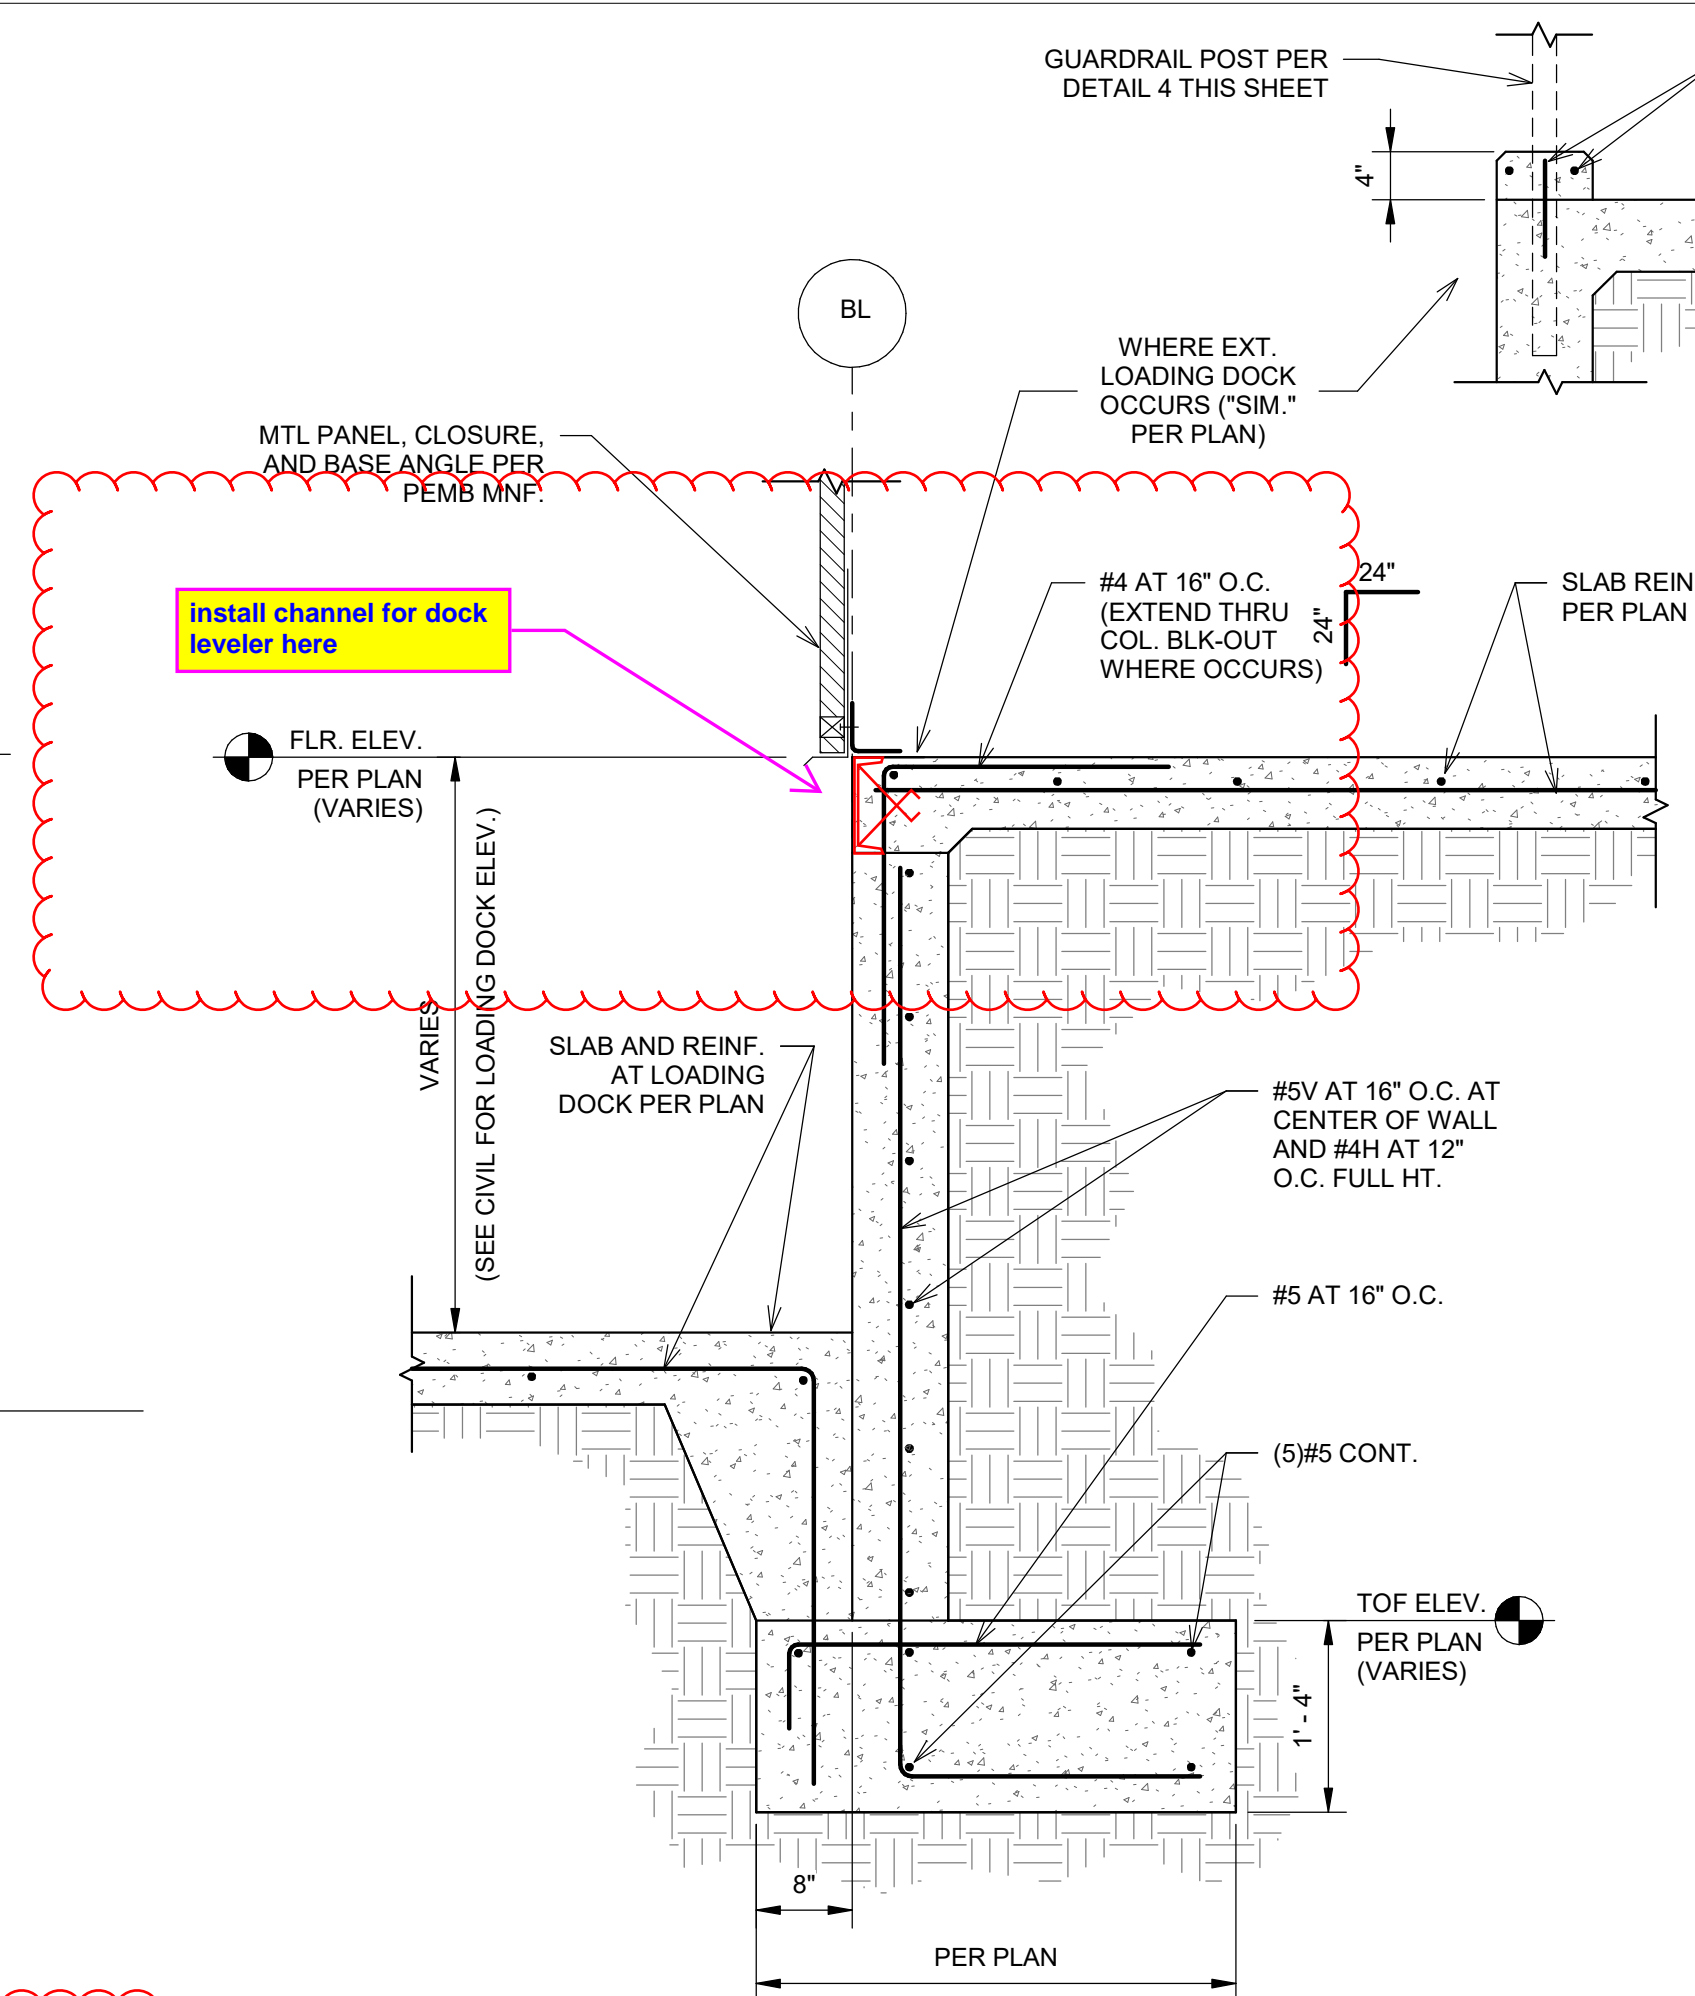


3 TYP. FND. WALL ADJACENT TO LOADING DOCK  
S3.1 3/4" = 1'-0"

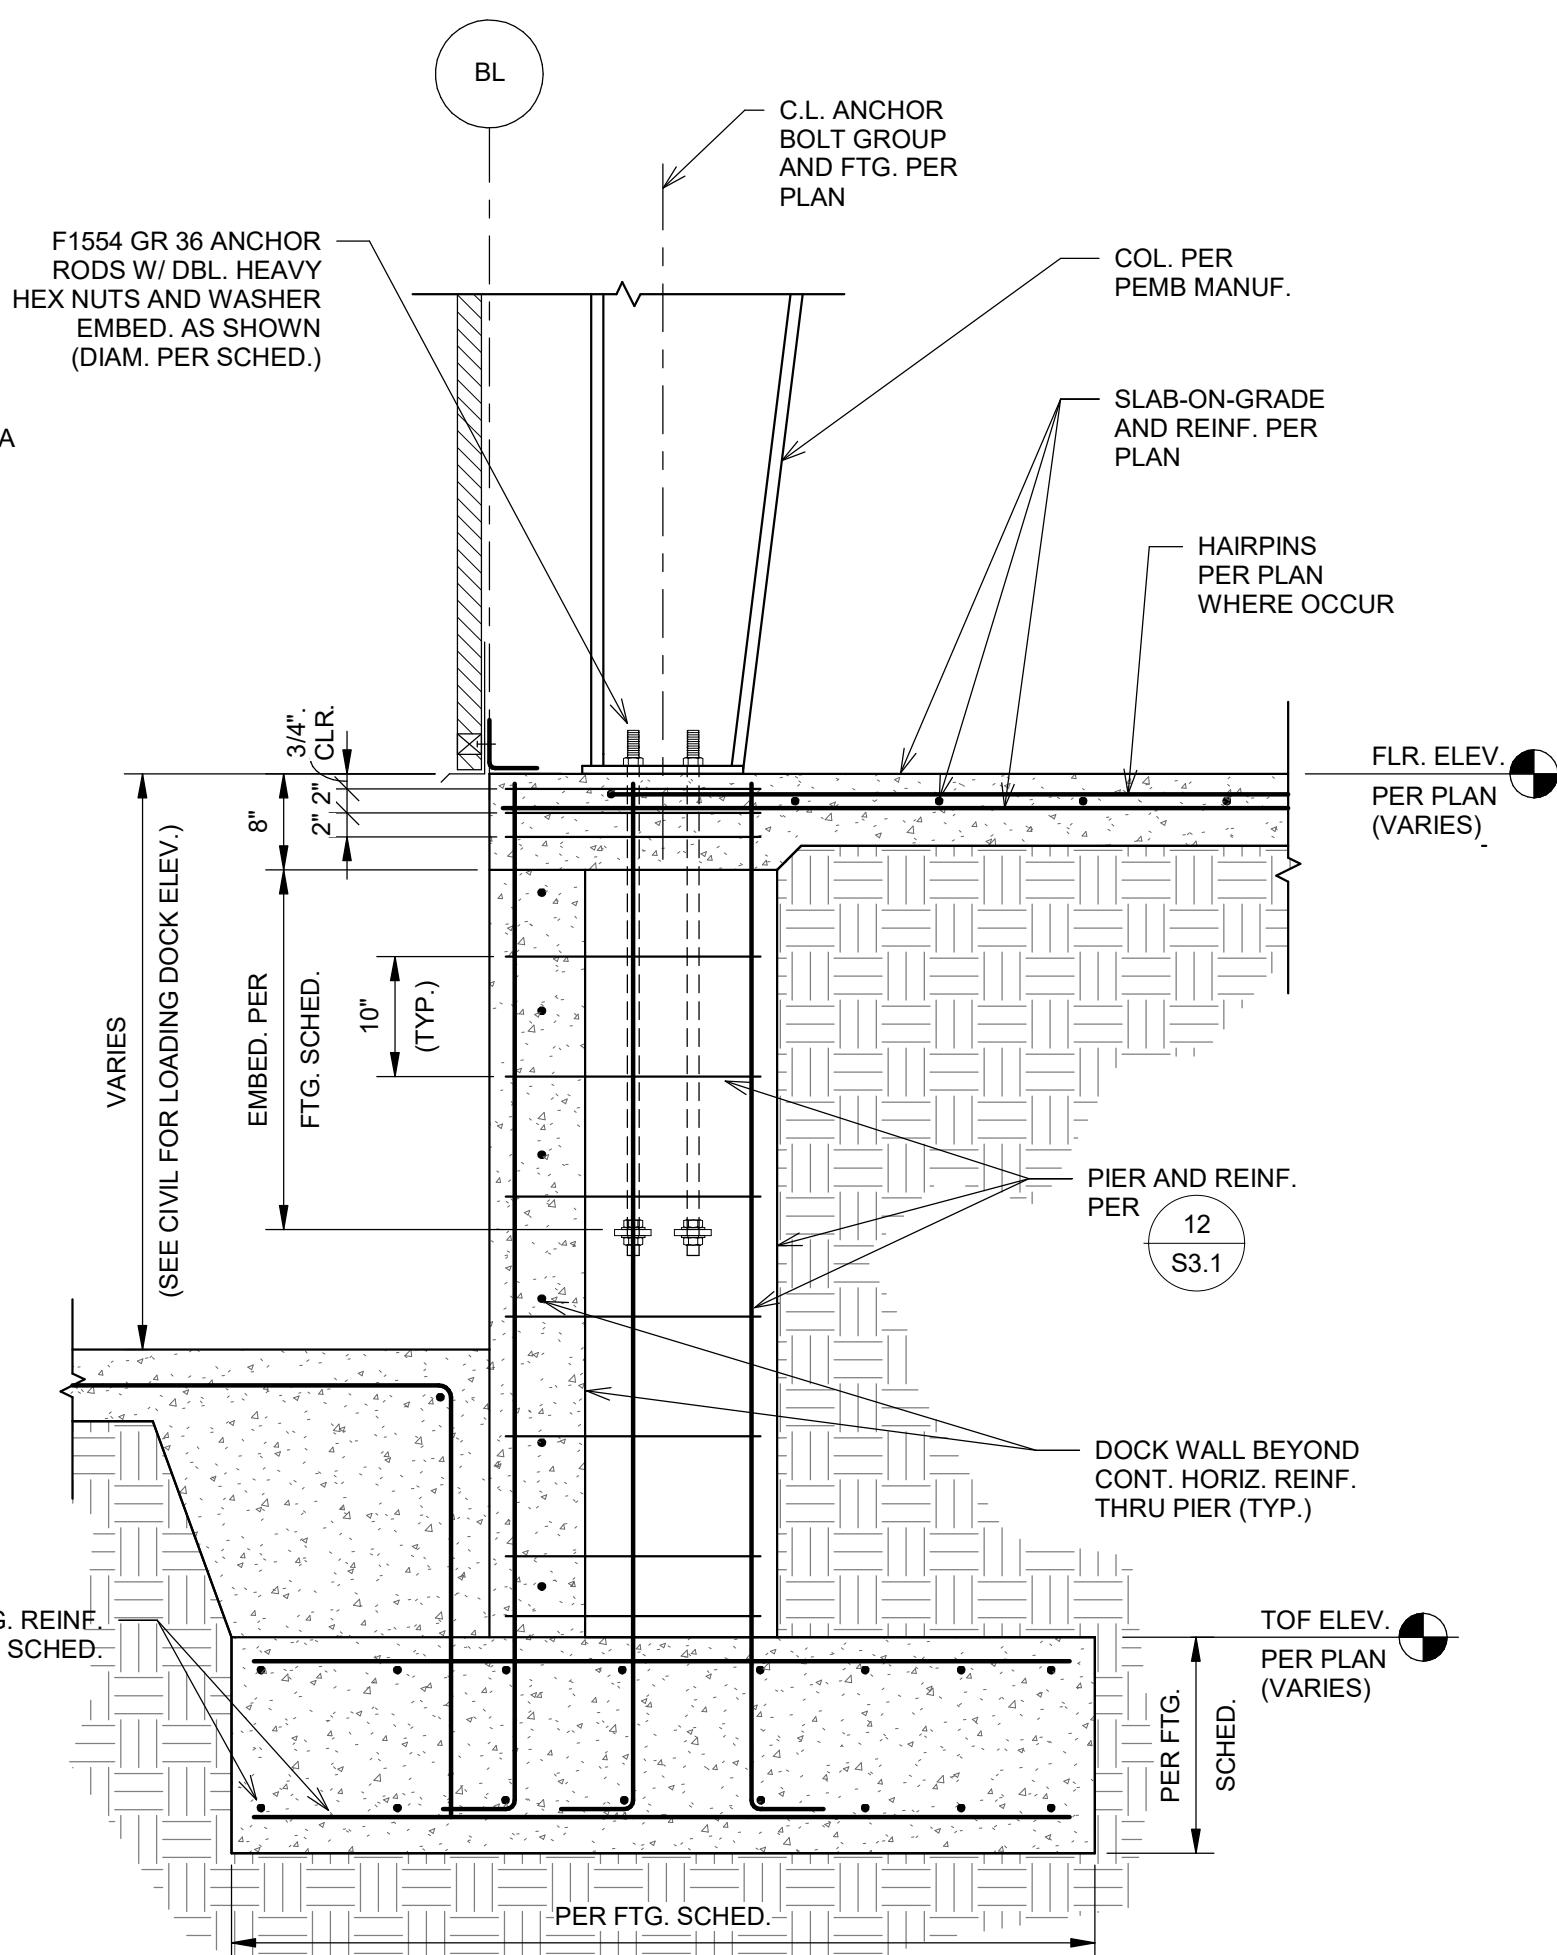

11 TYP. COL. PIER AT LOADING DOCK WALL  
S3.1 3/4" = 1'-0"

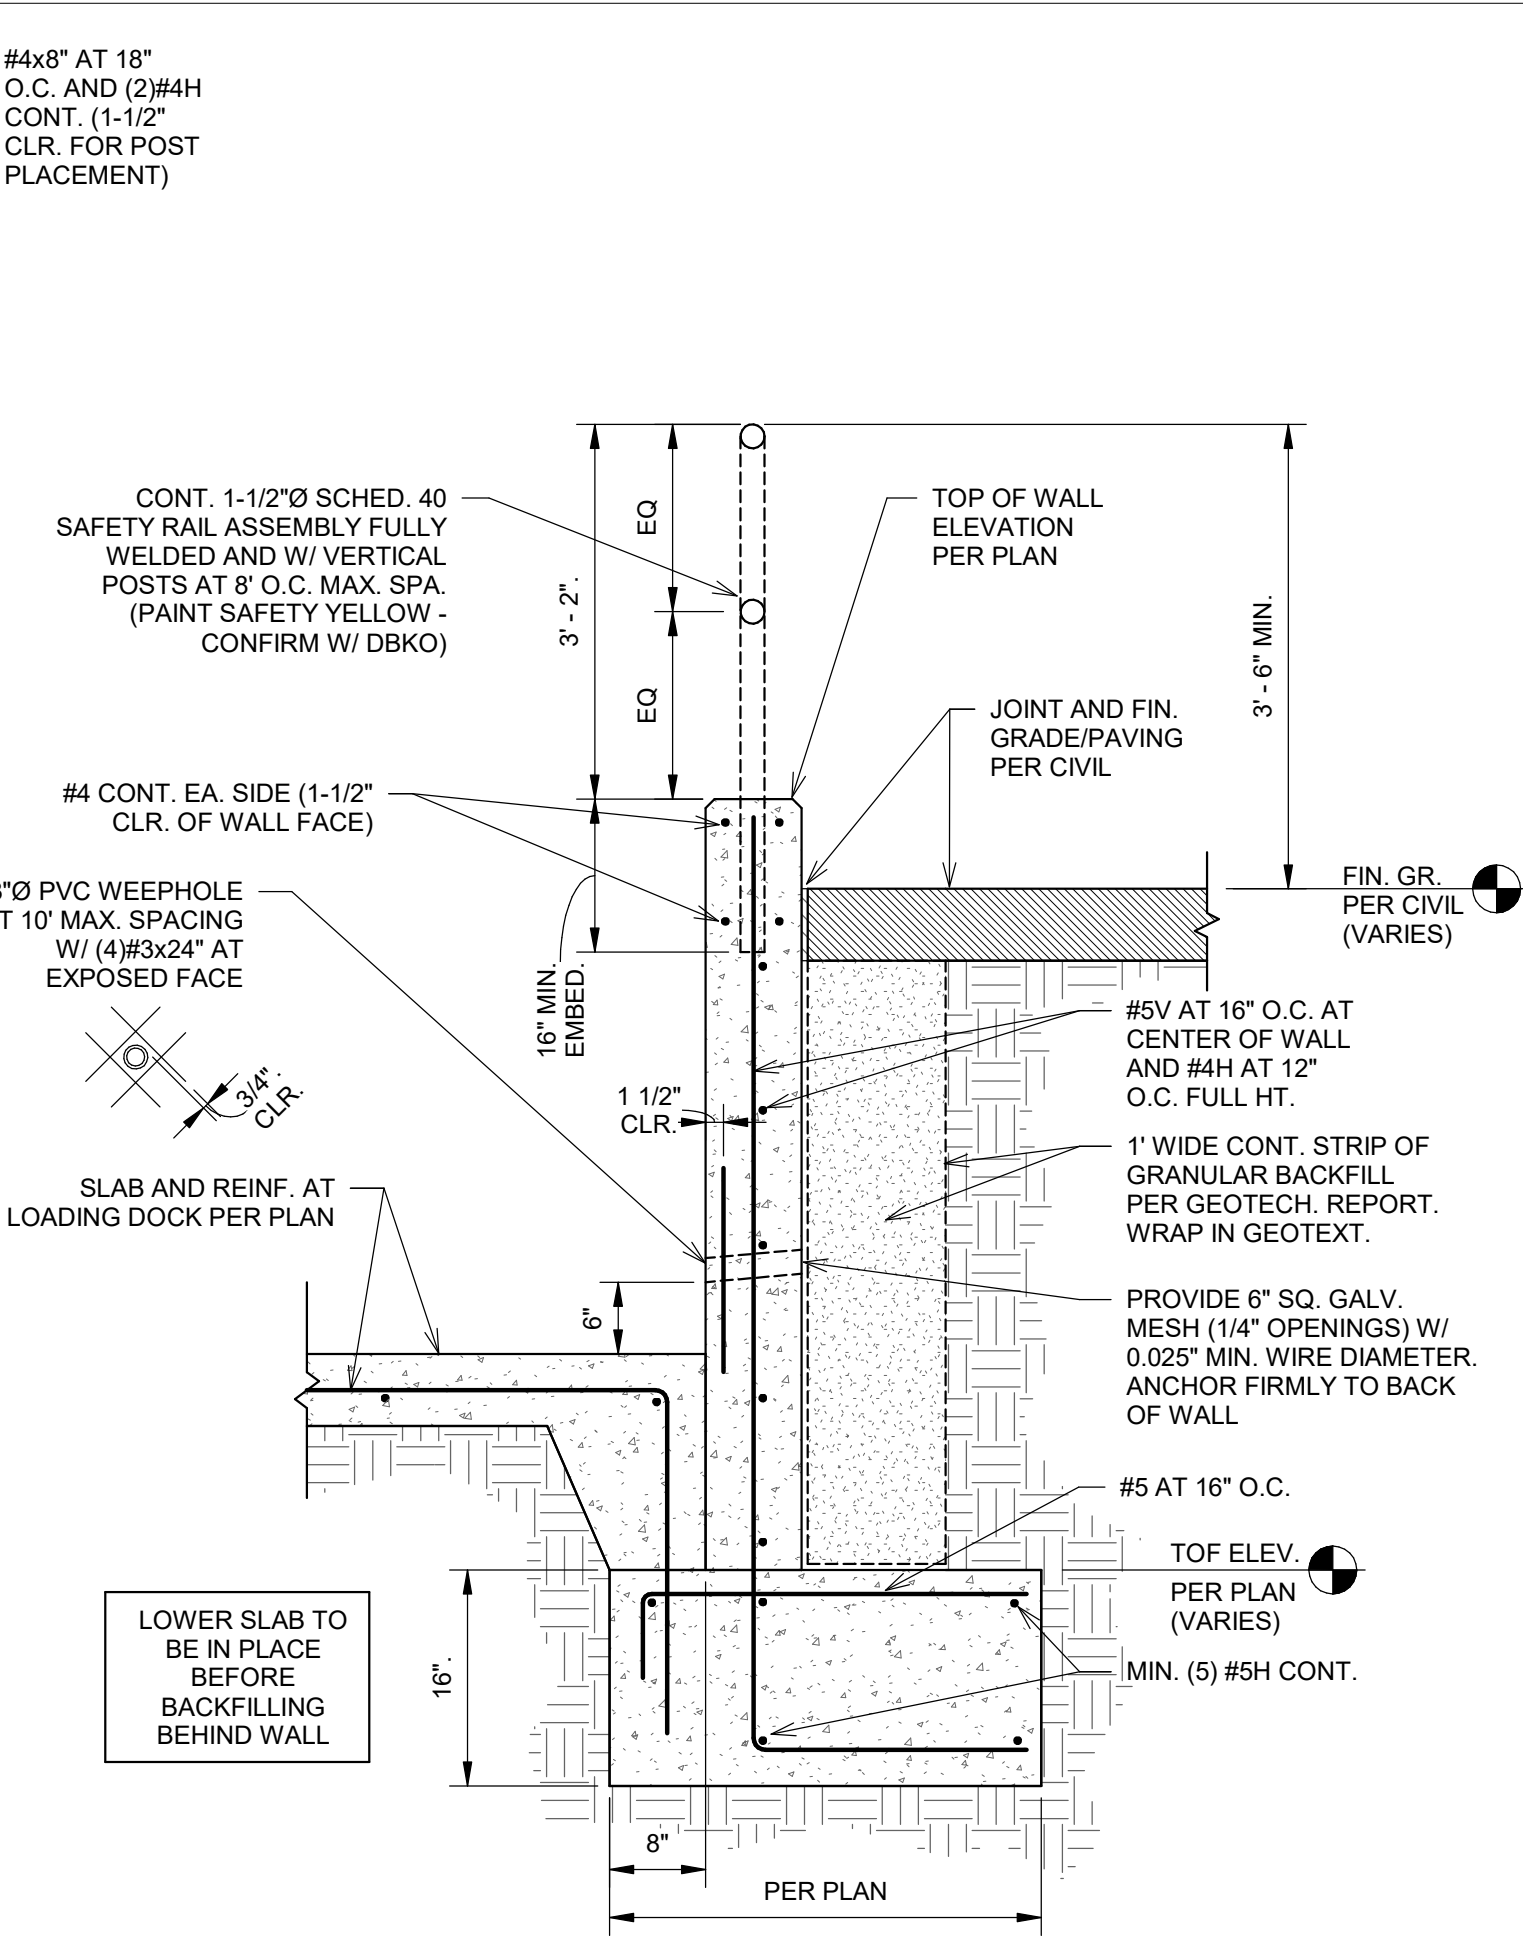

4 TYPICAL DOCK RETAINING WALL SECTION  
S3.1 3/4" = 1'-0"

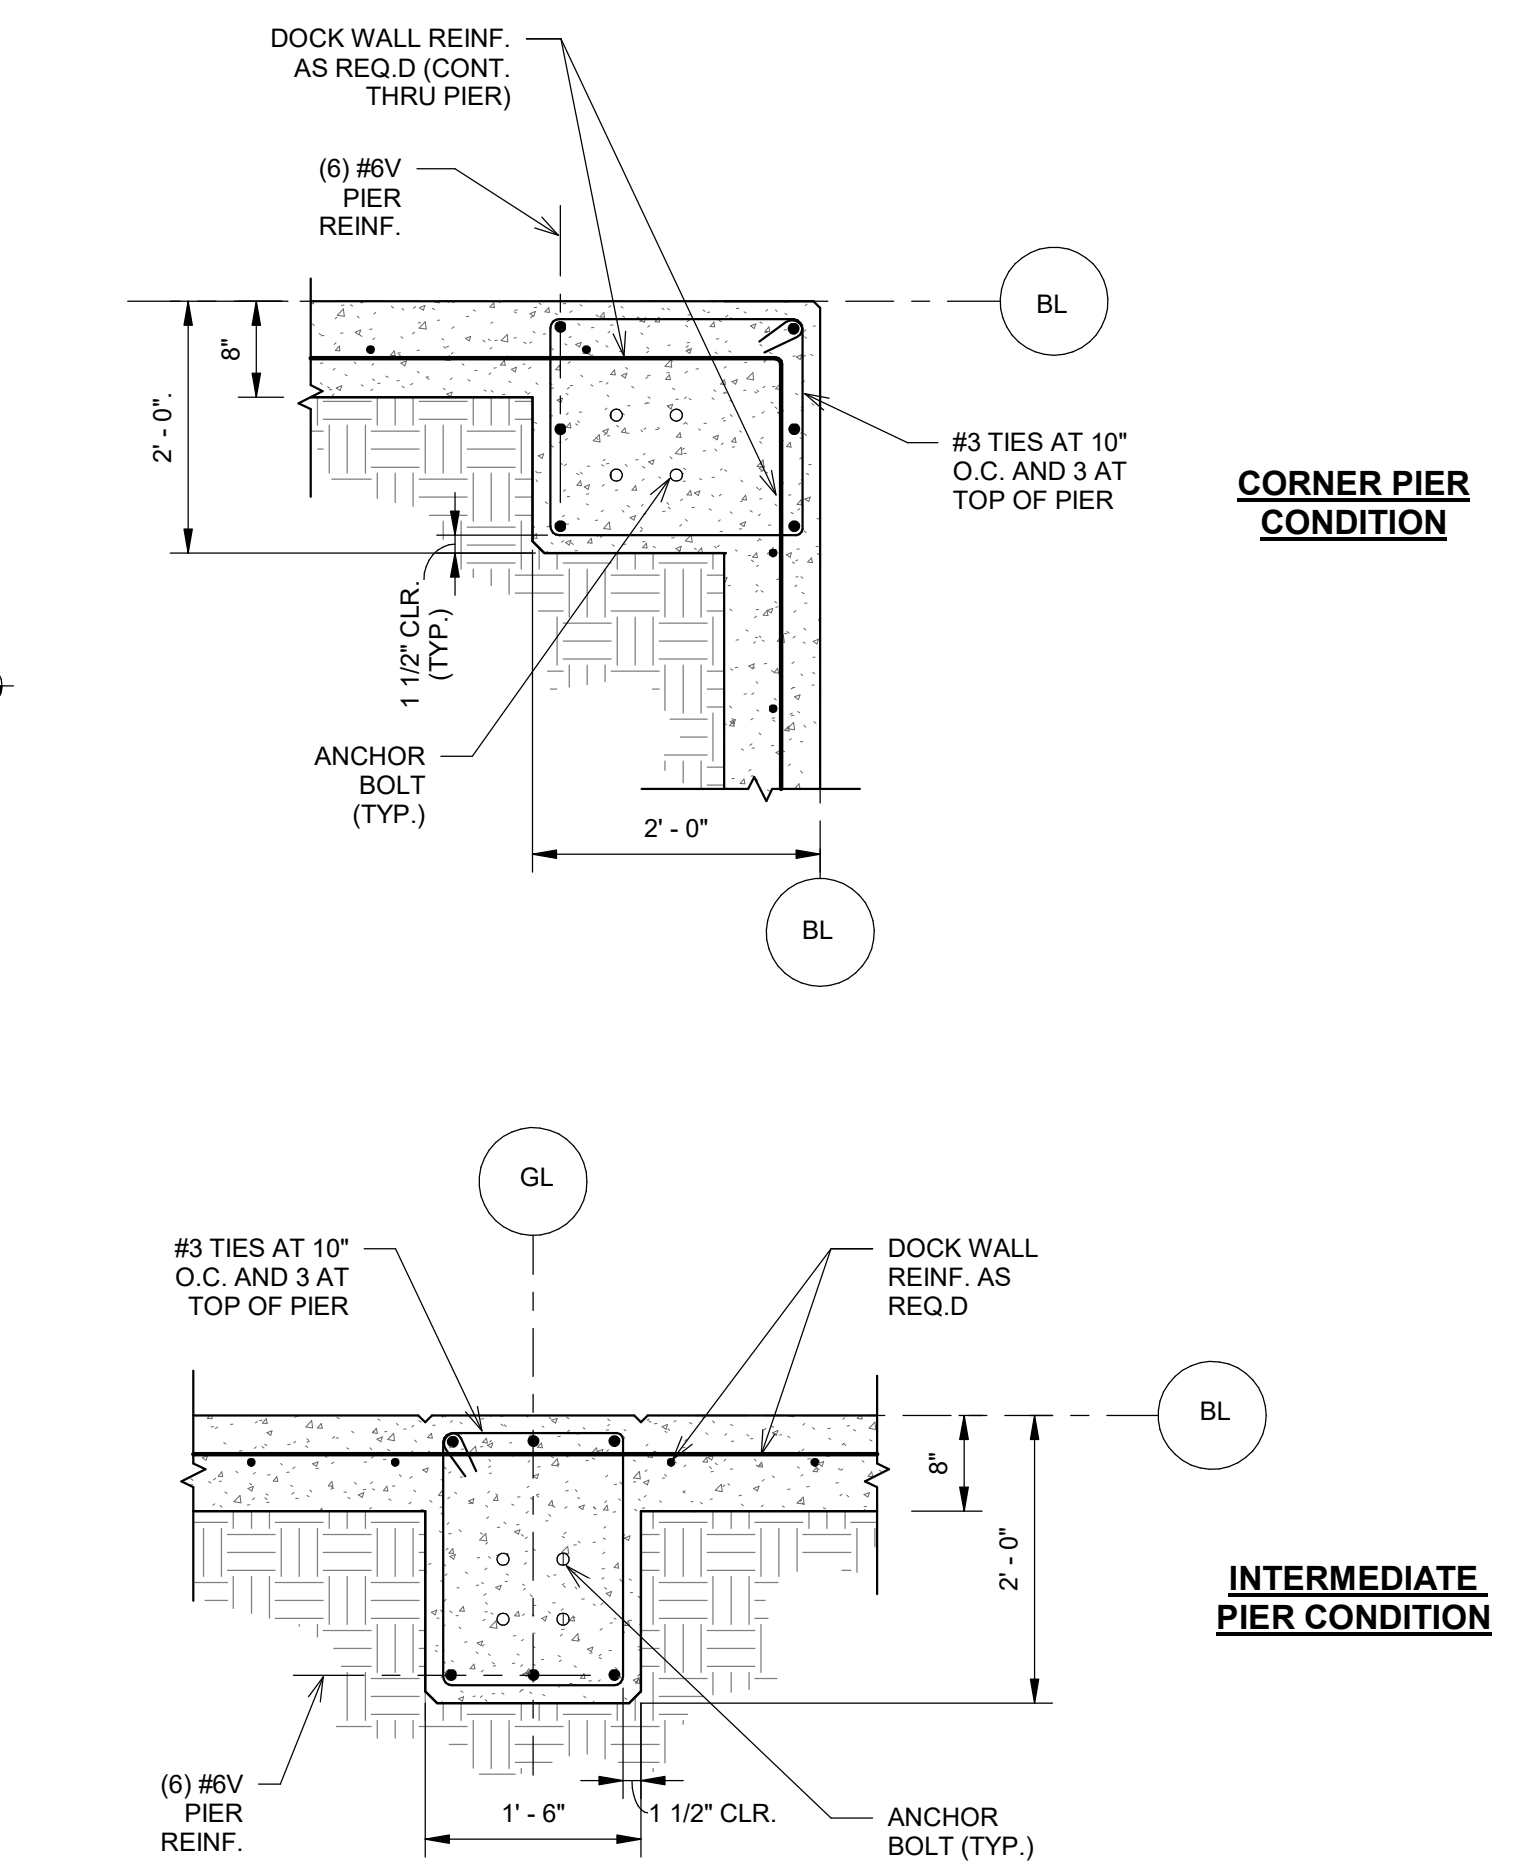

12 PLAN VIEWS AT PIERS  
S3.1 3/4" = 1'-0"

BY	
REVISION	
DATE	
SEAL	

REGISTERED PROFESSIONAL ENGINEER  
ROBERT A. TAMACCO  
S5607  
STRUCTURAL  
STATE OF CALIFORNIA  
11/17/2021

FOUNDATION DETAILS

FOR

LEASE FLEX. / WAREHOUSE BUILDINGS

MADERA INDUSTRIAL WHSE, LLC


S. SCHNOOR AVENUE, MADERA, CA

JOB NUMBER	21107
DESIGNED BY	RT
DRAWN BY	LM
DATE	9/17/2021
SHEET NUMBER	S3.1







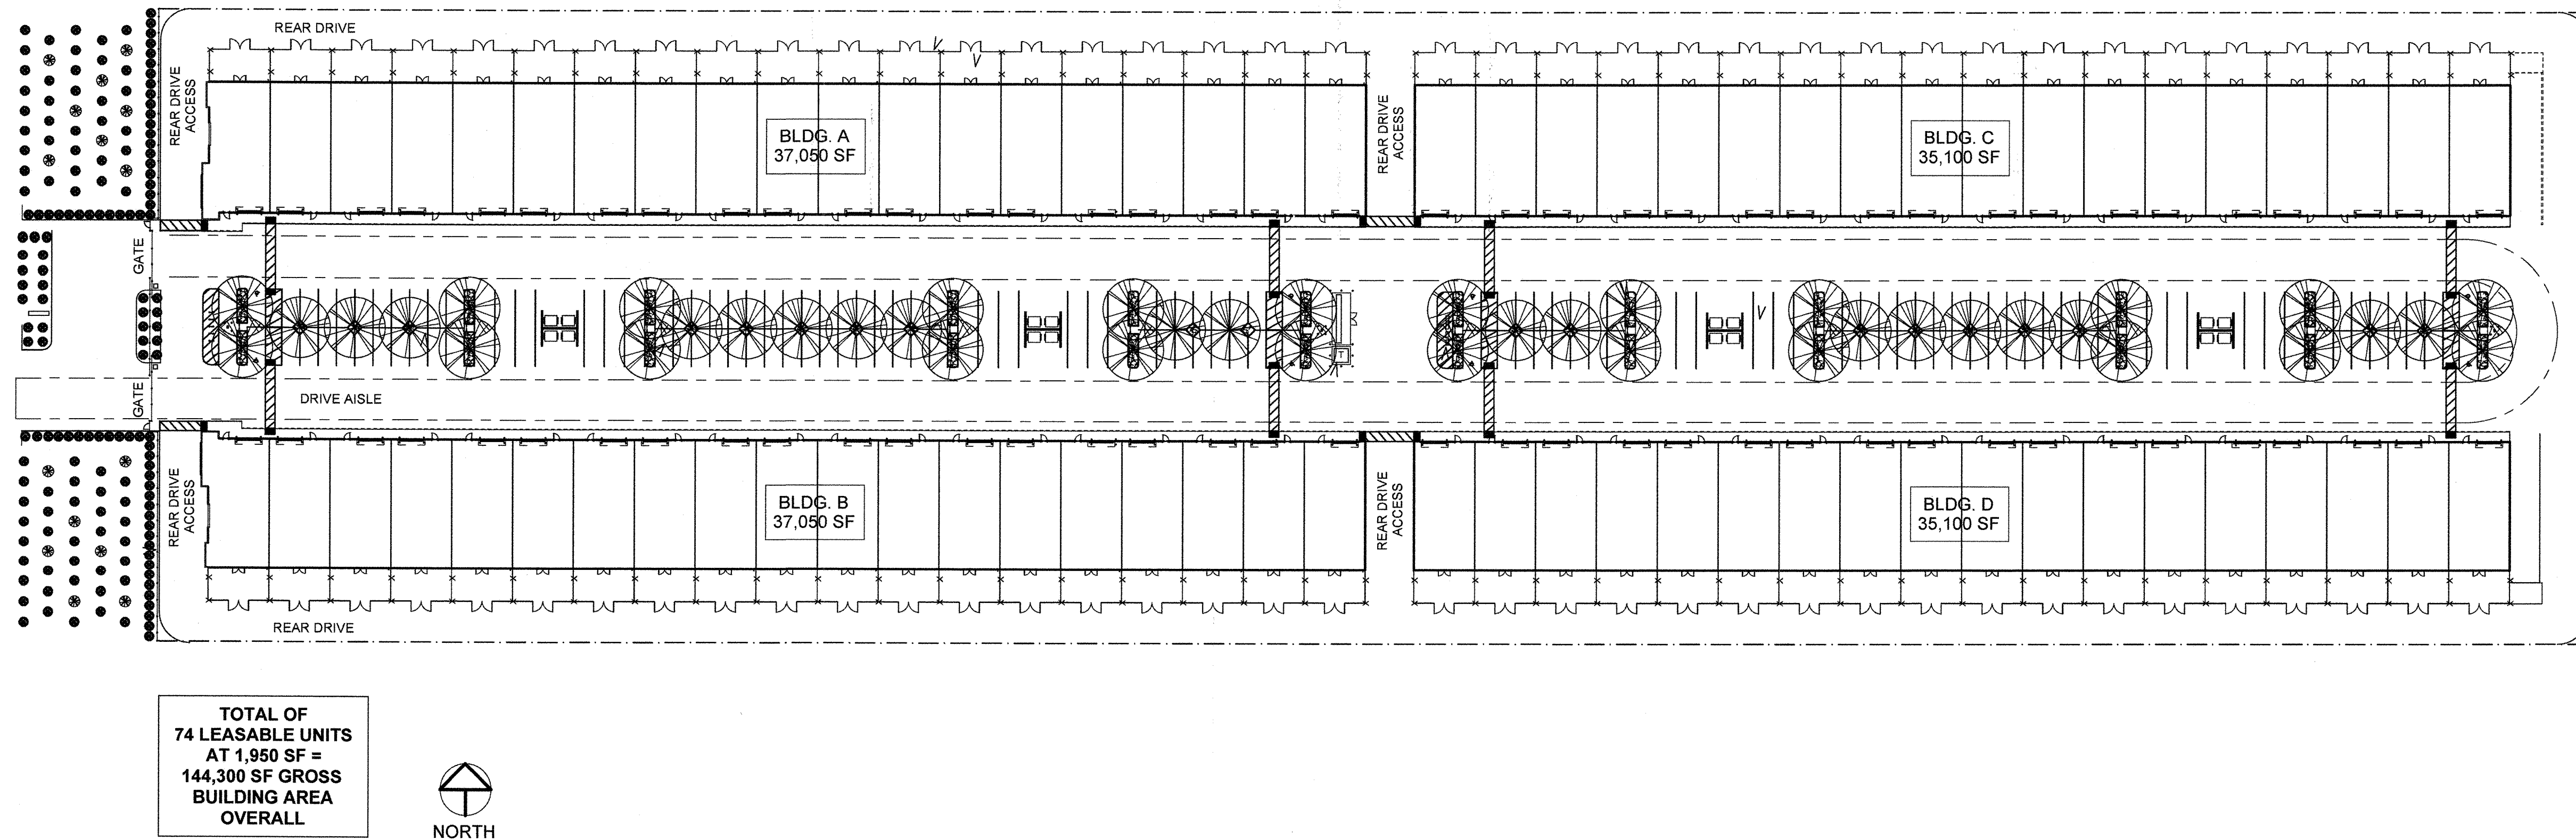

1 MECHANICAL SITE PLAN  
M1 1" = 50'-0"

20190303  
City of Madera  
Building Department  
The approval of these plans does not prevent the City of Madera from requiring correction of errors or omissions in the plans, specifications, construction, or materials. Subject to field inspections and approvals by the City Engineer.  
APPROVED  
By: [Signature]  
Date: MAR 03 2022

These plans or drawings or any part of these publications are the exclusive property of VAR, and may not be reproduced, or transmitted in any form or by means, recording, electronic, mechanical, photocopying or otherwise without written permission by VAR. Copies of these drawings are supplied to the owner or the Building Contractor and, otherwise for the use of this project only. Any Re-use of these drawings or documents is prohibited without the written permission of VAR. If VAR is not awarded the project, VAR will not warrant these plans, drawings or contents and will not assume any liability or responsibility for the unauthorized use of these plans or drawings, and the plans or drawings and contents must be returned to VAR, immediately.

**Air Conditioning & Heating**  
Custom Sheet Metal  
Sales & Service

**VAR**  
Since 1970  
825 S Topeka Ave  
Fresno CA, 93721  
559-237-3188

Signed *Steve Mendrin* Date **9-9-21**  
Steve Mendrin  
License #689806  
Valley Air Conditioning & Repair.

Valley Air Conditioning & Repair, Inc.  
**VAR**  
Since 1970

**50 Years of**  
Indoor comfort.

**DBKO**  
DESIGN-BUILD  
LIC#103083

BY	
REVISION	
DATE	
SEAL	

**Mechanical site plan**


**LEASE FLEX. / WAREHOUSE BUILDINGS**

**MADERA INDUSTRIAL WHSE, LLC**

S. SCHNOOR AVENUE, MADERA, CA


JOB NUMBER	21107
DESIGNED BY	RT
DRAWN BY	CD
DATE	9/9/21
SHEET NUMBER	M1



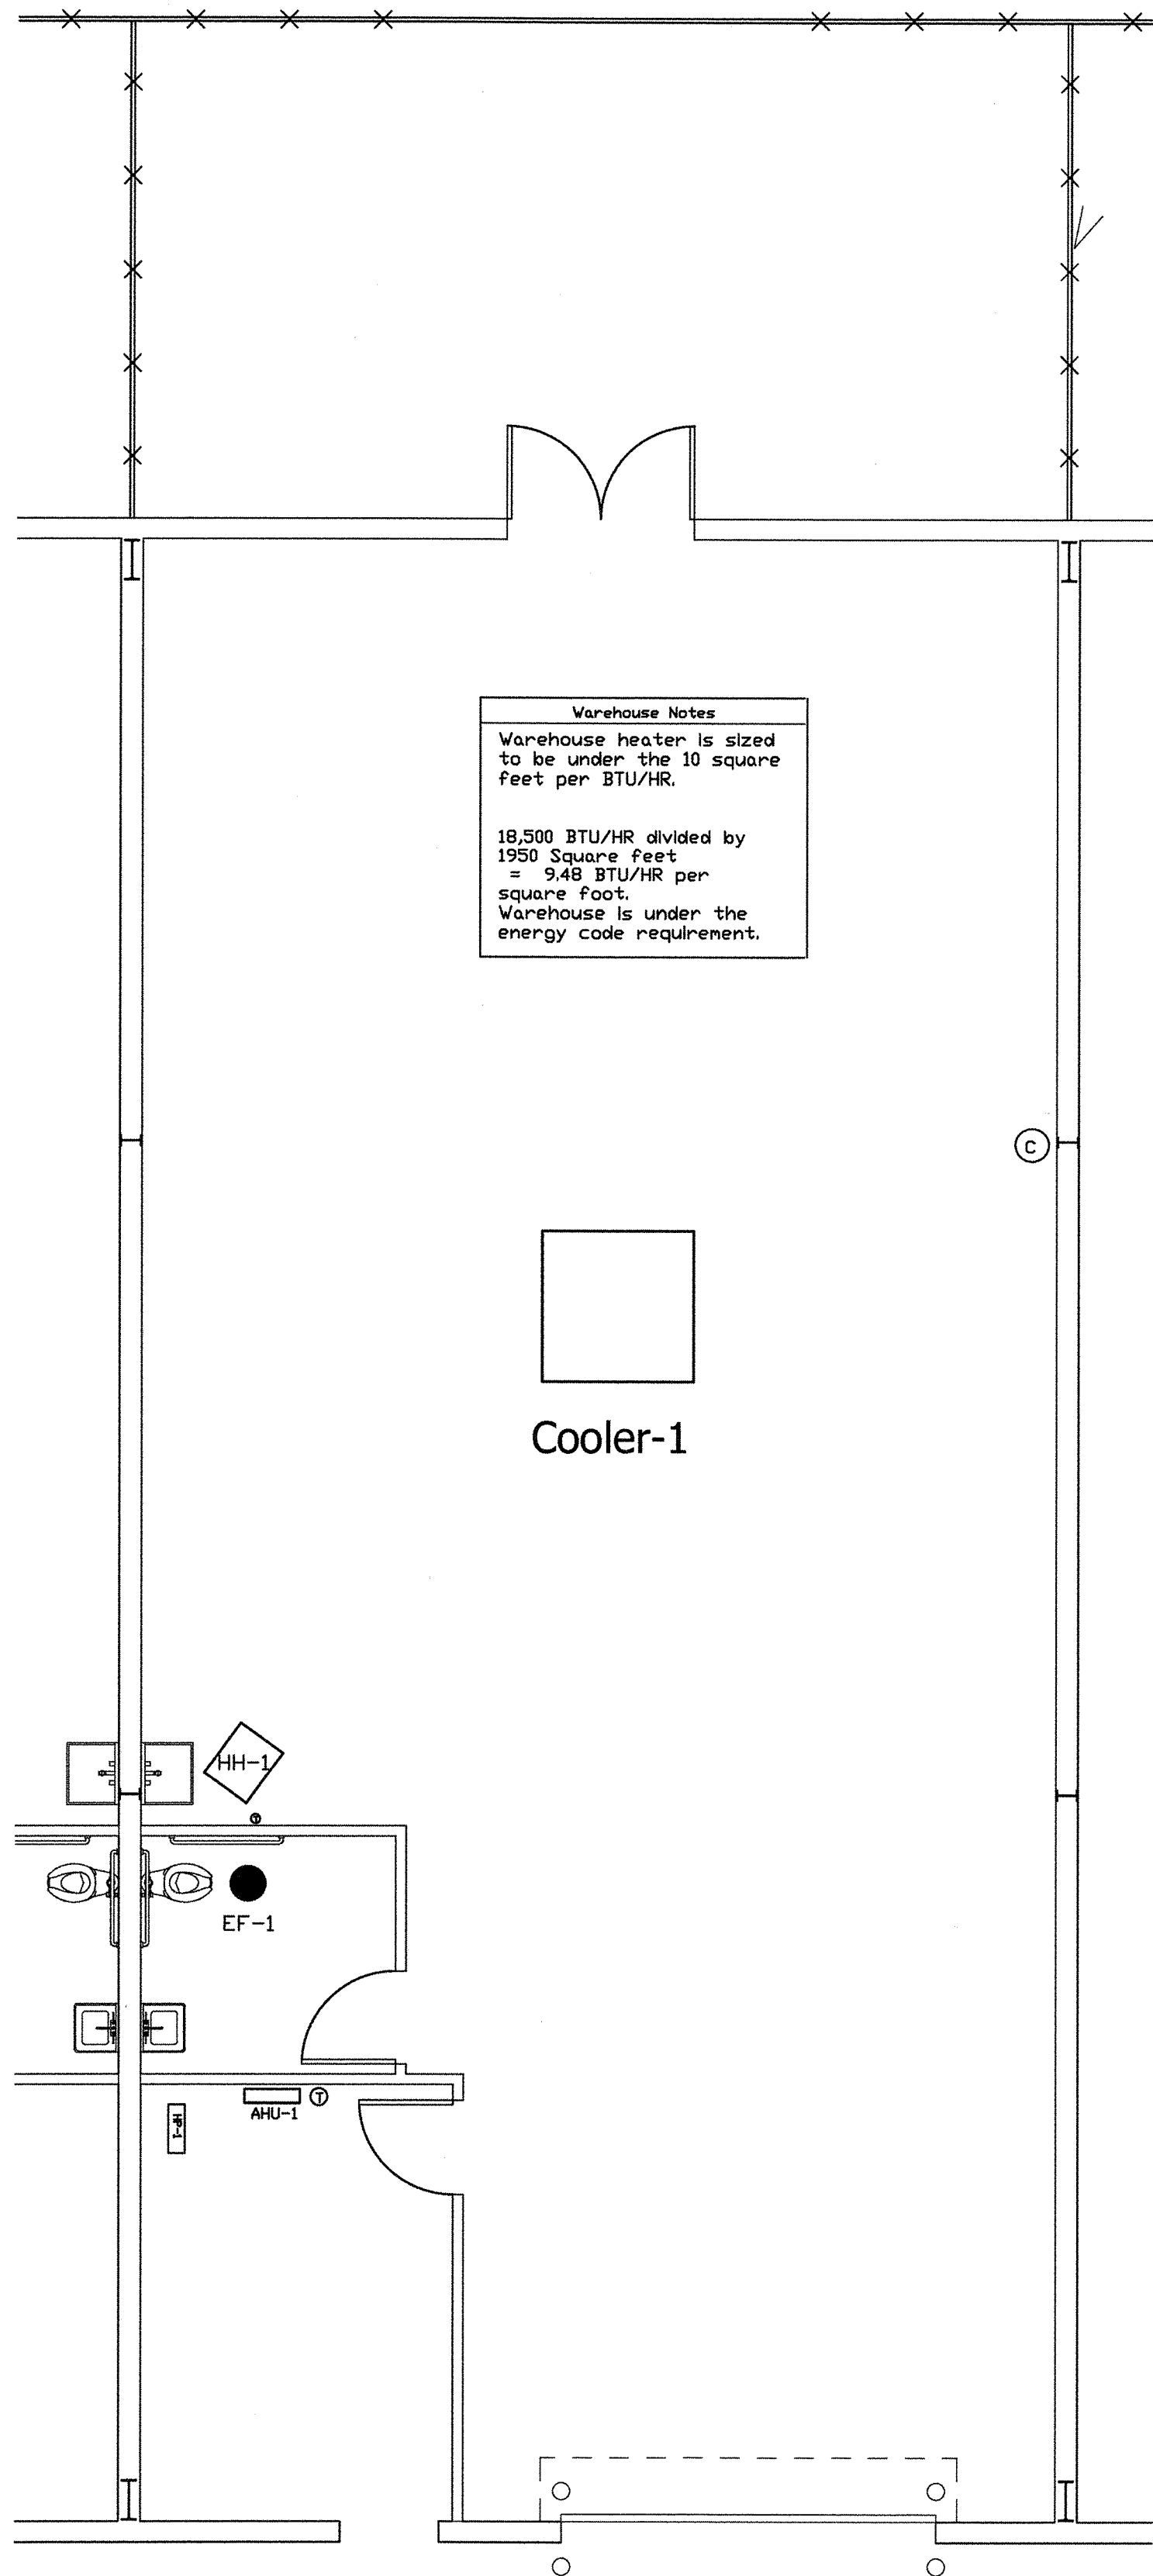

Warehouse heater is sized to be under the 10 square feet per BTU/HR.

18,500 BTU/HR divided by 1950 Square feet = 9.49 BTU/HR per square foot. Warehouse is under the energy code requirement.

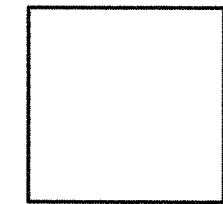

Cooler-1

**NOTES**

Ductless split system condensate to be ran in to nearest vent pipe. To be installed by plumber.

Controller for Evap cooler to be mounted on wall 48" above finished floor.

Thermostat for ductless split system to be located 48" above finished floor.

- LEGEND**
- ☒ SUPPLY AIR
  - ☒ RETURN AIR
  - Ceiling mount exhaust fan with duct to roof top vent.
  - MANUAL DAMPER
  - ⑪ Smoke detector, located in supply air plenum.
  - ⑪ CO2 detector located in space 3'-6" above finished floor.
  - ① THERMOSTAT: MOUNT 48" to top of thermostat A.F.F.
  - ③ SENSOR FOR THERMOSTAT, located in return air duct.
  - AHU AIR HANDLING UNIT
  - CFM CUBIC FEET PER MINUTE
  - CU CONDENSING UNIT
  - EF EXHAUST FAN
  - SAD SUPPLY AIR DIFFUSER
  - SAG SUPPLY AIR GRILLE
  - SAR SUPPLY AIR REGISTER
  - SF SUPPLY FAN
  - RAG RETURN AIR GRILLE
  - RTU ROOF TOP UNIT


DUCTLESS SPLIT SYSTEM SCHEDULE:														
						COMPRESSOR			Heat pump					
UNIT	AC Section	CFM.	MCA	MOCP	VOLTS PHASE	RLA	LRA	COOLING CAPACITY	HSPF	HEATING	Refrigerant	Veight	MAKE/MODEL	EER/Seer RATING
AHU-1	Indoor section	453			208/230/1			9,000		12,000	R410A	29	Fujitsu AUU30RGLX	
HP-1	Outdoor section		9.7	15	208/230/1				13		R410A	68	Fujitsu ADU30RGLX	14 eer 26 Seer

FAN SCHEDULE								
UNIT	AREA SERVED	CFM.	SP.	MOTOR		RPM	MAKE AND MODEL	REMARKS
				HP	VOLTS PHASE			
EF-1	Bathrooms	100	125	1/12	120 1		Broan L100	CONTROLLED BY LIGHTING CIRCUIT. PROVIDE BACKDRAFT DAMPER 6' EXHAUST FAN DUCT TO T-TOP ROOF VENT..


Hanging Heater SCHEDULE								
UNIT	AREA SERVED	CFM.	KW.	MOTOR		RPM	MAKE AND MODEL	REMARKS
				HP	VOLTS PHASE			
HH-1	Warehouse	830	3	1/15	240 1		Modine HER50C1201	CONTROLLED BY low voltage thermostat. Wall mounted
MCA = 42 AMPS.      Heating capacity = 18,500      Weight = 67 lbs								

New Evaporative cooler														
UNIT		CFM.	MCA	MOCP	VOLTS PHASE	Electrical						weight	MAKE/MODEL	Seer/Eer RATING
						MCA								
C-1	warehouse	10,000	7.0	15	208/230 Single Ph	7.0						201	Breezair TBS1	
Install Factory wall mounted Controller.														



New Evaporative coolers

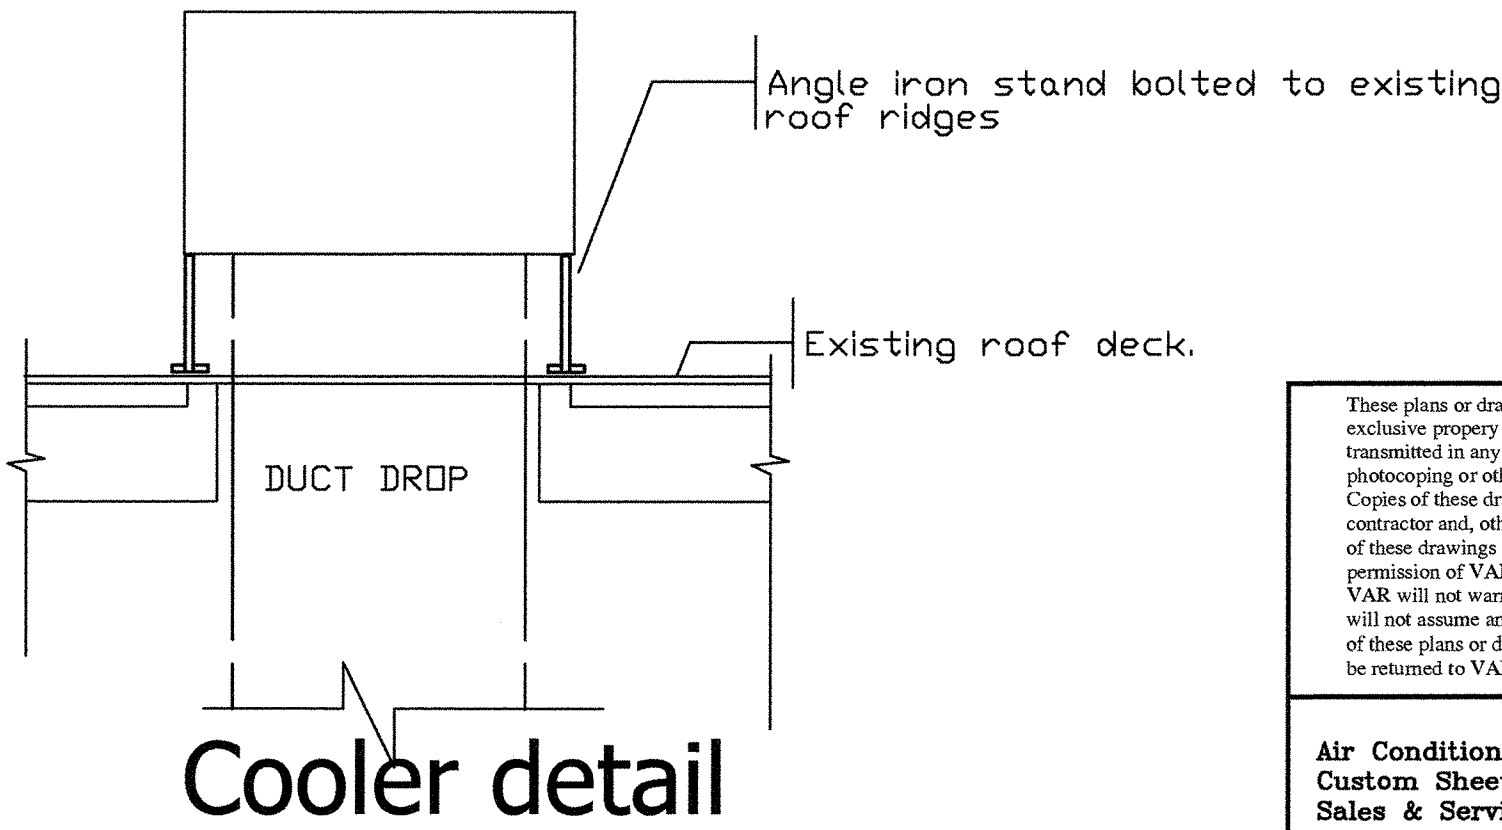

Exhaust fan detail. Ducts to be vented to outside.

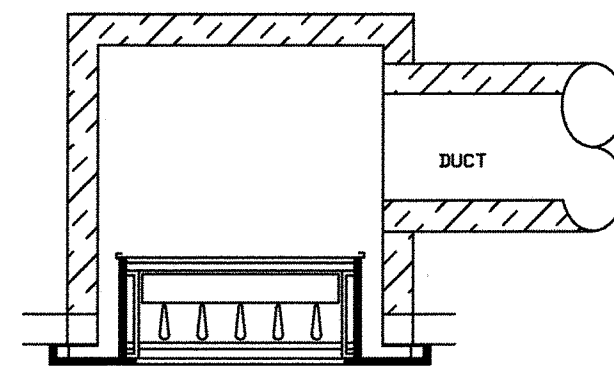

2019CDBC  
City of Madera  
Building Department  
The approval of these plans does not prevent the City of Madera from requiring correction of errors or omission in the plans, specifications or construction. Subject to the inspections and approvals of the City of Madera.  
By: *[Signature]*  
Date: MAR 03 2022

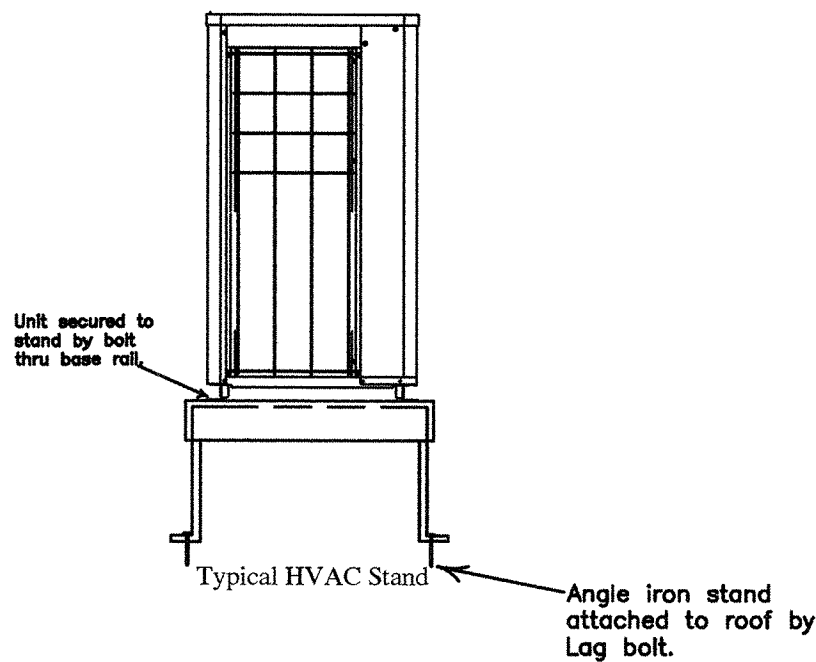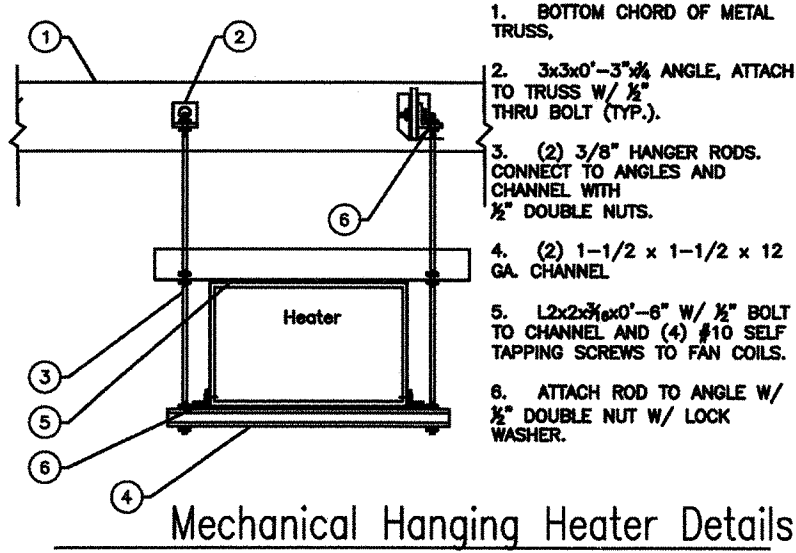

These plans or drawings or any part of these publications are the exclusive property of VAR, and may not be reproduced, or transmitted in any form or by means, recording, electronic, mechanical, photocopying or otherwise without written permission by VAR. Copies of these drawings are supplied to the owner or the Building contractor and, otherwise for the use of this project only. Any Re-use of these drawings or documents is prohibited without the written permission of VAR. If VAR is not awarded the project, VAR will not warranty these plans, drawings or contents and will not assume any liability or responsibility for the unauthorized use of these plans or drawings, and the plans or drawings and contents must be returned to VAR immediately.

Air Conditioning & Heating  
Custom Sheet Metal  
Sales & Service

**VAR**  
Since 1970  
825 S Topeka Ave  
Fresno CA, 93721  
559-237-3188

Signed: *Steve Mendrin* Date: 9-10-21  
Steve Mendrin  
License #689808  
Valley Air Conditioning & Repair.



50 Years of Indoor comfort.



ANY INFORMATION OR DATA ON THIS DRAWING IS NOT INTENDED TO BE SUITABLE FOR REUSE BY ANY PERSON, FIRM, CORPORATION, OR ANY OTHERS ON EXTENSIONS OF THIS PROJECT OR FOR ANY USE ON ANY OTHER PROJECT. ANY REUSE WITHOUT WRITTEN VERIFICATION AND ADAPTATION BY THE ENGINEER FOR THE SPECIFIC PROJECT, THE USER'S SOLE RISK AND WITHOUT LIABILITY OR LEGAL ENFORCEMENT TO THE ENGINEER.

**TYPICAL MECHANICAL FLOOR PLAN**  
LEASE FLEX: / WAREHOUSE BUILDINGS  
FOR  
MADERA INDUSTRIAL WHSE, LLC  
S. SCHNOOR AVENUE, MADERA, CA

JOB NUMBER 21107  
DESIGNED BY  
DRAWN BY  
DATE 9/09/2021  
SHEET NUMBER



Project Name:	Madera Industrial WISE	NRCC-PRF-01-E	Page 1 of 39
Project Address:	5. Schnoor Avenue Madera	Calculation Date/Time:	10/23, Thu, Nov 18, 2021
Input File Name:	2020.264 Energy Calcs (2x4).cld19x		
<b>A. GENERAL INFORMATION</b>			
1 Project Location (city)	Madera	8 Standards Version	Compliance2019
2 CA Zip Code		9 Compliance Software (version)	EnergyPro 8.2
3 Climate Zone	13	10 Weather File	FRESNO_723890_CZ2010.epw
4 Total Conditioned Floor Area in Scope	12,069 ft <sup>2</sup>	11 Building Orientation (deg)	(N) 0 deg
5 Total Unconditioned Floor Area	136,101 ft <sup>2</sup>	12 Permitted scope of Work	New/Complete
6 Total # of Stories (Habitable Above Grade)	1	13 Building Type(s)	Nonresidential
7 Total # of dwelling units	0	14 Gas Type	NaturalGas
<b>B. PROJECT SUMMARY</b>			
Table Instructions: Table B shows which building components are included in the performance calculation. If indicated as not included, the project must show compliance prescriptively if within permit application.			
Building Components Complying via Performance			
Envelope (see Table G)	<input checked="" type="checkbox"/> Performance	Covered Process: Commercial Kitchens	<input type="checkbox"/> Performance
	<input type="checkbox"/> Not Included		<input checked="" type="checkbox"/> Not Included
Mechanical (see Table H)	<input checked="" type="checkbox"/> Performance	Covered Process: Computer Rooms	<input type="checkbox"/> Performance
	<input type="checkbox"/> Not Included		<input checked="" type="checkbox"/> Not Included
Domestic Hot Water (see Table I)	<input checked="" type="checkbox"/> Performance	Covered Process: Laboratory Exhaust	<input type="checkbox"/> Performance
	<input type="checkbox"/> Not Included		<input checked="" type="checkbox"/> Not Included
Lighting (Indoor Conditioned, see Table J)	<input checked="" type="checkbox"/> Performance		
	<input type="checkbox"/> Not Included		
Solar Thermal Water Heating (see Table K)	<input checked="" type="checkbox"/> Performance		
	<input type="checkbox"/> Not Included		

CA Building Energy Efficiency Standards- 2019 Nonresidential Compliance Report Version: NRCC-PRF-01-E-09022021-6384 Report Generated at: 2021-11-18 10:44:49

Project Name:	Madera Industrial WISE	NRCC-PRF-01-E	Page 5 of 39							
Project Address:	5. Schnoor Avenue Madera	Calculation Date/Time:	10/23, Thu, Nov 18, 2021							
Input File Name:	2020.264 Energy Calcs (2x4).cld19x									
G3. OPAQUE SURFACE ASSEMBLY SUMMARY										
1	2	3	4	5	6	7	8	9	10	11
Surface Name	Surface Type	Area (ft <sup>2</sup> )	Framing Type	Cavity R-Value	Continuous R-Value	Units	Value	Description of Assembly Layers		Level
Exterior Metal Building Wall	ExteriorWall	17930	NA	26	NA	U-Factor	0.055	Metal Siding - 1/2 in. Metal building wall, double layer batt, R-36 Gypsum Board - 5/8 in.	N	
2x4 Metal Stud wall25	InteriorWall	13938	Metal	13	NA	U-Factor	0.170	Metal framed wall, 2x4n, OC, 3.5 in., R-13 Gypsum Board - 5/8 in.	N	
Metal Building Roof (Builtup)	Roof	130629	NA	10	NA	U-Factor	0.115	Metal Standing seam - 1/2 in. Metal standing seam roof, R-10	N	
Exterior Metal Building Wall	ExteriorWall	88664	NA	0	NA	U-Factor	1.176	Metal Siding - 1/2 in. Metal building wall, single layer batt, R-0	N	
Interior Warehouse Demin41	InteriorWall	18298	NA	19	NA	U-Factor	0.063	Gypsum Board - 5/8 in. Metal building wall, double layer batt, R-19	N	
Interior Office Demin54	InteriorWall	9450	NA	19	NA	U-Factor	0.063	Metal building wall, double layer batt, R-19 Gypsum Board - 5/8 in.	N	
Interior Restroom Demin63	InteriorWall	5040	NA	19	NA	U-Factor	0.063	Gypsum Board - 5/8 in. Metal building wall, double layer batt, R-19 Gypsum Board - 5/8 in.	N	
1 - District H - New, A - Altered, F - Existing										
G4. OPAQUE DOOR SUMMARY										
1	2	3								
Assembly Name	Overall U-Factor	Status <sup>1</sup>								
Wood Door16	0.500	N								

CA Building Energy Efficiency Standards- 2019 Nonresidential Compliance Report Version: NRCC-PRF-01-E-09022021-6384 Report Generated at: 2021-11-18 10:44:49

Project Name:	Madera Industrial WISE	NRCC-PRF-01-E		Page 9 of 33									
Project Address:	5. Schnoor Avenue Madera	Calculation Date/Time:		10/23, Thu, Nov 18, 2021									
Input File Name:	2020.264 Energy Calcs (2x4).cld19x												
H1. DRY SYSTEM EQUIPMENT (furnaces, air handling units, heat pumps, VRF, economizers etc.)													
		1	2	3	4	5	6	7	8	9	10	11	12
		Heating						Cooling		Economizer Type (if present)			
Equipment Name	Equipment Type	Qty	Total Heating Output (Btu/h)	Supp Heat Output (Btu/h)	Efficiency Unit	Efficiency	Total Cooling Output (Btu/h)	Efficiency Unit	Efficiency				
Building B Suite #19	SZAC (SplitPhase)	1	12	0			9	SEER EER	14,000 12,200			NoEconomizer	N
Building C Suite #1	SZAC (SplitPhase)	1	12	0			9	SEER EER	14,000 12,200			NoEconomizer	N
Building C Suite #2	SZAC (SplitPhase)	1	12	0			9	SEER EER	14,000 12,200			NoEconomizer	N
Building C Suite #3	SZAC (SplitPhase)	1	12	0			9	SEER EER	14,000 12,200			NoEconomizer	N
Building C Suite #4	SZAC (SplitPhase)	1	12	0			9	SEER EER	14,000 12,200			NoEconomizer	N
Building C Suite #5	SZAC (SplitPhase)	1	12	0			9	SEER EER	14,000 12,200			NoEconomizer	N
Building C Suite #6	SZAC (SplitPhase)	1	12	0			9	SEER EER	14,000 12,200			NoEconomizer	N
Building C Suite #7	SZAC (SplitPhase)	1	12	0			9	SEER EER	14,000 12,200			NoEconomizer	N
Building C Suite #8	SZAC (SplitPhase)	1	12	0			9	SEER EER	14,000 12,200			NoEconomizer	N
Building C Suite #9	SZAC (SplitPhase)	1	12	0			9	SEER EER	14,000 12,200			NoEconomizer	N
Building C Suite #10	SZAC (SplitPhase)	1	12	0			9	SEER EER	14,000 12,200			NoEconomizer	N
Building C Suite #11	SZAC (SplitPhase)	1	12	0			9	SEER EER	14,000 12,200			NoEconomizer	N
Building C Suite #12	SZAC (SplitPhase)	1	12	0			9	SEER EER	14,000 12,200			NoEconomizer	N
Building C Suite #13	SZAC (SplitPhase)	1	12	0			9	SEER EER	14,000 12,200			NoEconomizer	N

CA Building Energy Efficiency Standards- 2019 Nonresidential Compliance Report Version: NRCC-PRF-01-E-09022021-6384 Report Generated at: 2021-11-18 10:44:49

Project Name:	Madera Industrial WISE	NRCC-PRF-01-E	Page 2 of 33
Project Address:	5. Schnoor Avenue Madera	Calculation Date/Time:	10/23, Thu, Nov 18, 2021
Input File Name:	2020.264 Energy Calcs (2x4).cld19x		
<b>C1. COMPLIANCE RESULTS FOR PERFORMANCE COMPONENTS (Annual TDV Energy Use, kBtu/ft<sup>2</sup>-yr)</b>			
<b>COMPLIES</b>			
Energy Component	Standard Design (TDV)	Proposed Design (TDV)	Compliance Margin (TDV) <sup>1</sup>
Space Heating	35.66	47.54	-11.88
Space Cooling	139.70	123.78	15.92
Indoor Fans	206.89	140.42	66.47
Heat Rejection	---	---	---
Pumps & Misc.	---	---	---
Domestic Hot Water	22.62	35.21	-12.59
Indoor Lighting	43.34	43.34	---
<b>ENERGY STANDARDS COMPLIANCE TOTAL</b>	<b>448.21</b>	<b>390.29</b>	<b>57.92 (12.9%)</b>
<sup>1</sup> Notes: The number in parenthesis following the Compliance Margin in column 4, represents the Percent Better than Standard.			
<b>C2. RESULTS FOR 'ABOVE CODE' QUALIFICATIONS<sup>1</sup></b>			
This project is pursuing California Tier 1			
This project is pursuing California Tier 2			
Miscellaneous Energy Component	Standard Design (TDV)	Proposed Design (TDV)	Compliance Margin (TDV) <sup>1</sup>
Receptacle	284.67	284.67	---
Process	---	---	---
Other Lgt	319.79	319.79	---
Process Motors	---	---	---
<b>COMPLIANCE TOTAL PLUS MISCELLANEOUS COMPONENTS</b>	<b>1,063.67</b>	<b>994.75</b>	<b>57.9 (5.5%)</b>
<sup>1</sup> Notes: This table is used to document compliance with programs OTHER THAN Title 24 Part 6, if applicable.			

CA Building Energy Efficiency Standards- 2019 Nonresidential Compliance Report Version: NRCC-PRF-01-E-09022021-6384 Report Generated at: 2021-11-18 10:44:49

Project Name:	Madera Industrial WISE	NRCC-PRF-01-E	Page 6 of 33		
Project Address:	5. Schnoor Avenue Madera	Calculation Date/Time:	10/23, Thu, Nov 18, 2021		
Input File Name:	2020.264 Energy Calcs (2x4).cld19x				
G4. OPAQUE DOOR SUMMARY					
1		2		3	
Assembly Name		Overall U-factor		Status <sup>1</sup>	
Metal Door20		0.700		N	
Roll-up Door64		1.450		N	

H1. DRY SYSTEM EQUIPMENT (furnaces, air handling units, heat pumps, VRF, economizers etc.)												
1	2	3	4	5	6	7	8	9	10	11	12	
Equipment Name	Equipment Type	Qty	Heating			Cooling			Economizer Type (if present)	Comments		
			Total Heating Output (kBtu/h)	Supp Heat Output (kBtu/h)	Efficiency Unit	Efficiency	Total Cooling Output (kBtu/h)	Efficiency Unit			Efficiency	
Building A Suite #1	SZAC (Split1Phase)	1	12	0			9	SEER	14.000 EER 12.200	NoEconomizer	N	
Building A Suite #2	SZAC (Split1Phase)	1	12	0			9	SEER	14.000 EER 12.200	NoEconomizer	N	
Building A Suite #3	SZAC (Split1Phase)	1	12	0			9	SEER	14.000 EER 12.200	NoEconomizer	N	
Building A Suite #4	SZAC (Split1Phase)	1	12	0			9	SEER	14.000 EER 12.200	NoEconomizer	N	
Building A Suite #5	SZAC (Split1Phase)	1	12	0			9	SEER	14.000 EER 12.200	NoEconomizer	N	
Building A Suite #6	SZAC (Split1Phase)	1	12	0			9	SEER	14.000 EER 12.200	NoEconomizer	N	
Building A Suite #7	SZAC (Split1Phase)	1	12	0			9	SEER	14.000 EER 12.200	NoEconomizer	N	
Building A Suite #8	SZAC (Split1Phase)	1	12	0			9	SEER	14.000 EER 12.200	NoEconomizer	N	
Building A Suite #9	SZAC (Split1Phase)	1	12	0			9	SEER	14.000 EER 12.200	NoEconomizer	N	

CA Building Energy Efficiency Standards- 2019 Nonresidential Compliance Report Version: NRCC-PRF-01-E-09022021-6384 Report Generated at: 2021-11-18 10:44:49

Project Name:	Madera Industrial WISE	NRCC-PRF-01-E	Page 10 of 39									
Project Address:	5. Schnoor Avenue Madera	Calculation Date/Time:	10/23, Thu, Nov 18, 2021									
Input File Name:	2020.264 Energy Calcs (2x4).cld19x											
H1. DRY SYSTEM EQUIPMENT (furnaces, air handling units, heat pumps, VRF, economizers etc.)												
1	2	3	4	5	6	7	8	9	10	11	12	
			Heating				Cooling					
Equipment Name	Equipment Type	Qty	Total Heating Output (Btu/h)	Supp Heat Output (Btu/h)	Efficiency Unit	Efficiency	Total Cooling Output (Btu/h)	Efficiency Unit	Efficiency	Economizer Type (if present)	Comments	
Building C Suite #14	SZAC (SplitPhase)	1	12	0			SEER EER	14,000 12,200		NoEconomizer	N	
Building C Suite #15	SZAC (SplitPhase)	1	12	0			SEER EER	14,000 12,200		NoEconomizer	N	
Building C Suite #16	SZAC (SplitPhase)	1	12	0			SEER EER	14,000 12,200		NoEconomizer	N	
Building C Suite #17	SZAC (SplitPhase)	1	12	0			SEER EER	14,000 12,200		NoEconomizer	N	
Building C Suite #18	SZAC (SplitPhase)	1	12	0			SEER EER	14,000 12,200		NoEconomizer	N	
Building C Suite #19	SZAC (SplitPhase)	1	12	0			SEER EER	14,000 12,200		NoEconomizer	N	
Building D Suite #1	SZAC (SplitPhase)	1	12	0			SEER EER	14,000 12,200		NoEconomizer	N	
Building D Suite #2	SZAC (SplitPhase)	1	12	0			SEER EER	14,000 12,200		NoEconomizer	N	
Building D Suite #3	SZAC (SplitPhase)	1	12	0			SEER EER	14,000 12,200		NoEconomizer	N	
Building D Suite #4	SZAC (SplitPhase)	1	12	0			SEER EER	14,000 12,200		NoEconomizer	N	
Building D Suite #5	SZAC (SplitPhase)	1	12	0			SEER EER	14,000 12,200		NoEconomizer	N	
Building D Suite #6	SZAC (SplitPhase)	1	12	0			SEER EER	14,000 12,200		NoEconomizer	N	
Building D Suite #7	SZAC (SplitPhase)	1	12	0			SEER EER	14,000 12,200		NoEconomizer	N	
Building D Suite #8	SZAC (SplitPhase)	1	12	0			SEER EER	14,000 12,200		NoEconomizer	N	

CA Building Energy Efficiency Standards- 2019 Nonresidential Compliance Report Version: NRCC-PRF-01-E-09022021-6384 Report Generated at: 2021-11-18 10:44:49

Project Name:	Madera Industrial WISE	NRCC-PRF-01-E	Page 3 of 33			
Project Address:	5. Schnoor Avenue Madera	Calculation Date/Time:	10/23, Thu, Nov 18, 2021			
Input File Name:	2020.264 Energy Calcs (2x4).cld19x					
<b>C3. ENERGY USE SUMMARY</b>						
Energy Component	Standard Design Size (MMBtu)	Proposed Design Size (MMBtu)	Margin (MMBtu)	Standard Design Size (MMBtu)	Proposed Design Size (MMBtu)	Margin (MMBtu)
Space Heating		22.9		209.1		
Space Cooling	41.0	39.2	1.8			
Indoor Fans	85.1	59.7	25.4			
Heat Rejection						
Pumps & Misc.						
Domestic Hot Water	10.0	15.5	-5.5			
Indoor Lighting	19.0	39.0	0.0			
Compliance Total	155.1	150.3	-1.2	209.1	0.0	
Receptacle	126.3	126.3	0.0			
Process						
Other Lgt	140.5	140.5	0.0			
Process Motors						
TOTAL	421.9	423.1	-1.2	209.1	0.0	

**D. EXCEPTIONAL CONDITIONS**  
The user model includes space(s) that are designed to be served by mechanical cooling systems, but the cooling systems were not included in the simulation model. A cooling system has been modeled for both the proposed and standard cases.  
The user model includes space(s) without sufficient cooling equipment. Cooling equipment has been added to the model to meet cooling loads.

**E. HERS VERIFICATION**  
This Section Does Not Apply

CA Building Energy Efficiency Standards- 2019 Nonresidential Compliance Report Version: NRCC-PRF-01-E-09022021-6384 Report Generated at: 2021-11-18 10:44:49

Project Name:	Madera Industrial WISE	NRCC-PRF-01-E				Page 7 of 33			S			
Project Address:	5. Schnoor Avenue Madera	Calculation Date/Time:				10/23, Thu, Nov 18, 2021			S			
Input File Name:	2020.264 Energy Calcs (2x4).cld19x											
H1. DRY SYSTEM EQUIPMENT (furnaces, air handling units, heat pumps, VRF, economizers etc.)												
1	2	3	4	5	6	7	8	9	10	11	12	
			Heating				Cooling				Economizer Type (if present)	
Equipment Name	Equipment Type	Qty	Total Heating Output (Btu/h)	Supp Heat Output (Btu/h)	Efficiency Unit	Efficiency	Total Cooling Output (Btu/h)	Efficiency Unit	Efficiency			
Building A Suite #10	SZAC (Split1Phase)	1	12	0			SEER EER	14,000 12,200		NoEconomizer	N	
Building A Suite #11	SZAC (Split1Phase)	1	12	0			SEER EER	14,000 12,200		NoEconomizer	N	
Building A Suite #12	SZAC (Split1Phase)	1	12	0			SEER EER	14,000 12,200		NoEconomizer	N	
Building A Suite #13	SZAC (Split1Phase)	1	12	0			SEER EER	14,000 12,200		NoEconomizer	N	
Building A Suite #14	SZAC (Split1Phase)	1	12	0			SEER EER	14,000 12,200		NoEconomizer	N	
Building A Suite #15	SZAC (Split1Phase)	1	12	0			SEER EER	14,000 12,200		NoEconomizer	N	
Building A Suite #16	SZAC (Split1Phase)	1	12	0			SEER EER	14,000 12,200		NoEconomizer	N	
Building A Suite #17	SZAC (Split1Phase)	1	12	0			SEER EER	14,000 12,200		NoEconomizer	N	
Building A Suite #18	SZAC (Split1Phase)	1	12	0			SEER EER	14,000 12,200		NoEconomizer	N	
Building A Suite #19	SZAC (Split1Phase)	1	12	0			SEER EER	14,000 12,200		NoEconomizer	N	
Building B Suite #1	SZAC (Split1Phase)	1	12	0			SEER EER	14,000 12,200		NoEconomizer	N	
Building B Suite #2	SZAC (Split1Phase)	1	12	0			SEER EER	14,000 12,200		NoEconomizer	N	
Building B Suite #3	SZAC (Split1Phase)	1	12	0			SEER EER	14,000 12,200		NoEconomizer	N	
Building B Suite #4	SZAC (Split1Phase)	1	12	0			SEER EER	14,000 12,200		NoEconomizer	N	



CA Building Energy Efficiency Standards- 2019 Nonresidential Compliance      Report Version: NRCC-PRF-01-E-0902021-6384      Report Generated at: 2021-11-18 10:44:49












<p>These plans or drawings or any part of these publications are the exclusive property of VAR, and may not be reproduced, or transmitted in any form or by means, recording, electronic, mechanical, photocopying or otherwise without written permission by VAR. Copies of these drawings are supplied to the owner or the Building contractor and, otherwise for the use of this project only. Any Re-use of these drawings or documents is prohibited without the written permission of VAR. If VAR is not awarded the project, VAR will not warranty these plans, drawings or contents and will not assume any liability or responsibility for the unauthorized use of these plans or drawings, and the plans or drawings and contents must be returned to VAR immediately.</p>	<div style="text-align: center;"> <h1>VAR</h1> <p>Since 1970</p> <p><b>885 S Topoka Ave</b>  <b>Tucson, AZ 85711</b>  <b>520-297-8188</b></p> </div>
<p><b>Air Conditioning &amp; Heating</b>  <b>Custom Sheet Metal</b>  <b>Sales &amp; Service</b></p>	<p><b>Since Steve Mendez</b> 11-18-21</p> <p><b>Steve Mendez</b>  <b>Phone 520-550-0808</b>  <b>Consultations &amp; Service</b></p>



**50 Years of  
Indoor comfort.**

**TYPICAL MECHANICAL FLOOR PLAN**  
**LEASE FLEX. / WAREHOUSE BUILDINGS**  
**FOR**  
**MADERA INDUSTRIAL WHSE, LLC**  
**S. SCHNOOR AVENUE, MADERA, CA**

JOB NUMBER	21107
DESIGNED BY	
DRAWN BY	
DATE	9/09/2021
SHEET NUMBER	M4



Project Name:	Madera Industrial WHSE	NRCC-PHF-01-E	Page 25 of 33
Project Address:	5, Schnoor Avenue Madera	Calculation Date/Time:	10/23, Thu, Nov 18, 2021
Input File Name:	2020.264 Energy Calcs (2x4).cld19x		

1	2	3	4	5	6	7	8	9
Zone Name	Ventilation Function	# of hotel rooms	# of people	# of bedrooms	Supply OA CFM	Exhaust CFM	Conditioned Area (sf)	DCV or Occupant Sensor Controls, or Both
154-Office C-14	Office - Office space	0	0.79	0	24	0	159	NA
157-Office C-15	Office - Office space	0	0.79	0	24	0	159	NA
160-Office C-16	Office - Office space	0	0.79	0	24	0	159	NA
163-Office C-17	Office - Office space	0	0.79	0	24	0	159	NA
166-Office C-18	Office - Office space	0	0.79	0	24	0	159	NA
169-Office C-19	Office - Office space	0	0.79	0	24	0	159	NA
172-Office D-1	Office - Office space	0	0.79	0	24	0	159	NA
175-Office D-2	Office - Office space	0	0.79	0	24	0	159	NA
179-Office D-3	Office - Office space	0	0.79	0	24	0	159	NA
183-Office D-4	Office - Office space	0	0.79	0	24	0	159	NA
184-Office D-5	Office - Office space	0	0.79	0	24	0	159	NA
187-Office D-6	Office - Office space	0	0.79	0	24	0	159	NA
190-Office D-7	Office - Office space	0	0.79	0	24	0	159	NA
193-Office D-8	Office - Office space	0	0.79	0	24	0	159	NA
196-Office D-9	Office - Office space	0	0.79	0	24	0	159	NA
199-Office D-10	Office - Office space	0	0.79	0	24	0	159	NA
202-Office D-11	Office - Office space	0	0.79	0	24	0	159	NA
205-Office D-12	Office - Office space	0	0.79	0	24	0	159	NA
208-Office D-13	Office - Office space	0	0.79	0	24	0	159	NA
211-Office D-14	Office - Office space	0	0.79	0	24	0	159	NA
214-Office D-15	Office - Office space	0	0.79	0	24	0	159	NA
217-Office D-16	Office - Office space	0	0.79	0	24	0	159	NA
220-Office D-17	Office - Office space	0	0.79	0	24	0	159	NA
223-Office D-18	Office - Office space	0	0.79	0	24	0	159	NA
226-Office D-19	Office - Office space	0	0.79	0	24	0	159	NA

CA Building Energy Efficiency Standards: 2019 Nonresidential Compliance Report Version: NRCC-PHF-01-E-09022021-6384 Report Generated at: 2021-11-18 10:44:49

Project Name:	Madera Industrial WHSE	NRCC-PHF-01-E	Page 29 of 33
Project Address:	5, Schnoor Avenue Madera	Calculation Date/Time:	10/23, Thu, Nov 18, 2021
Input File Name:	2020.264 Energy Calcs (2x4).cld19x		

HYD. ZONAL SYSTEM AND TERMINAL UNIT SUMMARY																
1	2	3	4		5	6		7		8		9		10	11	12
System ID	Zone Name	System Type	Rated Capacity (Btuh)		Design	Airflow (cfm)		Fan								
			Heating	Cooling		Min.	Min. Ratio	BHP	Watts	Cycles	ECM Motor					
205-Office D-12-Tm	205-Office D-12	Uncontrolled	NA	NA	453	NA	0.00	NA	NA	NA	NA	NA				
208-Office D-13-Tm	208-Office D-13	Uncontrolled	NA	NA	453	NA	0.00	NA	NA	NA	NA	NA				
211-Office D-14-Tm	211-Office D-14	Uncontrolled	NA	NA	453	NA	0.00	NA	NA	NA	NA	NA				
214-Office D-15-Tm	214-Office D-15	Uncontrolled	NA	NA	453	NA	0.00	NA	NA	NA	NA	NA				
217-Office D-16-Tm	217-Office D-16	Uncontrolled	NA	NA	453	NA	0.00	NA	NA	NA	NA	NA				
220-Office D-17-Tm	220-Office D-17	Uncontrolled	NA	NA	453	NA	0.00	NA	NA	NA	NA	NA				
223-Office D-18-Tm	223-Office D-18	Uncontrolled	NA	NA	453	NA	0.00	NA	NA	NA	NA	NA				
226-Office D-19-Tm	226-Office D-19	Uncontrolled	NA	NA	453	NA	0.00	NA	NA	NA	NA	NA				

1	2	3	4	5	6	7	8	9	10	11	12	13	14
Name	Heater Element Type	Tank Type	Qty	Rated Input (kW)	Rated Input (hp)	Efficiency	Efficiency Unit	Tank Insulation R-value (in/Rx)	Standby Loss Fraction	Heat Pump Type	1st Hour Rating or Flow Rate (gpm)	Tank Location or Ambient Condition	Tank Location or Ambient Condition
Instantaneous Electric2	Electricity	Instantaneous	19	1.00	2.3	kW	0.98	UEF	NA	NA	NA	NA	NA
Instantaneous Electric2 2	Electricity	Instantaneous	19	1.00	2.3	kW	0.98	UEF	NA	NA	NA	NA	NA
Instantaneous Electric2 3	Electricity	Instantaneous	19	1.00	2.3	kW	0.98	UEF	NA	NA	NA	NA	NA
Instantaneous Electric2 4	Electricity	Instantaneous	19	1.00	2.3	kW	0.98	UEF	NA	NA	NA	NA	NA

CA Building Energy Efficiency Standards: 2019 Nonresidential Compliance Report Version: NRCC-PHF-01-E-09022021-6384 Report Generated at: 2021-11-18 10:44:49



Project Name:	Madera Industrial WHSE	NRCC-PHF-01-E	Page 26 of 33
Project Address:	5, Schnoor Avenue Madera	Calculation Date/Time:	10/23, Thu, Nov 18, 2021
Input File Name:	2020.264 Energy Calcs (2x4).cld19x		

Multifamily or Hotel/Motel Occupancy? (If "Yes," see DOMESTIC/SERVICE HOT WATER SYSTEM SUMMARY )												No	
Does the Project include Zone Systems?													Yes
H_ZONAL SYSTEM AND TERMINAL UNIT SUMMARY													
1	2	3	4		5	6	7	8	9	10	11	12	
System ID	Zone Name	System Type	Rated Capacity (Btuh)		Design	Airflow (cfm)	Min.	A1h. Ratio	BHP	Watts	Cycles	ECM Motor	
			Heating	Cooling									
1-Office A-1-Tm	1-Office A-1	Uncontrolled	NA	NA	453	NA	0.00	NA	NA	NA	NA	<input type="checkbox"/>	
4-Office A-2-Tm	4-Office A-2	Uncontrolled	NA	NA	453	NA	0.00	NA	NA	NA	NA	<input type="checkbox"/>	
7-Office A-3-Tm	7-Office A-3	Uncontrolled	NA	NA	453	NA	0.00	NA	NA	NA	NA	<input type="checkbox"/>	
10-Office A-4-Tm	10-Office A-4	Uncontrolled	NA	NA	453	NA	0.00	NA	NA	NA	NA	<input type="checkbox"/>	
13-Office A-5-Tm	13-Office A-5	Uncontrolled	NA	NA	453	NA	0.00	NA	NA	NA	NA	<input type="checkbox"/>	
16-Office A-6-Tm	16-Office A-6	Uncontrolled	NA	NA	453	NA	0.00	NA	NA	NA	NA	<input type="checkbox"/>	
19-Office A-7-Tm	19-Office A-7	Uncontrolled	NA	NA	453	NA	0.00	NA	NA	NA	NA	<input type="checkbox"/>	
22-Office A-8-Tm	22-Office A-8	Uncontrolled	NA	NA	453	NA	0.00	NA	NA	NA	NA	<input type="checkbox"/>	
25-Office A-9-Tm	25-Office A-9	Uncontrolled	NA	NA	453	NA	0.00	NA	NA	NA	NA	<input type="checkbox"/>	
28-Office A-10-Tm	28-Office A-10	Uncontrolled	NA	NA	453	NA	0.00	NA	NA	NA	NA	<input type="checkbox"/>	
31-Office A-11-Tm	31-Office A-11	Uncontrolled	NA	NA	453	NA	0.00	NA	NA	NA	NA	<input type="checkbox"/>	
34-Office A-12-Tm	34-Office A-12	Uncontrolled	NA	NA	453	NA	0.00	NA	NA	NA	NA	<input type="checkbox"/>	
37-Office A-13-Tm	37-Office A-13	Uncontrolled	NA	NA	453	NA	0.00	NA	NA	NA	NA	<input type="checkbox"/>	
40-Office A-14-Tm	40-Office A-14	Uncontrolled	NA	NA	453	NA	0.00	NA	NA	NA	NA	<input type="checkbox"/>	
43-Office A-15-Tm	43-Office A-15	Uncontrolled	NA	NA	453	NA	0.00	NA	NA	NA	NA	<input type="checkbox"/>	
46-Office A-16-Tm	46-Office A-16	Uncontrolled	NA	NA	453	NA	0.00	NA	NA	NA	NA	<input type="checkbox"/>	
49-Office A-17-Tm	49-Office A-17	Uncontrolled	NA	NA	453	NA	0.00	NA	NA	NA	NA	<input type="checkbox"/>	
52-Office A-18-Tm	52-Office A-18	Uncontrolled	NA	NA	453	NA	0.00	NA	NA	NA	NA	<input type="checkbox"/>	
55-Office A-19-Tm	55-Office A-19	Uncontrolled	NA	NA	453	NA	0.00	NA	NA	NA	NA	<input type="checkbox"/>	
58-Office B-1-Tm	58-Office B-1	Uncontrolled	NA	NA	453	NA	0.00	NA	NA	NA	NA	<input type="checkbox"/>	

CA Building Energy Efficiency Standards: 2019 Nonresidential Compliance Report Version: NRCC-PHF-01-E-09022021-6384 Report Generated at: 2021-11-18 10:44:49

Project Name:	Madera Industrial WHSE	NRCC-PHF-01-E	Page 30 of 33
Project Address:	5, Schnoor Avenue Madera	Calculation Date/Time:	10/23, Thu, Nov 18, 2021
Input File Name:	2020.264 Energy Calcs (2x4).cld19x		

1	2	3	4	5	6
Occupancy Type <sup>1</sup>	Conditioned Floor Area <sup>2</sup> (ft <sup>2</sup> )	Installed Lighting Power (Watts)	Lighting Control Credits (Watts)	Area Category Footcandle (Watts)	Additional (Custom) Allowance
Office Area (<20 square feet)	12,084	6,436	0	0	0
<b>Building Totals:</b>	<b>12,084</b>	<b>6,436</b>	<b>0</b>	<b>0</b>	<b>0</b>

<sup>1</sup> See Table 6.0.1.2.2  
<sup>2</sup> See Table 6.0.1.2.2.2 for unconditioned spaces  
<sup>3</sup> Lighting information for existing spaces modeled is not included in this table


CA Building Energy Efficiency Standards: 2019 Nonresidential Compliance Report Version: NRCC-PHF-01-E-09022021-6384 Report Generated at: 2021-11-18 10:44:49













Project Name:	Madera Industrial WHSE	NRCC-PHF-01-E	Page 37 of 33
Project Address:	5, Schnoor Avenue Madera	Calculation Date/Time:	10/23, Thu, Nov 18, 2021
Input File Name:	2020.264 Energy Calcs (2x4).cld19x		

H7_ZONAL SYSTEM AND TERMINAL UNIT SUMMARY											
System ID	Zone Name	System Type	Rated Capacity (Btu/h)		Design	Airflow (cfm)	Min. Ratio	BHP	Watts	Cycles	ECM Motor
			Heating	Cooling							
61-Office B-2-Tm	61-Office B-2	Uncontrolled	NA	NA	453	NA	0.00	NA	NA	NA	<input type="checkbox"/>
64-Office B-3-Tm	64-Office B-3	Uncontrolled	NA	NA	453	NA	0.00	NA	NA	NA	<input type="checkbox"/>
67-Office B-4-Tm	67-Office B-4	Uncontrolled	NA	NA	453	NA	0.00	NA	NA	NA	<input type="checkbox"/>
70-Office B-5-Tm	70-Office B-5	Uncontrolled	NA	NA	453	NA	0.00	NA	NA	NA	<input type="checkbox"/>
73-Office B-6-Tm	73-Office B-6	Uncontrolled	NA	NA	453	NA	0.00	NA	NA	NA	<input type="checkbox"/>
76-Office B-7-Tm	76-Office B-7	Uncontrolled	NA	NA	453	NA	0.00	NA	NA	NA	<input type="checkbox"/>
79-Office B-8-Tm	79-Office B-8	Uncontrolled	NA	NA	453	NA	0.00	NA	NA	NA	<input type="checkbox"/>
82-Office B-9-Tm	82-Office B-9	Uncontrolled	NA	NA	453	NA	0.00	NA	NA	NA	<input type="checkbox"/>
85-Office B-10-Tm	85-Office B-10	Uncontrolled	NA	NA	453	NA	0.00	NA	NA	NA	<input type="checkbox"/>
88-Office B-11-Tm	88-Office B-11	Uncontrolled	NA	NA	453	NA	0.00	NA	NA	NA	<input type="checkbox"/>
91-Office B-12-Tm	91-Office B-12	Uncontrolled	NA	NA	453	NA	0.00	NA	NA	NA	<input type="checkbox"/>
94-Office B-13-Tm	94-Office B-13	Uncontrolled	NA	NA	453	NA	0.00	NA	NA	NA	<input type="checkbox"/>
97-Office B-14-Tm	97-Office B-14	Uncontrolled	NA	NA	453	NA	0.00	NA	NA	NA	<input type="checkbox"/>
100-Office B-15-Tm	100-Office B-15	Uncontrolled	NA	NA	453	NA	0.00	NA	NA	NA	<input type="checkbox"/>
103-Office B-16-Tm	103-Office B-16	Uncontrolled	NA	NA	453	NA	0.00	NA	NA	NA	<input type="checkbox"/>
106-Office B-17-Tm	106-Office B-17	Uncontrolled	NA	NA	453	NA	0.00	NA	NA	NA	<input type="checkbox"/>
109-Office B-18-Tm	109-Office B-18	Uncontrolled	NA	NA	453	NA	0.00	NA	NA	NA	<input type="checkbox"/>
112-Office B-19-Tm	112-Office B-19	Uncontrolled	NA	NA	453	NA	0.00	NA	NA	NA	<input type="checkbox"/>
115-Office C-1-Tm	115-Office C-1	Uncontrolled	NA	NA	453	NA	0.00	NA	NA	NA	<input type="checkbox"/>
118-Office C-2-Tm	118-Office C-2	Uncontrolled	NA	NA	453	NA	0.00	NA	NA	NA	<input type="checkbox"/>
121-Office C-3-Tm	121-Office C-3	Uncontrolled	NA	NA	453	NA	0.00	NA	NA	NA	<input type="checkbox"/>
124-Office C-4-Tm	124-Office C-4	Uncontrolled	NA	NA	453	NA	0.00	NA	NA	NA	<input type="checkbox"/>
127-Office C-5-Tm	127-Office C-5	Uncontrolled	NA	NA	453	NA	0.00	NA	NA	NA	<input type="checkbox"/>
130-Office C-6-Tm	130-Office C-6	Uncontrolled	NA	NA	453	NA	0.00	NA	NA	NA	<input type="checkbox"/>



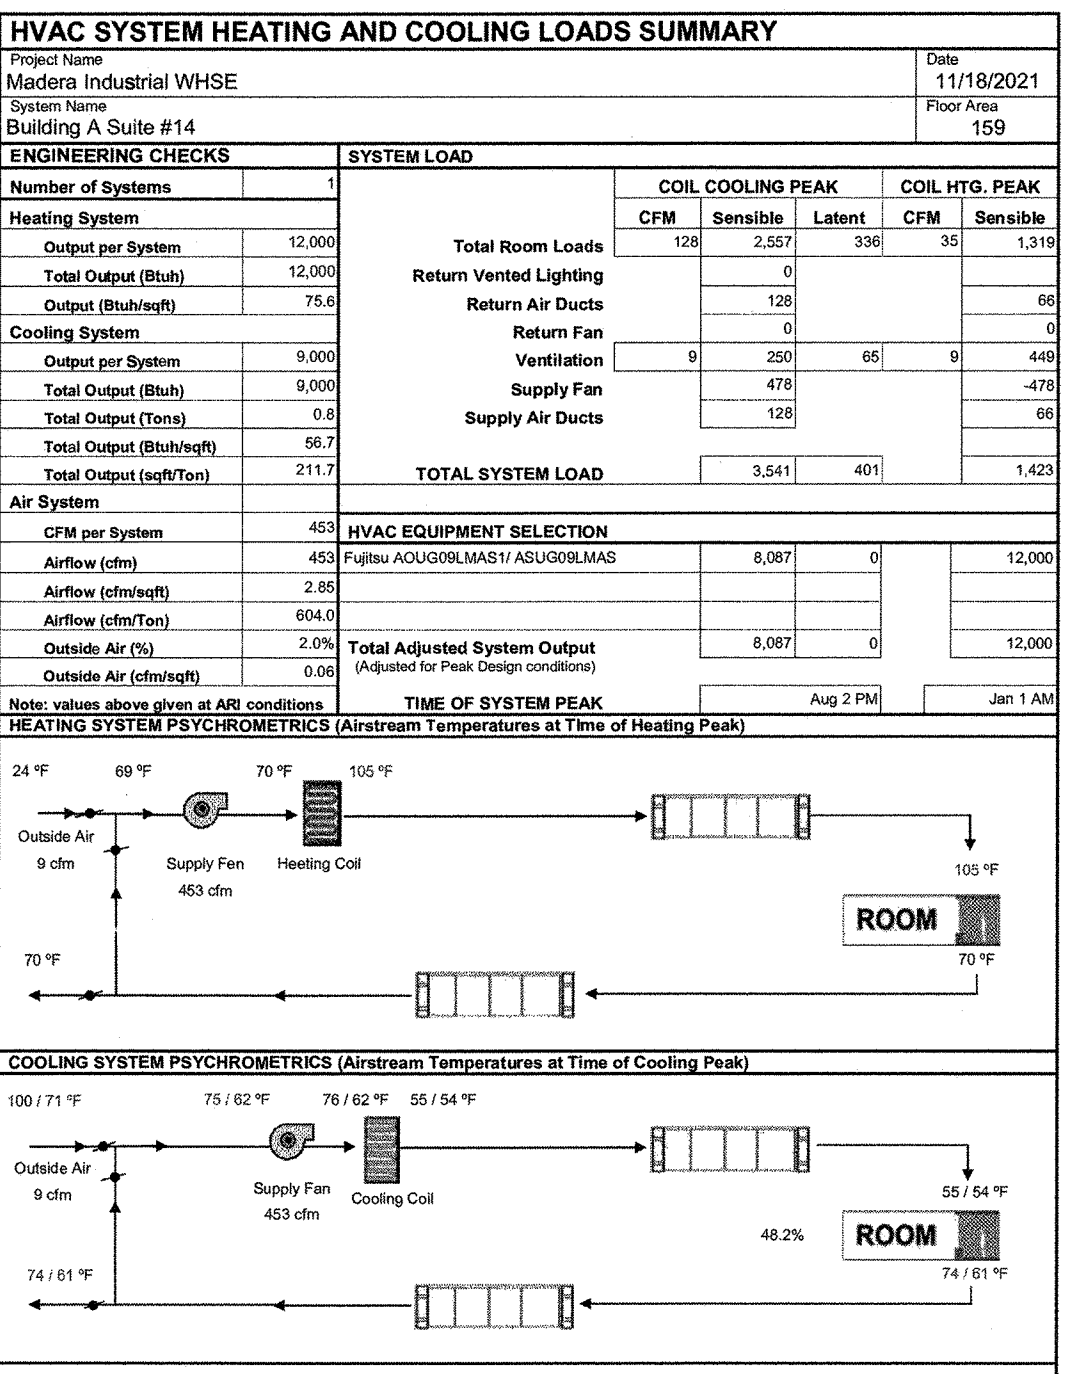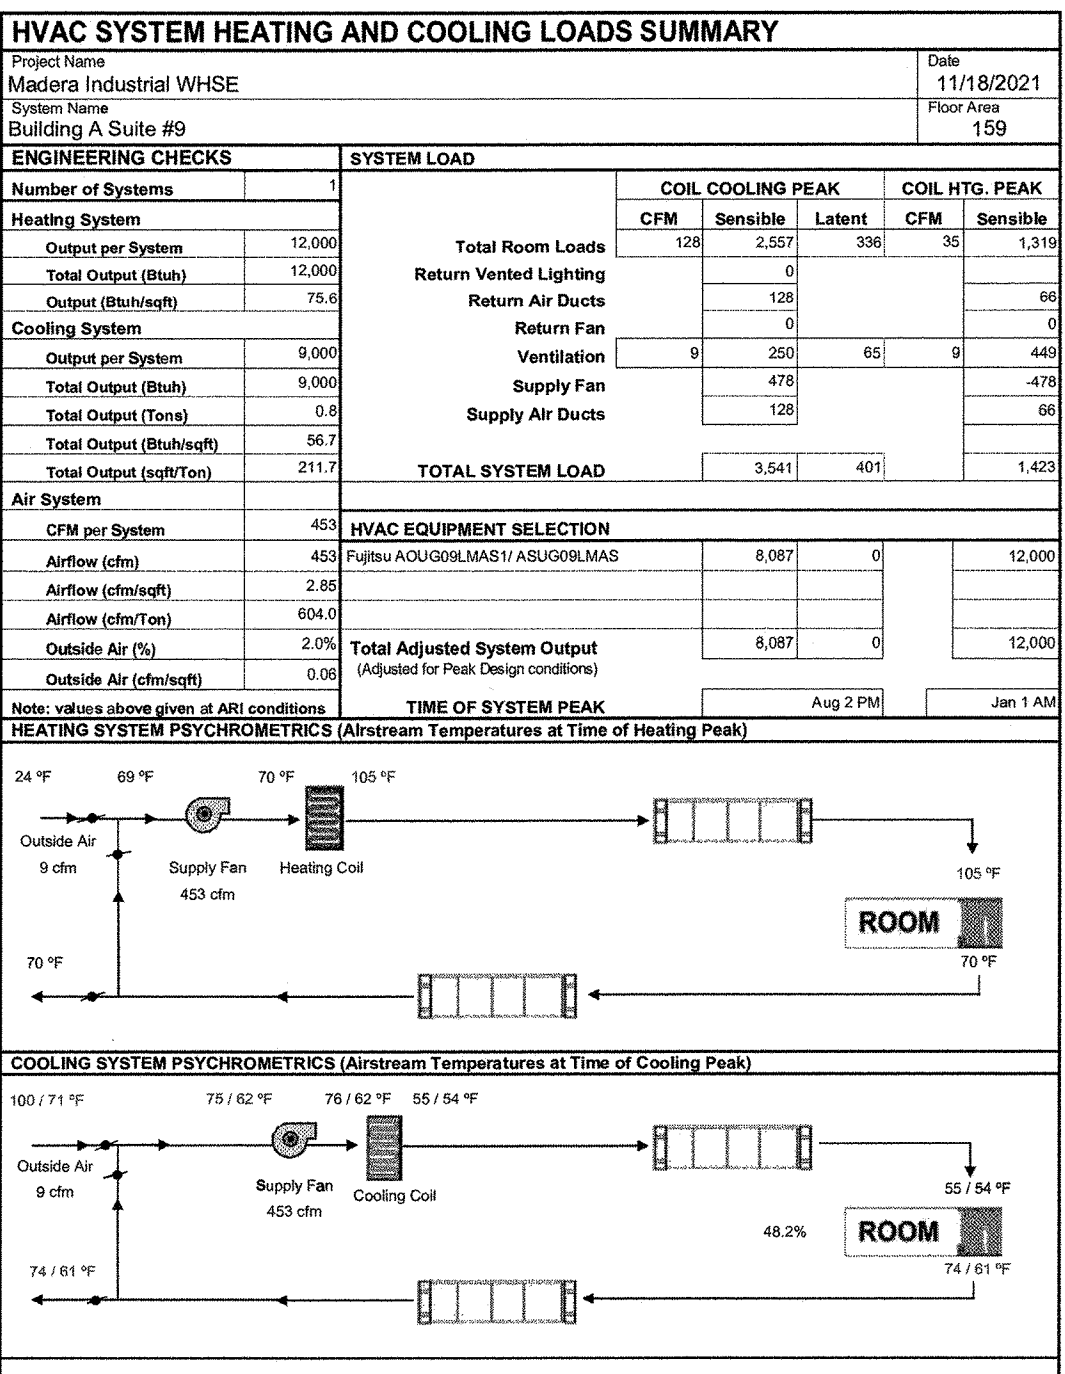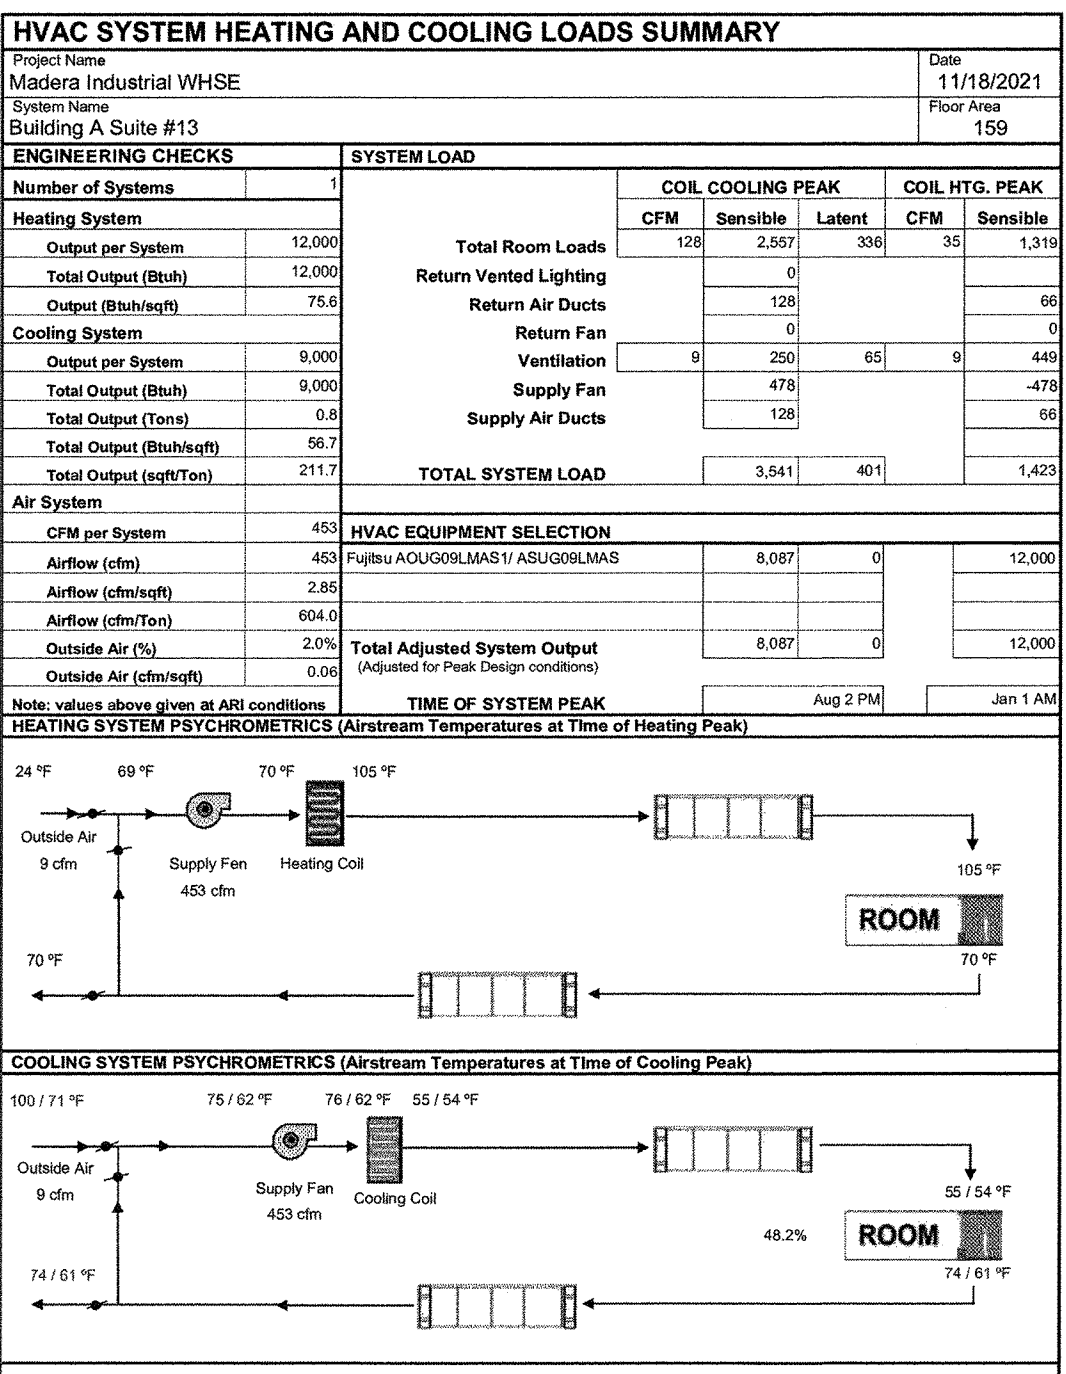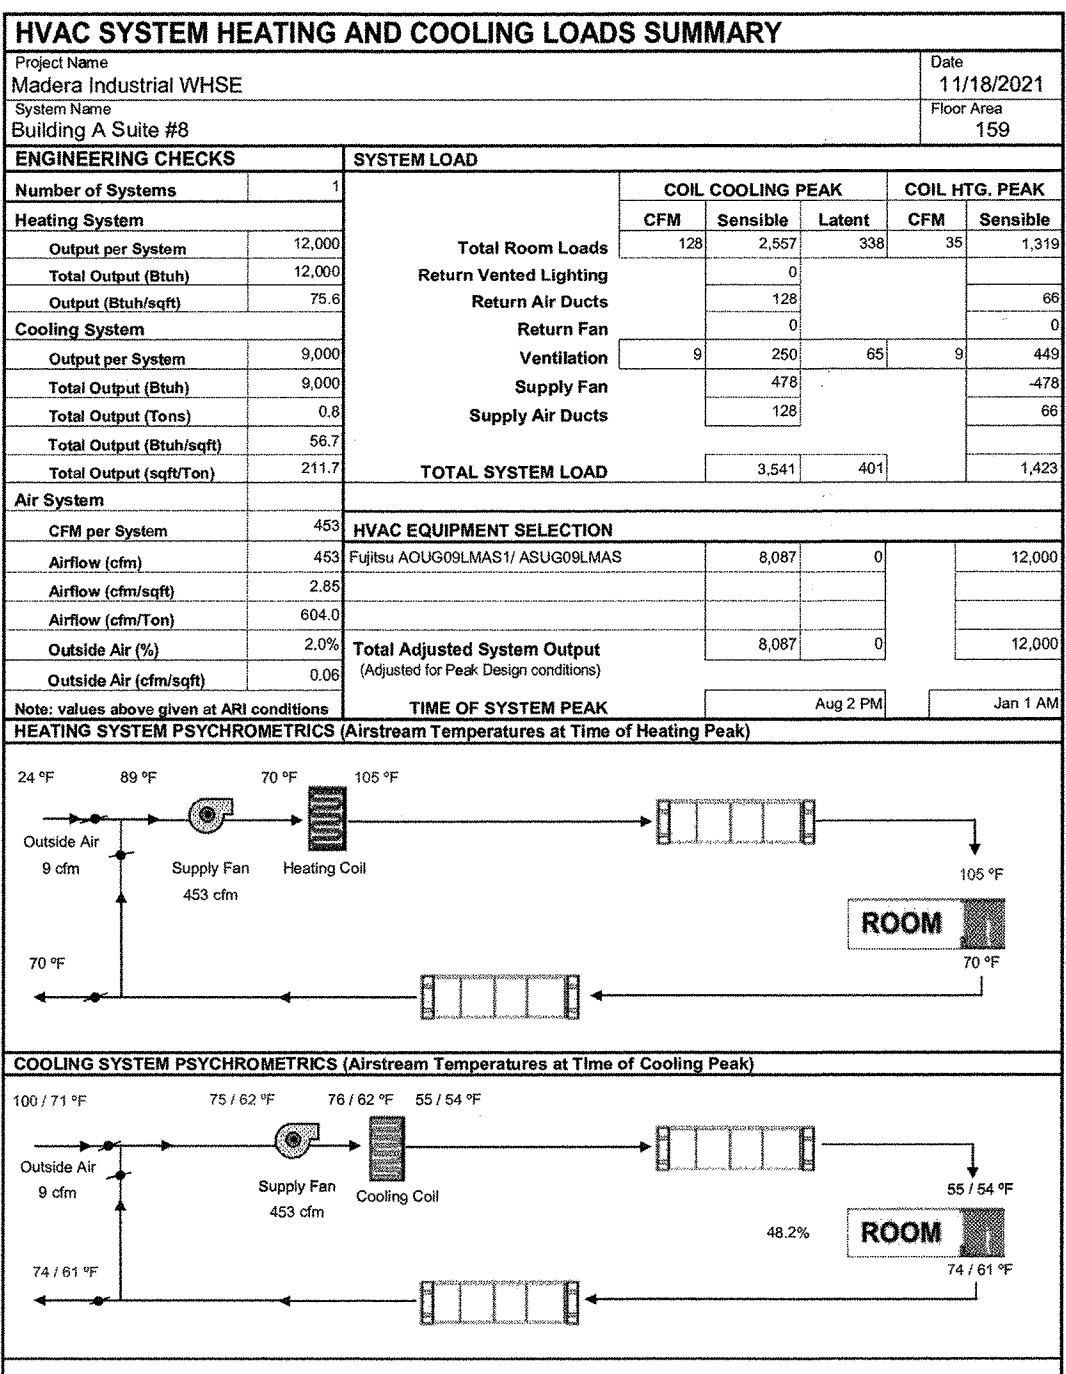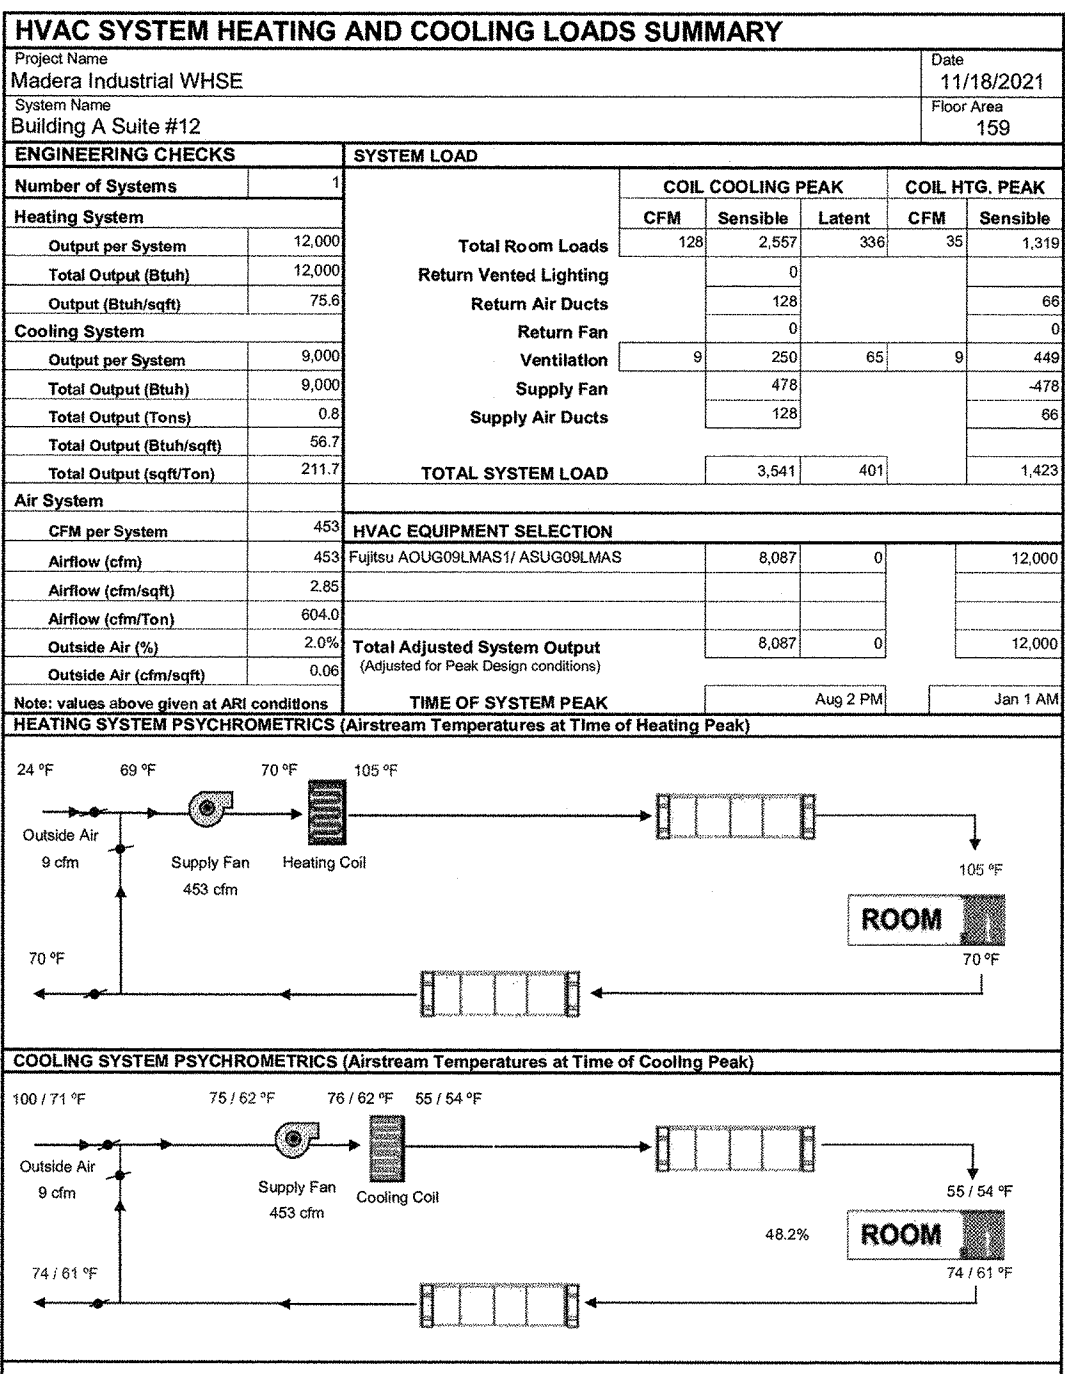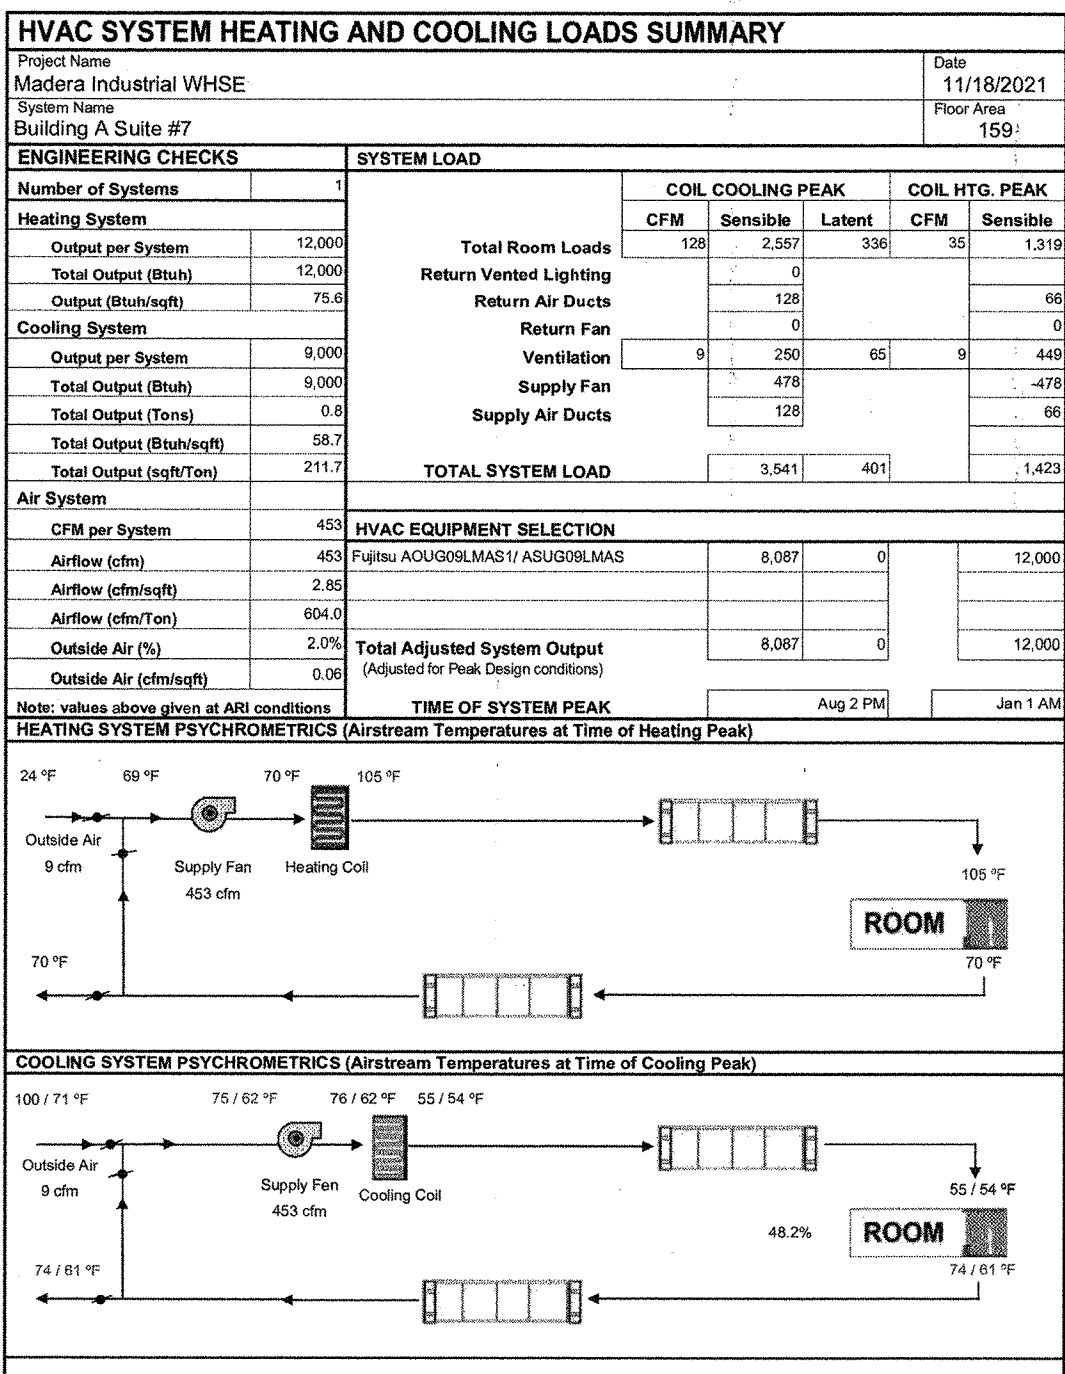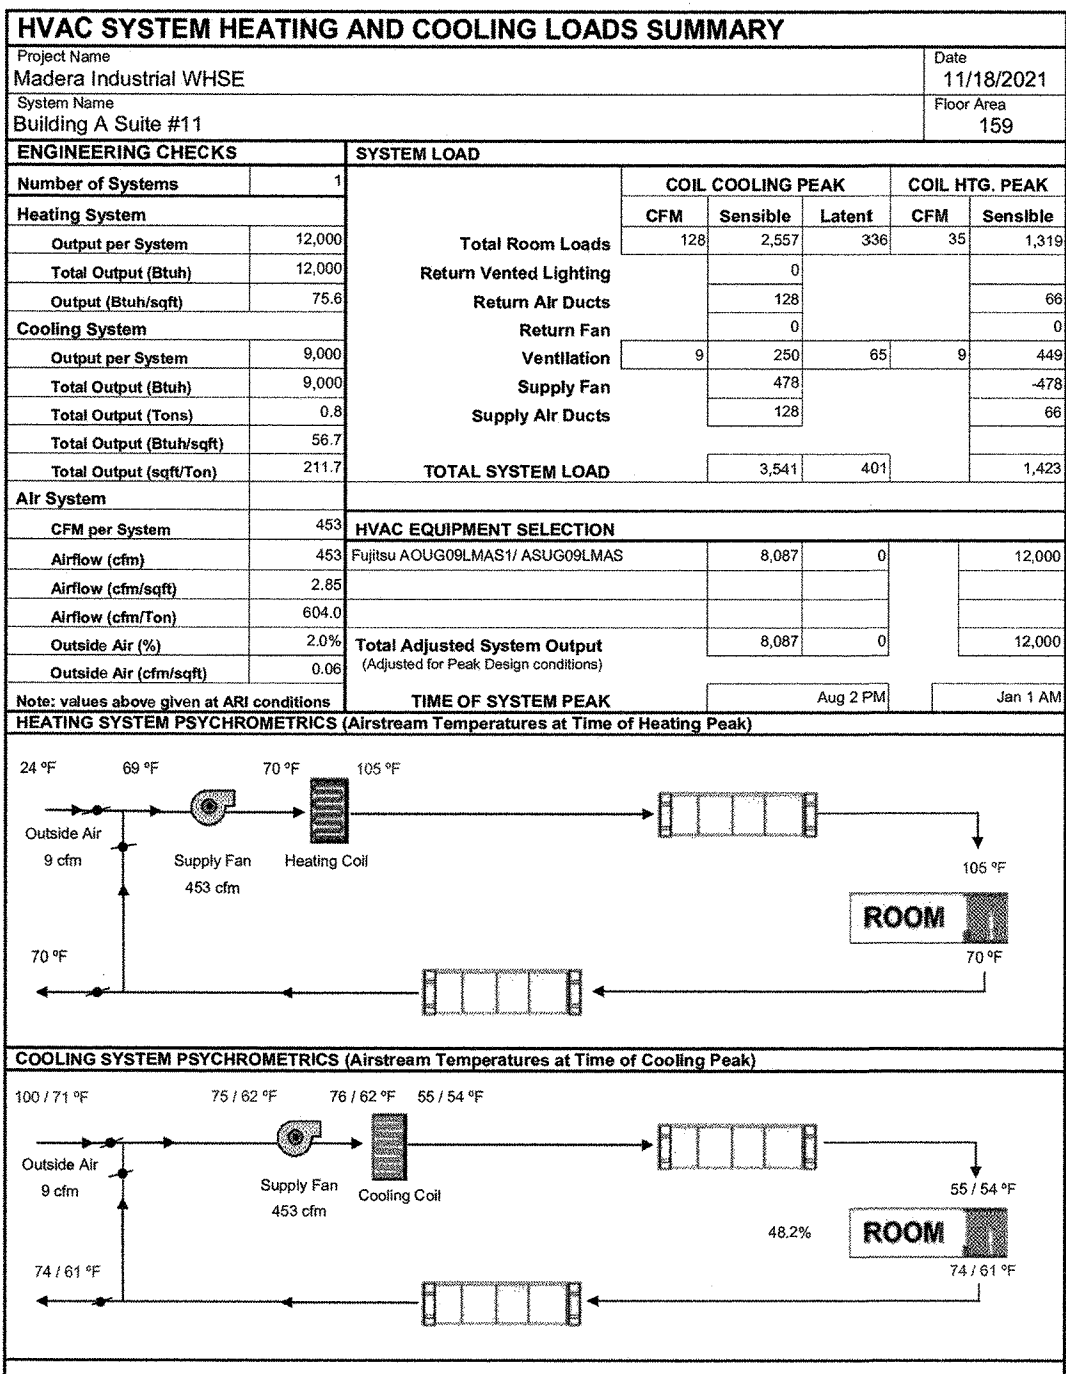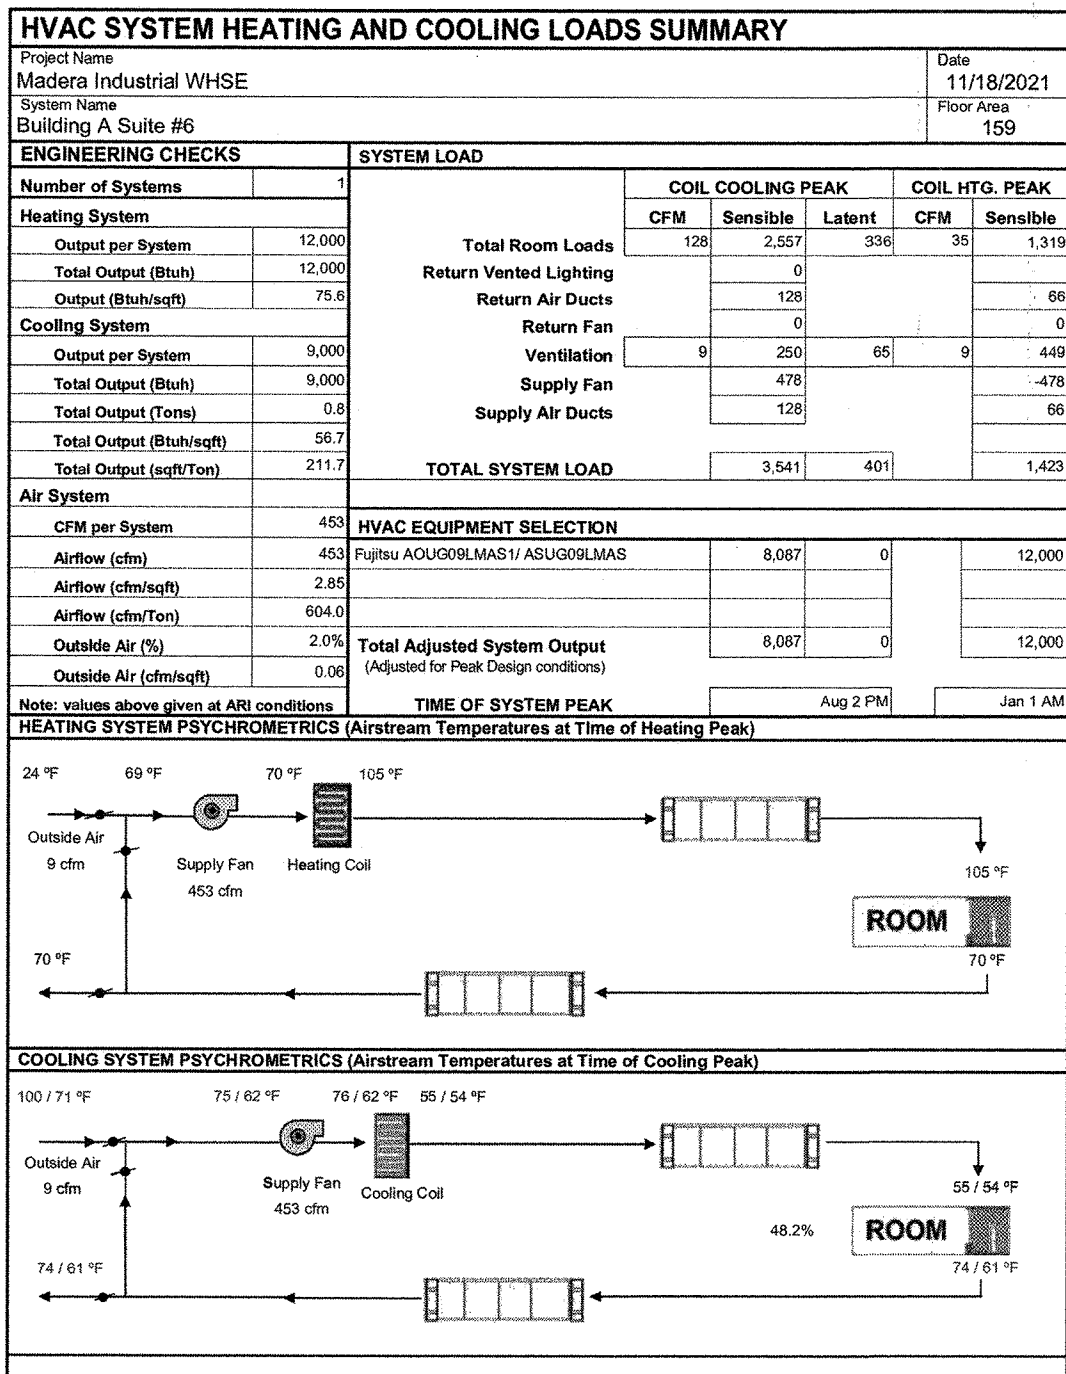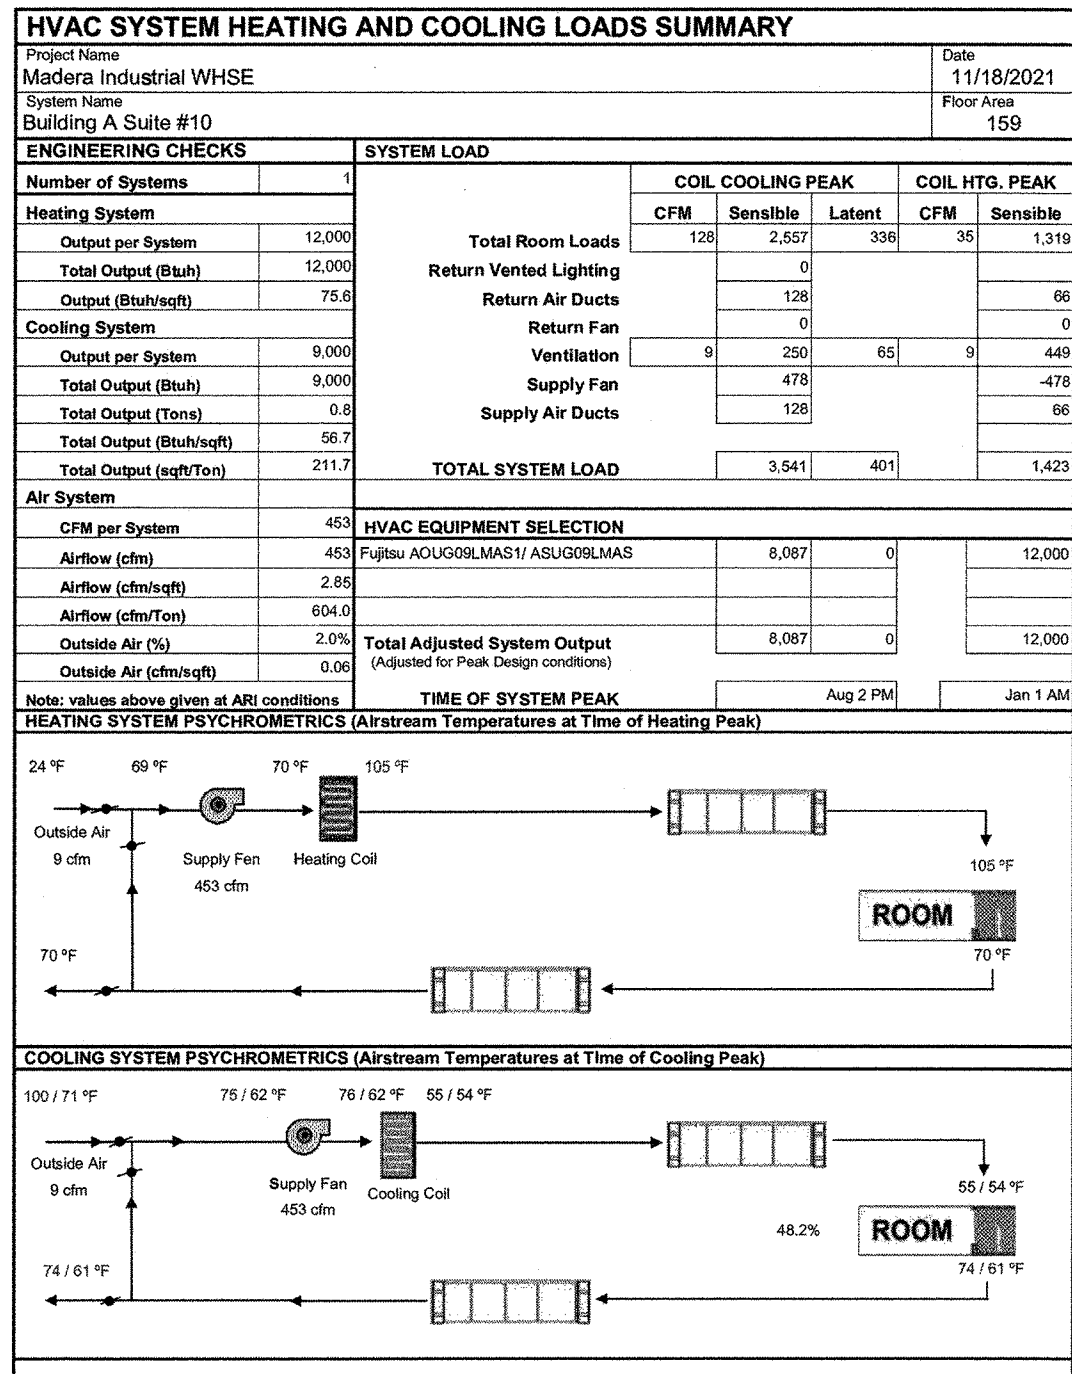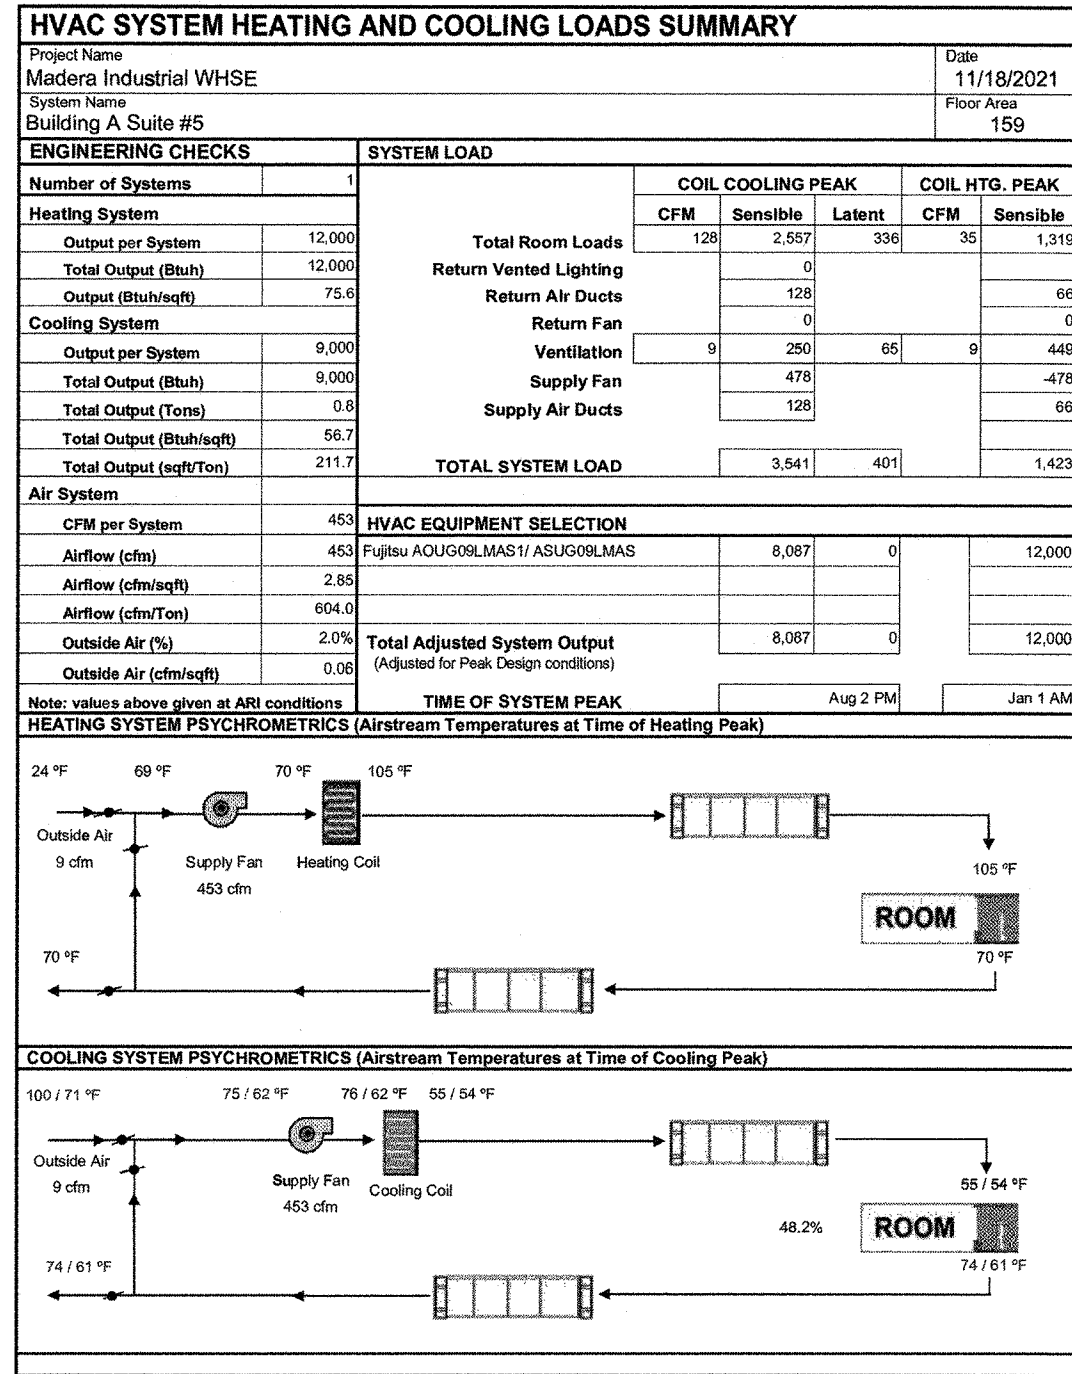

These plans or drawings or any part of these publications are the exclusive property of VAR, and may not be reproduced, or transmitted in any form or by means, recording, electronic, mechanical, photocopying or otherwise without written permission by VAR. Copies of these drawings are supplied to the owner or the Building contractor and, otherwise for the use of this project only. Any Re-use of these drawings or documents is prohibited without the written permission of VAR. If VAR is not awarded the project, VAR will not warranty these plans, drawings or contents and will not assume any liability or responsibility for the unauthorized use of these plans or drawings, and the plans or drawings and contents must be returned to VAR immediately.

Air Conditioning & Heating  
Custom Sheet Metal  
Sales & Service

VAR  
Since 1970  



50 Years of  
Indoor comfort.

Signed Steve Mendez  
License #009006  
Valley Air Conditioning & Repair


TYPICAL MECHANICAL FLOOR PLAN  
FOR  
LEASE FLEX. / WAREHOUSE BUILDINGS

MADERA INDUSTRIAL WHSE, LLC  
S. SCHNOOR AVENUE, MADERA, CA

JOB NUMBER 21107  
DESIGNED BY  
DRAWN BY  
DATE 9/09/2021  
SHEET NUMBER M6

ANY INFORMATION ON THIS DRAWING IS NOT INTENDED TO BE RELIED UPON BY ANY PERSON, FIRM, CORPORATION OR ANY OTHERS ON THE BASIS OF THIS PROJECT OR FOR ANY USE OTHER THAN THE SPECIFIC PURPOSE. ANY REUSE WITHOUT WRITTEN AUTHORIZATION AND ADAPTATION BY THE ENGINEER FOR THE SPECIFIC PURPOSE, INTENDED WILL BE AT THE USER'S SOLE RISK AND WITHOUT LIABILITY TO THE ENGINEER.



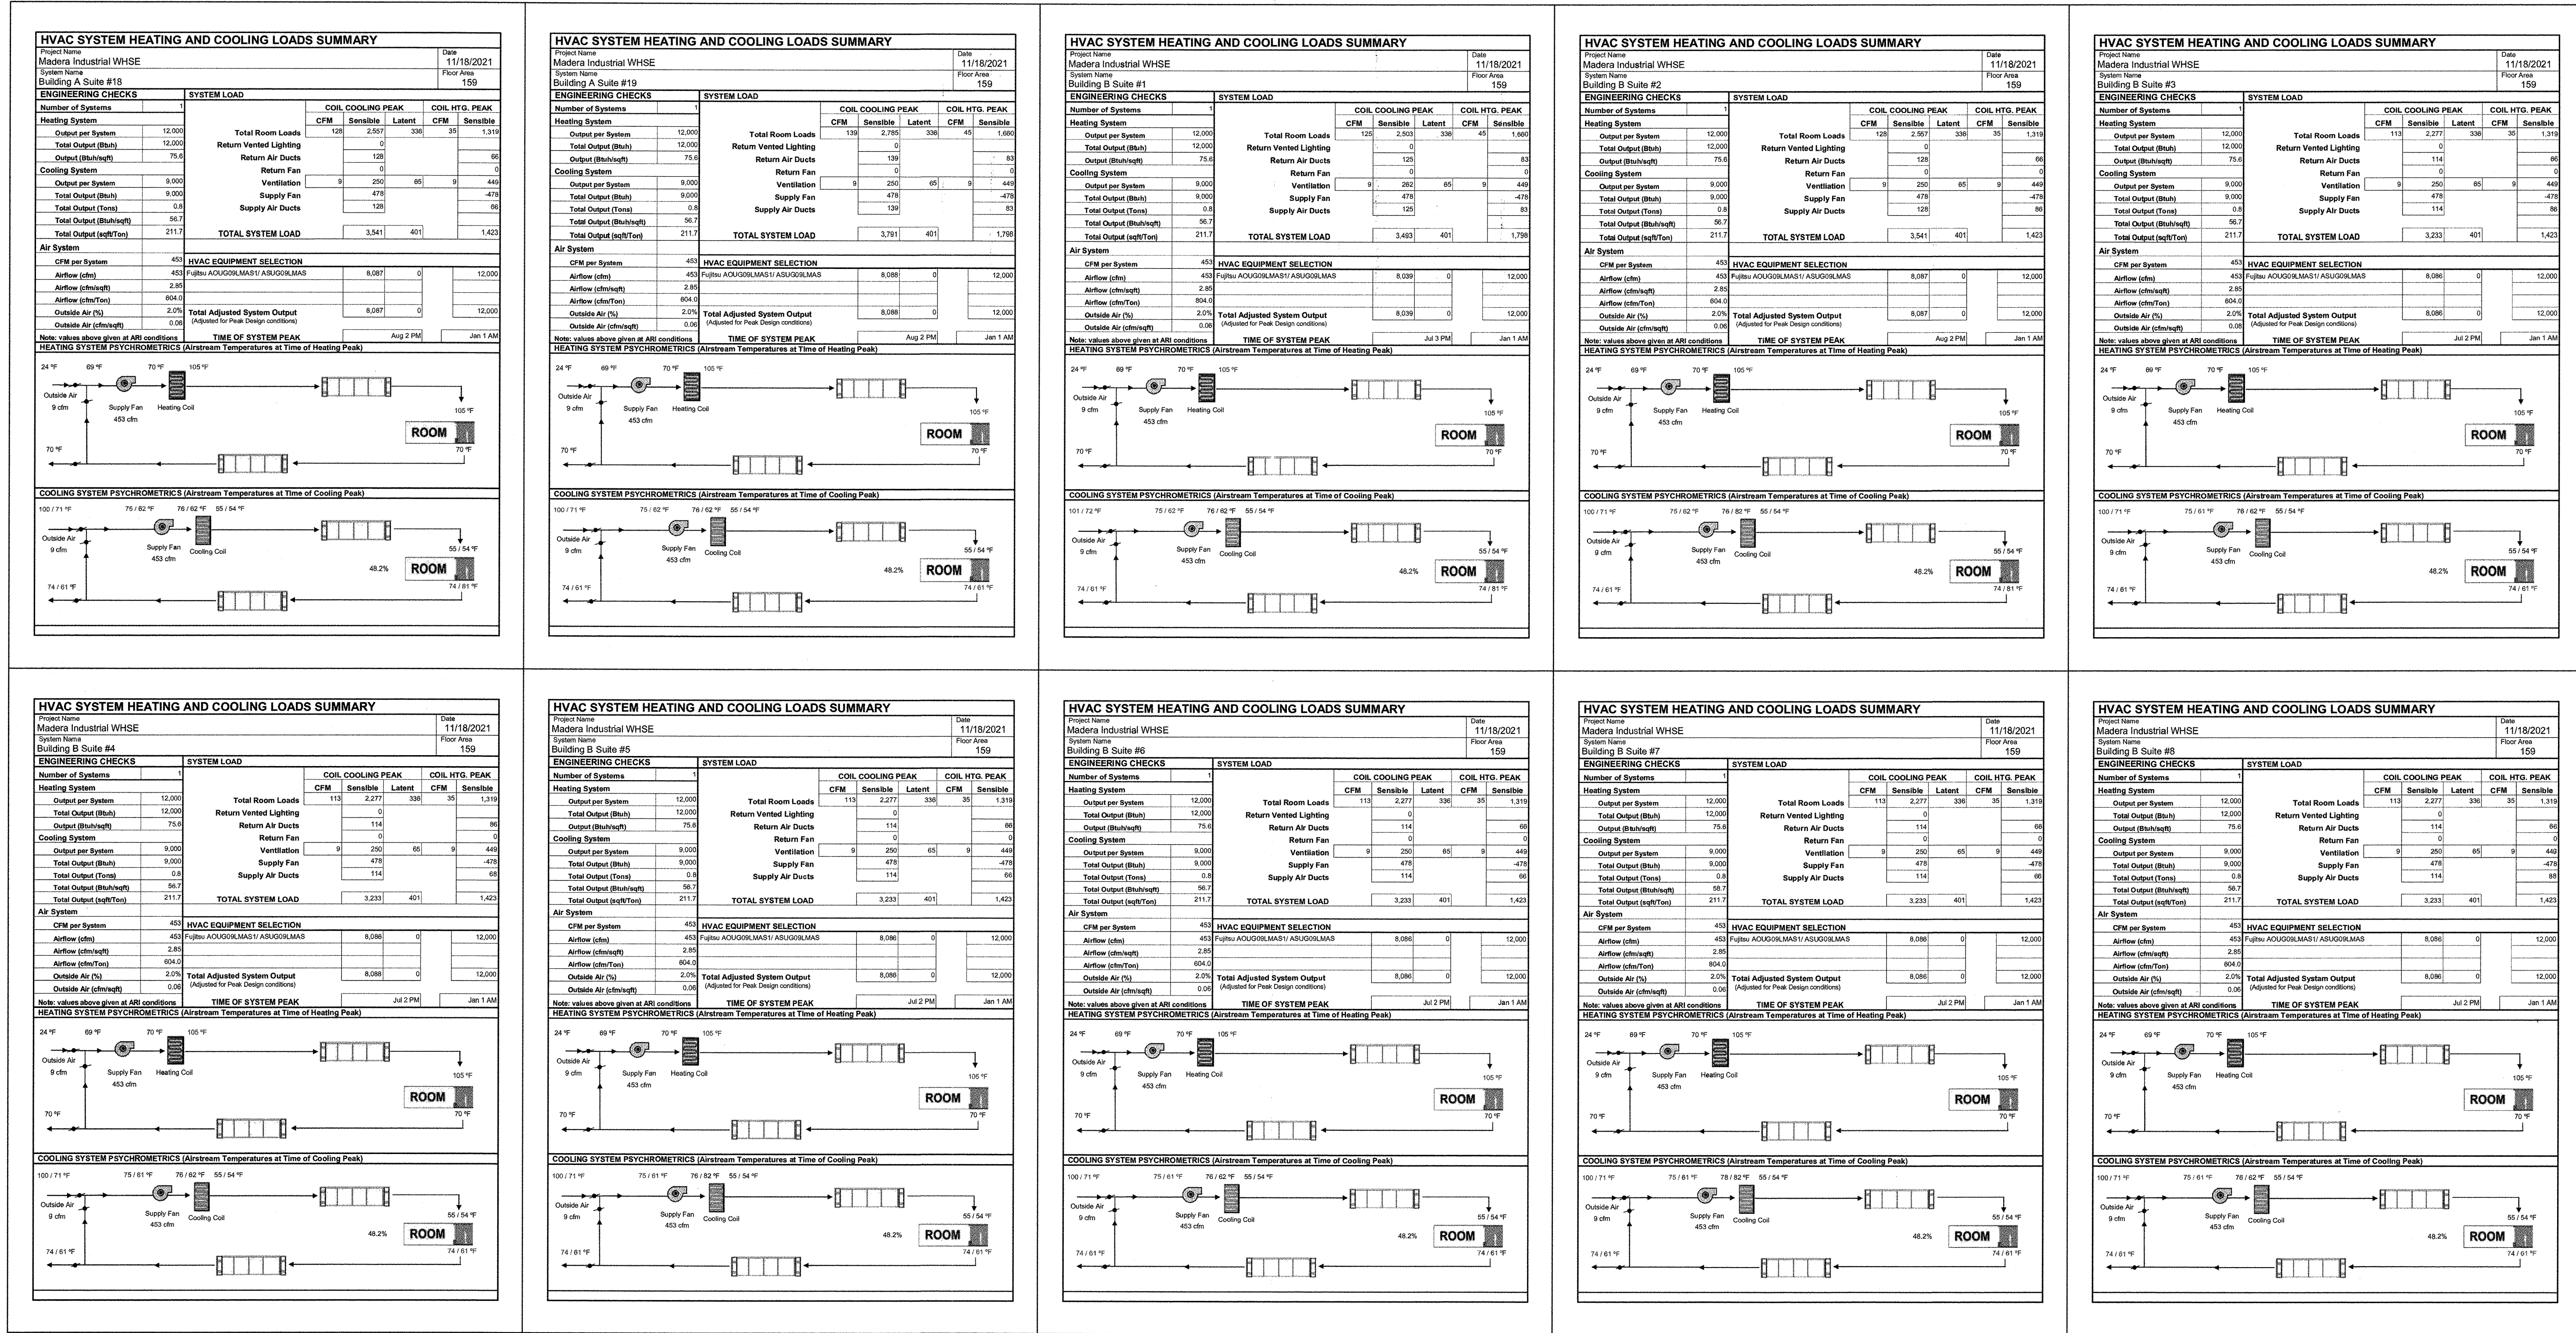

These plans or drawings or any part of these publications are the exclusive property of VAR, and may not be reproduced, or transmitted in any form or by means, recording, electronic, mechanical, photocopying or otherwise without written permission by VAR. Copies of these drawings are supplied to the owner or the Building contractor and, otherwise for the use of this project only. Any Re-use of these drawings or documents is prohibited without the written permission of VAR. If VAR is not awarded the project, VAR will not warranty these plans, drawings or contents and will not assume any liability or responsibility for the unauthorized use of these plans or drawings, and the plans or drawings and contents must be returned to VAR immediately.

**Air Conditioning & Heating  
Custom Sheet Metal  
Sales & Service**

**VAR**  
Since 1970  
855 S Topeka Ave  
Fresno, CA 93721  
559-297-3188

*Steve Mendez*  
11-18-21  
MAR 03 2022

**50 Years of  
Indoor comfort.**

2019080  
City of Madera  
Building Department  
The approval of these plans does not prevent the City of Madera from requiring correction of errors or omissions in the plans, specifications or construction. Subject to field inspections and approvals of the Building Department.

**APPROVED**  
By: *[Signature]*  
Date: 11-18-21

TYPICAL MECHANICAL FLOOR PLAN  
FOR  
LEASE FLEX / WAREHOUSE BUILDINGS  
MADERA INDUSTRIAL WHE, LLC  
S. SCHNOOR AVENUE, MADERA, CA

JOB NUMBER	21107
DESIGNED BY	
DRAWN BY	
DATE	9/09/2021
SHEET NUMBER	M7








HVAC SYSTEM HEATING AND COOLING LOADS SUMMARY
Project Name: Madera Industrial WHSE
System Name: Building C Suite #1
Date: 11/18/2021
Floor Area: 159

[Tables for Engineering Checks, System Load, Heating System, Cooling System, Air System, and Psychrometrics]
[Diagrams for Heating and Cooling System Psychrometrics]

These plans or drawings or any part of these publications are the exclusive property of VAR, and may not be reproduced, or transmitted in any form or by any means, electronic, mechanical, photocopying or otherwise without written permission by VAR.











VAR Since 1970

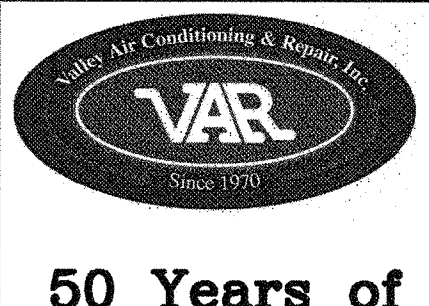

TYPICAL MECHANICAL FLOOR PLAN
LEASE FLEX. / WAREHOUSE BUILDINGS
FOR
MADERA INDUSTRIAL WHSE, LLC
S. SCHNOOR AVENUE, MADERA, CA

JOB NUMBER: 21107
DESIGNED BY:
DRAWN BY:
DATE: 9/09/2021
SHEET NUMBER: M9



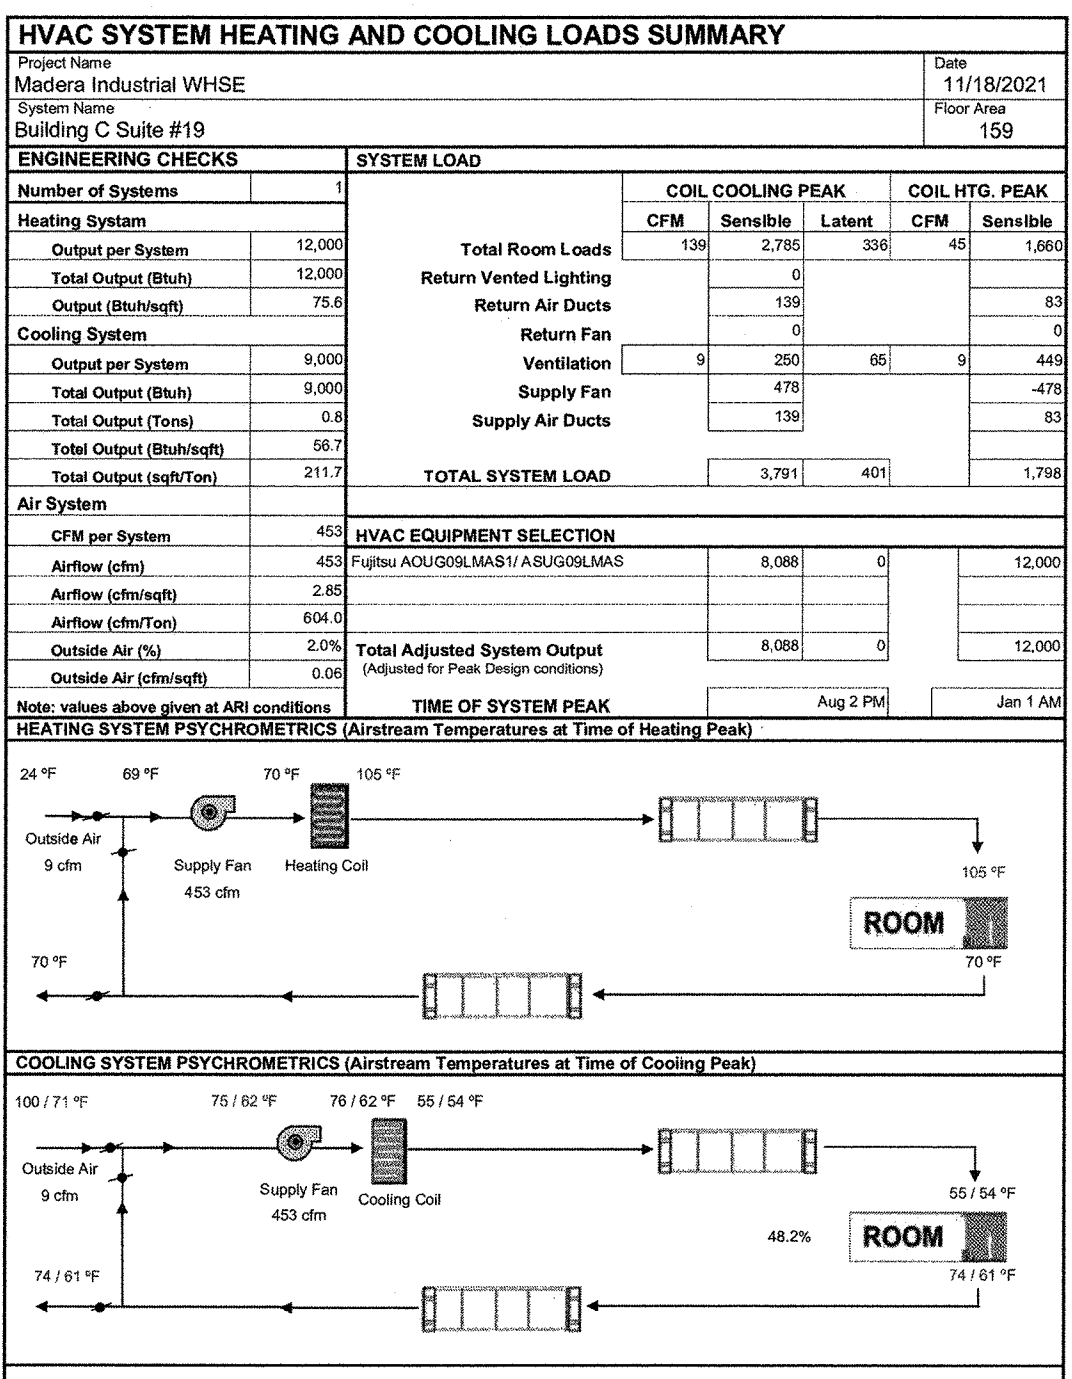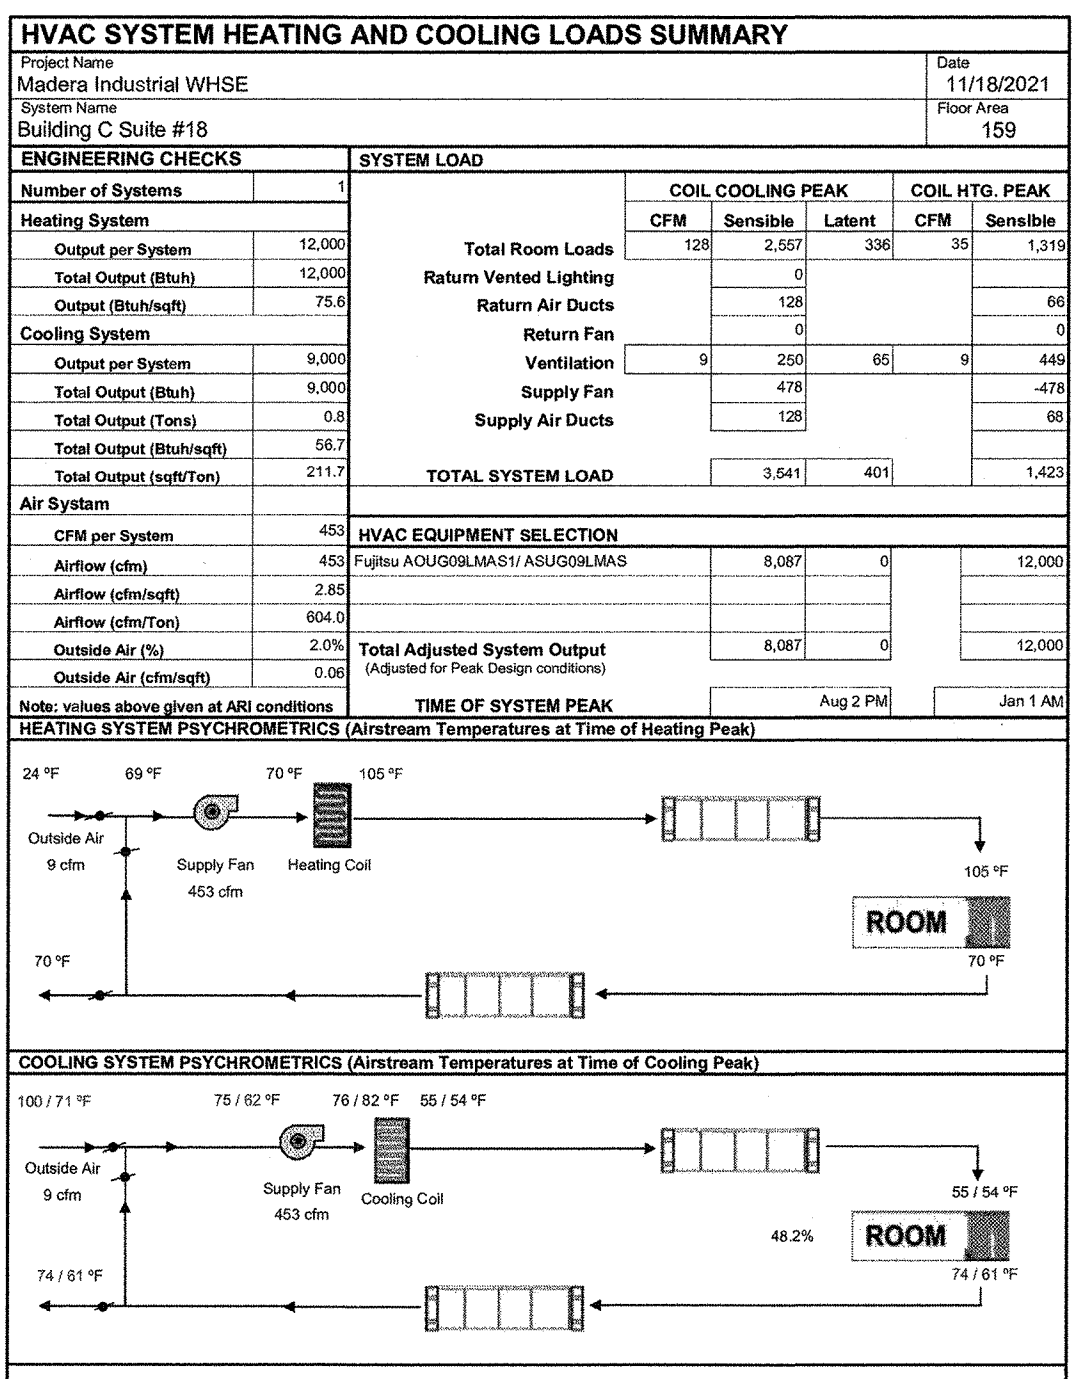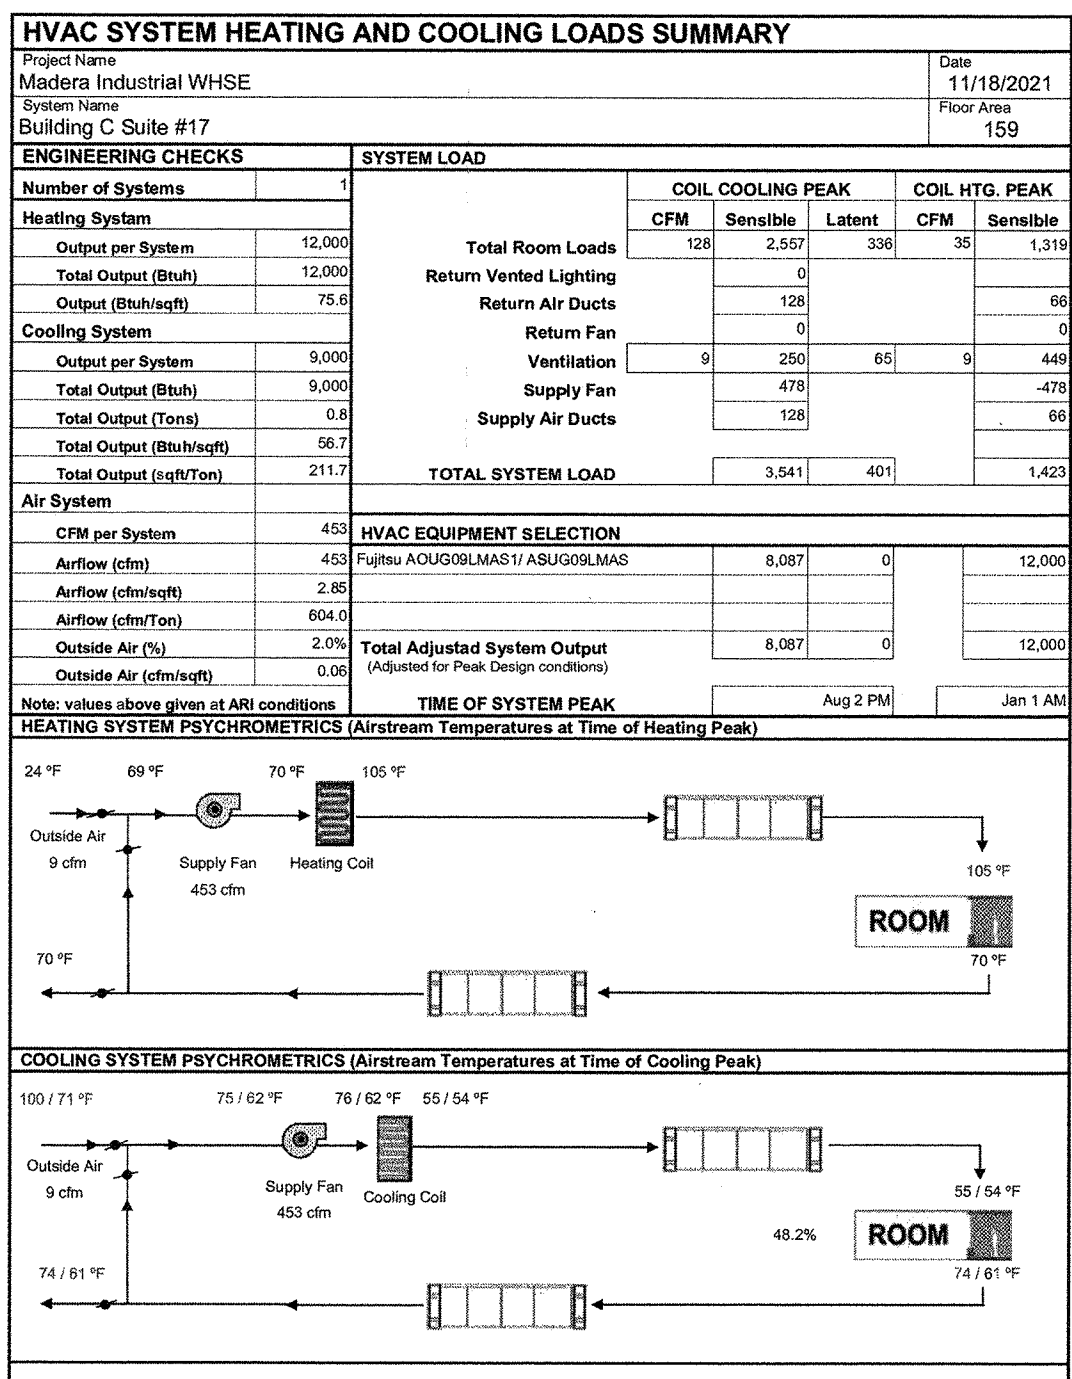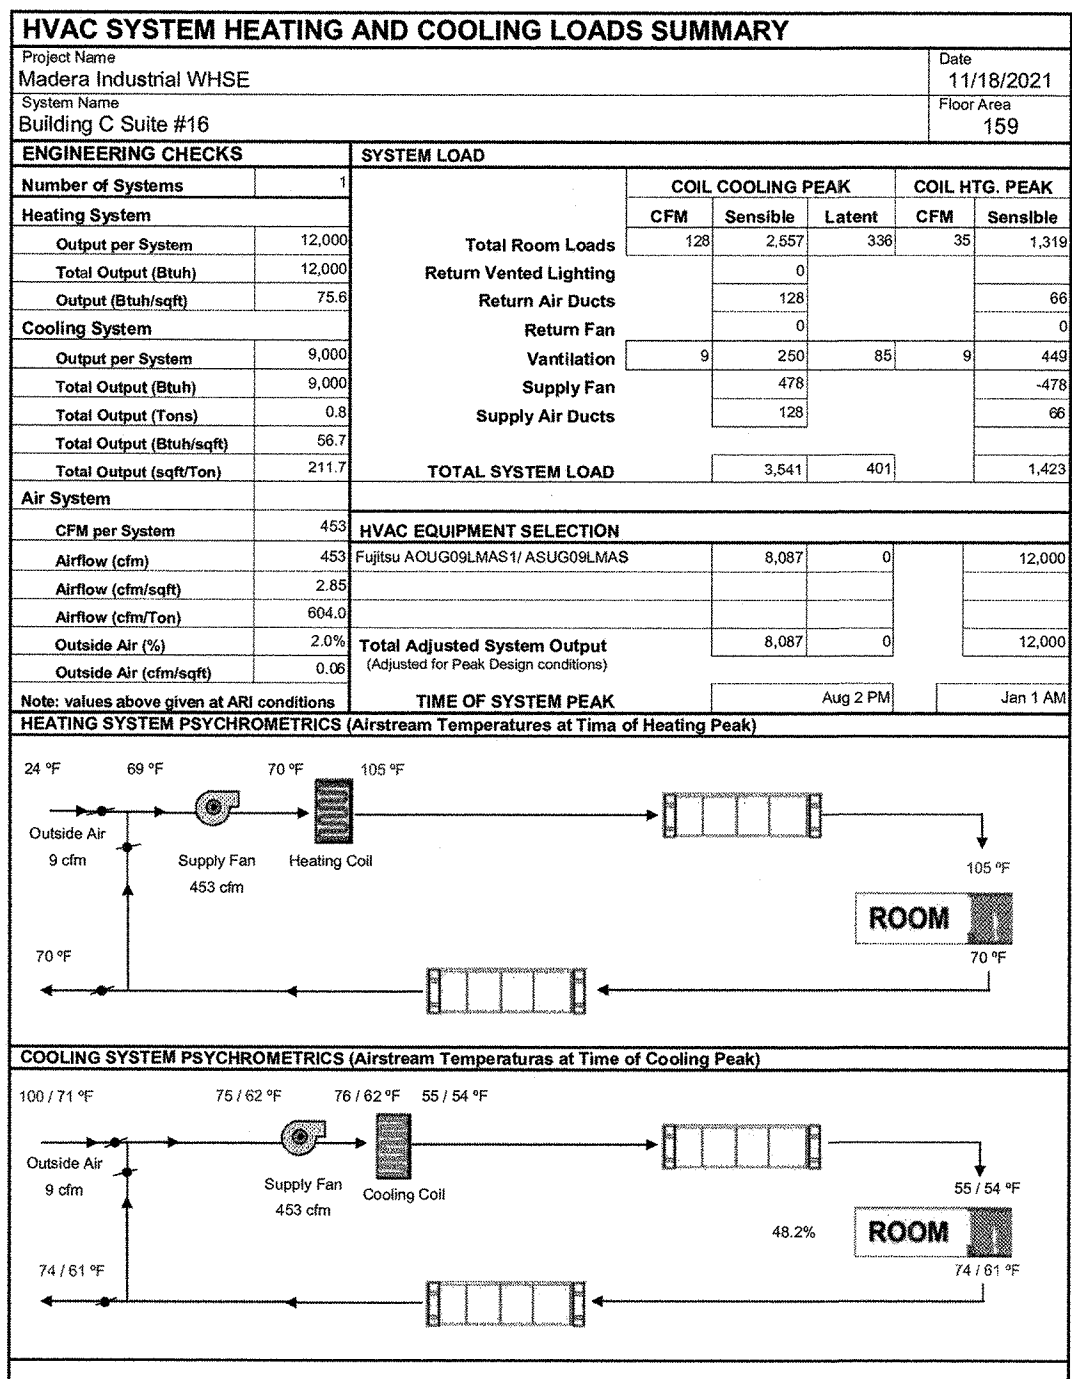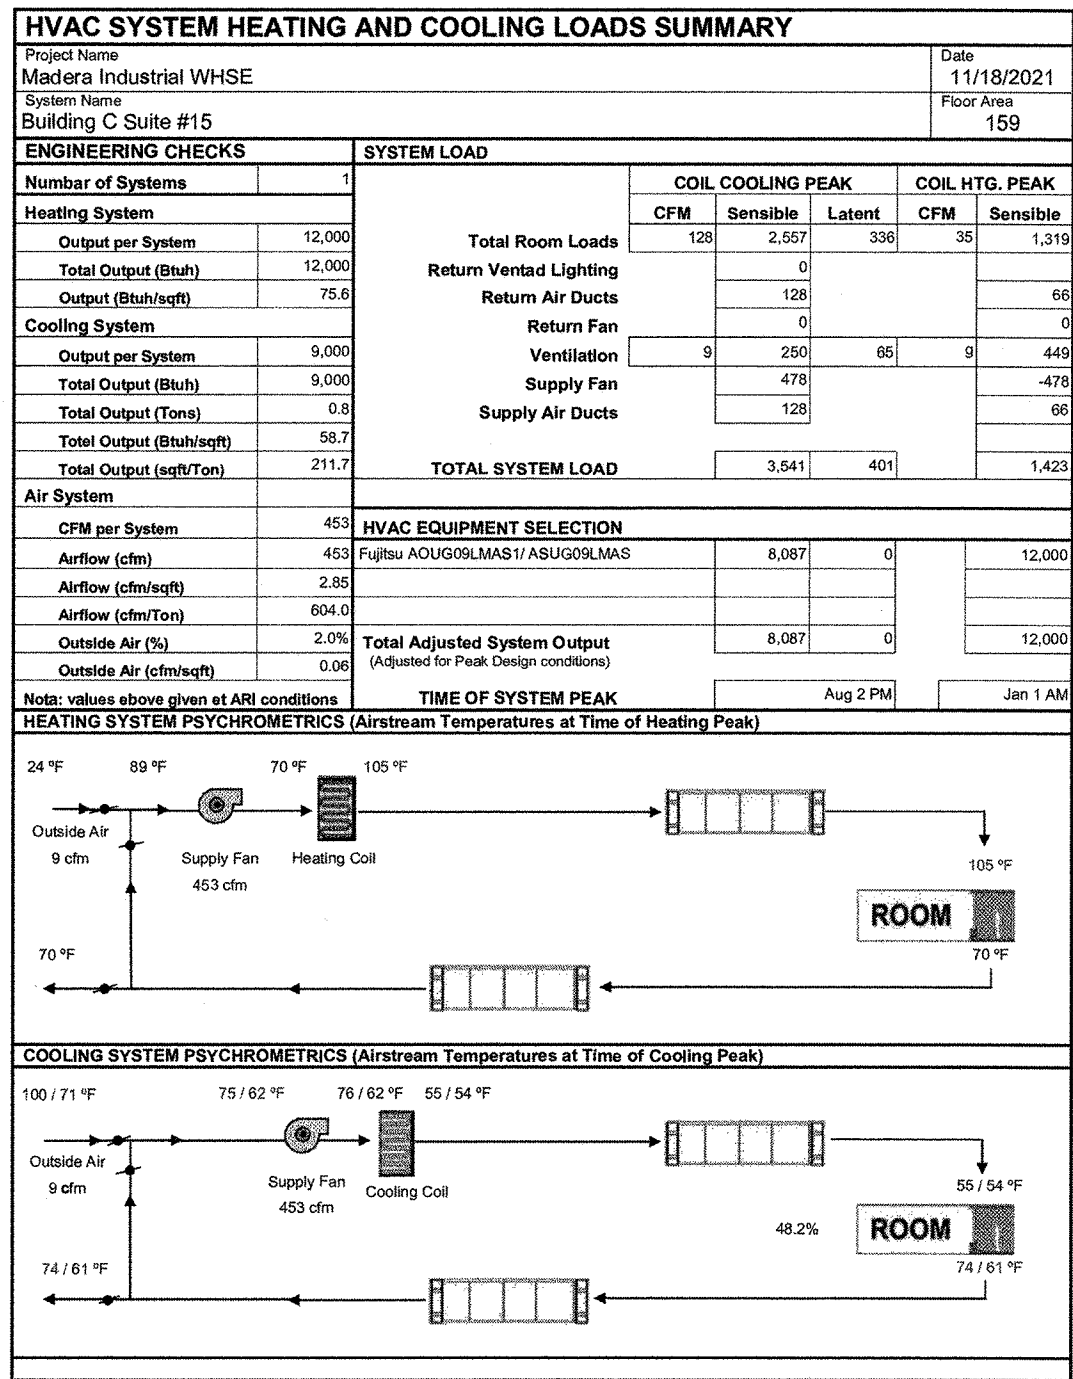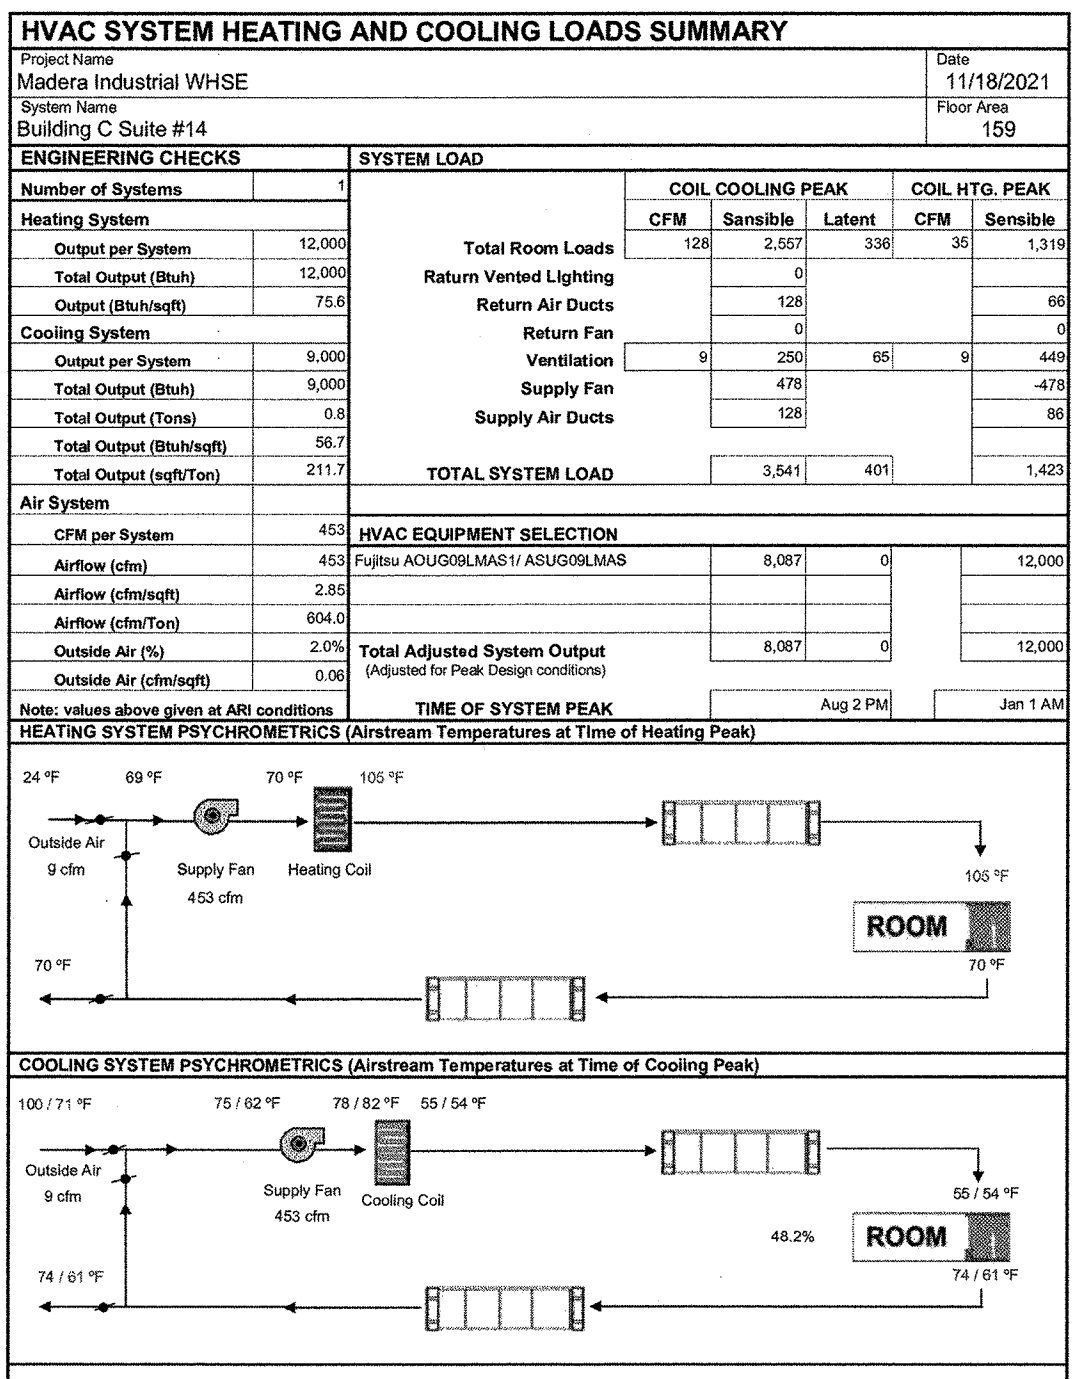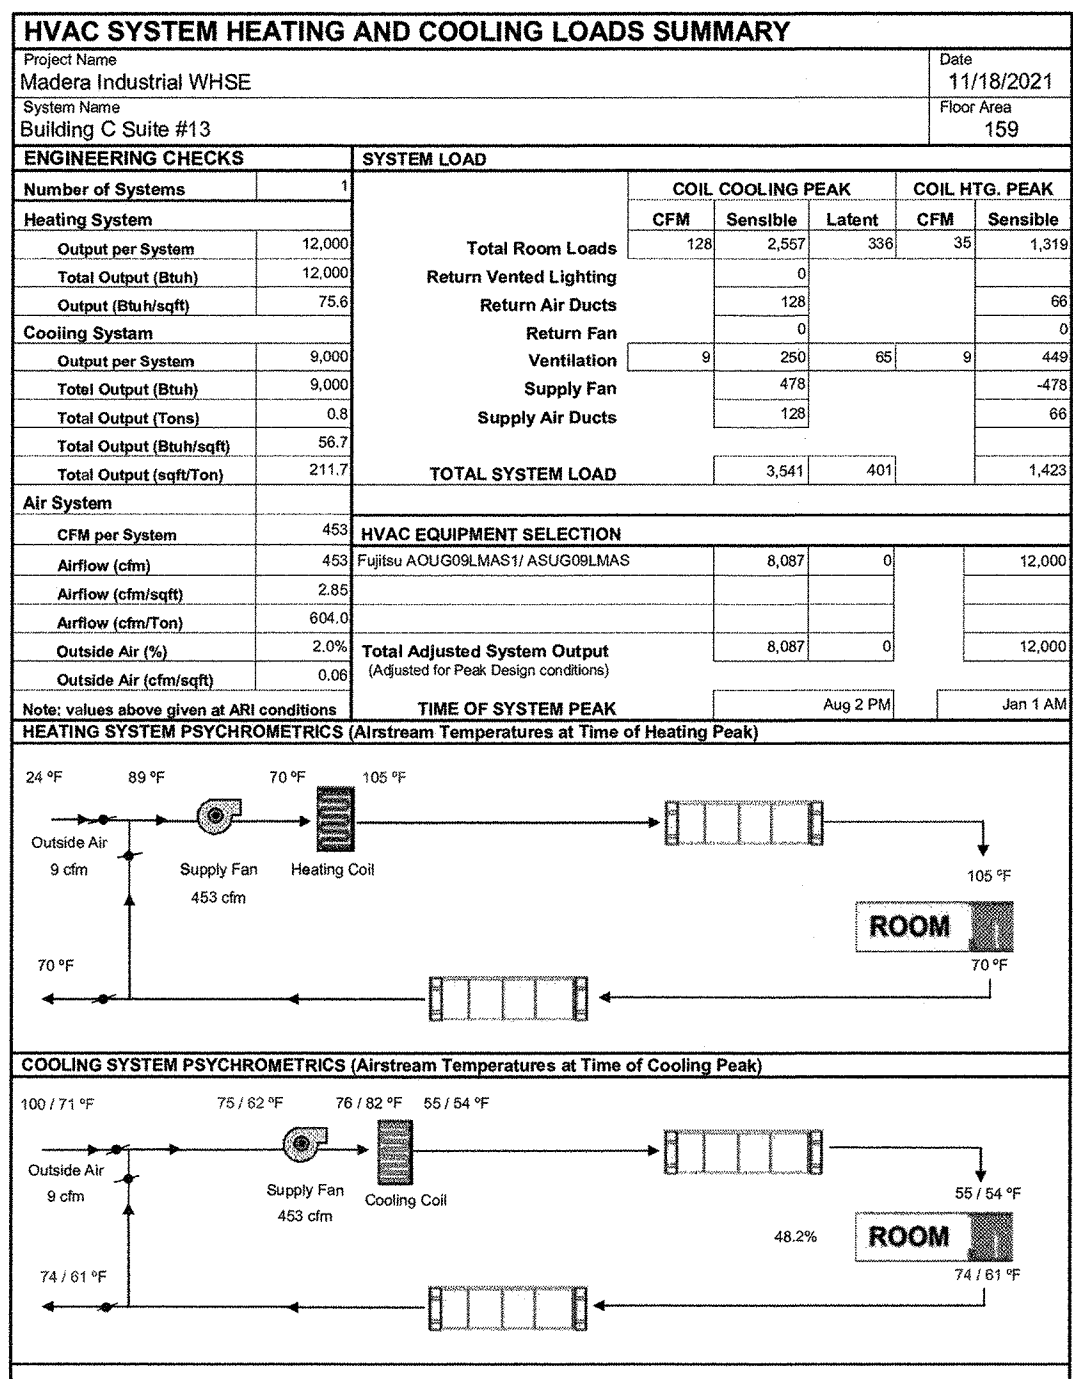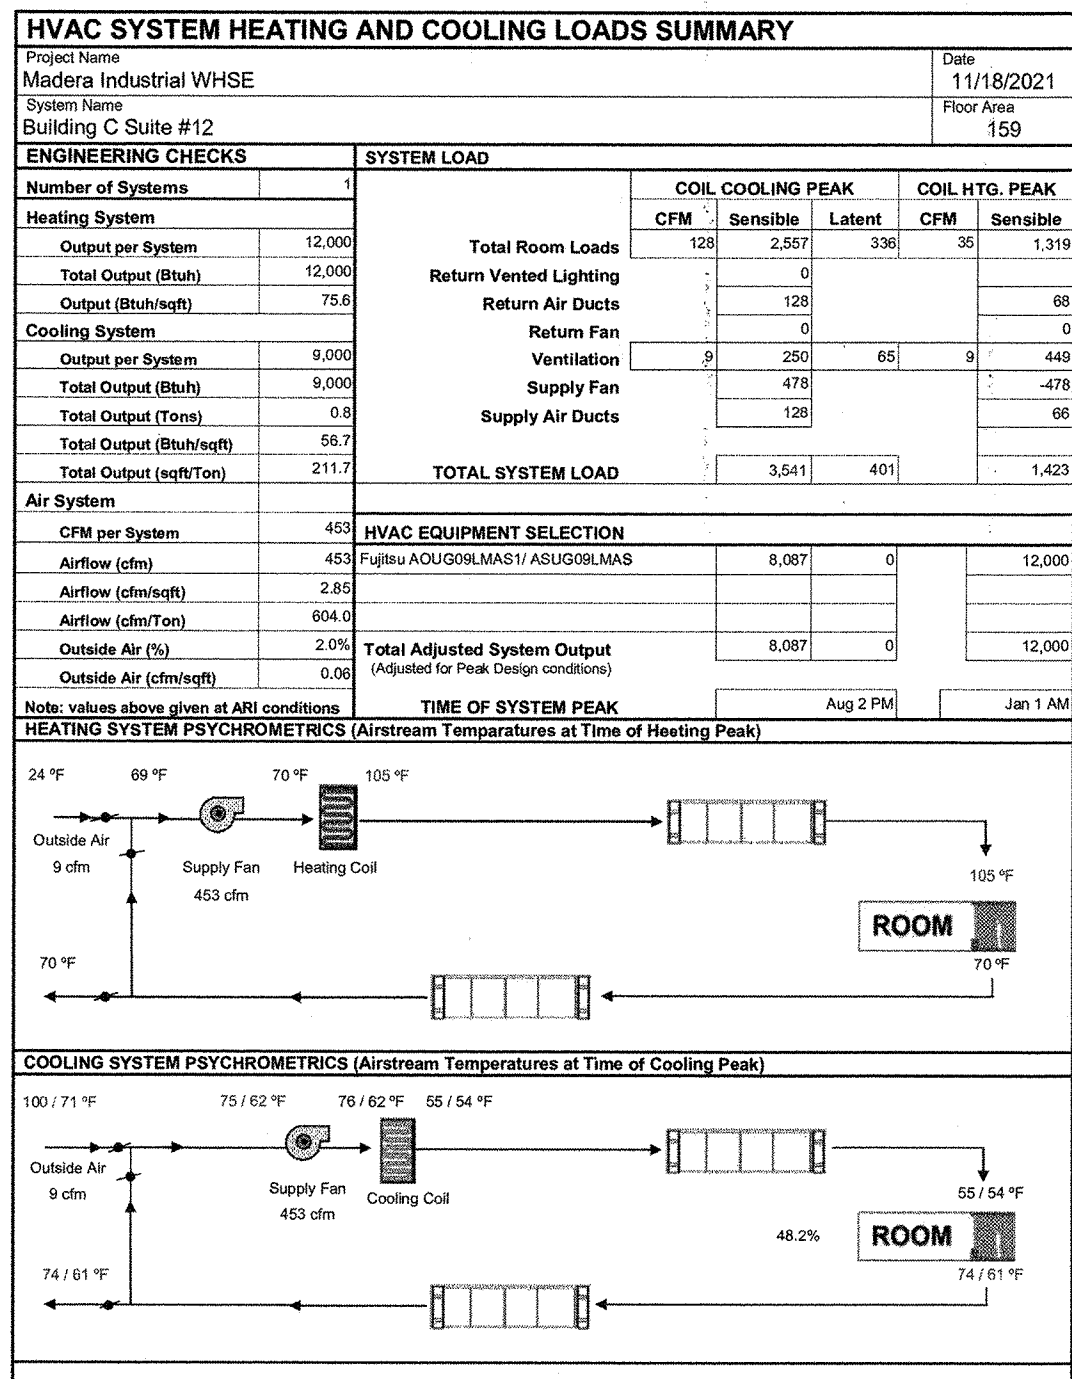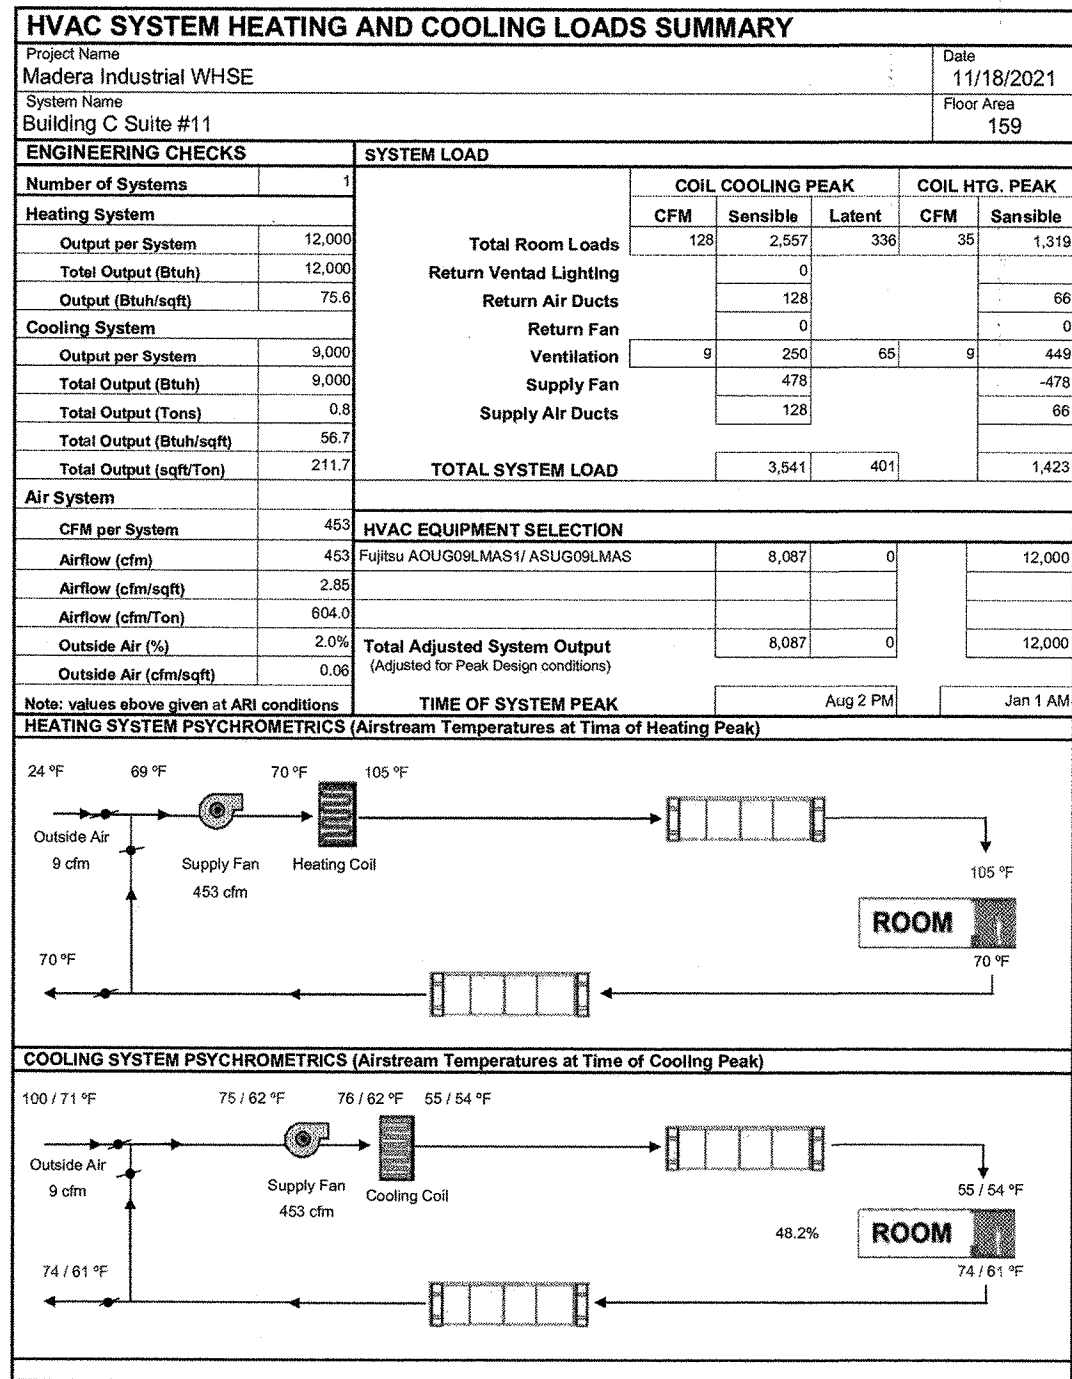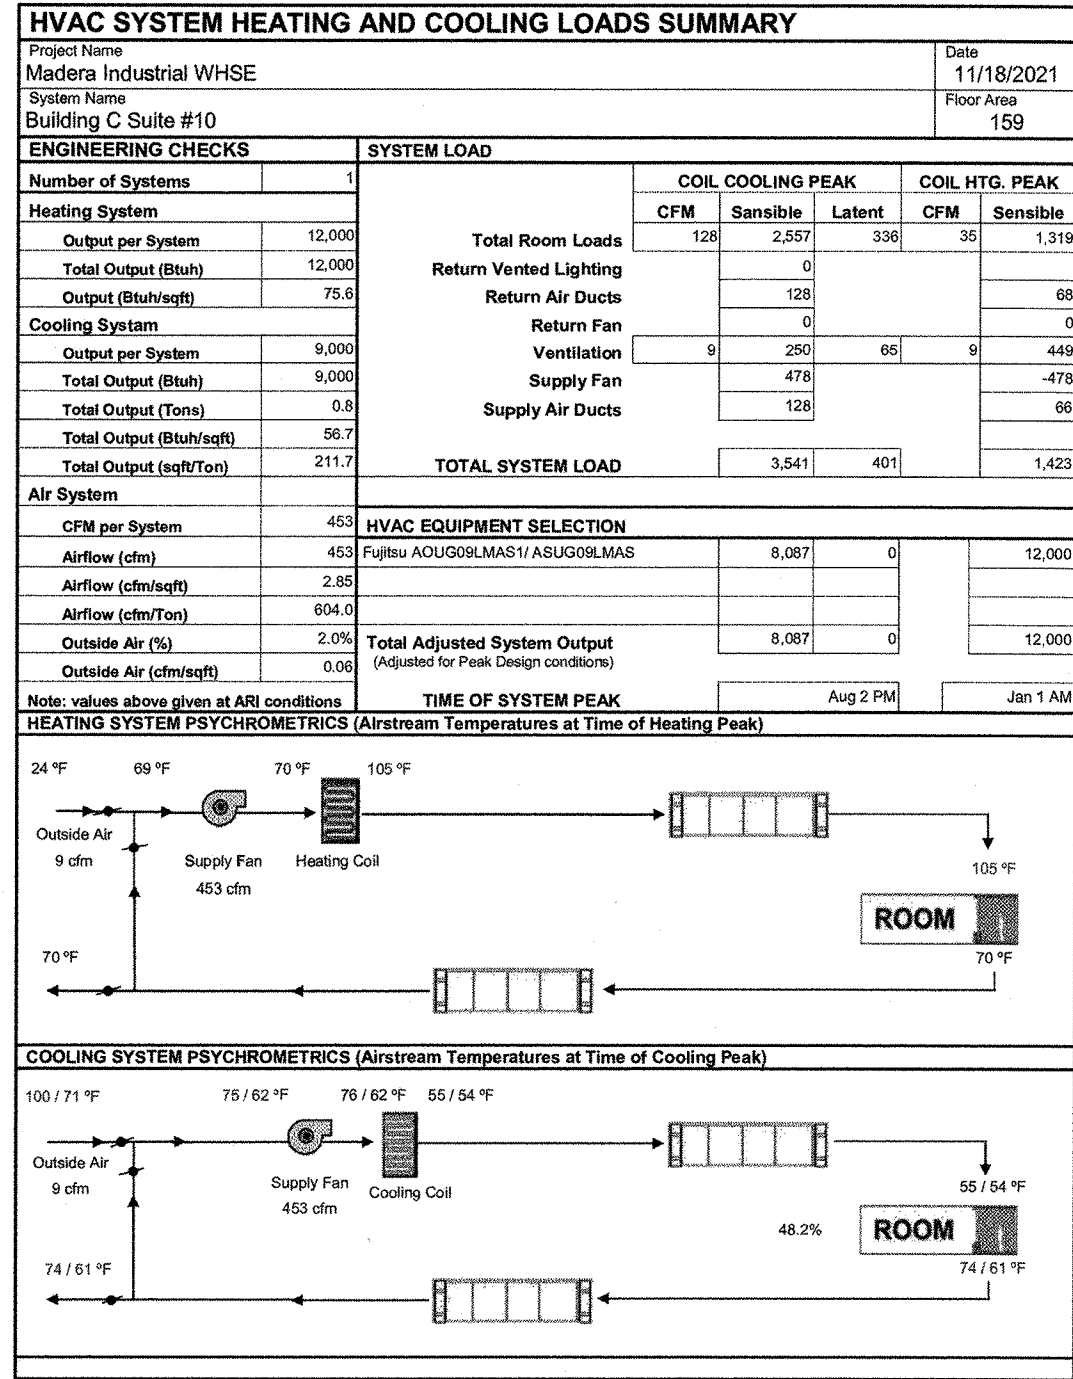

These plans or drawings or any part of these publications are the exclusive property of VAR, and may not be reproduced, or transmitted in any form or by any means, recording, electronic, mechanical, photocopying or otherwise without written permission by VAR. Copies of these drawings are supplied to the owner or the Building Contractor and, otherwise for the use of this project only. Any Re-use of these drawings or documents is prohibited without the written permission of VAR. If VAR is not awarded the project, VAR will not warrant these plans, drawings or contents and will not assume any liability or responsibility for the unauthorized use of these plans or drawings, and the plans or drawings and contents must be returned to VAR immediately.

Air Conditioning & Heating  
Custom Sheet Metal  
Sales & Service

VAR  
Since 1970  
856 S Topolka Ave  
Fresno, CA 93721  
555-897-8188

Signed Steve Mendez Date: 11-18-21  
License #099606  
Valley Air Conditioning & Repair



50 Years of  
Indoor comfort.

TYPICAL MECHANICAL FLOOR PLAN  
FOR  
LEASE FLEX. / WAREHOUSE BUILDINGS  
MADERA INDUSTRIAL WHSE, LLC  
S. SCHNOOR AVENUE, MADERA, CA

JOB NUMBER  
21107

DESIGNED BY











DRAWN BY

DATE  
9/09/2021

SHEET NUMBER


M10



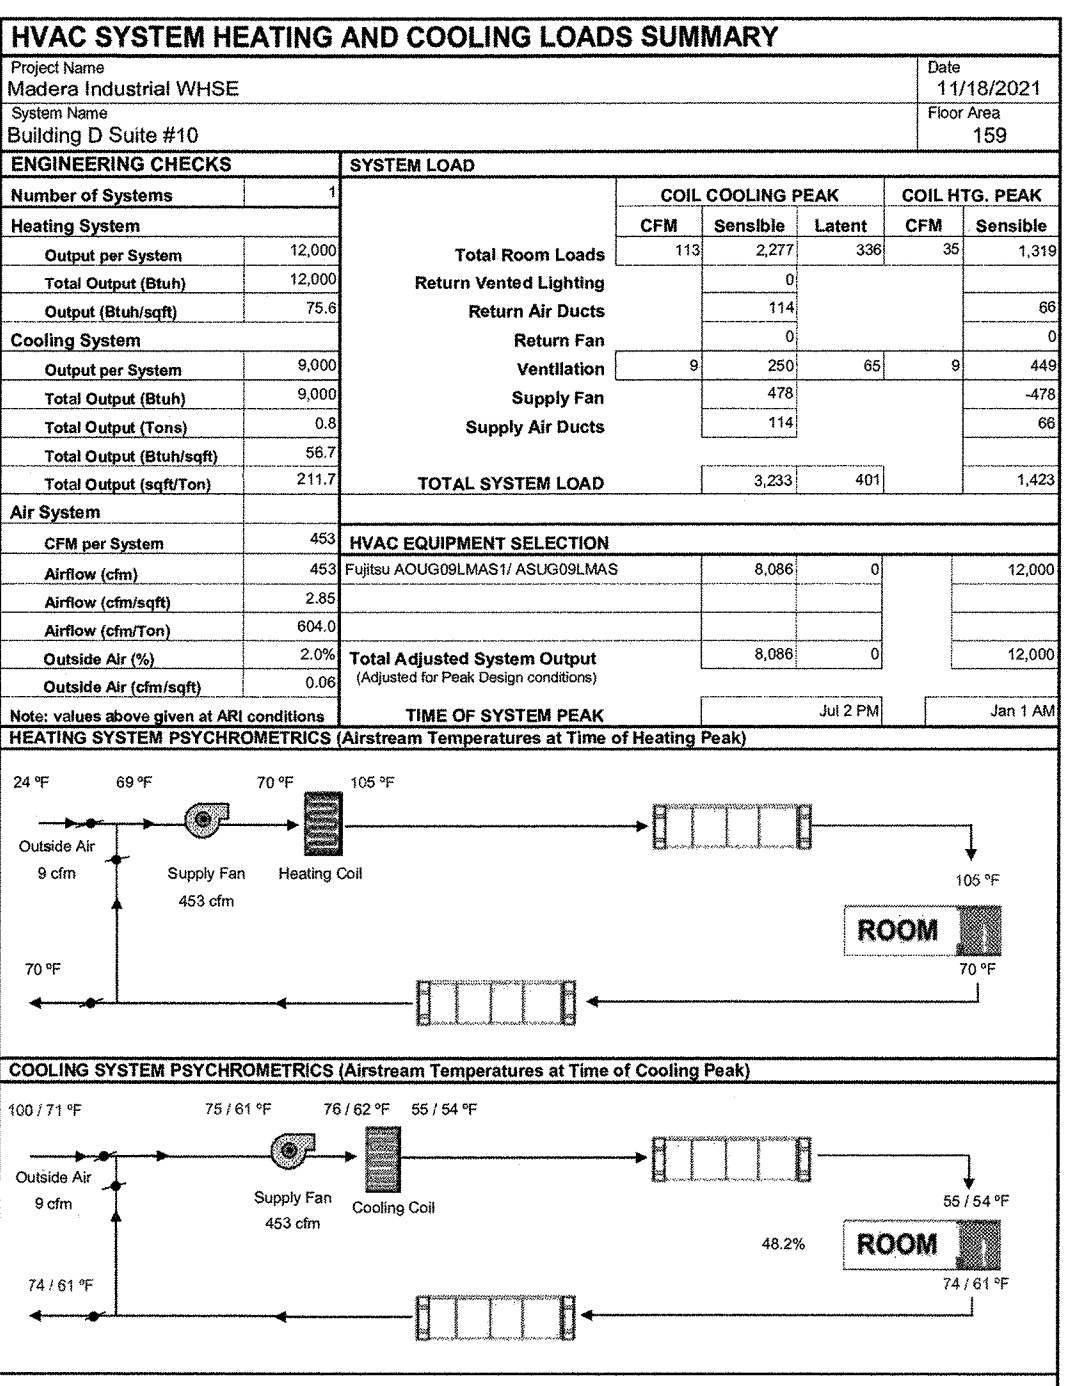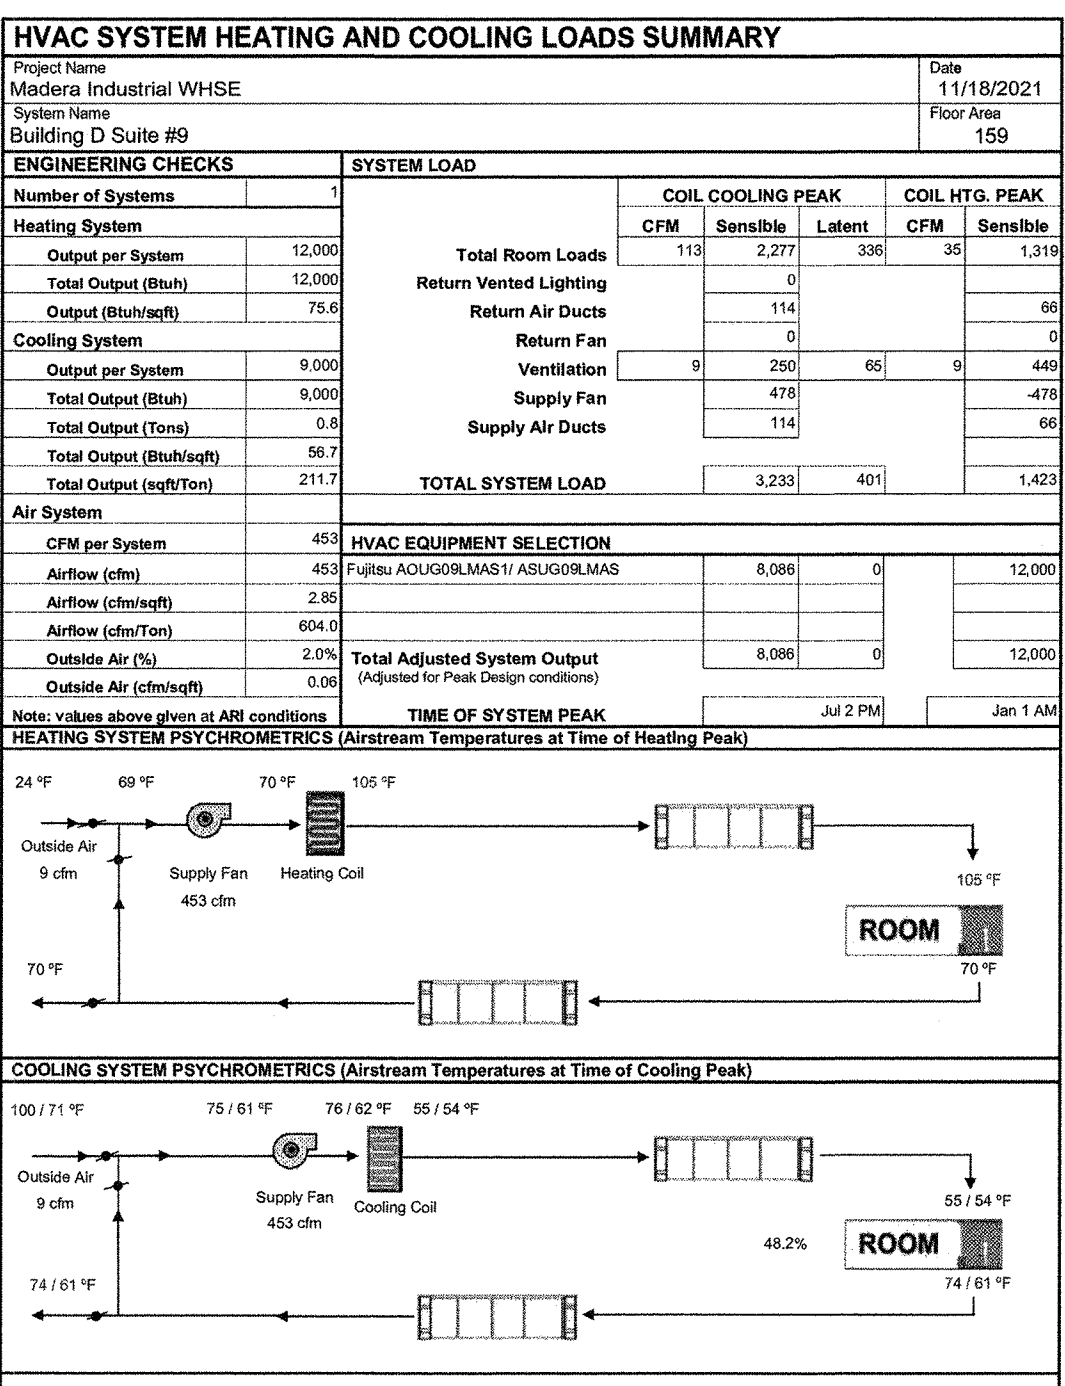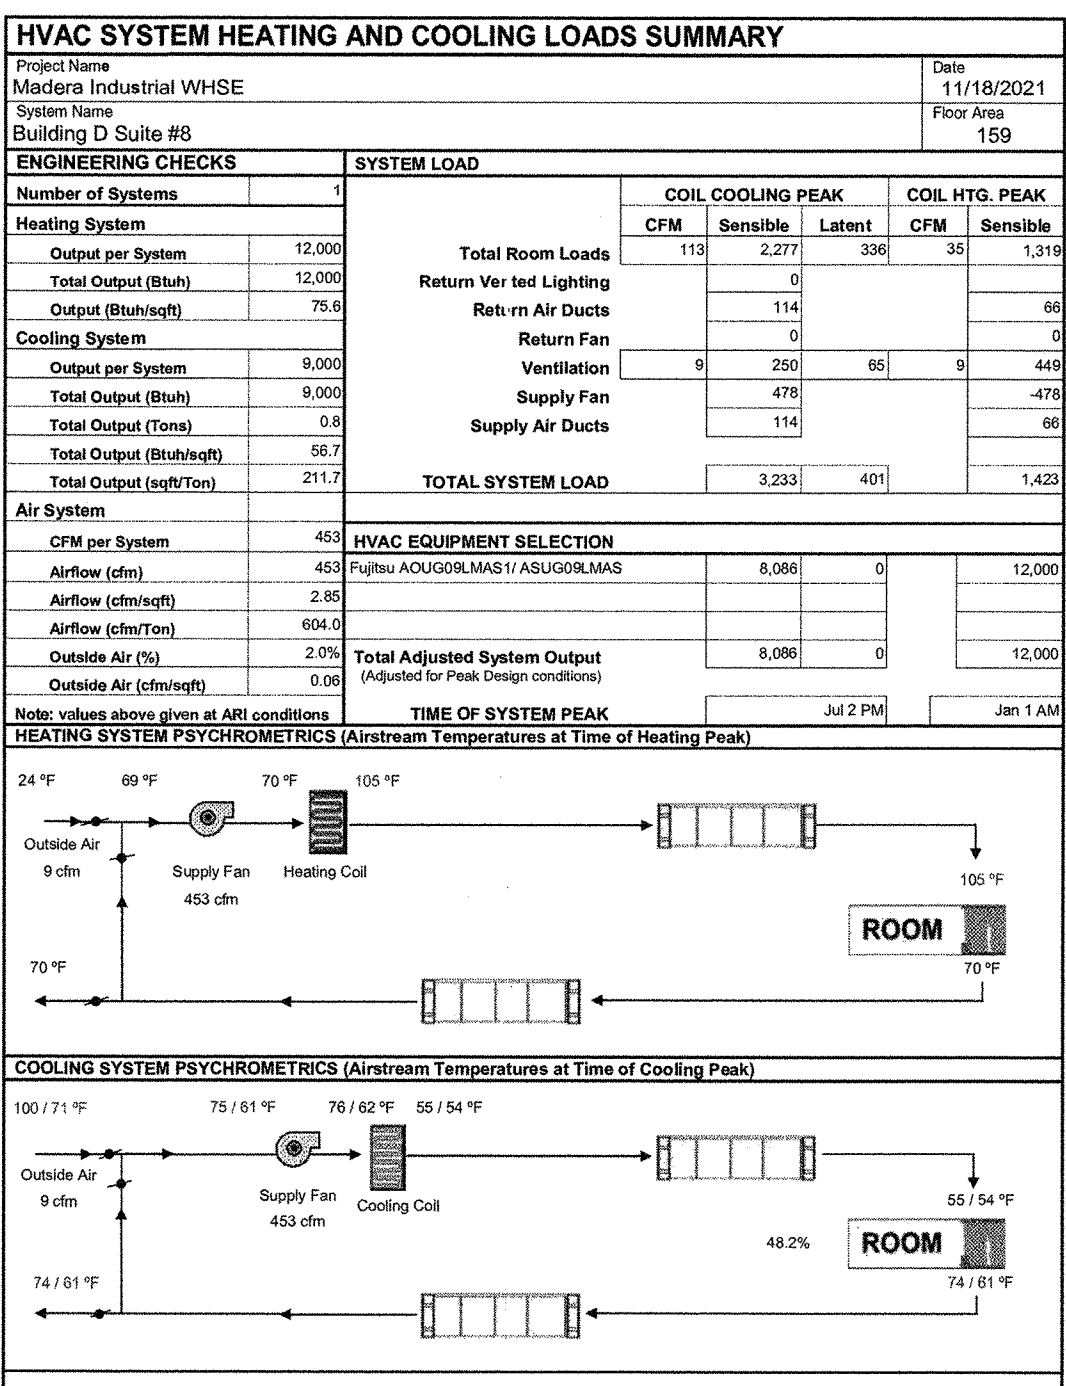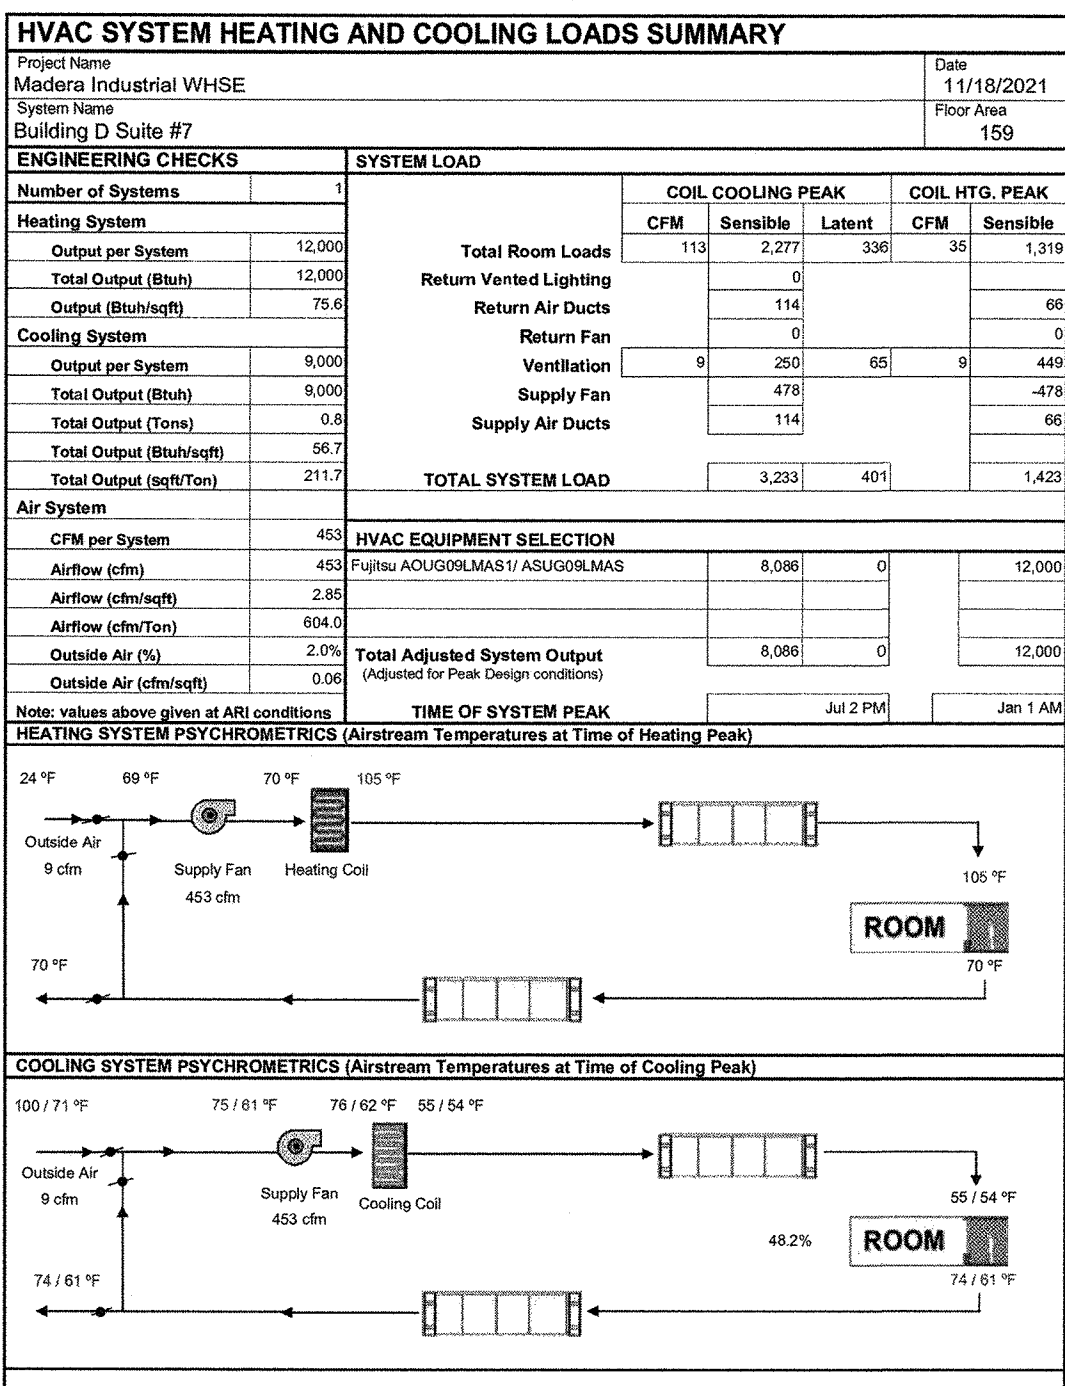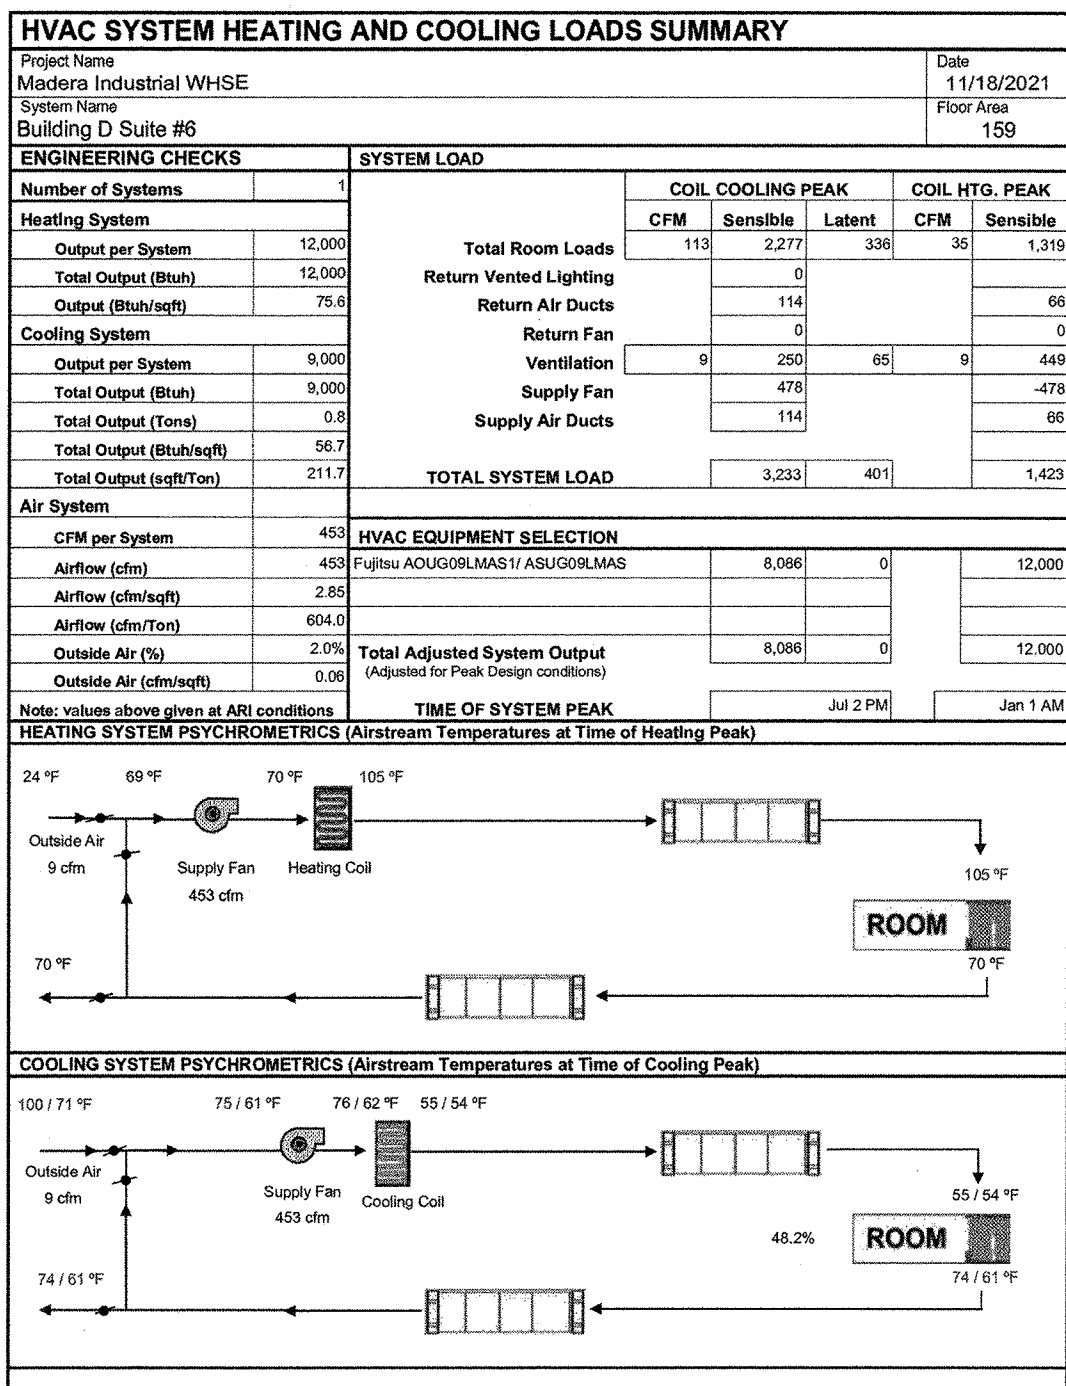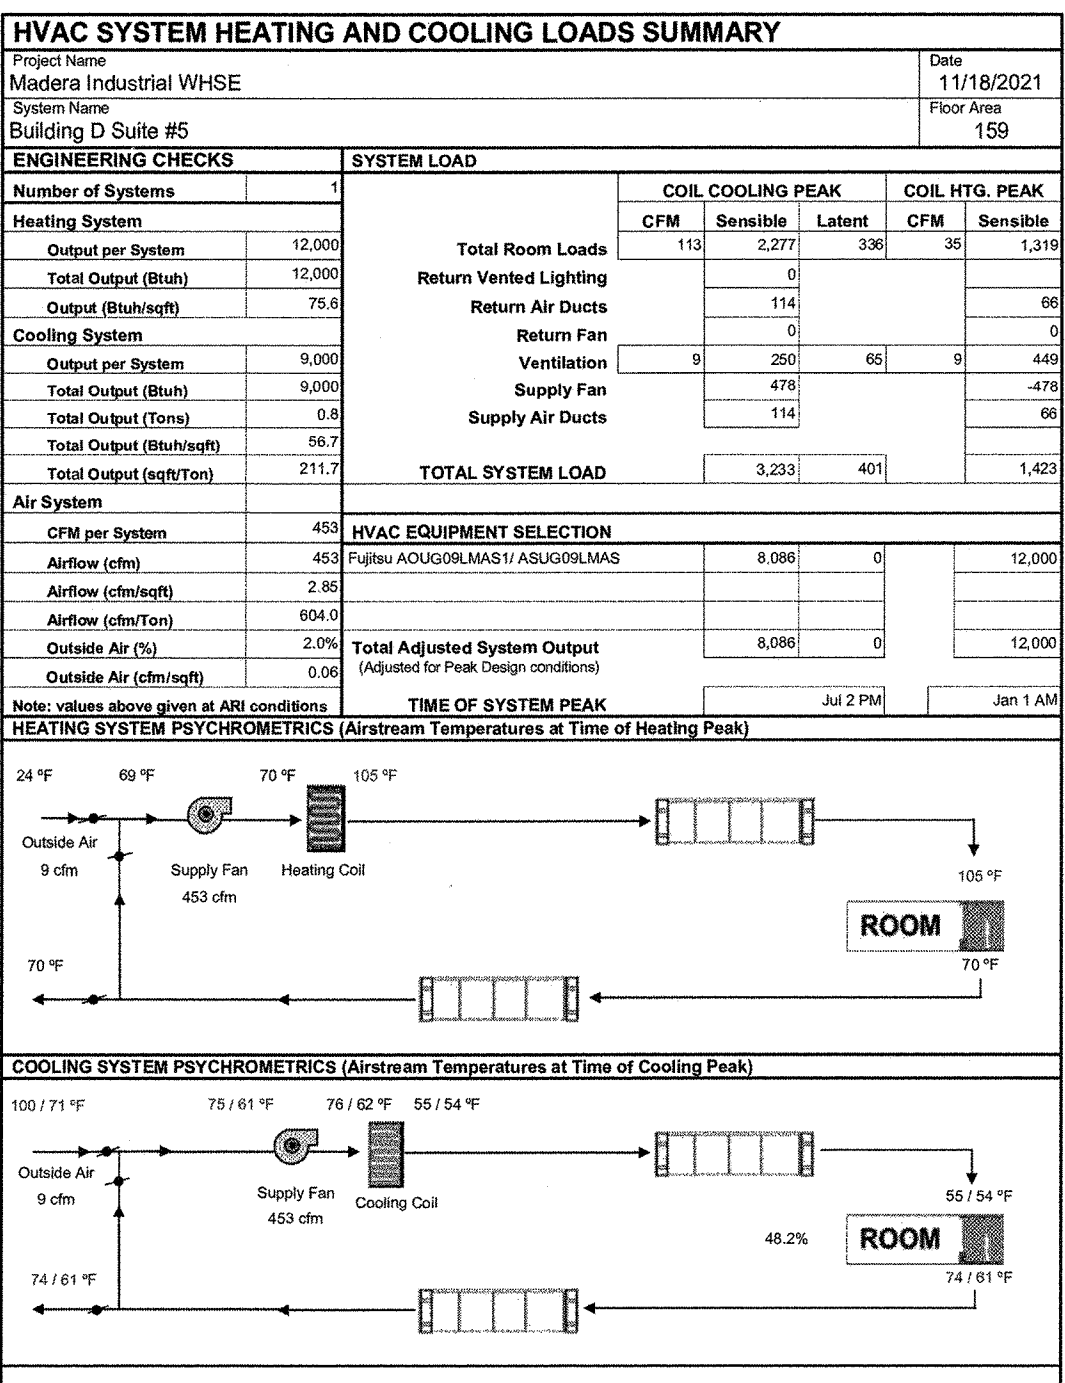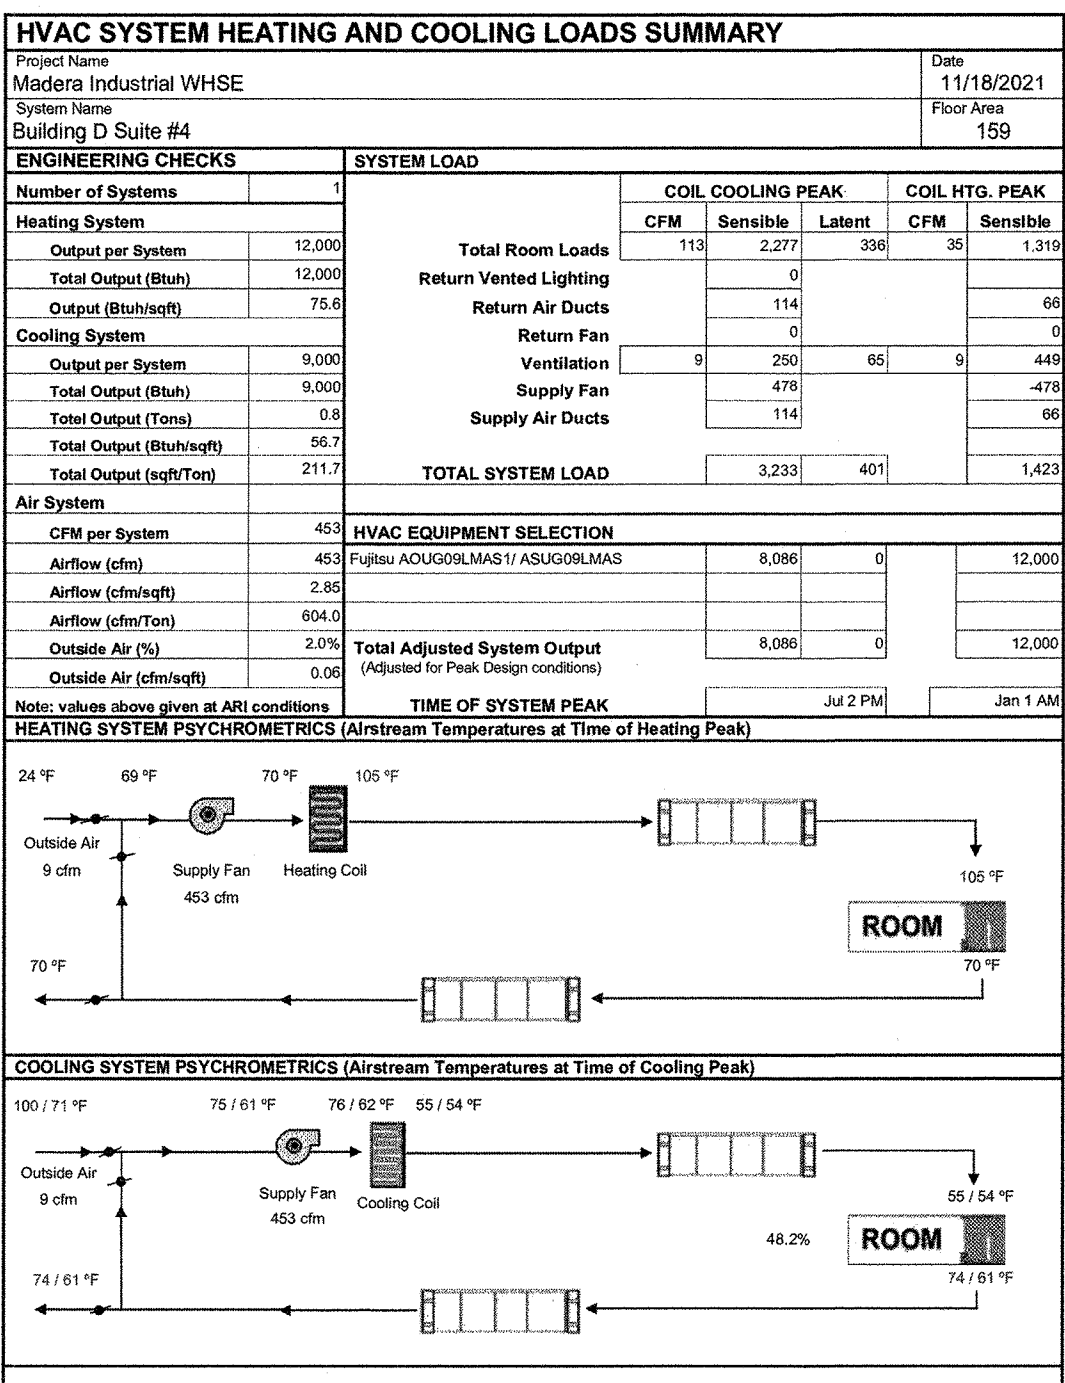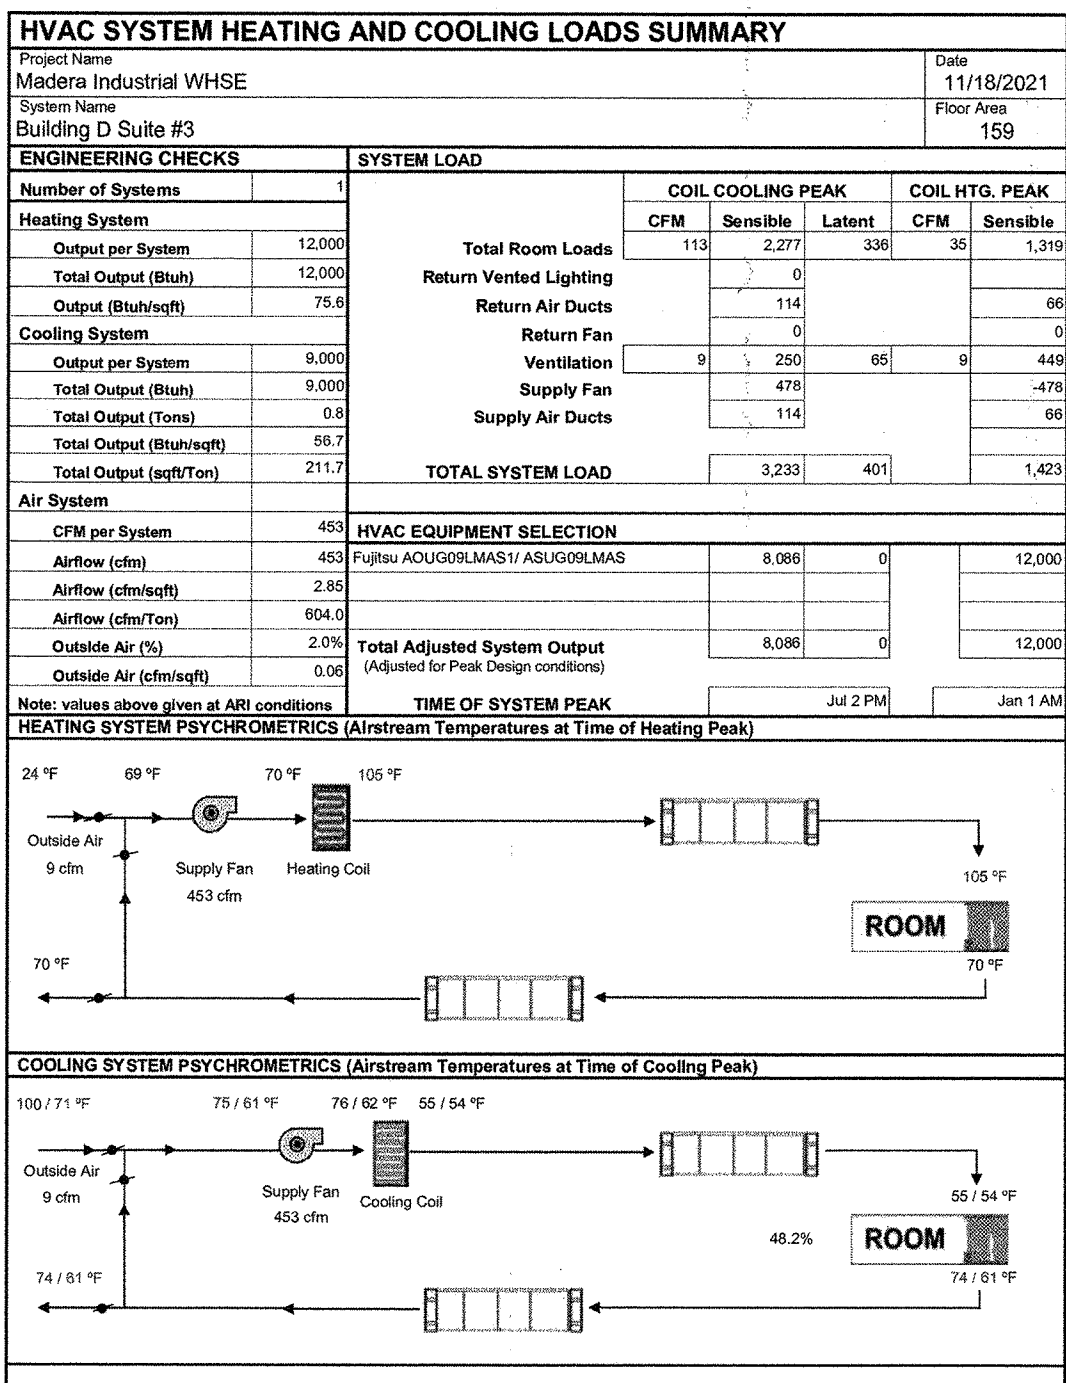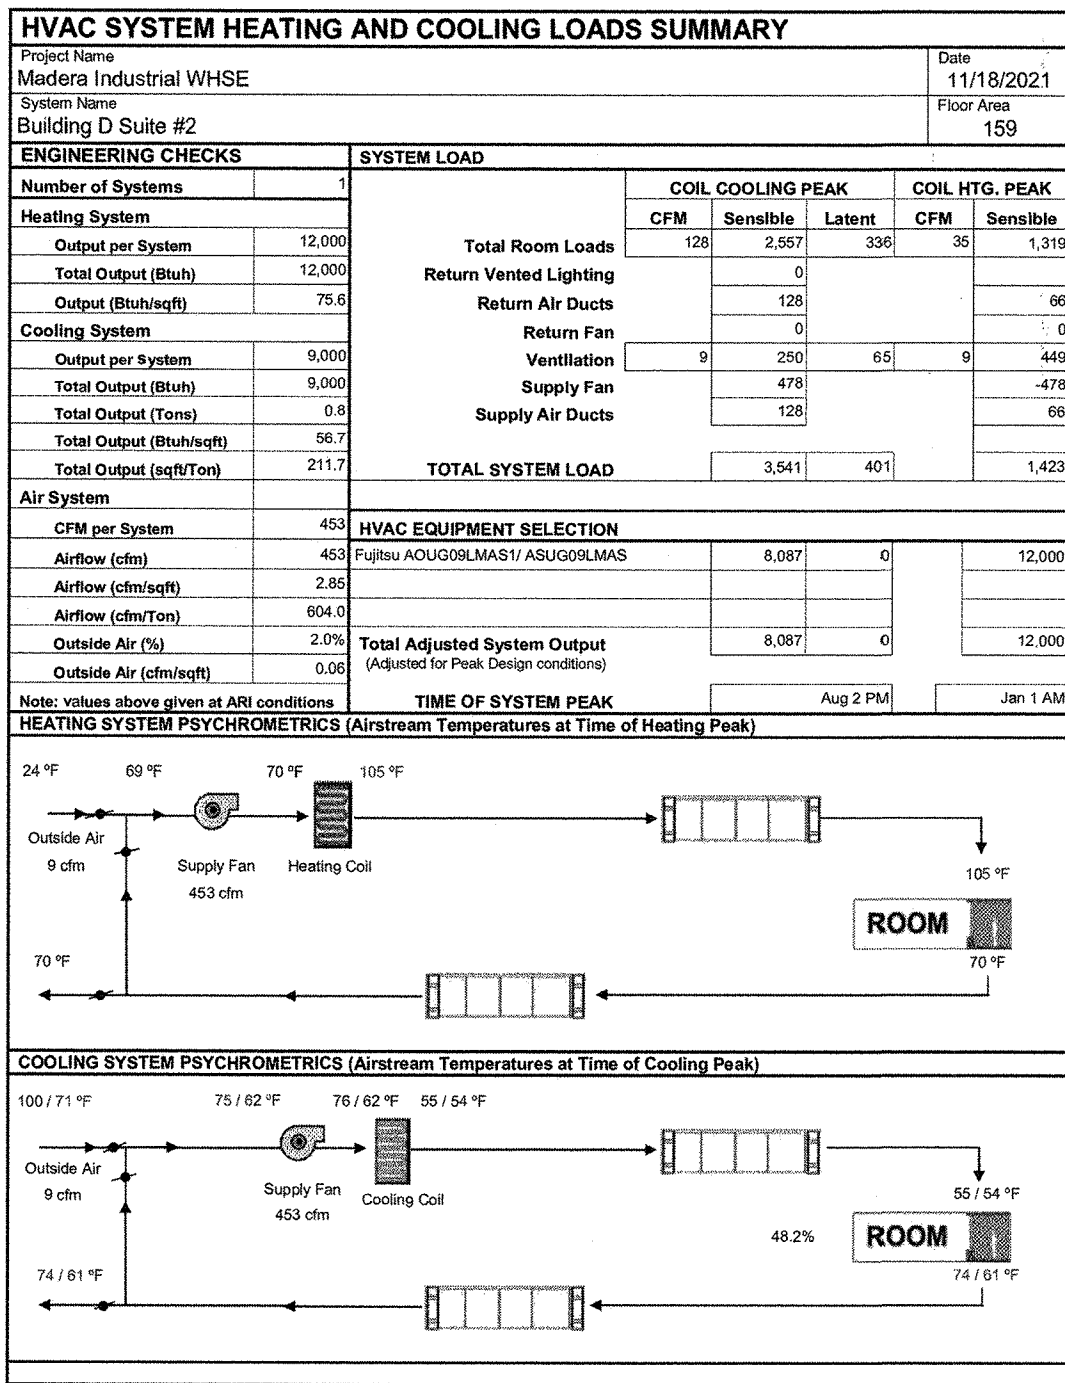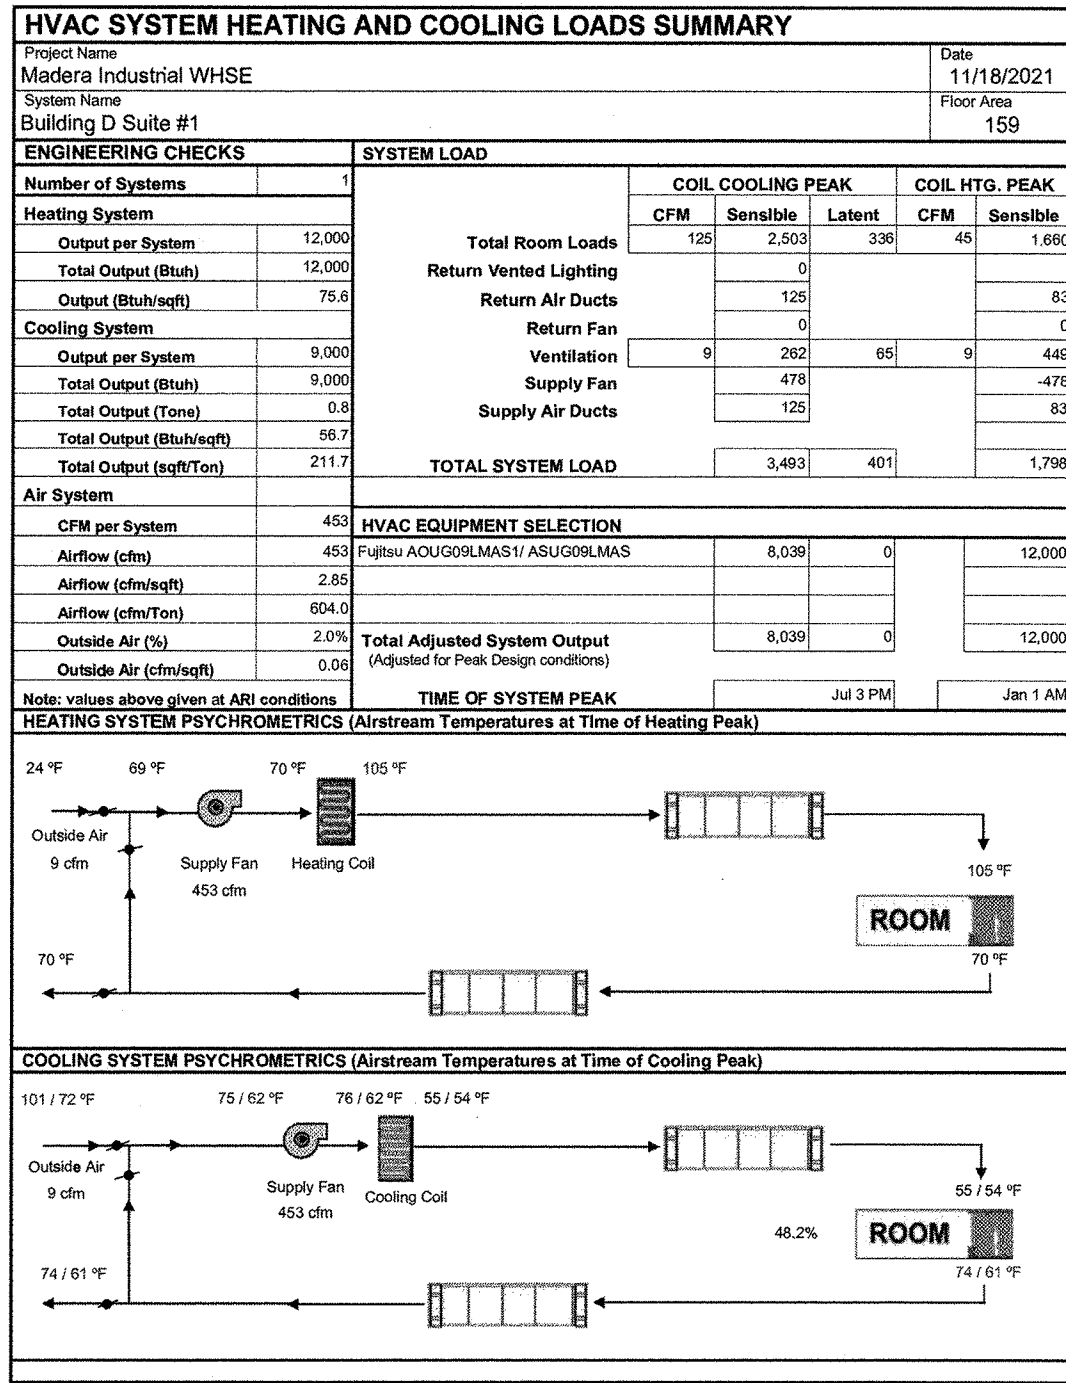

These plans or drawings or any part of these publications are the exclusive property of VAR, and may not be reproduced, or transmitted in any form or by means, recording, electronic, mechanical, photocopying or otherwise without written permission by VAR. Copies of these drawings are applied to the owner or the Building contractor and, otherwise for the use of this project only. Any use of these drawings or documents is prohibited without the written permission of VAR. If VAR is not awarded the project, VAR will not warrant these plans, drawings or contents and will not assume any liability or responsibility for the unauthorized use of these plans or drawings, and the plans or drawings and contents must be returned to VAR immediately.

VAR  
Since 1970  
825 S Topeka Ave  
Fresno, CA 93721  
559-237-3188

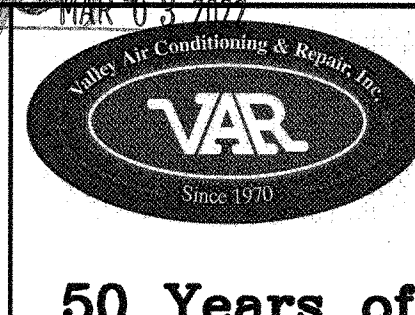

Air Conditioning & Heating  
Custom Sheet Metal  
Sales & Service

Steve Mendez  
11-18-21  
Steve Mendez  
11-18-21  
Valley Air Conditioning & Repair

TYPICAL MECHANICAL FLOOR PLAN  
FOR  
LEASE FLEX. / WAREHOUSE BUILDINGS  
MADERA INDUSTRIAL WHSE, LLC  
S. SCHNOOR AVENUE, MADERA, CA

JOB NUMBER 21107  
DESIGNED BY  
DRAWN BY  
DATE 9/09/2021  
SHEET NUMBER M11









- NOTES
1. LIGHTS ON FRONT ONLY ON BUILDINGS A, B.
  2. LIGHTS TYPICAL ON BUILDINGS A, B, C, D.

TYPICAL FOR ALL 4 BUILDINGS A, B, C, D  
(325, 345, 335, 355 S SCHNOOR AVE MADERA 93637)

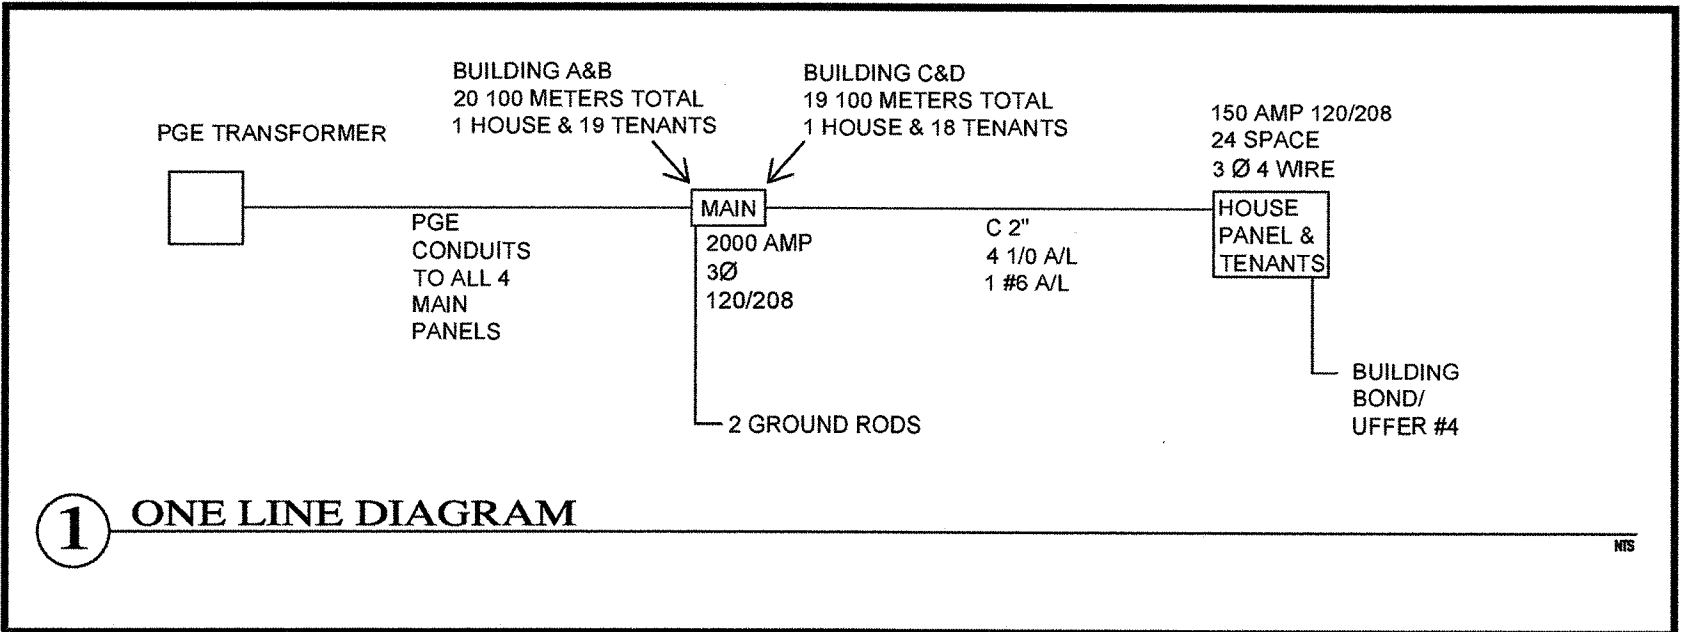

TYPICAL FOR ALL 4 BUILDINGS A, B, C, D

120/208 3Ø 4 WIRE					PANEL HOUSE 150 AMP MAIN		10,000 BREAKER ATC 4 MAX. ENCL DEPTH SURFACE MOUNTED				
CIR	BKR	A	LOAD AMPS B	C	DESCRIPTION	DESCRIPTION	C	LOAD AMPS B	A	BKR	CIR
1	20	12			OUTSIDE LIGHTS	OUTSIDE LIGHTS			12	20	2
3	11		12		11	11		12		11	4
5	20			10	GATES	EV FUTURE	32			40	6
7	20	12			SUMP PUMP OUTLET	11			32	11	8
9						EV FUTURE		32		40	10
11						11	32			11	12
13						EV FUTURE		32		40	14
15						11		32		11	16
17						EV FUTURE	32			40	18
19						11		32		11	20
21											22
23											24
25											26
27											28
29											30
31											32
33											34
35											36
37											38
39											40
41											42
TOTAL		24	12	10	PHASE A 132 AMPS PHASE B 88 AMPS PHASE C 106 AMPS		96	76	108	TOTAL	

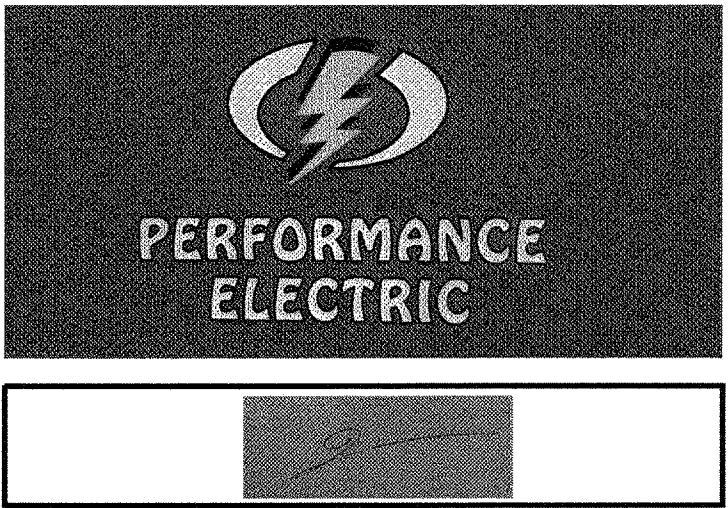

CONTRACTOR:

**DBKO**  
DESIGN BUILD  
8839 NORTH CEDAR #374  
FRESNO, CA 93720  
(559) 930-DBKO

**WHSE**  
[PARTNERS]

BY: BN

REVISION

DATE: 9/08/2021

SEAL

ANY INFORMATION OR DATA ON THIS DRAWING IS NOT INTENDED TO BE SUITABLE FOR REUSE BY ANY PERSON, OR FOR ANY OTHER PROJECT, WITHOUT WRITTEN VERIFICATION AND ADAPTATION BY THE ENGINEER FOR THE SPECIFIC PURPOSE INTENDED. WILL BE AT THE USER'S SOLE RISK AND WITHOUT LIABILITY OR LEGAL EXPOSURE TO THE ENGINEER.

ELECTRICAL SITE PLAN  
FOR  
LEASE FLEX. / WAREHOUSE BUILDINGS  
MADERA INDUSTRIAL WHSE, LLC.  
S. SCHNOOR AVENUE  
MADERA, CA 93637


JOB NUMBER

DESIGNED BY: TD

DRAWN BY: BN

DATE: 9/08/2021

SHEET NUMBER: E1

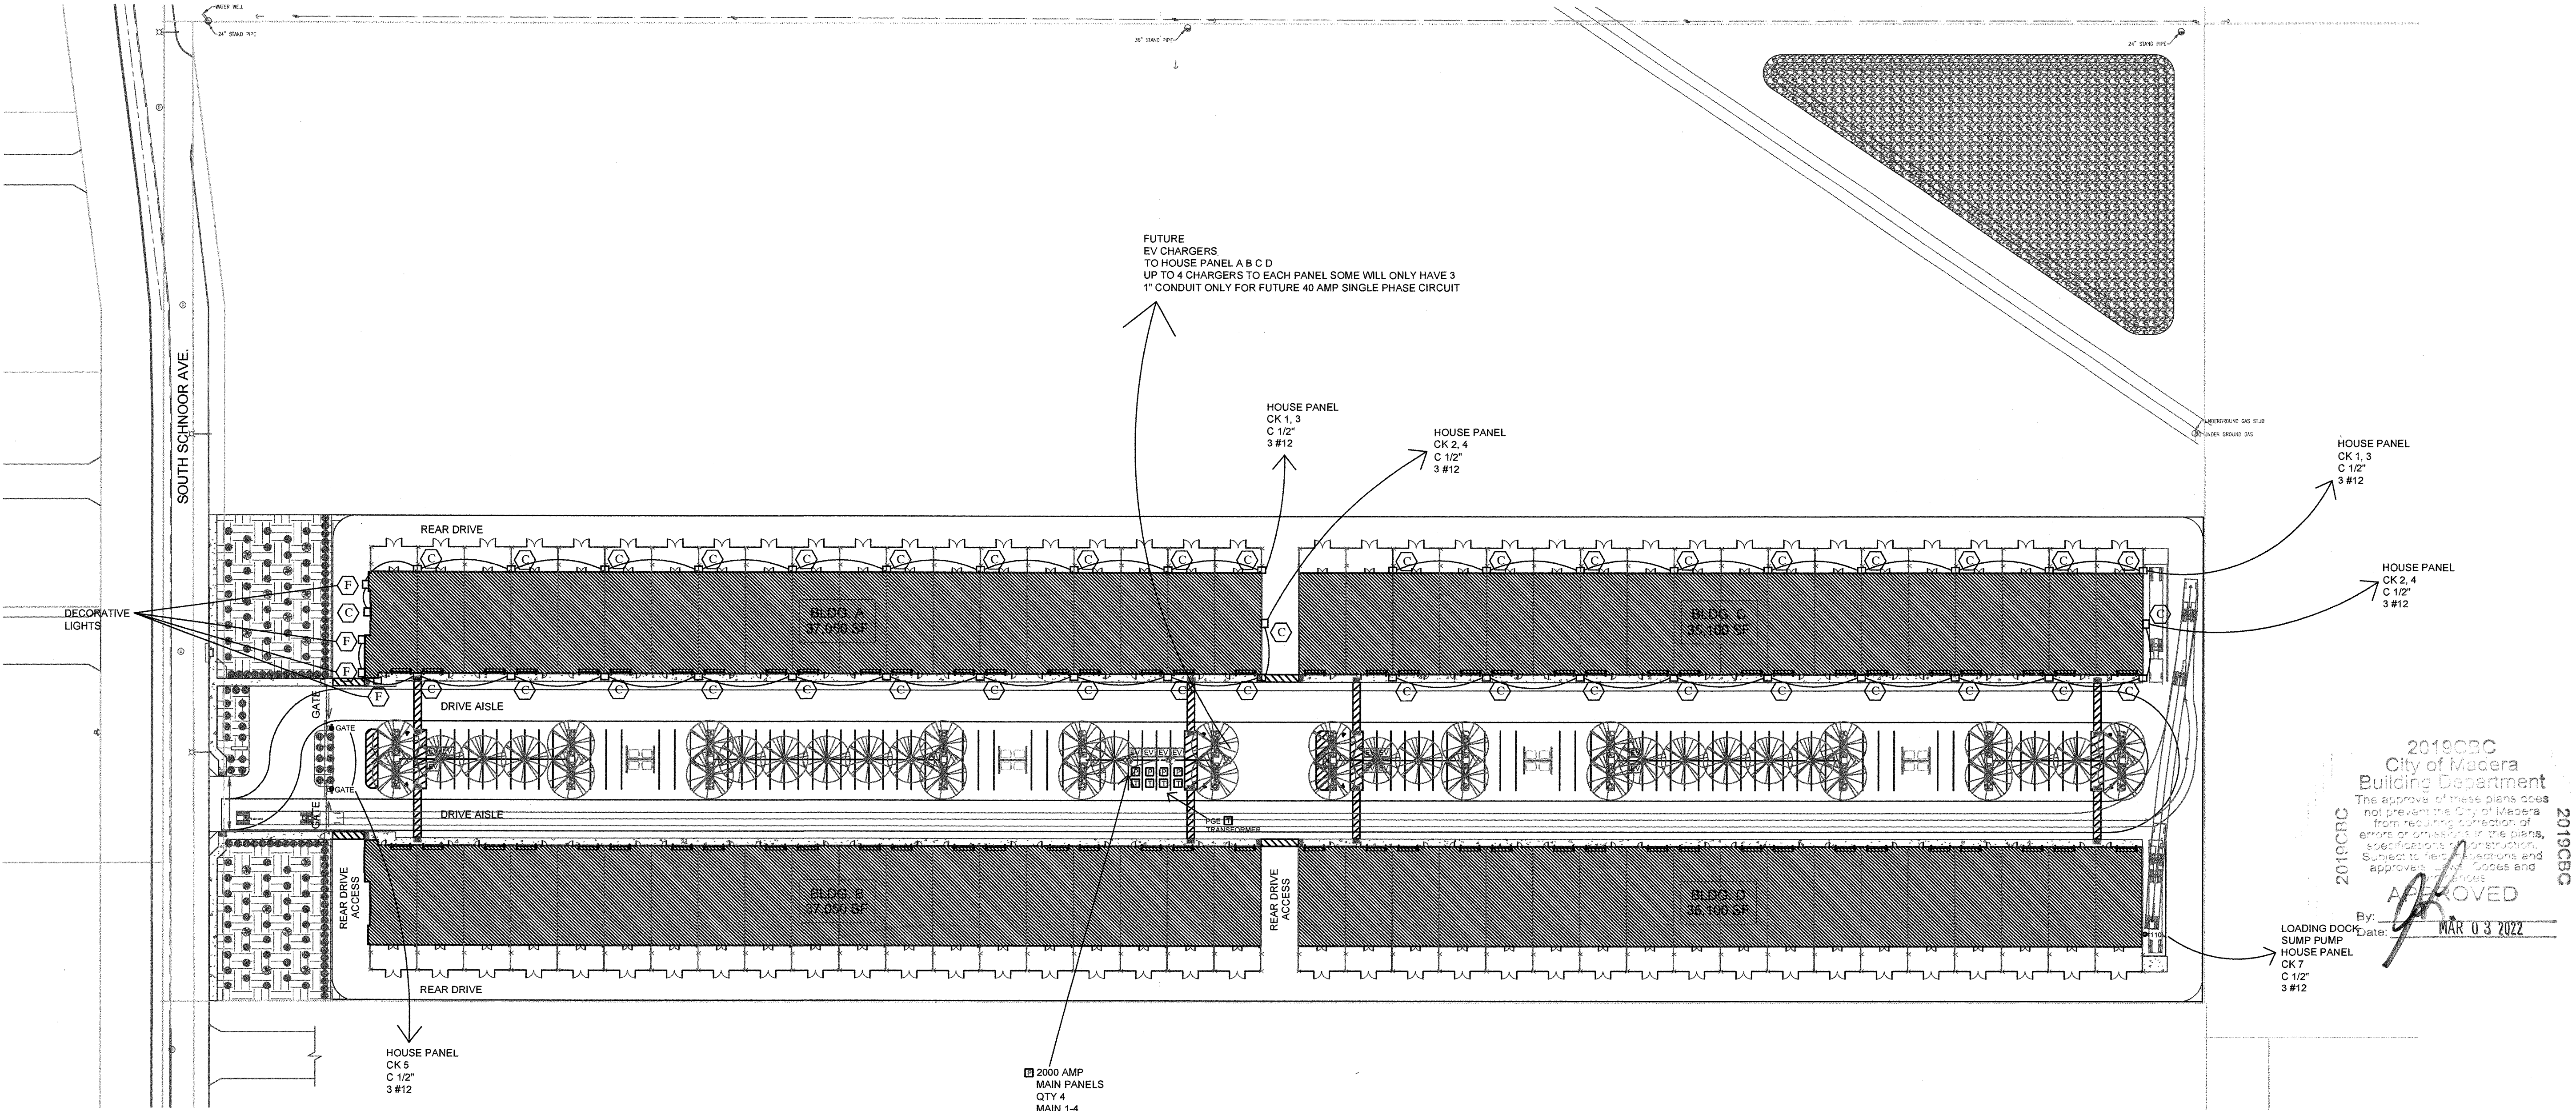



TYPICAL FOR ALL 4 BUILDINGS A, B, C, D

120/208 3Ø 4 WIRE				PANEL L-1-L-4 100 AMP MAIN LUG				10,000 BREAKER ATC 4 MAX, ENCL DEPTH SURFACE MOUNTED			
CIR	BKR	A	B	C	DESCRIPTION	DESCRIPTION	C	B	A	BKR	CIR
1	20	5			SHOP OUTLET	SHOP OUTLET			5	20	2
3	20		5					5			4
5	20			5			5			20	6
7	20	2			SHOP LIGHTS	SWAMP COOLER			10	20	8
9	20		5		OFFICE OUTLET			10		20	10
11	20			5	BATH GFI	BATH/ OFFICE LIGHTS	2			20	12
13	20	2			EMERGENCY	SHOP HEATER		41		50	14
15	20		8		OFFICE A/C				41	50	16
17	11			8		INSTA HOT	12			20	18
19											20
21											22
23											24
25											26
27											28
29											30
31											32
33											34
35											36
37											38
39											40
41											42
TOTAL		9	18	18	PHASE A 65 AMPS PHASE B 74 AMPS PHASE C 37 AMPS		19	56	56	TOTAL	

ELECTRICAL SYMBOL LEGEND

	=	OUTLETS
	=	GFI OUTLETS
	=	EXTERIOR EXIT LIGHTS
	=	EMERGENCY/ EXIT LIGHTS
	=	LED LIGHTS FOR SHOP ON MOTION
	=	1X4 LED LIGHTS
	=	EXTERIOR LIGHT
	=	SWITCH WITH MOTION
	=	3 WAY SWITCH
	=	CONDUITS
	=	CIRCUITS

SYMBOL	LUMINAIRE DESCRIPTION	NO. OF LUMIN.	WATTS PER LUMIN.	TOTAL WATTS
	METALUX WNLCD UTILITY LED WRAPAROUND	SEE ATTACHED SPEC SHEETS		
	ORBIT DECORATIVE WET LOCATION LED EMERGENCY LIGHT	SEE ATTACHED SPEC SHEETS		
	SYLVANIA NON CUTOFF WALL PACK	SEE ATTACHED SPEC SHEETS		
	ULTI-BAY AL-HB***60	SEE ATTACHED SPEC SHEETS		
	SURE-LITE EMERGENCY LIGHTS	SEE ATTACHED SPEC SHEETS		
	4' LED ARCHITECTURAL SQUARE CYLINDER UP & DOWNRIGHT	SEE ATTACHED SPEC SHEETS		



LIGHTING SCHEDULE

NO SCALE

2K

NOTES

1. SHOP LIGHTS ON MOTION.
2. TYPICAL FOR ALL UNITS IN BUILDINGS A, B, C, D.
3. ALL LIGHTING TO BE LED.
4. ALL OUTLETS REQUIRED BY NEC IN WET LOCATIONS TO BE GFI.
5. ALL WIRE COPPER UNLESS NOTED OTHERWISE.
6. OFFICE/ BATHROOMS WIL BE DONE IN MC

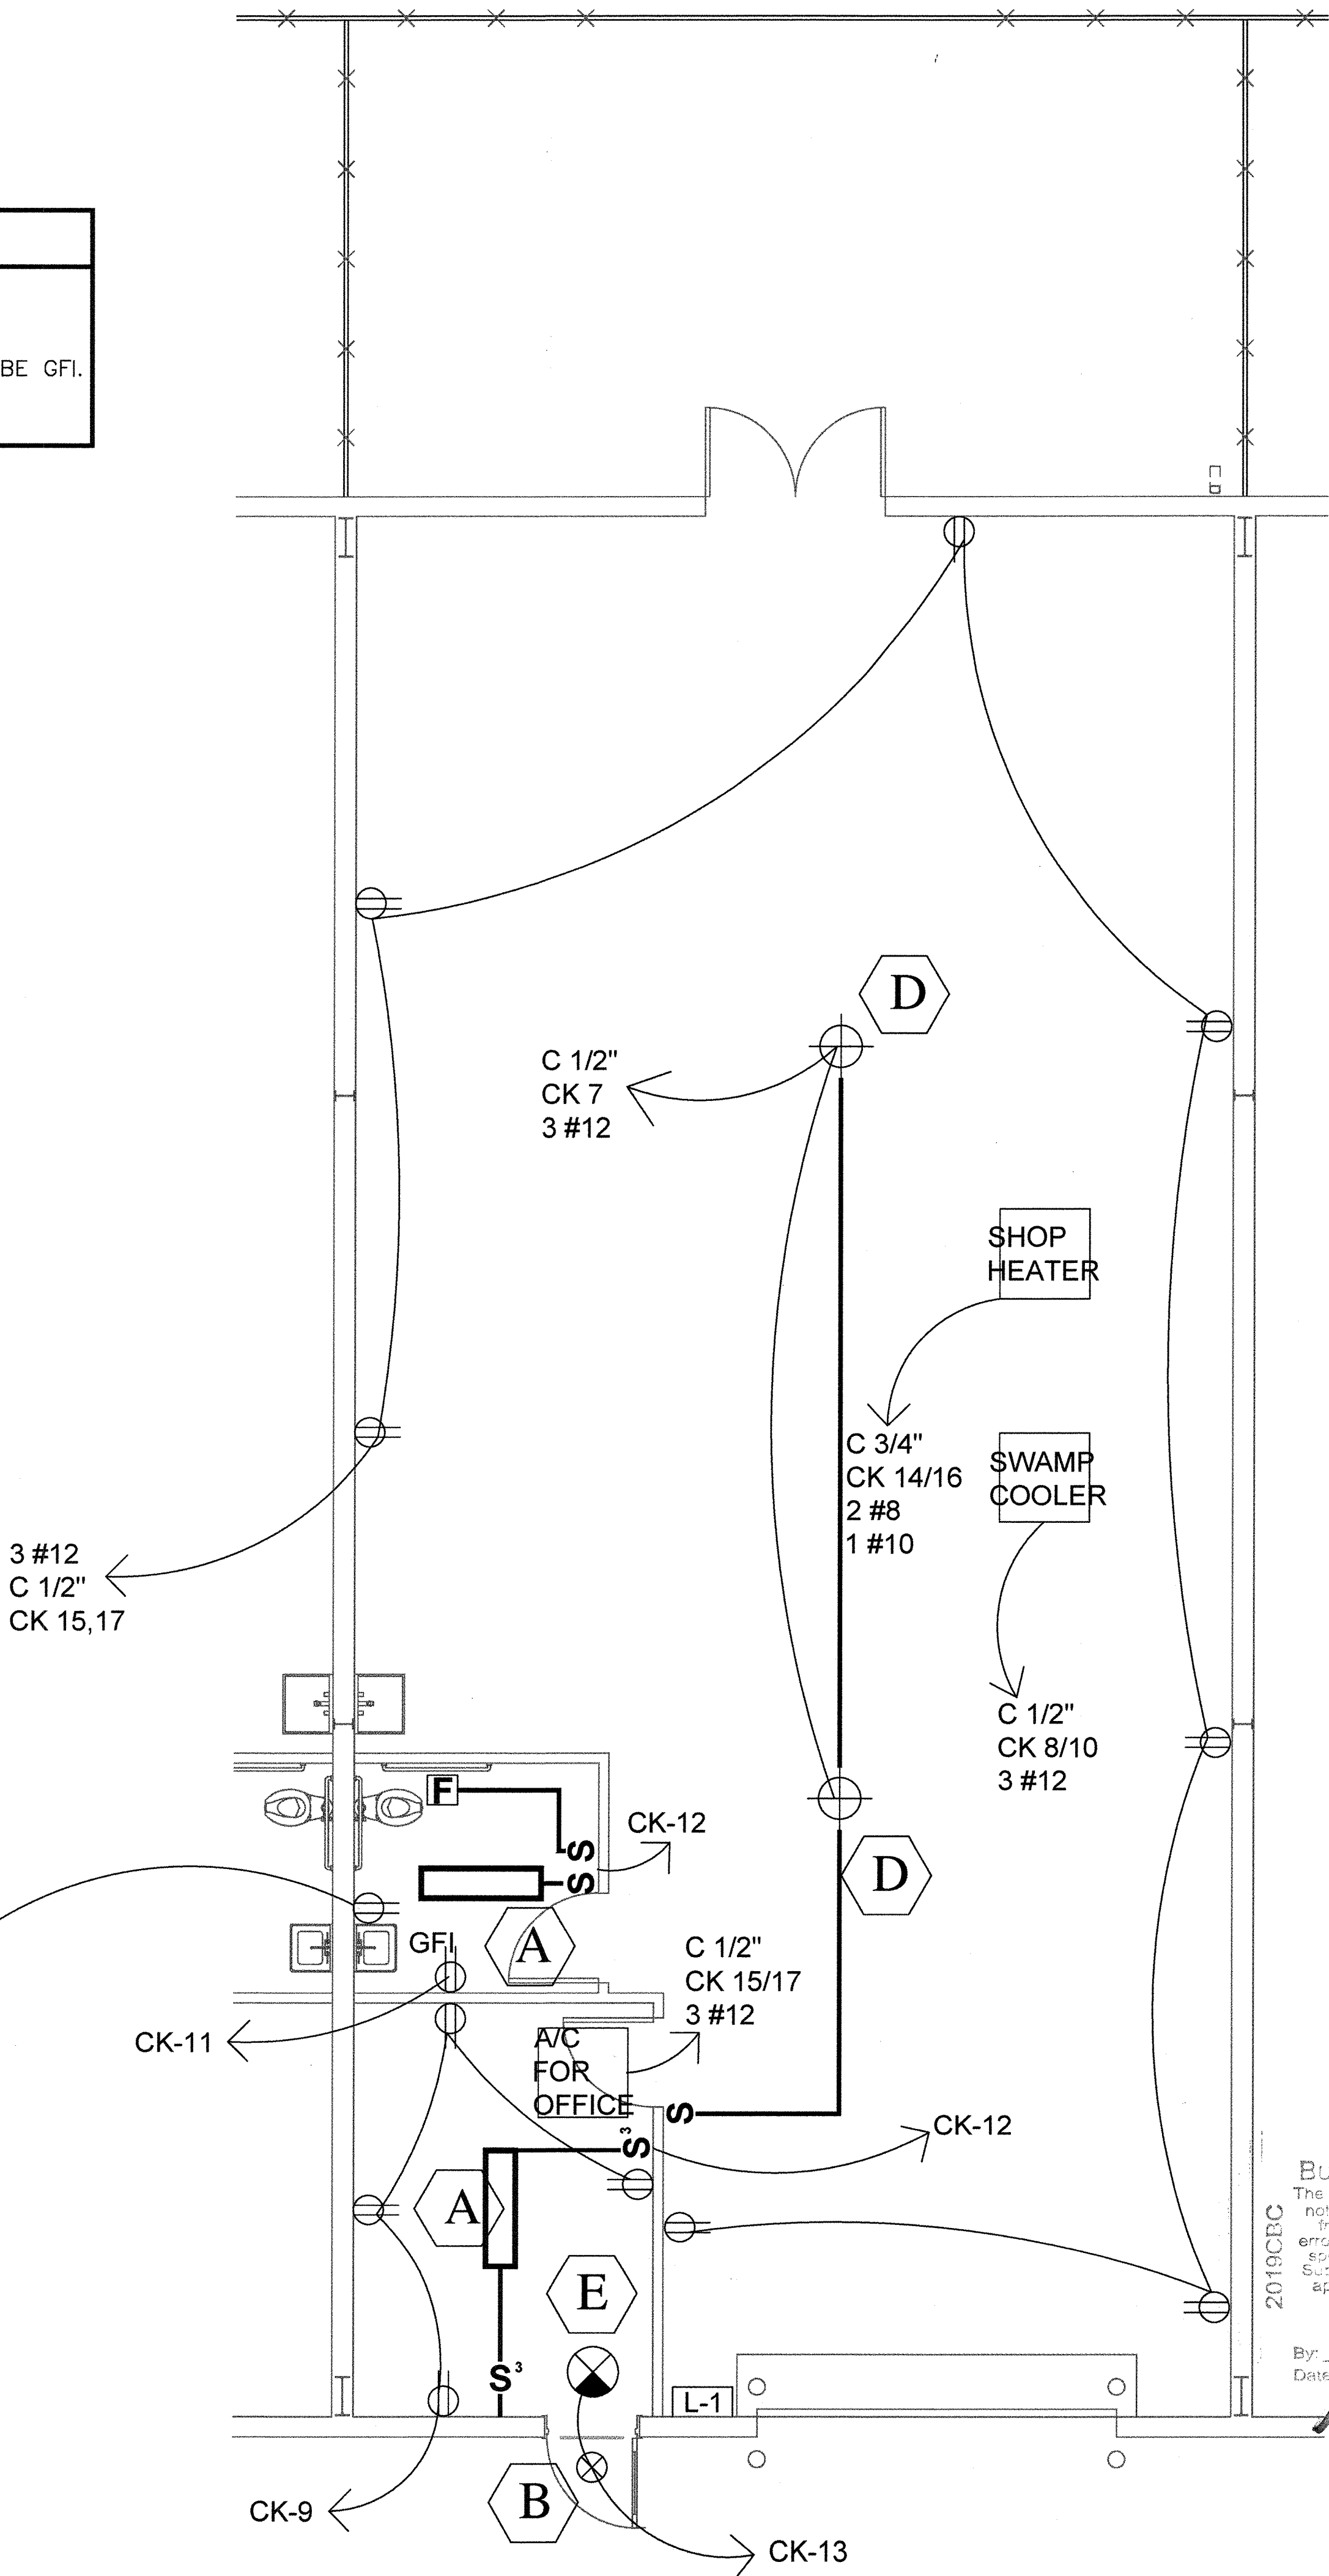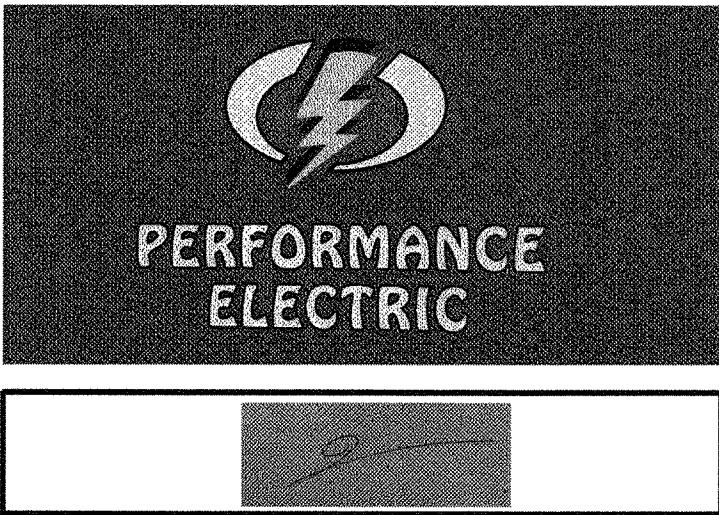

CONTRACTOR:

**DBKO**  
DESIGN • BUILD  
8839 NORTH CEDAR #374  
FRESNO, CA 93720  
(559) 930-DBKO

**WHSE**  
[PARTNERS]

BY	BN
REVISION	
DATE	9/08/2021
SEAL	

ELECTRICAL PLAN

FOR

LEASE FLEX. / WAREHOUSE BUILDINGS

MADERA INDUSTRIAL WHSE, LLC.

S. SCHNOOR AVENUE  
MADERA, CA 93637

JOB NUMBER	
DESIGNED BY	TD
DRAWN BY	BN
DATE	9/08/2021
SHEET NUMBER	E2



**electrician.com Racewayfill Calculator**  
by electrician.com

This program calculates the number of same size conductors using the 3/8 roundoff method. In the Auto Mode this program limits the fill to 40 per cent for over 2 conductors, 31 per cent for only two conductors, and 53 percent for one conductor. Note: THWN, THHN, and THHW-2 have the same areas. RHH, RHW, and RHW-2 without covering have the same areas. THW-2, THW, and THHW have the same areas. RHL, RHL, RHW, and RHW-2 with covering have the same areas. (This program does not calculate for 3/8 inch FMC and LTFMC - Open Table 348.22 below)  
Enter conductor information starting at the top of the form.  
ALL AREAS ARE IN SQUARE INCHES.

Select Insulation	Select Size	Enter No. Conductors	Wire Area	Total Area
1) XHHW	1/0 AWG	4	1.1825	0.73
2) XHHW	6 AWG	1	1.0590	0.059
3) THHN	14 AWG	0	0	0
4) THHN	14 AWG	0	0	0
5) THHN	14 AWG	0	0	0

Total: 8 Grand Total Area: 0.789

Select Raceway  
Electrical Nonmetallic Tubing

Enter Selections to Start Outputs

Select Fill Value  
Auto  
60 Per Cent (nipples)  
25 Per Cent (sealoffs)

Minimum Raceway Size: 2  
Allowed Raceway area: 1.282  
Available Raceway area: 0.495

Maximum number of same size wires at the Per Cent Fill: 40 %  
JAM RATIO (for 3 conductors only): 4.78  
JAM RATIO between 2.8 and 3.2

To View Table 348.22 for 3/8 inch Flexible Metal and Liquidtight Flexible Metal Conduit  
Open Table 348.22 Close Table 348.22

Last updated: 10/6/105 at 20:8:35 GMT - 0800

**electrician.com Racewayfill Calculator**  
by electrician.com

This program calculates the number of same size conductors using the 3/8 roundoff method. In the Auto Mode this program limits the fill to 40 per cent for over 2 conductors, 31 per cent for only two conductors, and 53 percent for one conductor. Note: THWN, THHN, and THHW-2 have the same areas. RHH, RHW, and RHW-2 without covering have the same areas. THW-2, THW, and THHW have the same areas. RHL, RHL, RHW, and RHW-2 with covering have the same areas. (This program does not calculate for 3/8 inch FMC and LTFMC - Open Table 348.22 below)  
Enter conductor information starting at the top of the form.  
ALL AREAS ARE IN SQUARE INCHES.

Select Insulation	Select Size	Enter No. Conductors	Wire Area	Total Area
1) THHN	12 AWG	8	1.0133	0.1197
2) THHN	14 AWG	0	0	0
3) THHN	14 AWG	0	0	0
4) THHN	14 AWG	0	0	0
5) THHN	14 AWG	0	0	0

Total: 8 Grand Total Area: 0.1197

Select Raceway  
EMT

Enter Selections to Start Outputs

Select Fill Value  
Auto  
60 Per Cent (nipples)  
25 Per Cent (sealoffs)

Minimum Raceway Size: 1/2  
Allowed Raceway area: 0.122  
Available Raceway area: 0.0023

Maximum number of same size wires at the Per Cent Fill: 40 %  
JAM RATIO (for 3 conductors only): 4.78  
JAM RATIO between 2.8 and 3.2

To View Table 348.22 for 3/8 inch Flexible Metal and Liquidtight Flexible Metal Conduit  
Open Table 348.22 Close Table 348.22

Last updated: 10/6/105 at 20:8:35 GMT - 0800

**electrician.com Racewayfill Calculator**  
by electrician.com

This program calculates the number of same size conductors using the 3/8 roundoff method. In the Auto Mode this program limits the fill to 40 per cent for over 2 conductors, 31 per cent for only two conductors, and 53 percent for one conductor. Note: THWN, THHN, and THHW-2 have the same areas. RHH, RHW, and RHW-2 without covering have the same areas. THW-2, THW, and THHW have the same areas. RHL, RHL, RHW, and RHW-2 with covering have the same areas. (This program does not calculate for 3/8 inch FMC and LTFMC - Open Table 348.22 below)  
Enter conductor information starting at the top of the form.  
ALL AREAS ARE IN SQUARE INCHES.

Select Insulation	Select Size	Enter No. Conductors	Wire Area	Total Area
1) THHN	8 AWG	2	0.0366	0.0732
2) THHN	10 AWG	1	0.0211	0.0211
3) THHN	14 AWG	0	0	0
4) THHN	14 AWG	0	0	0
5) THHN	14 AWG	0	0	0

Total: 3 Grand Total Area: 0.0943

Select Raceway  
EMT

Enter Selections to Start Outputs

Select Fill Value  
Auto  
60 Per Cent (nipples)  
25 Per Cent (sealoffs)

Minimum Raceway Size: 1/2  
Allowed Raceway area: 0.122  
Available Raceway area: 0.0277

Maximum number of same size wires at the Per Cent Fill: 40 %  
JAM RATIO (for 3 conductors only): 4.78  
JAM RATIO between 2.8 and 3.2

To View Table 348.22 for 3/8 inch Flexible Metal and Liquidtight Flexible Metal Conduit  
Open Table 348.22 Close Table 348.22

Last updated: 10/6/105 at 20:8:35 GMT - 0800

**electrician.com Racewayfill Calculator**  
by electrician.com

This program calculates the number of same size conductors using the 3/8 roundoff method. In the Auto Mode this program limits the fill to 40 per cent for over 2 conductors, 31 per cent for only two conductors, and 53 percent for one conductor. Note: THWN, THHN, and THHW-2 have the same areas. RHH, RHW, and RHW-2 without covering have the same areas. THW-2, THW, and THHW have the same areas. RHL, RHL, RHW, and RHW-2 with covering have the same areas. (This program does not calculate for 3/8 inch FMC and LTFMC - Open Table 348.22 below)  
Enter conductor information starting at the top of the form.  
ALL AREAS ARE IN SQUARE INCHES.

Select Insulation	Select Size	Enter No. Conductors	Wire Area	Total Area
1) THHN	12 AWG	3	1.0133	0.0399
2) THHN	14 AWG	0	0	0
3) THHN	14 AWG	0	0	0
4) THHN	14 AWG	0	0	0
5) THHN	14 AWG	0	0	0

Total: 3 Grand Total Area: 0.0399

Select Raceway  
EMT

Enter Selections to Start Outputs

Select Fill Value  
Auto  
60 Per Cent (nipples)  
25 Per Cent (sealoffs)

Minimum Raceway Size: 1/2  
Allowed Raceway area: 0.122  
Available Raceway area: 0.0821

Maximum number of same size wires at the Per Cent Fill: 40 %  
JAM RATIO (for 3 conductors only): 4.78  
JAM RATIO between 2.8 and 3.2

To View Table 348.22 for 3/8 inch Flexible Metal and Liquidtight Flexible Metal Conduit  
Open Table 348.22 Close Table 348.22

Last updated: 10/6/105 at 20:8:35 GMT - 0800

CONTRACTOR:

**DBKO**  
DESIGN-BUILD

8839 NORTH CEDAR #374  
FRESNO, CA 93720  
(559) 930-DBKO

**WHSE**  
[PARTNERS]

BY BN

REVISION

DATE 9/08/2021

SEAL

ANY INFORMATION OR DATA ON THIS DRAWING IS NOT INTENDED TO BE SUITABLE FOR REUSE BY ANY PERSON, IN ANY PROJECT, WITHOUT THE WRITTEN VERIFICATION AND ADAPTATION BY THE ENGINEER OR THE SPECIFIC PURPOSE INTENDED WILL BE AT THE USER'S SOLE RISK AND WITHOUT LIABILITY OR LEGAL EXPOSURE TO THE ENGINEER.

**1 OF 4**

**SYLVANIA Luminares**  
ValueLED™ Non-Cutoff Wall Pack

Application  
The SYLVANIA ValueLED Wall Pack luminaires are environmentally preferable LED alternatives to traditional HID luminaires, offering up to 77% in energy savings. Ideal in place of traditional luminaires, or as new installations, the Wall Pack series is offered in several wattages/lumen packages for illuminating building exteriors, outdoor corridors, walkways, and stairwells.

Benefits and Features  
- DLC listing maximizes rebate opportunities  
- Traditional appearance allows for lowered installation costs  
- Wide operating temperature (-40°F to +40°F) enables this product to be used in a variety of outdoor environments  
- Up to 145 LPW  
- 4000K and 5000K color temperature  
- CRI >80  
- Offered in 80, 60, and 120 watts  
- Energy savings up to 77%

Electrical  
- 120-277 Vac  
- Power Factor >90%  
- THD <20%  
- 0-10V dimmable (80, 60, and 120W versions only)

Rated Life  
- 50,000 hours (L70)

Warranty  
- 5-year

Ambient Operating Range  
- -40°F to 104°F (-40°C to 40°C)

Certifications and Listings  
- cULus  
- RoHS  
- FCC  
- DLC

Wattage Comparison

Traditional Wattage	LED System Wattage	Energy Savings
100W HPS	30	67%
150W HPS	30	75%
100W MH	30	75%
150W MH	30	75%

Installation  
- Luminaire mounts to exterior wall

**SYLVANIA**

**2 OF 4**

**Wall Pack Sylvania**

Luminaire Watts 123 W  
Ballast/Driver Factor 1.00  
Light Loss Factor 1.00  
Total Proration Factor 1.00  
Luminaire Lumens 14880 lms

175 x 110 ft

22 ft

Min: 0.50 fc X  
Max/Avg: 3.5

Avg: 1.1 fc  
Avg/Min: 2.1

Max: 3.7 fc +  
Max/Min: 7.4

**3 OF 3**

**Physical Information**

Luminaire Description	CU Depth (in)	CU Height (in)
WALPAXA 30W	5.4 (137)	5.4 (137)
WALPAXA 60W	7.4 (188)	5.4 (137)
WALPAXA 120W	5.4 (137)	5.4 (137)

WALPAXA 30W

WALPAXA 60W

WALPAXA 120W

LEDWANCE LLC  
200 Ballardvale Street  
Wilmington, MA 01887 USA  
Phone: 1-800-LIGHTS-USA (1-800-544-4828)  
www.sylvania.com

SYLVANIA

**2 OF 2**

**Ordering Guide**

Product Name	Wattage	Color Temp	Beam Angle	Mounting	Ordering Code
WALPAXA - Non-Cutoff Wall Pack	80-120W	4000K	40°	90°	WALPAXA-80-120W-4000K-90°

**Ordering Information**



**Photometric Data**

WALPAXA 30W

WALPAXA 60W

WALPAXA 120W

**LIGHT-C**

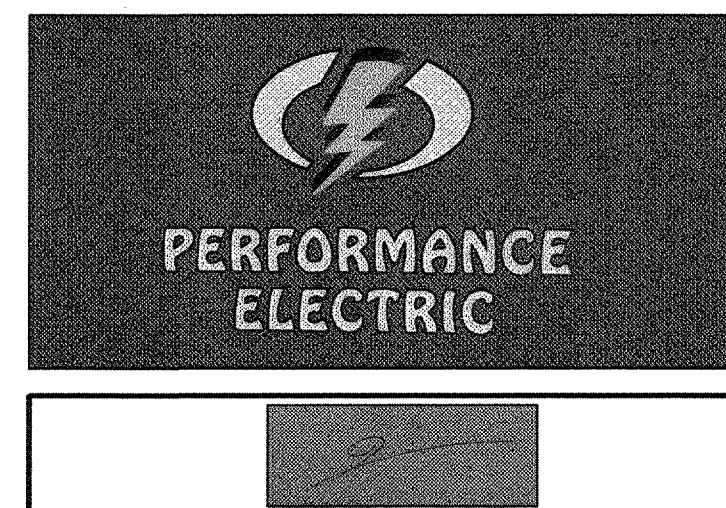

2019CBC  
City of Madera  
Building Department  
The approval of these plans does not constitute the City of Madera from assuming the responsibility of errors or omissions in the plans, specifications, contract documents, or any other documents. The City of Madera and its representatives shall not be liable for any damages or losses resulting from the use of these plans. The City of Madera and its representatives shall not be liable for any damages or losses resulting from the use of these plans.

APPROVED

By: [Signature]  
MAR 03 2022

JOB NUMBER

DESIGNED BY TD

DRAWN BY BN

DATE 9/08/2021

SHEET NUMBER E3







STATE OF CALIFORNIA

**Indoor Lighting**

NRCC-LTH-4

CALIFORNIA ENERGY COMMISSION

CERTIFICATE OF COMPLIANCE

Project Name: Modera Industrial Works

Report Page: NRCC-LTH-4 (Page 6 of 7)

Project Address: S. Schinner Avenue

Date Prepared: 9/17/2021

**I. LIGHTING POWER ALLOWANCE: COMPLETE BUILDING OR AREA CATEGORY METHODS**

Each area complying using the Complete Building or Area Category Methods per §180.6(b) are included in this table. Column 06 indicates if additional lighting power allowances per §180.6(c) or adjustments per §180.6(a) are being used.

Unconditioned Spaces		02	03	04	05	06	
Area Description	Complete Building or Area Category Primary Function Area	Allowed Density (W/ft²)	Area (ft²)	Allowed Wattage (Watts)	Additional Allowance / Adjustment	Area Category	PMF
Whole Building	Assembly Building	0.7	136,100.8	95,270.6	No	No	No
<b>TOTALS:</b>				136,100.8	95,270.6	See Tables J, or P for detail	

**J. ADDITIONAL ALLOWANCE: AREA CATEGORY METHOD QUALIFYING LIGHTING SYSTEM**

This section does not apply to this project.

**K. TAILORED METHOD GENERAL LIGHTING POWER ALLOWANCE**

This section does not apply to this project.

**L. ADDITIONAL LIGHTING ALLOWANCE: TAILORED WALL DISPLAY**

This section does not apply to this project.

**M. ADDITIONAL LIGHTING ALLOWANCE: TAILORED FLOOR AND TASK LIGHTING**

This section does not apply to this project.

**N. ADDITIONAL LIGHTING ALLOWANCE: TAILORED ORNAMENTAL/SPECIAL EFFECTS**

This section does not apply to this project.

**O. ADDITIONAL LIGHTING ALLOWANCE: TAILORED VERY VALUABLE MERCHANDISE**

This section does not apply to this project.

**P. POWER ADJUSTMENT: LIGHTING CONTROL CREDIT (POWER ADJUSTMENT FACTOR [PAF])**

This section does not apply to this project.

Registration Number:

Registration Date/Time:

Registration Provider: Energysoft

CA Building Energy Efficiency Standards - 2019 Nonresidential Compliance

Report Version: 2019.1.003

Schema Version: rev 20200601

Report Generated: 2021-09-17 16:08:46

STATE OF CALIFORNIA <b>Indoor Lighting</b> NRC-LE-1E		CALIFORNIA ENERGY COMMISSION NRC-LE-1E					
CERTIFICATE OF COMPLIANCE		NRC-LE-1E					
Project Name: Malera Industrial WHS		(Page 5 of 7)					
Project Address: S. Schmeier Avenue		Date Prepared: 9/17/2021					
<b>Q. RATED POWER REDUCTION COMPLIANCE FOR ALTERATIONS</b>							
This section does not apply to this project.							
<b>R. 80% LIGHTING POWER FOR ALL ALTERATIONS - CONTROLS EXCEPTIONS</b>							
This section does not apply to this project.							
<b>S. DAYLIGHT DESIGN POWER ADJUSTMENT FACTOR (PAF)</b>							
This section does not apply to this project.							
<b>T. DECLARATION OF REQUIRED CERTIFICATES OF INSTALLATION</b>							
Selectors have been made based on information provided in this document. If any selector has been changed by permit applicant, an explanation should be included in Table E.							
Additional Remarks: These documents must be provided to the building inspector during construction and can be found online at <a href="https://www.energy.ca.gov/title24/2019standards/2019_compliance_documents/Nonresidential_Documents/NRC/">https://www.energy.ca.gov/title24/2019standards/2019_compliance_documents/Nonresidential_Documents/NRC/</a>							
Yes	No	Form/Title	Field Inspector				
			<table border="1" style="width: 100%; border-collapse: collapse;"> <tr> <th style="width: 50%;">Page</th> <th style="width: 50%;">Sig</th> </tr> <tr> <td><input type="checkbox"/></td> <td><input type="checkbox"/></td> </tr> </table>	Page	Sig	<input type="checkbox"/>	<input type="checkbox"/>
Page	Sig						
<input type="checkbox"/>	<input type="checkbox"/>						
●	⊙	NRC-LE-01-E - Must be submitted for all buildings	<table border="1" style="width: 100%; border-collapse: collapse;"> <tr> <td><input type="checkbox"/></td> <td><input type="checkbox"/></td> </tr> </table>	<input type="checkbox"/>	<input type="checkbox"/>		
<input type="checkbox"/>	<input type="checkbox"/>						
●	⊙	NRC-LE-02-E - Must be submitted for a lighting control system, or for an Energy Management Control System (EMCS), to be recognized for compliance.	<table border="1" style="width: 100%; border-collapse: collapse;"> <tr> <td><input type="checkbox"/></td> <td><input type="checkbox"/></td> </tr> </table>	<input type="checkbox"/>	<input type="checkbox"/>		
<input type="checkbox"/>	<input type="checkbox"/>						
⊙	●	NRC-LE-04-E - Must be submitted for two interlocked systems serving an auditorium, a convention center, a conference room, a multipurpose room or a theater to be recognized for compliance.	<table border="1" style="width: 100%; border-collapse: collapse;"> <tr> <td><input type="checkbox"/></td> <td><input type="checkbox"/></td> </tr> </table>	<input type="checkbox"/>	<input type="checkbox"/>		
<input type="checkbox"/>	<input type="checkbox"/>						
⊙	●	NRC-LE-05-E - Must be submitted for a Power Adjustment Factor (PAF) to be recognized for compliance.	<table border="1" style="width: 100%; border-collapse: collapse;"> <tr> <td><input type="checkbox"/></td> <td><input type="checkbox"/></td> </tr> </table>	<input type="checkbox"/>	<input type="checkbox"/>		
<input type="checkbox"/>	<input type="checkbox"/>						
⊙	●	NRC-LE-06-E - Must be submitted for additional wattage installed in a video conferencing studio to be recognized for compliance.	<table border="1" style="width: 100%; border-collapse: collapse;"> <tr> <td><input type="checkbox"/></td> <td><input type="checkbox"/></td> </tr> </table>	<input type="checkbox"/>	<input type="checkbox"/>		
<input type="checkbox"/>	<input type="checkbox"/>						

Registration Number: CA Building Energy Efficiency Standards - 2019 Nonresidential Compliance

Registration Date/Time: Schema Version: 2019.1.003  
 Schema Version: rev 20200601

Registration Provider: Energysoft  
 Report Generated: 2021-09-17 16:08:46

STATE OF CALIFORNIA <b>Indoor Lighting</b> WEC-016		CALIFORNIA ENERGY COMMISSION	
<b>CERTIFICATE OF COMPLIANCE</b>		<b>NRCC-LTH-E</b>	
Project Name: Madera Industrial WHS		Report Page: (Page 6 of 7)	
Project Address: S. Schinner Avenue		Date Prepared: 9/17/2021	

**II. DECLARATION OF REQUIRED CERTIFICATES OF ACCEPTANCE**

Selections have been made based on information provided in this document. If any selection have been changed by the permit applicant, an explanation should be included in Table E. Additional Remarks. These documents must be provided to the building inspector during construction and any with "A" in the form name must be completed through an Acceptance Test Technician Certification Provider (ATTCP). For more information visit: <http://www.energy.ca.gov/title24/atttcp/providers.html>

Yes	No	Form/Title	Field Inspector	
			Page	Sign
●	⊙	NRCA-LTI-02-A - Must be submitted for occupancy sensors and automatic time switch controls.	<input type="checkbox"/>	<input type="checkbox"/>
⊙	●	NRCA-LTI-03-A - Must be submitted for automatic daylight controls.	<input type="checkbox"/>	<input type="checkbox"/>
●	⊙	NRCA-LTI-04-A - Must be submitted for demand responsive lighting controls.	<input type="checkbox"/>	<input type="checkbox"/>
⊙	●	NRCC-LTI-05-A - Must be submitted for institutional tuning power adjustment factor (PAF)	<input type="checkbox"/>	<input type="checkbox"/>

STATE OF CALIFORNIA <b>ENERGY EFFICIENCY</b> Indoor Lighting WAC-016		CALIFORNIA ENERGY COMMISSION NCC-016	
Project Name: Madera Industrial Warehouse		Report Page: (Page 7 of 7)	
Project Address: 5. Schinner Avenue		Date Prepared: 9/17/2021	
<b>DOCUMENTATION AUTHOR'S DECLARATION STATEMENT</b> I certify that this Certificate of Compliance documentation is accurate and complete.			
Documentation Author Name: Daniel Field		Documentation Author Signature: 	
Company: GMA Consulting Engineers & Architects, Inc.		Signature Date: 9/17/21	
Address: 7327 N. First St. Suite #110		CEAH/HERS Certification Identification (if applicable):	
City/State/Zip: Fresno California 93720		Phone: (559) 435-1411	
<b>RESPONSIBLE PERSON'S DECLARATION STATEMENT</b> I verify the following under penalty of perjury under the laws of the State of California:			
1. The information provided on this Certificate of Compliance is true and correct.			
2. I am eligible under Division 5 of the Business and Professions Code to accept responsibility for the building design or system design identified on this Certificate of Compliance (designer)			
3. The energy features and performance specifications, materials, components, and manufactured devices for the building design or system design identified on the Certificate of Compliance conform to the requirements of Title 24, Part 1 and Part 6 of the California Code of Regulations.			
4. The building design features or system design features identified on this Certificate of Compliance are consistent with the information provided on other applicable compliance documents, worksheets, calculations, plans and specifications submitted to the enforcement agency for approval with this building permit application.			
5. I will ensure that a completed signed copy of this Certificate of Compliance shall be made available with the building permit(s) issued for the building, and made available to the enforcement agency for all applicable inspections. I understand that a completed signed copy of this Certificate of Compliance is required to be included with the documentation the builder provides to the building owner at occupancy.			
Responsible Designer Name: Tom Dalgas		Responsible Designer Signature: 	
Company: Performance Electric		Date Signed: 2021-09-17	
Address: City/State/Zip:		Phone: (559) 631-1000	

Registration Number:
 Registration Date/Time:
 Registration Provider: Energyproof

CA Building Energy Efficiency Standards - 2019 Nonresidential Compliance
 Report Version: 2019-1.003
 Schema Version: rev 20200601
 Report Generated: 2021-09-17 16:08:46

<b>TYPICAL MECHANICAL FLOOR PLAN</b>	
<b>LEASE FLEX. / WAREHOUSE BUILDINGS</b>	
FOR <b>MADERA INDUSTRIAL WHSE, LLC</b> S. SCHNOOR AVENUE, MADERA, CA	
JOB NUMBER	21107
DESIGNED BY	
DRAWN BY	
DATE	9/09/2021
SHEET NUMBER <b>E5</b>	



STATE OF CALIFORNIA

Outdoor Lighting

CALIFORNIA ENERGY COMMISSION

NRCC-LTO-4

CERTIFICATE OF COMPLIANCE

Project Name: Madera Industrial WHSE | Report Page: (Page 1 of 7)

Project Address: S. Schnoor Avenue | Date Prepared: 9/17/2021

A. GENERAL INFORMATION

01 Project Location (city)

Madera

04 Total Illuminated Hardscape Area (ft²)

8000

02 Climate Zone

13

05 Outdoor Lighting Zone per Title 24 Part 1 §10.11.4 or as designated by Authority Having Jurisdiction (AHJ):

☐ L2-0: Very Low - Undeveloped Parkland

☐ L2-2: Moderate - Rural Areas

☐ L2-4: High - Must be reviewed by CA Energy Commission for Approval

☐ L2-1: Low - Developed Parkland

☒ L2-3: Moderately High - Urban Areas

B. PROJECT SCOPE

This table includes outdoor lighting systems that are within the scope of the permit application and are demonstrating compliance using the prescriptive path outlined in §140.7 or §141.0(b)(2), for alterations.

My Project Consists of:

01

☒ New Lighting System

Must Comply with Allowances from §140.7

☐ Altered Lighting System

Is your alteration increasing the connected lighting load (Watts)?

☒ Yes

☐ No

% of Existing Luminaires Being Altered¹

Sum Total of Luminaires Being Added or Altered

Calculation Method

Please proceed to Table F, Outdoor Lighting Fixture Schedule to define the project's luminaires.

¹ FOOTNOTES: % of Existing Luminaires Being Altered = (Sum Total of Luminaires Being Added or Altered / Existing Luminaires within the Scope of the Permit Application) x 100.

Registration Number:

Registration Date/Time:

Registration Provider: Energysoft

CA Building Energy Efficiency Standards - 2019 Nonresidential Compliance

Report Version: 2019.1.003

Report Generated: 2021-09-17 16:08:46

Schema Version: rev 20200601

STATE OF CALIFORNIA

Outdoor Lighting

CALIFORNIA ENERGY COMMISSION

NRCC-LTO-4

CERTIFICATE OF COMPLIANCE

Project Name: Madera Industrial WHSE | Report Page: (Page 2 of 7)

Project Address: S. Schnoor Avenue | Date Prepared: 9/17/2021

C. COMPLIANCE RESULTS

Results in this table are automatically calculated from data input and calculations in Tables F through I. Note: If any cell on this table says "COMPLIES with Exceptional Conditions" refer to Table G, Exceptional Conditions for guidance or see applicable Table referenced below.

Calculations of Total Allowed Lighting Power (Watts) §140.7 or §141.0(b)(2)

01	02	03	04	05	06	07	08	09					
General Hardscape Allowance §140.7(d)(1) (See Table I)	+	Per Application §140.7(d)(2) (See Table J)	+	Sales Frontage §140.7(d)(3) (See Table K)	+	Ornamental §140.7(d)(2) (See Table L)	+	Per Specific Area §140.7(d)(2) (See Table M) OR Existing Power Allowance §141.0(b)(2) (See Table N)	=	Total Allowed (Watts)	≥	Total Actual (Watts)	07 must be >= 08
4,245	+		+		+		+	OR		4,245	≥	3,256	COMPLIES

Cutoff Compliance (See Table G for Details)

Controls Compliance (See Table H for Details)

N/A

COMPLIES

D. EXCEPTIONAL CONDITIONS

This table is auto-filled with uneuitable comments because of selections made or data entered in tables throughout the form.

E. ADDITIONAL REMARKS

This table includes remarks made by the permit applicant to the Authority Having Jurisdiction.

Registration Number:

Registration Date/Time:

Registration Provider: Energysoft

CA Building Energy Efficiency Standards - 2019 Nonresidential Compliance

Report Version: 2019.1.003

Report Generated: 2021-09-17 16:08:46

Schema Version: rev 20200601

STATE OF CALIFORNIA

Outdoor Lighting

CALIFORNIA ENERGY COMMISSION

NRCC-LTO-4

CERTIFICATE OF COMPLIANCE

Project Name: Madera Industrial WHSE | Report Page: (Page 3 of 7)

Project Address: S. Schnoor Avenue | Date Prepared: 9/17/2021

F. OUTDOOR LIGHTING FIXTURE SCHEDULE

For new or altered lighting systems demonstrating compliance with §140.7, all new luminaires being installed and any existing luminaires remaining or being moved within the spaces covered by the permit application are included in the Table below. For altered lighting systems using the Existing Power method per §141.0(b)(2), only new luminaires being installed and replacement luminaires being installed as part of the project scope are included (i.e. existing luminaires remaining or existing luminaires being moved are not included).

Designed Wattage:

01	02	03	04	05	06	07	08	09	10
Name or Item Tag	Complete Luminaire Description	Watts per luminaire¹ ²	How is Wattage determined	Total number luminaires ²	Luminaire Status³	Excluded per §140.7(a)	Design Watts	Cutoff Area > 6,200 Initial lumen output §130.2(b) ⁴	Field Inspector
C	Sylvania Non Cutoff Wall Pack	30	CEC Default	104	New	<input type="checkbox"/>	3,120	NA < 6200 lumens	<input type="checkbox"/>
	Architectural Square Cylinder up & Downlight	17	CEC Default	8	New	<input type="checkbox"/>	136	NA < 6200 lumens	<input type="checkbox"/>
Total Design Watts:							3356		

¹ NOTES: Selections with "N" require a note in the space below explaining how compliance is achieved.

² For linear lighting, wattage shall be determined per §130.2(b)(2).

³ FOOTNOTES: Authority Having Jurisdiction may ask for luminaire cut sheets to confirm wattage used for compliance per §130.0(c).

⁴ For linear luminaires, wattage should be indicated as W/ft instead of Watts/luminaire. Total linear feet should be indicated in column 05 instead of number of luminaires.

⁵ Select "New" for new luminaires in a new outdoor lighting project or for added luminaires in an alteration. Select "Altered" for replacement luminaires in an alteration. Select "Existing to Remain" for existing luminaires within the project scope that are not being altered and are remaining. Select "Existing to Be Removed" for existing luminaires which are being removed and replaced as part of the project scope.

⁶ Compliance with mandatory cutoff requirements is required for luminaires with initial lumen output >= 6,200 unless exempted by §130.2(c).

G. CUTOFF REQUIREMENTS (BUG)

This section does not apply to this project.

Registration Number:

Registration Date/Time:

Registration Provider: Energysoft

CA Building Energy Efficiency Standards - 2019 Nonresidential Compliance

Report Version: 2019.1.003

Report Generated: 2021-09-17 16:08:46

Schema Version: rev 20200601

STATE OF CALIFORNIA

Outdoor Lighting

CALIFORNIA ENERGY COMMISSION

NRCC-LTO-4

CERTIFICATE OF COMPLIANCE

Project Name: Madera Industrial WHSE | Report Page: (Page 4 of 7)

Project Address: S. Schnoor Avenue | Date Prepared: 9/17/2021

H. OUTDOOR LIGHTING CONTROLS

This table demonstrates compliance with controls requirements for all new or altered luminaires installed as part of the permit application. For alteration projects, luminaires which are existing to remain (ie untouched) and luminaires which are removed and reinstalled (wiring only) do not need to be included in this table even if they are within the spaces covered by the permit application.

When an option having a "P" is selected, the notes section of this table must be completed. The lighting controls section of the Compliance Summary Table on the first page will show "DOES NOT COMPLY" if the notes are left blank.

Mandatory Controls

01	02	03	04	05
Area Description	Shut-Off §130.2(c)(1)	Auto-Schedule §130.2(c)(2)	Motion Sensor §130.2(c)(3)	Field Inspector
				Pass Fail

Field Inspector

Pass Fail

¹ NOTES: Controls with a "P" require a note in the space below explaining how compliance is achieved.

² Not permitted by §130.2 & cannot be turned off; ENEC §130.2.3 to §130.2.4.

Registration Number:

Registration Date/Time:

Registration Provider: Energysoft

CA Building Energy Efficiency Standards - 2019 Nonresidential Compliance

Report Version: 2019.1.003

Report Generated: 2021-09-17 16:08:46

Schema Version: rev 20200601

STATE OF CALIFORNIA

Outdoor Lighting

CALIFORNIA ENERGY COMMISSION

NRCC-LTO-4

CERTIFICATE OF COMPLIANCE

Project Name: Madera Industrial WHSE | Report Page: (Page 5 of 7)

Project Address: S. Schnoor Avenue | Date Prepared: 9/17/2021

I. LIGHTING POWER ALLOWANCE (per §140.7)

This table includes areas using allowance calculations per §140.7, General Hardscape Allowance & per Table 140.7-A while "Use it or lose it" Allowances are per Table 140.7-B. Indicate which allowances are being used to expand sections for user input. Luminaires that qualify for one of the "Use it or lose it" allowances shall not qualify for another "Use it or lose it" allowance.

Calculated General Hardscape Lighting Power Allowance per Table 140.7-A (L2 0, 1 & 4)

This section does not apply to this project.

Calculated General Hardscape Lighting Power Allowance per Table 140.7-A (L2 2 & 3)

01	02	03	04	05	06	07	08	09	10
Area Description	Surface Type	Illuminated Area (ft²)	Allowed Density (W/ft²)	Area Allowance (Watts)	Perimeter Length (ft)	Allowed Density (W/ft)	Linear Allowance (Watts)	Total General Hardscape Allowance (Watts)	
Exterior Lighting	Asphalt	60000	0.03	1500	5080	0.4	1270	2770	
Exterior Light	Asphalt	20000	0.03	500	2500	0.4	625	1125	
Initial Wattage Allowance for Entire Site (Watts):								350	
Total General Hardscape Allowance (Watts):								4245	

J. LIGHTING ALLOWANCE: PER APPLICATION

This section does not apply to this project.

K. LIGHTING ALLOWANCE: SALES FRONTAGE

This section does not apply to this project.

L. LIGHTING ALLOWANCE: ORNAMENTAL

This section does not apply to this project.

M. LIGHTING ALLOWANCE: PER SPECIFIC AREA

This section does not apply to this project.

Registration Number:

Registration Date/Time:

Registration Provider: Energysoft

CA Building Energy Efficiency Standards - 2019 Nonresidential Compliance

Report Version: 2019.1.003

Report Generated: 2021-09-17 16:08:46

Schema Version: rev 20200601

STATE OF CALIFORNIA

Outdoor Lighting

CALIFORNIA ENERGY COMMISSION

NRCC-LTO-4

CERTIFICATE OF COMPLIANCE

Project Name: Madera Industrial WHSE | Report Page: (Page 6 of 7)

Project Address: S. Schnoor Avenue | Date Prepared: 9/17/2021

N. EXISTING CONDITIONS POWER ALLOWANCE (alterations only)

This section does not apply to this project.

O. DECLARATION OF REQUIRED CERTIFICATES OF INSTALLATION

Selections have been made based on information provided in this document. If any selection have been changed by permit applicant, an explanation should be included in Table E, Additional Remarks. These documents must be provided to the building inspector during construction and can be found online at: [https://www.energy.ca.gov/title24/2019standards/2019\\_compliance\\_documents/Nonresidential\\_Documents/NRCC/](https://www.energy.ca.gov/title24/2019standards/2019_compliance_documents/Nonresidential_Documents/NRCC/)

Yes	No	Form/Title	Field Inspector
<input checked="" type="radio"/>	<input type="radio"/>	NRCC-LTO-01-E - Must be submitted for all buildings	<input type="checkbox"/>
<input checked="" type="radio"/>	<input type="radio"/>	NRCC-LTO-02-E - Must be submitted for a lighting control system, or for an Energy Management Control System (EMCS), to be recognized for compliance.	<input type="checkbox"/>

P. DECLARATION OF REQUIRED CERTIFICATES OF ACCEPTANCE

Selections have been made based on information provided in this document. If any selection have been changed by permit applicant, an explanation should be included in Table E, Additional Remarks. These documents must be provided to the building inspector during construction and must be completed through an Acceptance Test Technician Certification Provider (ATTCP). For more information visit: <http://www.energy.ca.gov/title24/2019standards/providers.html>

Yes	No	Form/Title	Field Inspector
<input checked="" type="radio"/>	<input type="radio"/>	NRCC-LTO-02-A - Must be submitted for all outdoor lighting controls except for alterations where controls are added to <= 20 luminaires.	<input type="checkbox"/>

Registration Number:

Registration Date/Time:

Registration Provider: Energysoft

CA Building Energy Efficiency Standards - 2019 Nonresidential Compliance

Report Version: 2019.1.003

Report Generated: 2021-09-17 16:08:46

Schema Version: rev 20200601

STATE OF CALIFORNIA

Outdoor Lighting

CALIFORNIA ENERGY COMMISSION

NRCC-LTO-4

CERTIFICATE OF COMPLIANCE

Project Name: Madera Industrial WHSE | Report Page: (Page 7 of 7)

Project Address: S. Schnoor Avenue | Date Prepared: 9/17/2021

DOCUMENTATION AUTHOR'S DECLARATION STATEMENT

I certify that this Certificate of Compliance documentation is accurate and complete.

Documentation Author Name:

Daniel Field

Signature Date:

9/17/21

Company:

GDMA Consulting Engineers & Architects, Inc.

Address:

1757 N. First St, Suite #110

City/State/Zip:


Phone:

(559) 435-1411

RESPONSIBLE PERSON'S DECLARATION STATEMENT

I certify the following under penalty of perjury under the laws of the State of California:

- The information provided on this Certificate of Compliance is true and correct.
- I am eligible under Division 9 of the Business and Professions Code to accept responsibility for the building design or system design identified on this Certificate of Compliance (responsible designer).
- The energy features and performance specifications, materials, components, and manufactured devices for the building design or system design identified on this Certificate of Compliance conform to the requirements of Title 24, Part 1 and Part 6 of the California Code of Regulations.
- The building design features or system design features identified on this Certificate of Compliance are consistent with the information provided on other applicable compliance documents, worksheets, calculations, plans and specifications submitted to the enforcement agency for approval with this building permit application.
- I will ensure that a completed signed copy of this Certificate of Compliance shall be made available with the building permit(s) issued for the building, and made available to the enforcement agency for all applicable inspections. I understand that a completed signed copy of this Certificate of Compliance is required to be included with the documentation the holder provides to the building owner at occupancy.

Responsible Designer Name:

Tom Dukes

Signature:

Date Signed:

2021-09-17

Company:

Performance Electric

Address:

Phone:

(559) 631-1000

City/State/Zip:

Registration Number:

Registration Date/Time:

Registration Provider: Energysoft

CA Building Energy Efficiency Standards - 2019 Nonresidential Compliance

Report Version: 2019.1.003

Report Generated: 2021-09-17 16:08:46

Schema Version: rev 20200601

2019090  
City of Madera  
Building Department  
The above information was not  
not provided by City of Madera  
from requiring verification of  
errors or omissions in the plans  
submitted for construction.  
Subject to the City's policies and  
approval of the plans.

APPROVED  
By:   
Date: MAR 03 2022

TYPICAL MECHANICAL FLOOR PLAN  
FOR  
LEASE FLEX. / WAREHOUSE BUILDINGS  
MADERA INDUSTRIAL WHSE, LLC  
S. SCHNOOR AVENUE, MADERA, CA

JOB NUMBER 21107  
DESIGNED BY  
DRAWN BY  
DATE 9/09/2021  
SHEET NUMBER E6



BY	BN
REVISION	
DATE	9/08/2021
SEAL	

ANY INFORMATION OR DATA ON THIS DRAWING IS NOT INTENDED TO BE SUITABLE FOR REUSE BY ANY PERSON, FIRM OR ORGANIZATION FOR ANY OTHER PROJECT OR PURPOSE. ANY REUSE WITHOUT WRITTEN VERIFICATION AND ADAPTATION BY THE ENGINEER FOR THE SPECIFIC PURPOSE INTENDED WILL BE AT THE USER'S SOLE RISK AND WITHOUT LIABILITY OR LEGAL EXPOSURE TO THE ENGINEER.

EGRESS PLAN

FOR

LEASE FLEX / WAREHOUSE BUILDINGS


MADERA INDUSTRIAL WHSE, LLC.

S. SCHNOOR AVENUE

MADERA, CA 93837

JOB NUMBER
DESIGNED BY TD
DRAWN BY BN
DATE 9/08/2021
SHEET NUMBER E7


BUILDING WALL PACKS ARE A MAXIMUM OF 30' APART

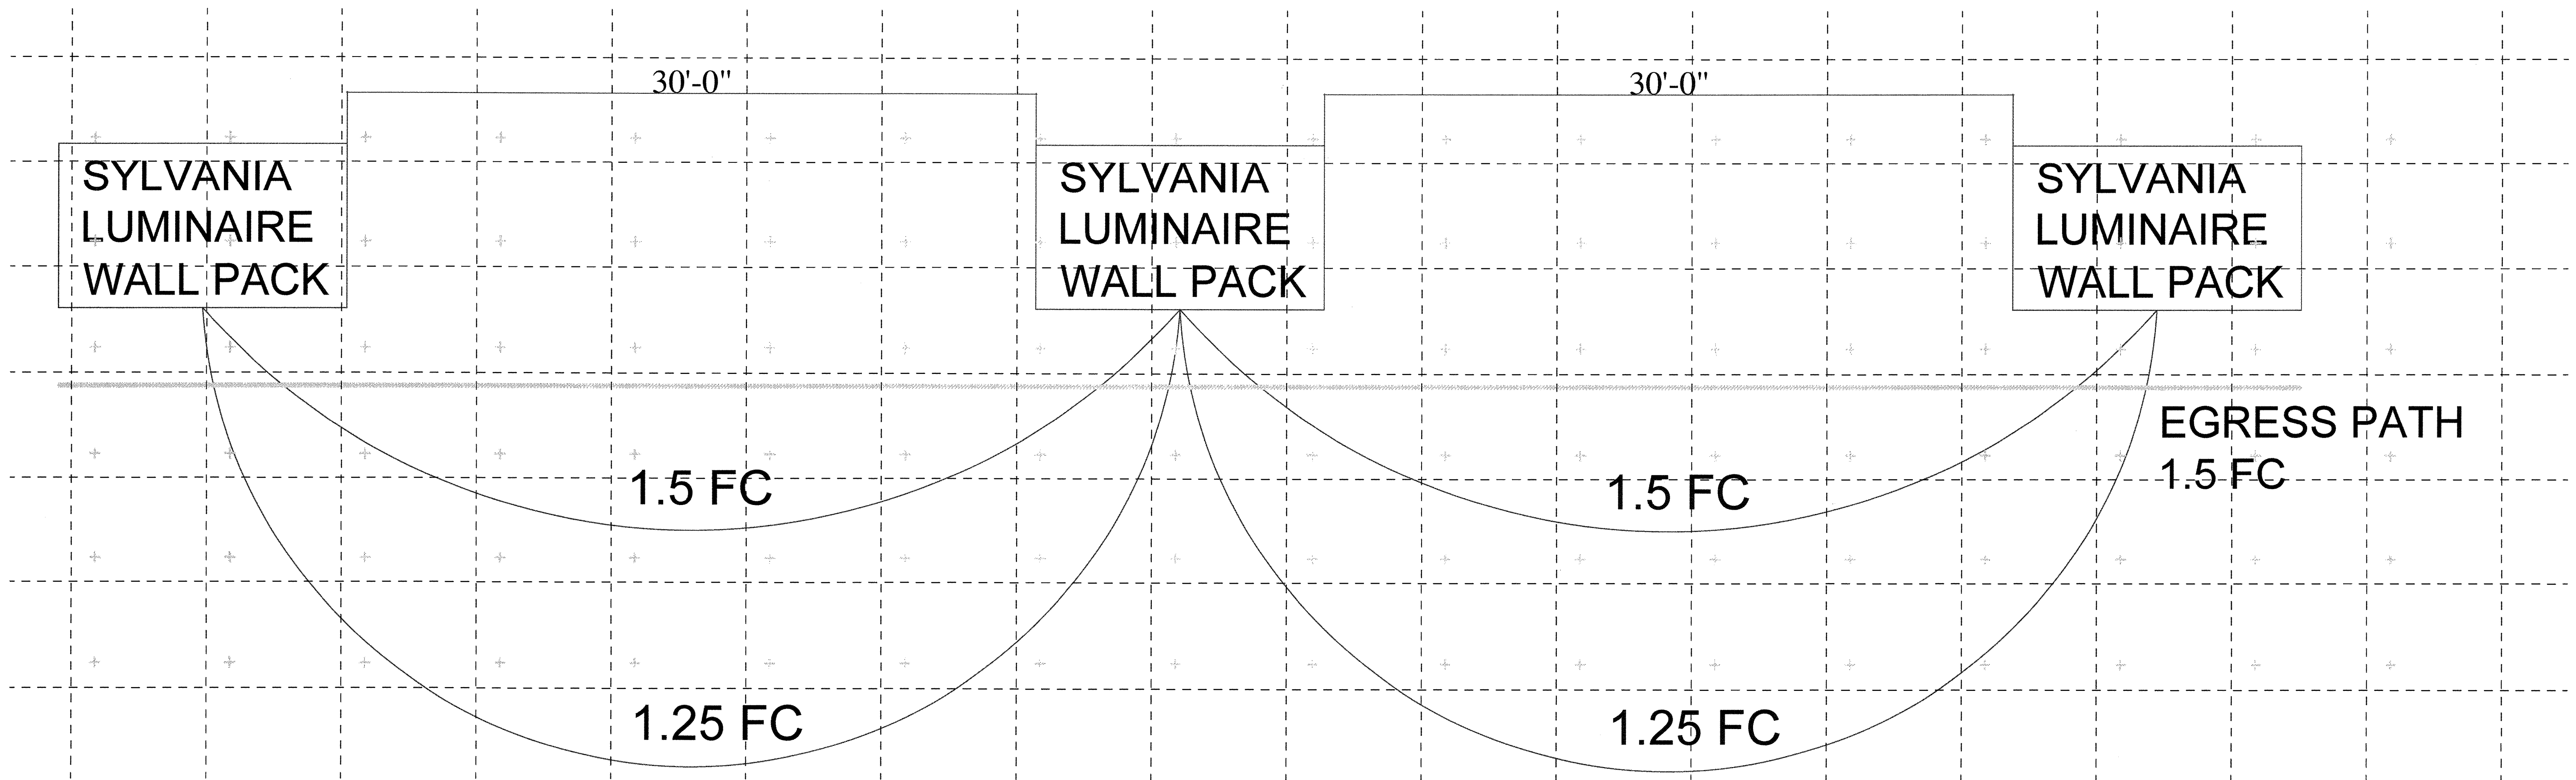

REFER TO SHEET  
E3 (1 OF 4, 3 OF 4,  
AND 2 OF 2) TO  
CONFIRM  
PHOTOMETRICS

PLEASE REFER TO  
SHEET A1-0 FOR  
EGRESS PATH AND  
E3 FOR LIGHTING  
SPECS  
NO LIGHTS ARE  
OVER 30' APART  
MEETS AND  
EXCEEDS CBC FOR  
EGRESS LIGHTING

20190808  
City of Madera  
Building Department  
The approval of these plans does  
not prevent the City of Madera  
from requiring correction of  
errors or omissions in the plans  
specifications or construction  
subject to field inspection and  
approval of the City.

APPROVED  
By:   
Date: MAR 03 2022



7/11/2021 11:49:10 AM  
C:\Shared drives\Company\PROJECTS\20106\_WHSE\Partners\Flexo, CA\Plans, Call & Speed\Arch-Sheet\DBKO\Drawings\Flexo Property - Madera\20106\_WHSE - Flexo Madera\_2021-07-05.rvt

TABLE 5.303.6  
STANDARDS FOR PLUMBING  
FIXTURES AND FIXTURE FITTINGS

REQUIRED STANDARDS	
WATER CLOSETS (TOILETS) – FLUSHOMETER VALVE TYPE SINGLE FLUSH MAXIMUM FLUSH VOLUME	ASME A 112.19.2/CSA B45.1 – 1.28 GAL (4.8L)
WATER CLOSETS (TOILETS) – FLUSHOMETER VALVE TYPE DUAL FLUSH MAXIMUM FLUSH VOLUME	ASME A 112.19.14 AND USEPA WATERSENSE TANK-TYPE HIGH EFFICIENCY TOILET SPECIFICATION – 1.28 GAL (4.8L)
WATER CLOSETS (TOILETS) – TANK TYPE	U.S. EPA WATERSENSE TANK-TYPE HIGH EFFICIENCY TOILET SPECIFICATION
URINALS, FLOOR-MOUNT URINALS, WALL-MOUNT MAXIMUM FLUSH VOLUME	ASME A 112.19.2/CSA B45.1 – 0.5 GAL (1.9L) ASME A 112.19.14/CSA B45.1 – 0.125GAL (.47L)
URINALS, NONWATER URINALS	ASME A 112.19.19 (VITREOUS CHINA) ANSI Z124.9-2004 OR IAPMO Z124.9 (PLASTIC)
PUBLIC LAVATORY FAUCETS: MAXIMUM FLOW RATE – 0.5 GPM(1.9/MIN.)	ASME A 112.18.1/CSA B125.1
PUBLIC METERING SELF-CLOSING FAUCETS: MAXIMUM WATER USE – 0.20 GAL (.75L) PER METERING CYCLE	ASME A 112.18.1/CSA B125.1
RESIDENTIAL BATHROOM LAVATORY SINK FAUCETS: MAXIMUM FLOW RATE – 1.5 GPM (5.7L/MIN.)	ASME A 112.18.1/CSA B125.1

TABLE 5.303.2.3.1 FIXTURE FLOW RATES PER CAL GREEN CODE

FIXTURE TYPE	FLOW RATE	MAXIMUM FLOW RATE AT 20 PERCENT REDUCTION
SHOWERHEADS	2.0 GPM @ 80 PSI	1.8 GPM @ 80 PSI
LAVATORY FAUCETS <sup>3</sup> NON RESIDENTIAL	0.5 GPM @ 60 PSI	0.35 GPM @ 60 PSI
KITCHEN FAUCETS <sup>3</sup>	1.8 GPM @ 60 PSI	1.6 GPM @ 60 PSI
WASH FOUNTAINS	1.8 GAL/CYCLE/20[RIM SPACE(in.) @ 60 PSI	1.6 GPM/20[RIM SPACE(in.) @ 60 PSI
METERING FAUCETS	0.20 GALLONS/CYCLE	0.18 GALLONS/CYCLE
METERING FAUCETS FOR WASH FOUNTAINS	0.20 GAL/CYCLE/20 [RIM SPACE(in.) @ 60 PSI	0.18 GAL/CYCLE 20 [RIM SPACE (in.) @ 60 PSI
GRAVITY TANK TYPE WATER CLOSETS	1.28 GALLONS / FLUSH	1.12 GALLONS / FLUSH <sup>1</sup>
FLUSHMETER TANK WATER CLOSETS	1.28 GALLONS / FLUSH	1.12 GALLONS / FLUSH <sup>1</sup>
FLUSHMETER VALVE WATER CLOSETS	1.28 GALLONS / FLUSH	1.12 GALLONS / FLUSH <sup>1</sup>
ELECTROMECHANICAL HYDRAULIC WATER CLOSETS	1.28 GALLONS / FLUSH	1.12 GALLONS / FLUSH <sup>1</sup>
URINALS	0.5 OR 0.125 GALLONS / FLUSH	0.44 OR 0.11 <sup>4</sup> GALLONS / FLUSH

ALL FIXTURES AND FITTINGS TO COMPLY WITH TABLE 5.303.2.3.1 AND TABLE 5.303.6.

- Includes water closets with an effective flush rate of 1.12 gallons or less when tested per ASME A 112.19.2 and ASME A 112.19.14.
- See Table A5.503.2.2 for additional notes and references.
- Where complying faucets are unavailable, aerators rated at .35 gpm or other means may be used to achieve reduction.
- Floor-mounted urinals @ 0.5 GPR or wall-mounted urinals @ 0.125 GPF.

GENERAL NOTES

- ALL WORK AND MATERIALS SHALL BE PERFORMED AND INSTALLED IN COMPLIANCE WITH THE FOLLOWING CODES AS ADOPTED BY THE INSPECTION AUTHORITY. NOTHING IN THESE PLANS IS TO BE CONSTRUCTED TO PERMIT WORK NOT CONFORMING TO THESE CODES OR OTHERS APPLICABLE TO THIS PROJECT.  
A) 2019 CALIFORNIA BUILDING CODE (CBC)  
B) 2019 CALIFORNIA PLUMBING CODE (CPC)  
C) 2019 CALIFORNIA MECHANICAL CODE (CMC)  
D) 2019 CALIFORNIA ELECTRICAL CODE (CEC)  
E) 2019 CALIFORNIA ENERGY CODE (effective date January 1, 2020)  
F) 2019 CALIFORNIA GREEN BUILDING STANDARDS CODE (Cal Green)
- ROUTE FULL SIZE DISCHARGE OF P & T RELIEF VALVES FROM WATER HEATER TO EXTERIOR OF BUILDING. DAYLIGHT @ (4'-) 6" ABOVE FINISHED GRADE AND ELBOW DOWN.
- STORAGE TYPE WATER HEATER SHALL BE FACTORY INSULATED TO SATISFY A COMBINED THERMAL RESISTANCE OF R-16 OR GREATER.
- PROVIDE FULL SIZE CONDENSATE DRAIN WITH DEEPWELL TRAP FOR ALL A/C UNITS. ROUTE CONDENSATE DRAIN TO NEAREST PLUMBING VENT AND TIE IN WITH APPROVED FITTINGS OR ROUTE TO PLANTER AREA.
- ALL HOT WATER PIPING SHALL BE INSULATED WITH 1" THICK INSULATION AND HAVE AN R RATING OF R-42 FOR PIPE SIZES 1" OR LESS. FOR HOT WATER PIPING LARGER THAN 1", 1½" THICK INSULATION IS REQUIRED AND SHALL HAVE AN R RATING OF R-6
- ALL WATER AND DRAIN PIPE UNDER ADA LAVATORIES AND ADA SINKS SHALL BE INSULATED AND PROTECTED AGAINST CONTACT AND THERE SHALL BE NO SHARP OR ABRASIVE SURFACES.
- ALL PLUMBING VENTS SHALL TERMINATE 10' AWAY FROM ANY OUTSIDE AIR INTAKE.
- DRAIN WASTE AND VENT PIPE SHALL BE ABS, PVC-DIUV, OR CAST IRON. VENT PIPE ABOVE GRADE MAY BE GALVANIZED IRON.
- WATER PIPE SHALL BE TYPE M COPPER ASTM B88, FLEX TUBING ASTM F801. COPPER PIPE TYPE L BELOW GRADE SHALL BE BRAZED AND UNRAFFED WITH 40 MIL TAPE OR APPROVED PVC. GALVANIZED STEEL WATER PIPE IS PROHIBITED IN THE CITY OF FRESNO.
- GAS PIPE SHALL BE SCHEDULE 40 BLACK STEEL, ASTM A-53, C88 PIPE CSA LC-1 (NFP445.5.6.3.4). BELOW GRADE PIPE POLYETHYLENE, ASTM D 2513, SCHEDULE 40 GALV. STEEL SHALL HAVE A PROTECTIVE COATING OF POLYETHYLENE OR BE OF APPROVED PVC.
- CHECK W/ THE WATER DEPARTMENT FOR R.P. (BACKFLOW PREVENTION) DEVICE REQUIREMENTS AND LOCATIONS.
- ALL MATERIALS AND EQUIPMENT INSTALLED UNDER THIS CONTRACT SHALL BE GUARANTEED FREE FROM ALL MECHANICAL, ELECTRICAL, AND WORKMANSHIP DEFECTS FOR A PRIOR OF ONE YEAR FROM DATE OF FINAL ACCEPTANCE.
- WORKMANSHIP:  
ALL WORK SHALL BE DONE IN A NEAT AND WORKMANLIKE MANNER ACCORDING TO THE BEST TRADE PRACTICES BY THOSE SKILLED IN THE PARTICULAR TRADE. PIPES, FIXTURES, EQUIPMENT, ETC. TO BE LEVEL, SQUARE, OR CENTERED ETC. TO GIVE NEAT AND PLEASING APPEARANCE. ALL EQUIPMENT IS TO BE INSTALLED STRICTLY PER MANUFACTURERS RECOMMENDATIONS. COORDINATE ALL WORK W/ OTHER TRADES.
- OFFICE OR PUBLIC BUILDINGS FOR USE BY MORE THAN SIX PEOPLE SHALL HAVE ON DRINKING FOUNTAIN (CPC APPENDIX "C").
- ALL WATER CLOSETS FOR PUBLIC USE SHALL BE ELONGATED BOWLS W/ OPEN FRONT SEATS. (CPC 409)
- PLUMBING FIXTURES SHALL MEET STATE OF CALIFORNIA HANDICAPPED REQUIREMENTS.
- ALL PLUMBING WORK SHALL COMPLY W/ THE LATEST UPC REQUIREMENTS.
- PROVIDE PERMANENT IDENTIFICATION ON ALL HEATING AND COOLING EQUIPMENT AS TO THE AREA OF SPACE SERVED BY THE EQUIPMENT. (CMC 303.6)
- PROVIDE CLEANOUTS FOR WASTE LINES EXCEEDING 5' FROM THE MAIN. CLEANOUTS SHALL BE SIZED PER CPC TABLE 101.
- ATTIC WATER HEATER SHALL BE EQUIPPED W/ AN APPROVED TYPE FAN W/ A ¾" DRAIN TO EXTERIOR OF BUILDING AT A CONSPICUOUS LOCATION.
- ATTIC MOUNTED WATER HEATERS SHALL BE ACCESSIBLE BY A FULL 24"x48" APPLIES PER (CPC 5112) INCLUDING A LIGHT SWITCH AND FIXTURE.
- DISABLED ACCESS WATER CLOSET TRIP LEVERS. (OR FLUSHOMETER VALVE HANDLES) SHALL BE MOUNTED ON THE WIDE SIDE.
- HOT WATER DELIVERED FROM PUBLIC USE LAVATORIES SHALL BE LIMITED TO A MAXIMUM HOT WATER TEMPERATURE OF 110° F AND THE WATER HEATER THERMOSTAT SHALL NOT BE CONSIDERED A CONTROL FOR MEETING THIS PROVISION. CPC 4212.
- ALL WASTE LINES TO BE A MINIMUM 2% SLOPE PER CPC 100.0.
- ALL PLUMBING CONVEYING OR DISPENSING WATER FOR HUMAN CONSUMPTION SHALL COMPLY WITH AB1993 FOR LEAD CONTENT.

DOMESTIC WATER DEMAND AND SIZING

WATER CALCULATIONS FOR BUILDINGS "A" AND "B"

WATER METER SIZE 2" \_\_\_\_\_  
TOTAL FIXTURE UNITS \_\_\_\_\_ 118 \_\_\_\_\_ EQUAL TOTAL \_\_\_\_\_ 50 \_\_\_\_\_ GPM  
TOTAL DISTANCE FROM WATER METER TO MOST REMOTE PLBG. FIXTURE \_\_\_\_\_ 500 \_\_\_\_\_ FT.  
TOTAL RISE FOR HEAD LOSS \_\_\_\_\_ 3 \_\_\_\_\_ FT. x 0.43 \_\_\_\_\_ 1.5 \_\_\_\_\_ PSI  
PSI REQUIRED FOR WATER CLOSET/URINAL (\*F.V.=15.0 PSI, F.T. = 8.0 PSI) \_\_\_\_\_ 8.0 \_\_\_\_\_ PSI  
PSI FLOW LOSS THRU WATER METER (CHART A-102.2) \_\_\_\_\_ 1.5 \_\_\_\_\_ PSI  
PSI FLOW LOSS THRU BACKFLOW PREVENTER (RP=12.0 PSI, D.C. = 12.0 PSI) \_\_\_\_\_ 12.0 \_\_\_\_\_ PSI  
TOTAL SYSTEM LOSS \_\_\_\_\_ 22.0 \_\_\_\_\_ PSI  
MINIMUM PSI AVAILABLE @ JOB SITE \_\_\_\_\_ 35.0 \_\_\_\_\_ PSI  
TOTAL SYSTEM LOSS IN PSI \_\_\_\_\_ 22.0 \_\_\_\_\_ PSI  
REMAINING PSI AVAILABLE (IF NEGATIVE USE BOOSTER PUMP) \_\_\_\_\_ 13.0 \_\_\_\_\_ PSI  
BOOSTER PUMP PSI \_\_\_\_\_ \_\_\_\_\_ PSI  
TOTAL REMAINING PSI AVAILABLE \_\_\_\_\_ 13.0 \_\_\_\_\_ PSI  
PSI AVAILABLE 13.0 + 500 TOTAL FEET = .028 x100= 2.8 PSI/100 FT

USE LINE "3" CHART #A-105.1(1) C.P.C.

6"	PIPE WILL DELIVER _____ GPM FOR _____ *F.V. FIXTURE UNITS	
5"	PIPE WILL DELIVER _____ GPM FOR _____ *F.V. FIXTURE UNITS	
4"	PIPE WILL DELIVER _____ GPM FOR _____ *F.V. FIXTURE UNITS _____ *F.T. FIXTURE UNITS	
3"	PIPE WILL DELIVER _____ GPM FOR _____ *F.V. FIXTURE UNITS _____ *F.T. FIXTURE UNITS	
2 1/2"	PIPE WILL DELIVER _____ GPM FOR _____ *F.V. FIXTURE UNITS _____ *F.T. FIXTURE UNITS	
2"	PIPE WILL DELIVER _____ GPM FOR _____ *F.V. FIXTURE UNITS _____ *F.T. FIXTURE UNITS	
1 1/2"	PIPE WILL DELIVER _____ GPM FOR _____ *F.V. FIXTURE UNITS _____ *F.T. FIXTURE UNITS	
1 1/4"	PIPE WILL DELIVER _____ GPM FOR _____ *F.V. FIXTURE UNITS _____ *F.T. FIXTURE UNITS	
1"	PIPE WILL DELIVER _____ GPM FOR _____ *F.V. FIXTURE UNITS _____ *F.T. FIXTURE UNITS	
3/4"	PIPE WILL DELIVER _____ GPM FOR _____ *F.V. FIXTURE UNITS _____ *F.T. FIXTURE UNITS	
1/2"	PIPE WILL DELIVER _____ GPM FOR _____ *F.V. FIXTURE UNITS _____ *F.T. FIXTURE UNITS	

REMARKS  
F.T. = FLUSH TANK  
F.V. = FLUSH VALVE

DOMESTIC WATER DEMAND AND SIZING

WATER CALCULATIONS FOR BUILDINGS "C" AND "D"

WATER METER SIZE 2" \_\_\_\_\_  
TOTAL FIXTURE UNITS \_\_\_\_\_ 112 \_\_\_\_\_ EQUAL TOTAL \_\_\_\_\_ 48 \_\_\_\_\_ GPM  
TOTAL DISTANCE FROM WATER METER TO MOST REMOTE PLBG. FIXTURE \_\_\_\_\_ 500 \_\_\_\_\_ FT.  
TOTAL RISE FOR HEAD LOSS \_\_\_\_\_ 10 \_\_\_\_\_ FT. x 0.43 \_\_\_\_\_ 1.5 \_\_\_\_\_ PSI  
PSI REQUIRED FOR WATER CLOSET/URINAL (\*F.V.=15.0 PSI, F.T. = 8.0 PSI) \_\_\_\_\_ 8.0 \_\_\_\_\_ PSI  
PSI FLOW LOSS THRU WATER METER (CHART A-102.2) \_\_\_\_\_ 1.5 \_\_\_\_\_ PSI  
PSI FLOW LOSS THRU BACKFLOW PREVENTER (RP=12.0 PSI, D.C. = 12.0 PSI) \_\_\_\_\_ 12.0 \_\_\_\_\_ PSI  
TOTAL SYSTEM LOSS \_\_\_\_\_ 22.0 \_\_\_\_\_ PSI  
MINIMUM PSI AVAILABLE @ JOB SITE \_\_\_\_\_ 35.0 \_\_\_\_\_ PSI  
TOTAL SYSTEM LOSS IN PSI \_\_\_\_\_ 22.0 \_\_\_\_\_ PSI  
REMAINING PSI AVAILABLE (IF NEGATIVE USE BOOSTER PUMP) \_\_\_\_\_ 13.0 \_\_\_\_\_ PSI  
BOOSTER PUMP PSI \_\_\_\_\_ \_\_\_\_\_ PSI  
TOTAL REMAINING PSI AVAILABLE \_\_\_\_\_ 13.0 \_\_\_\_\_ PSI  
PSI AVAILABLE 13.0 + 500 TOTAL FEET = .028 x100= 2.8 PSI/100 FT

USE LINE "3" CHART #A-105.1(1) C.P.C.


6"	PIPE WILL DELIVER _____ GPM FOR _____ *F.V. FIXTURE UNITS	
5"	PIPE WILL DELIVER _____ GPM FOR _____ *F.V. FIXTURE UNITS	
4"	PIPE WILL DELIVER _____ GPM FOR _____ *F.V. FIXTURE UNITS _____ *F.T. FIXTURE UNITS	
3"	PIPE WILL DELIVER _____ GPM FOR _____ *F.V. FIXTURE UNITS _____ *F.T. FIXTURE UNITS	
2 1/2"	PIPE WILL DELIVER _____ GPM FOR _____ *F.V. FIXTURE UNITS _____ *F.T. FIXTURE UNITS	
2"	PIPE WILL DELIVER _____ GPM FOR _____ *F.V. FIXTURE UNITS _____ *F.T. FIXTURE UNITS	
1 1/2"	PIPE WILL DELIVER _____ GPM FOR _____ *F.V. FIXTURE UNITS _____ *F.T. FIXTURE UNITS	
1 1/4"	PIPE WILL DELIVER _____ GPM FOR _____ *F.V. FIXTURE UNITS _____ *F.T. FIXTURE UNITS	
1"	PIPE WILL DELIVER _____ GPM FOR _____ *F.V. FIXTURE UNITS _____ *F.T. FIXTURE UNITS	
3/4"	PIPE WILL DELIVER _____ GPM FOR _____ *F.V. FIXTURE UNITS _____ *F.T. FIXTURE UNITS	
1/2"	PIPE WILL DELIVER _____ GPM FOR _____ *F.V. FIXTURE UNITS _____ *F.T. FIXTURE UNITS	

REMARKS  
F.T. = FLUSH TANK  
F.V. = FLUSH VALVE


FIXTURE SCHEDULE

- ADA WATER CLOSET, TANK TYPE, HANDLE ON WIDE SIDE, FLOOR MOUNT, ELONG BOWL, OPEN END SEAT, 18" MAX HEIGHT 3"W / 2"V / 1/2" CW
- ADA LAVATORY, WALL MOUNT, SINGLE LEVER FAUCET, 34" MAX RIM HEIGHT, 29" MIN. KNEE CLEARANCE, TRAP BOOT. 2" W / 2" V / 1/2" CW/ HW FROM MULTI LAY INSTANTANEOUS WATER HEATER
- ADA SINK, WALL MOUNT, SINGLE LEVER FAUCET, 34" MAX RIM HEIGHT, 29" MIN. KNEE CLEARANCE, TRAP BOOT. 2" W / 2" V / 1/2" CW/ HW FROM MULTI LAY INSTANTANEOUS WATER HEATER
- INSTANTANEOUS WATER HEATER MULTI-LAY, EEMAX LAY ADVANTAGE 8PEX 420ST ML: 41 KW, 20AMP, 1/2" CW ¾" SUPPLY HOT WATER
- HOSE BIB WITH VACUUM BREAKER 1/2" CW
- ROOF TOP HOSE BIB WITH VACUUM BREAKER 1/2" CW
- SUMP PUMP, ZOELLER M38, CAST IRON, 1/2 HP, 1½" EJECTION PORT VERTICAL FLOAT, CHECK VALVE, 38" CORD, IN TRAFFIC RATED PRECAST CONCRETE BOX. 4800 PSI CONCRETE, H-20 LOAD RATE. SEE LOADING DOCK SUMP PUMP DETAIL ON SHEET P-502.


EVAP COOLER CONNECTION DETAIL

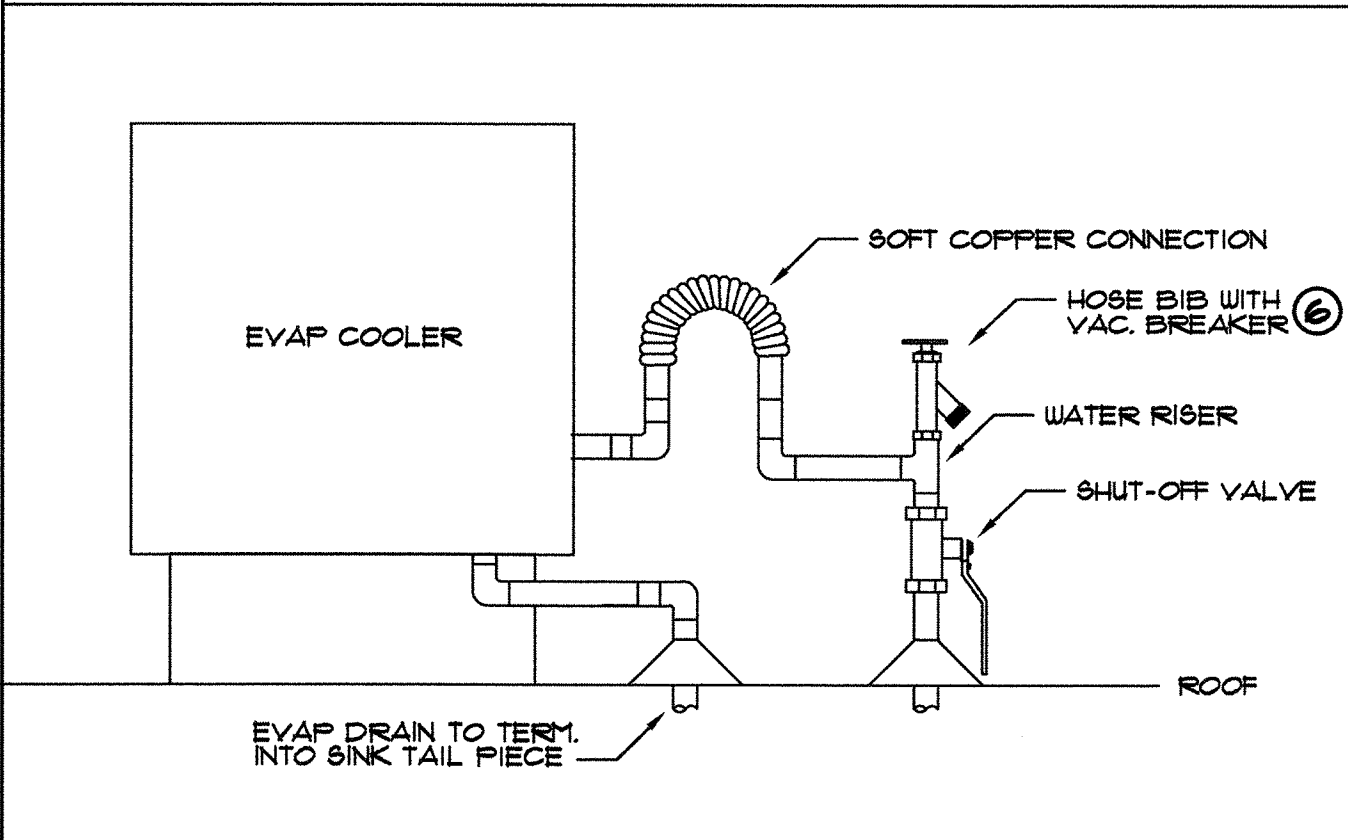

INDOOR MINI SPLIT UNIT CONDENSATE DRAIN DETAIL

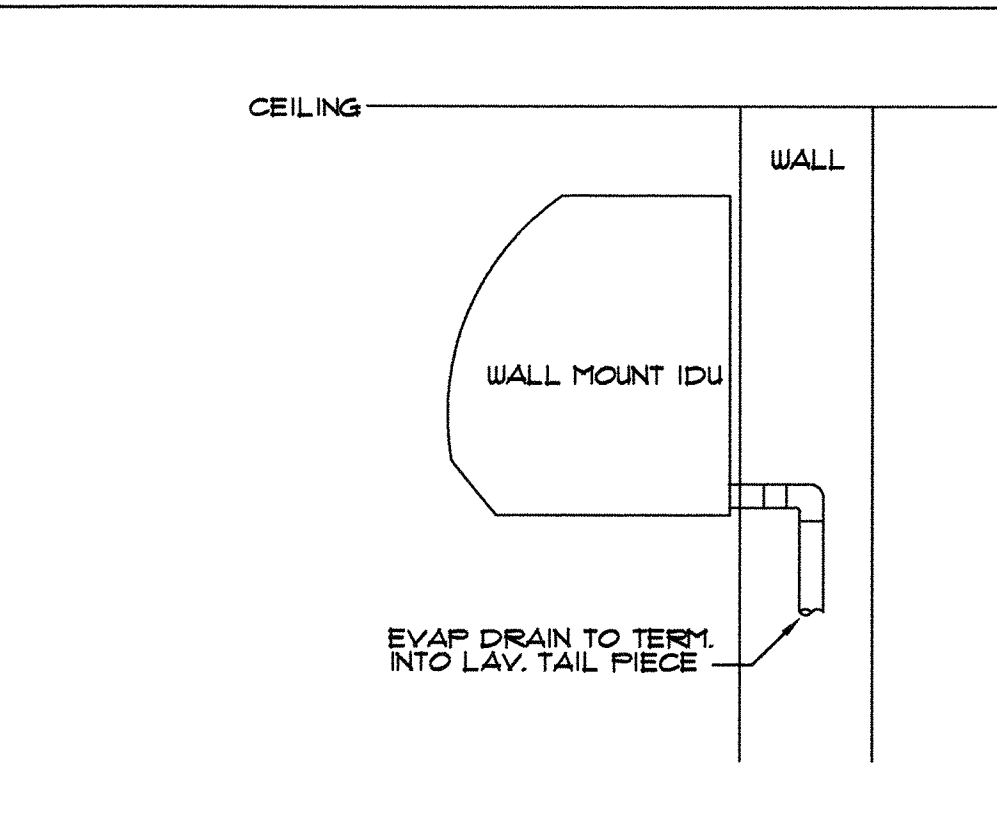

INSTA-HOT HOT WATER SUPPLY CONNECTION DETAIL

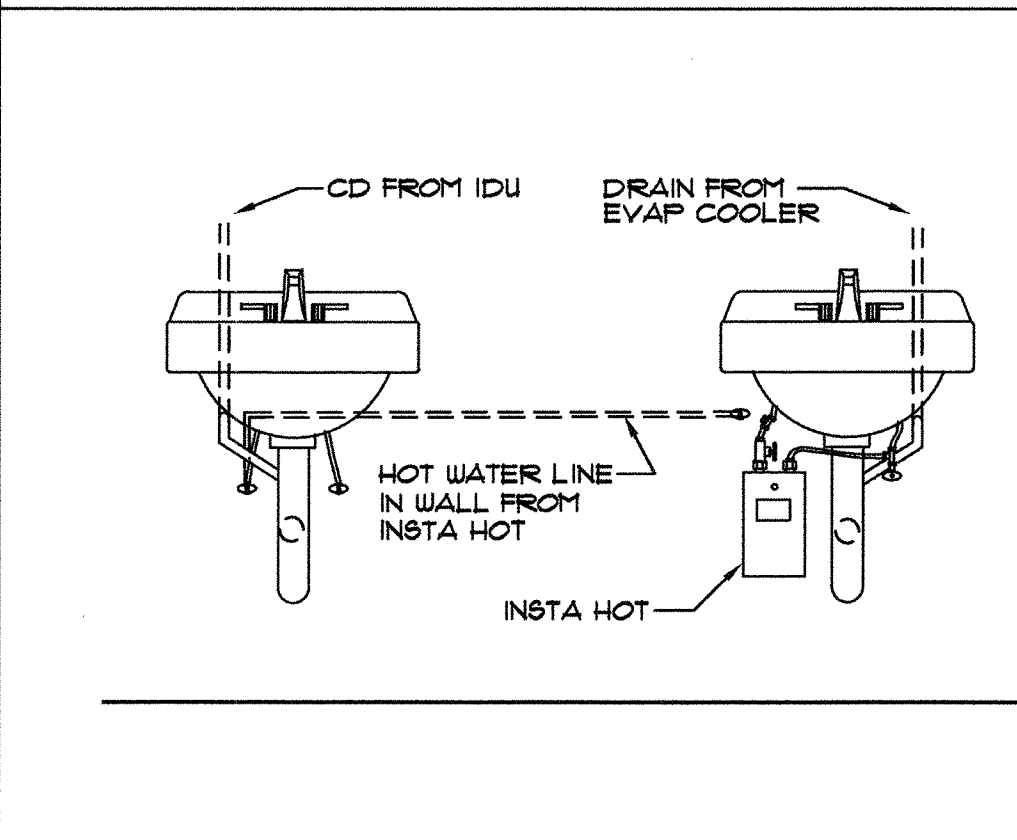

NOTES

- ALL WASTE LINES 4" AND LARGER TO RUN AT 1/8" PER FOOT. (1%) SLOPE TO MEET CITY SEWER DEPTH.
- ALL WASTE LINES, VENT LINES AND WATER LINES PENETRATING CONCRETE SLAB SHALL BE PROTECTED WITH A RIDGID SLEEVE. WATER CLOSET RISER, FLOOR DRAIN AND F.D. TAILPIECE EXCLUDED.
- MECHANICAL INDOOR WALL UNIT CONDENSATE DRAIN TO RUN THROUGH WALL AND TERMINATE INTO LAVATORY TAILPIECE.
- EVAPORATIVE COOLER TO HAVE 1/2" CW SHUT-OFF VALVE AND ¾" DRAIN TO TERMINATE INTO WAREHOUSE SINK TAILPIECE.

SYMBOLS

- |                            |  |
|----------------------------|--|
| SOV SHUT-OFF VALVE         | IWH INSTANTANEOUS WATER HEATER           |
| SOVB SHUT-OFF VALVE IN BOX | HB HOSE BIB WITH VAC. BREAKER            |
| FCO FLOOR CLEAN-OUT        | RTHB ROOF TOP HOSE BIB WITH VAC. BREAKER |
| WCO WALL CLEAN-OUT         |  |

LEGEND

- |       |            |
|-------|------------|
| ———   | WASTE      |
| ----- | VENT       |
| ———   | COLD WATER |
| ———   | HOT WATER  |
| ———   | CONDENSATE |



LICENSE: #1080771  
ADDRESS: 9405 E. HAMPTON WAY  
FRESNO, CA 93722  
CALL: (559) 779-8888  
EMAIL: Tony@gjplumbing.com




BY	
REVISION	
CITY OF MADERA PLAN CHECK CORRECTION	
DATE	11/1/2021
SEAL	

GENERAL NOTES AND DETAILS  
FOR  
LEASE FLEX. / WAREHOUSE BUILDINGS  
MADERA INDUSTRIAL WHSE, LLC  
325/035/045/055 S. SCHNOOR AVENUE, MADERA, CA

JOB NUMBER	21107
DESIGNED BY	Designer
DRAWN BY	Author
DATE	7/XX/2021
SHEET NUMBER	P-1.0




6/1/2021 11:44:14 AM 7/1/2021 11:44:14 AM

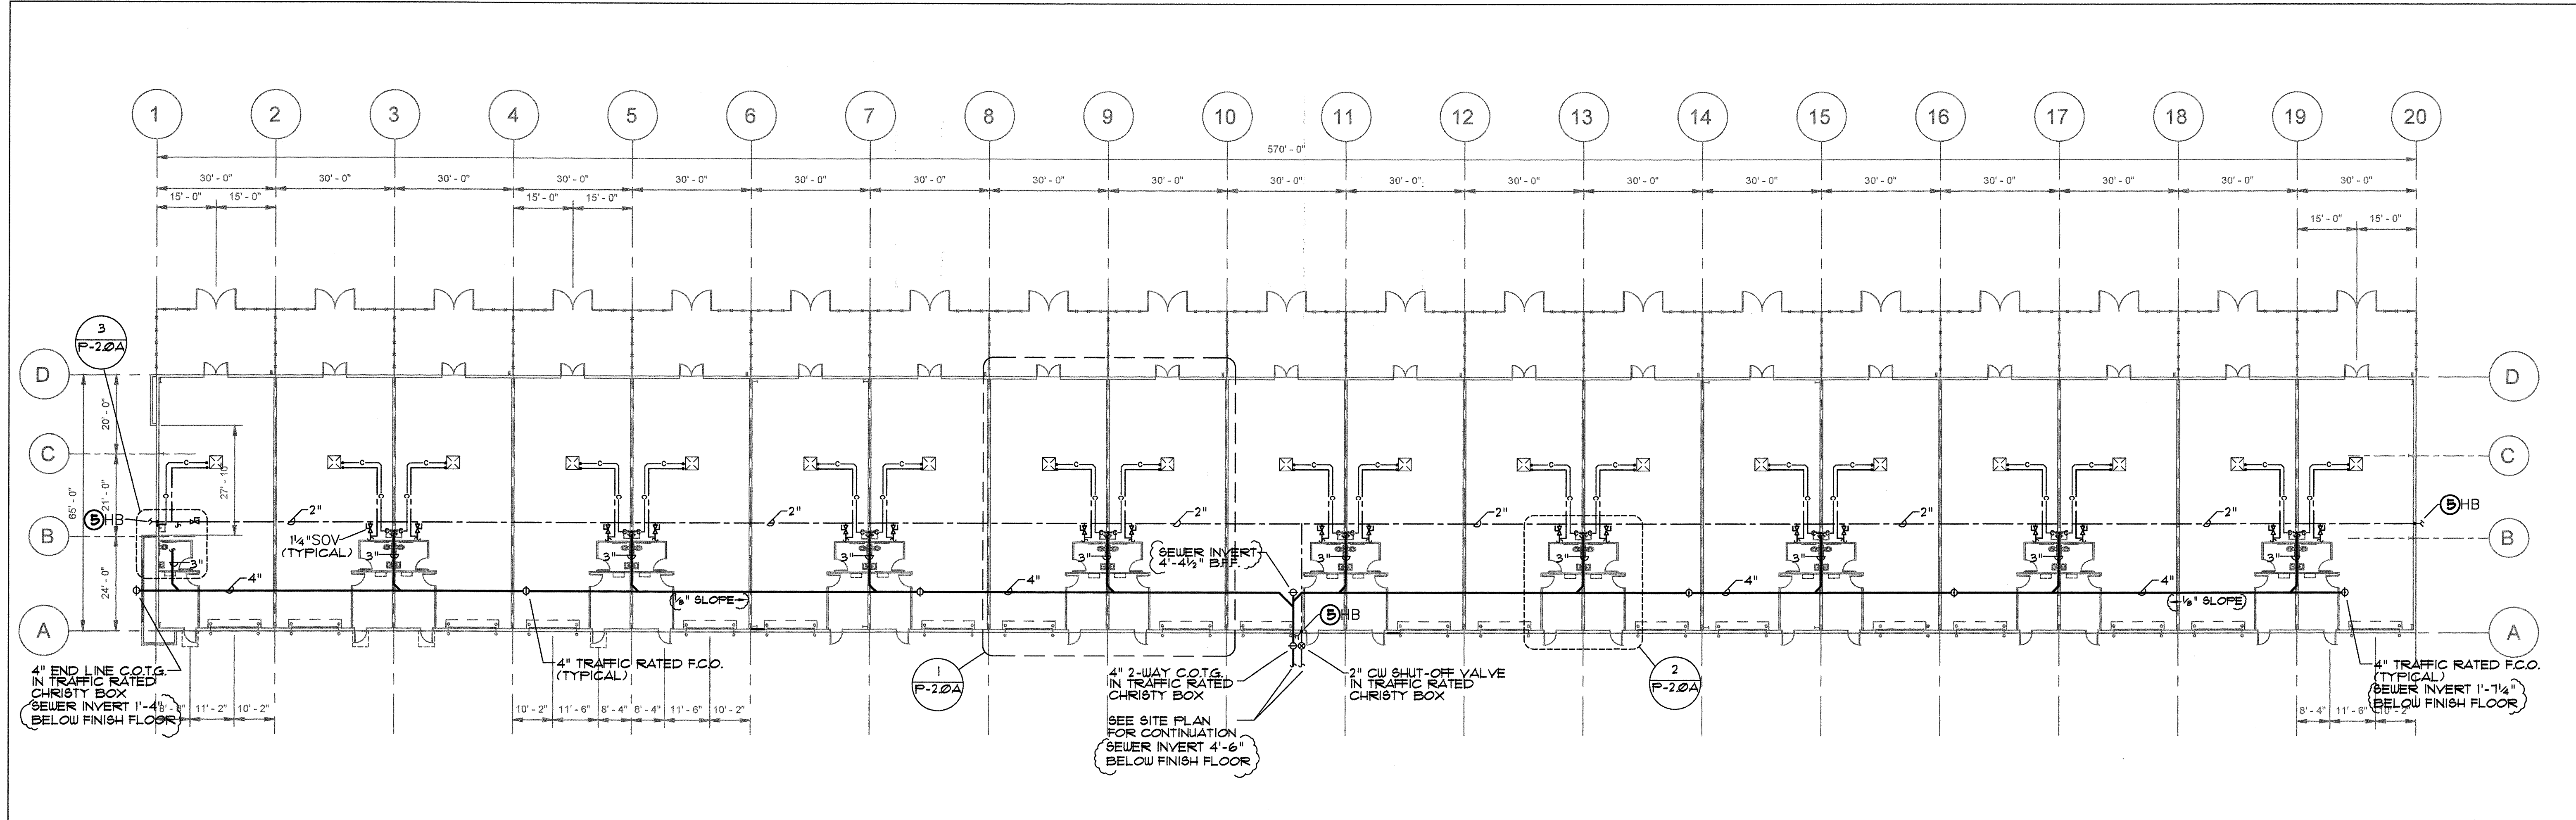


OVERALL PLUMBING PLAN

SCALE: 1" = 20'-0"

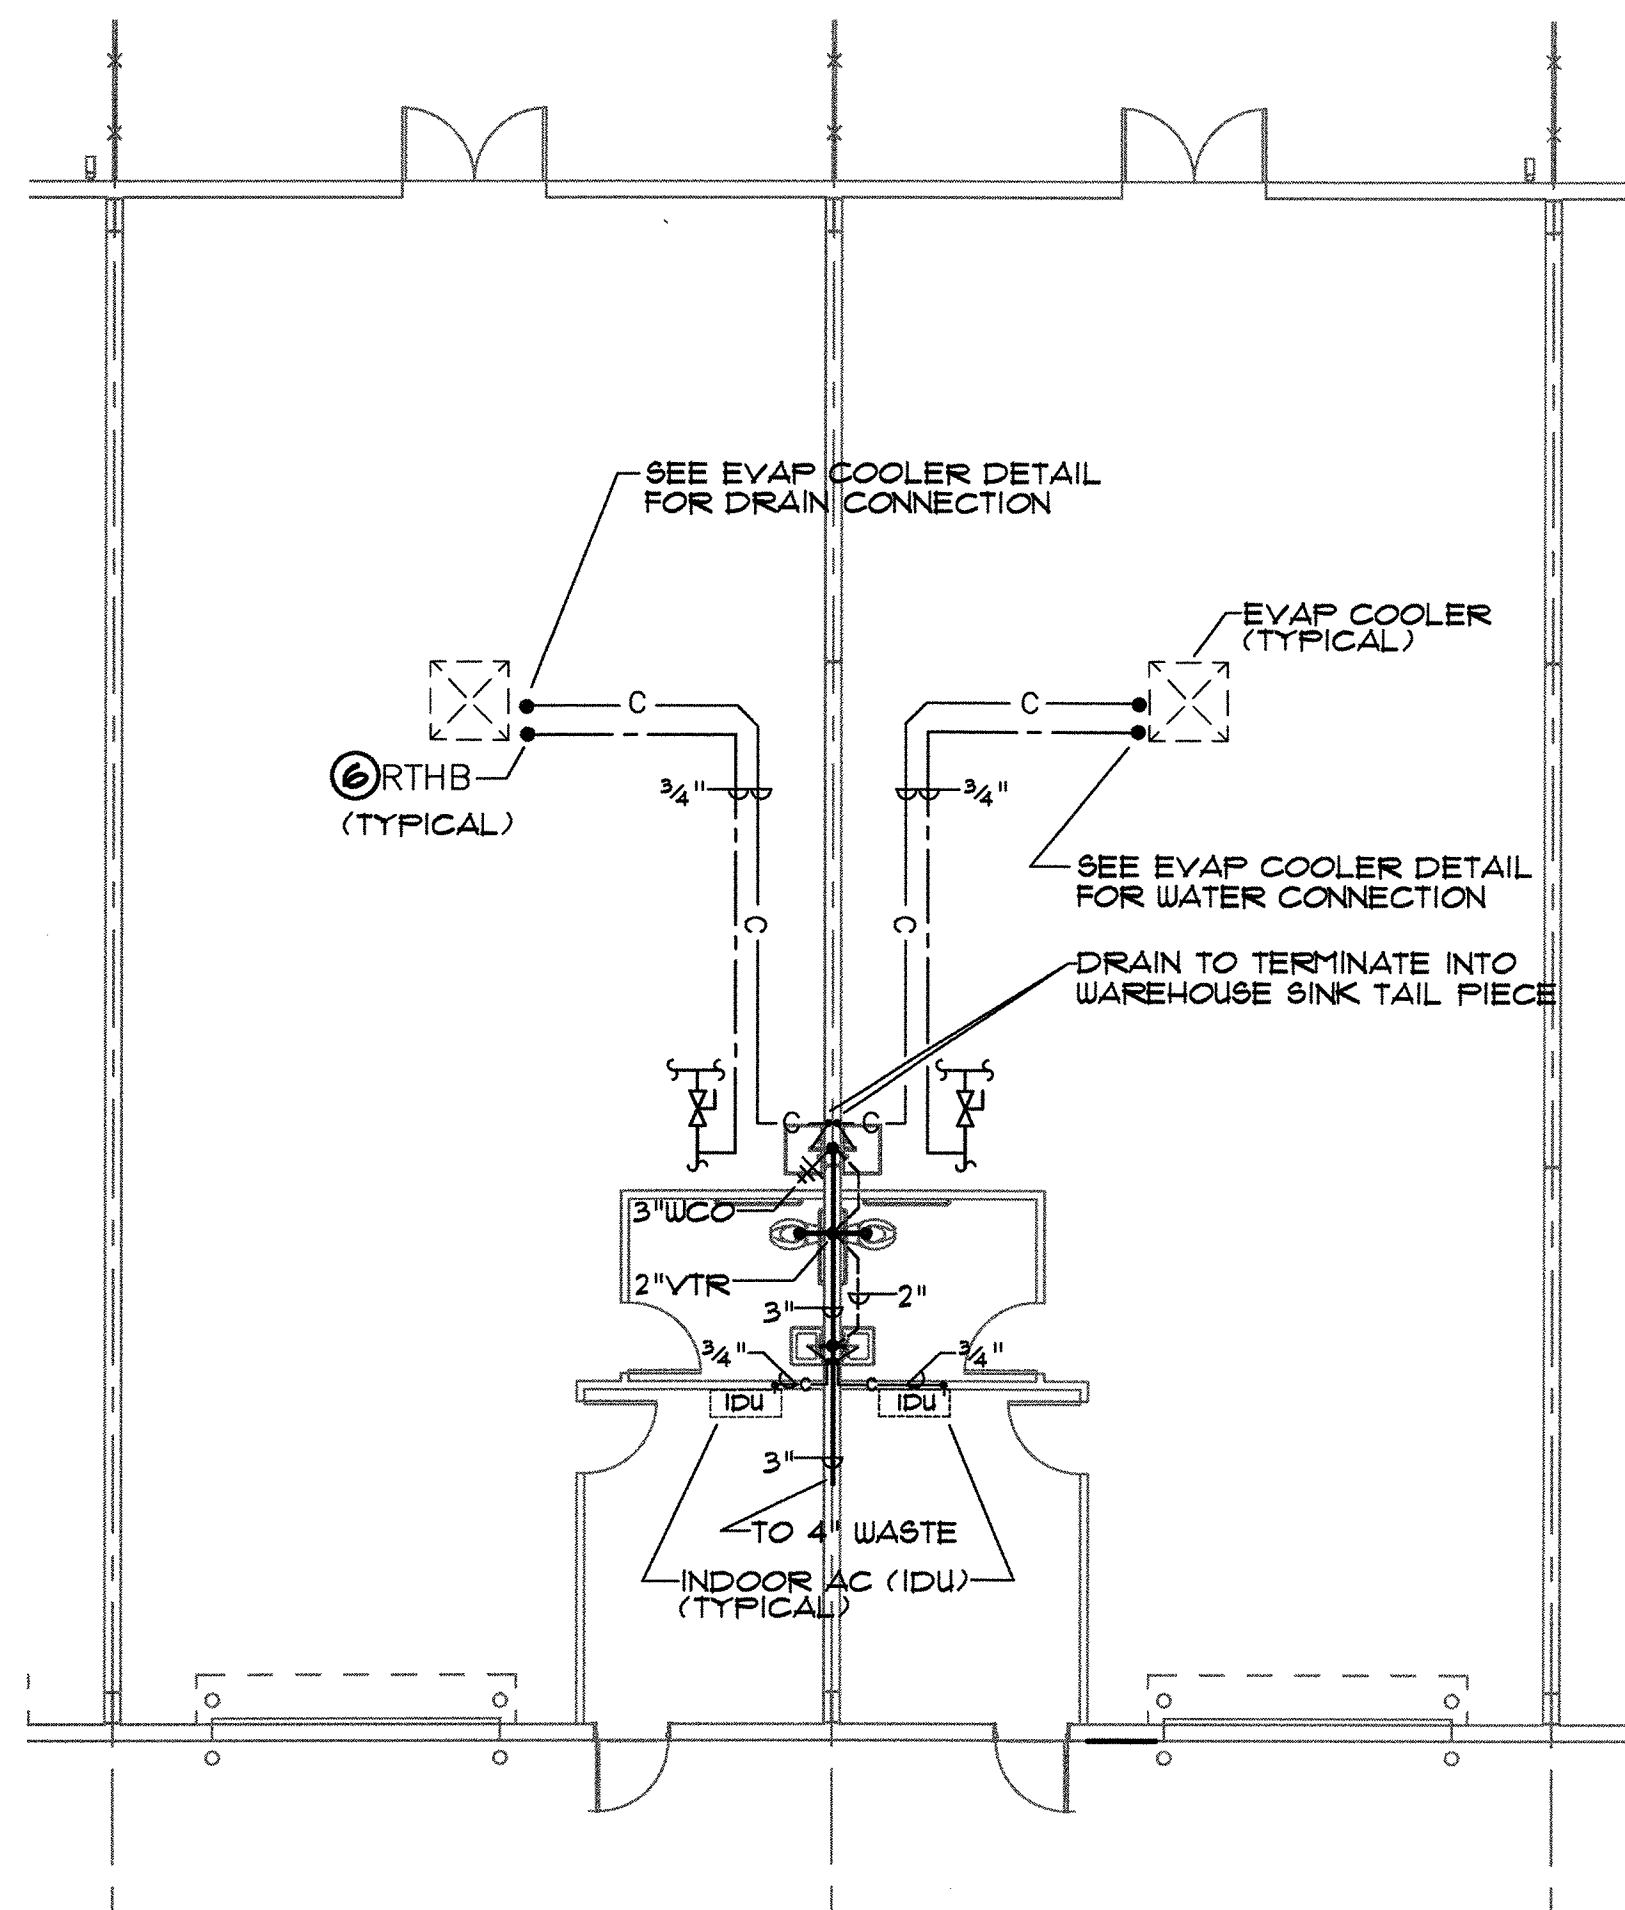


ENLARGED TENANT SPACE PLUMBING PLAN

SCALE: 1/2" = 1'-0"

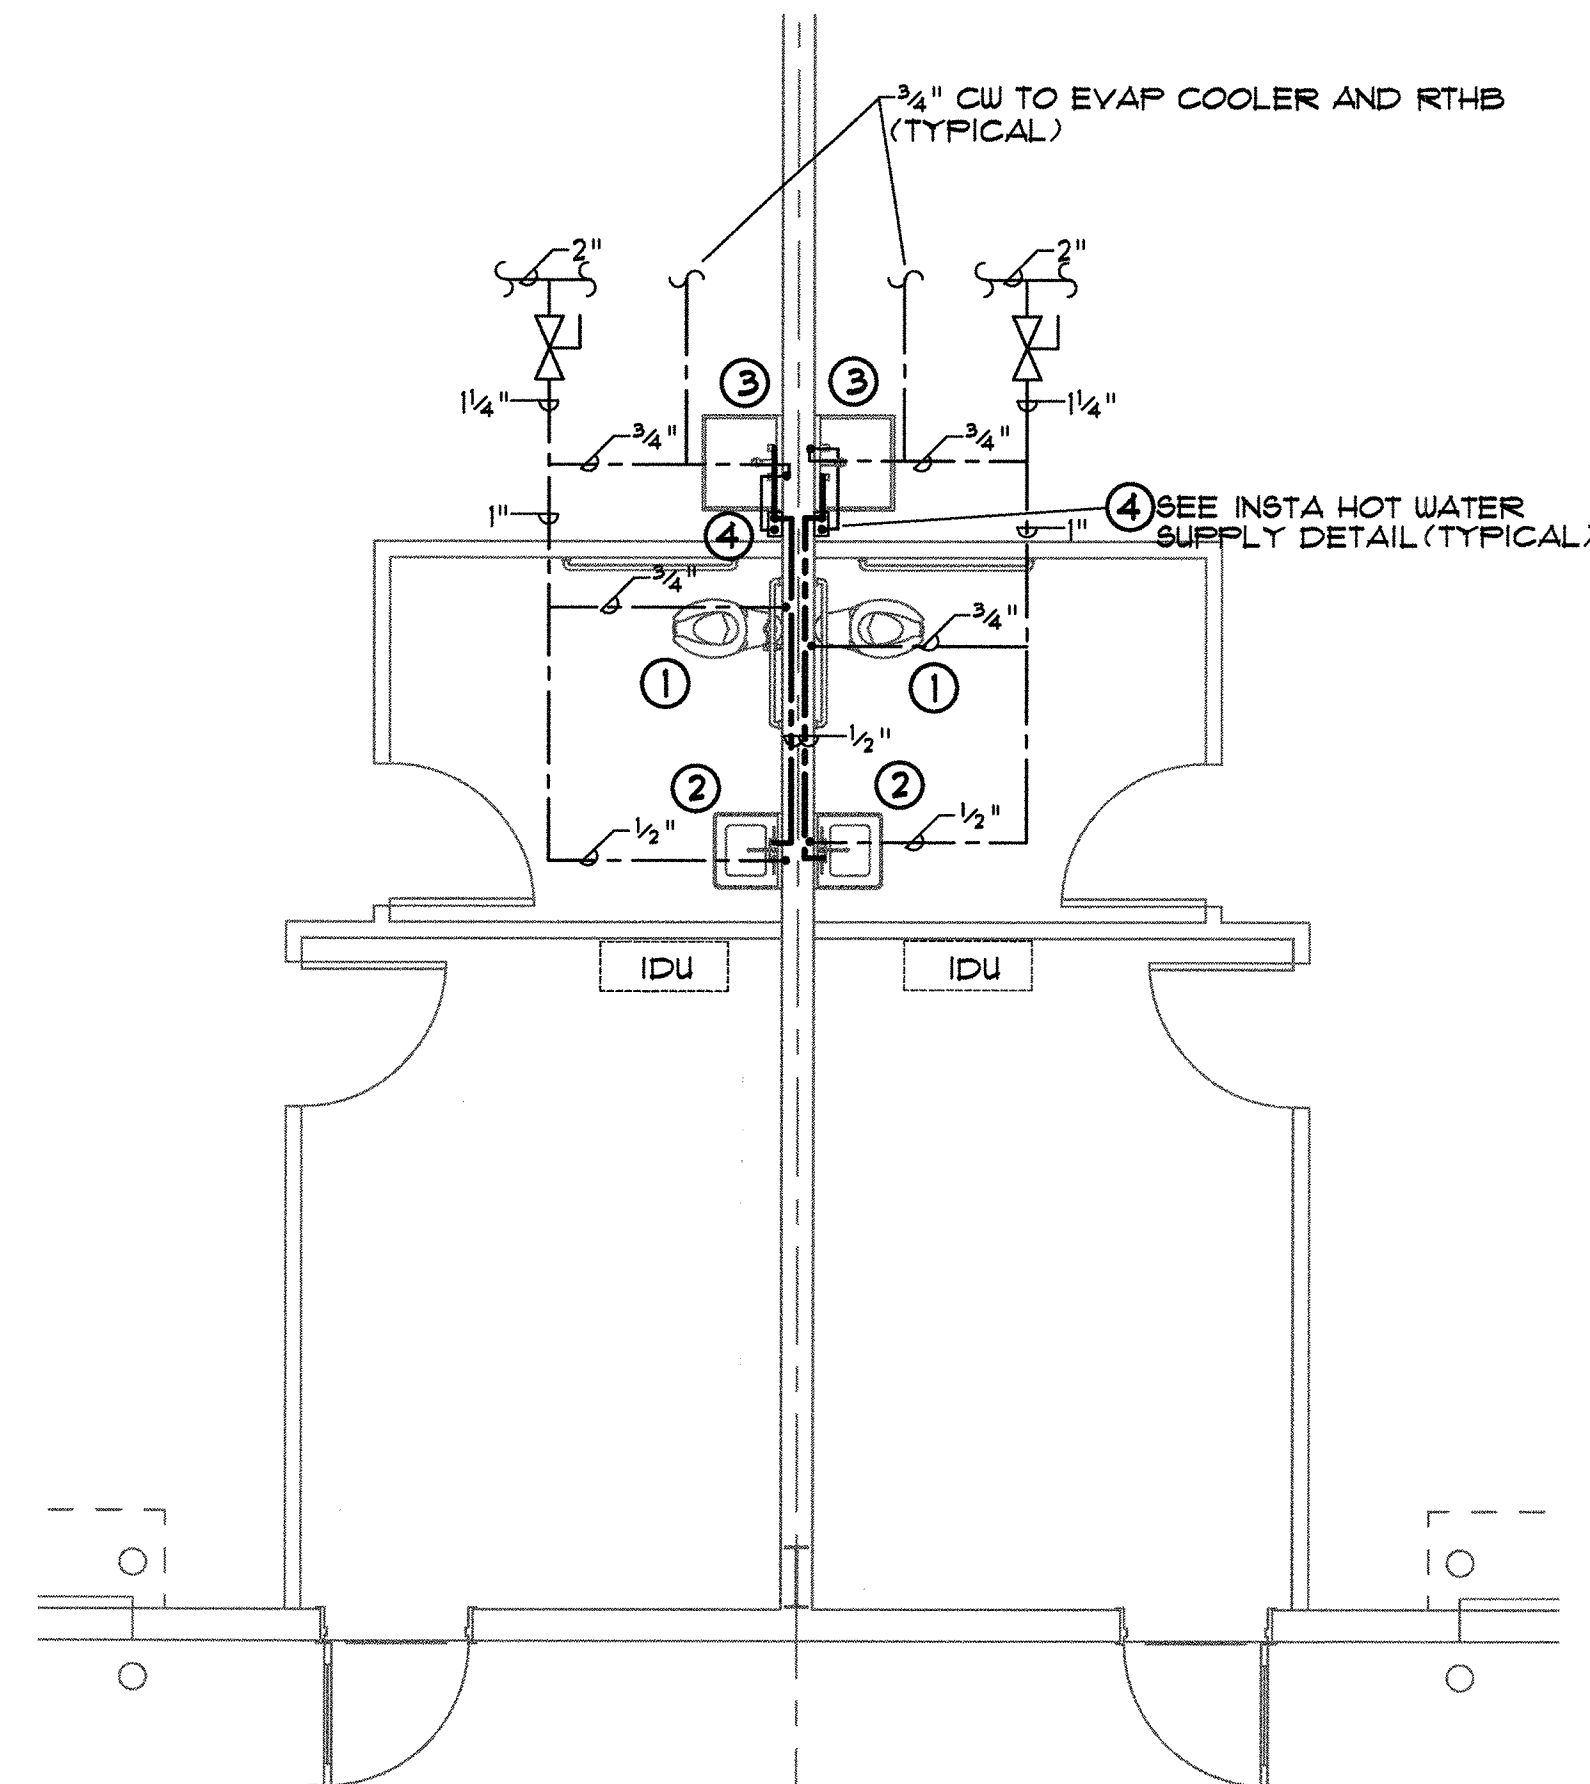


ENLARGED TENANT SPACE DOMESTIC WATER PLAN

SCALE: 1/4" = 1'-0"

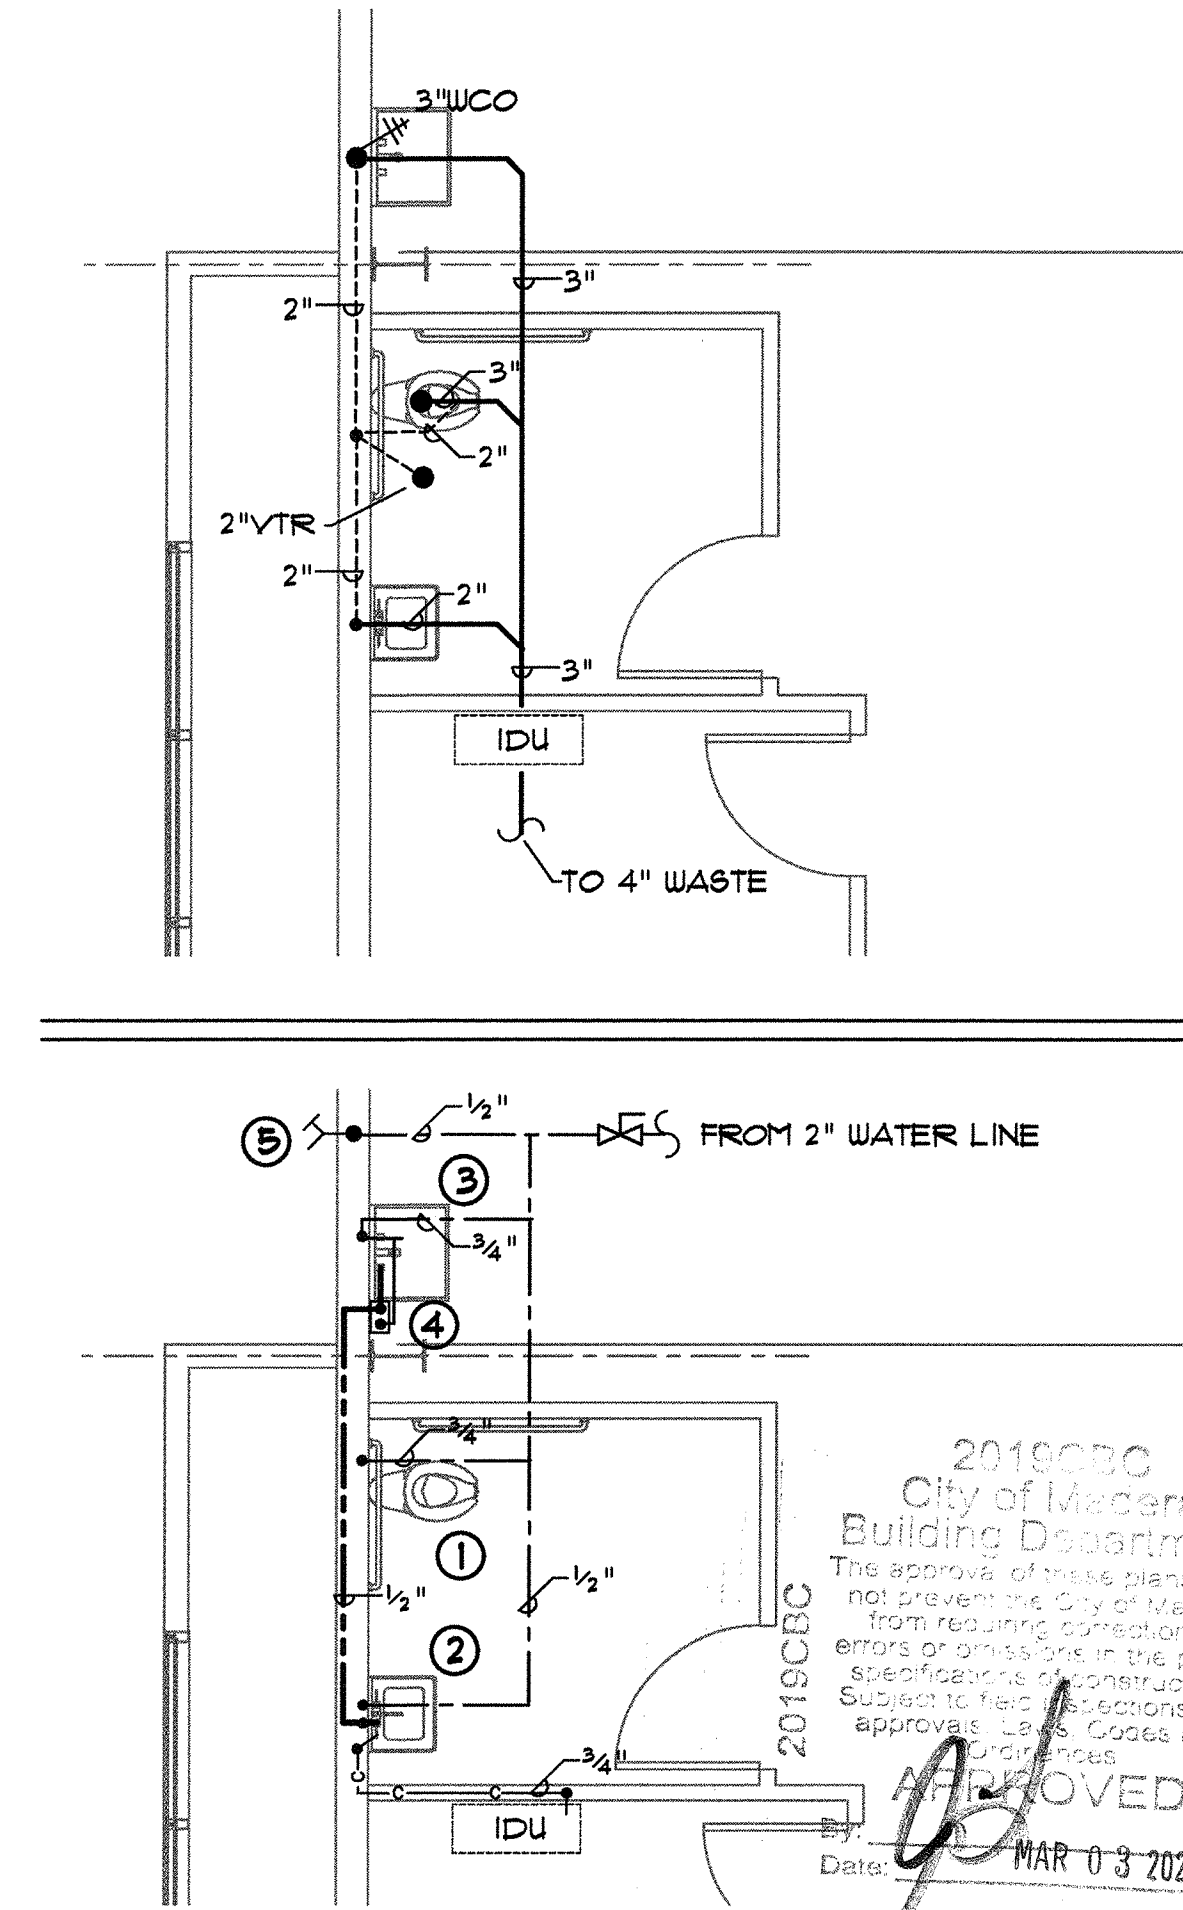

ENLARGED RESTROOM PLUMBING PLAN

SCALE: 1/4" = 1'-0"

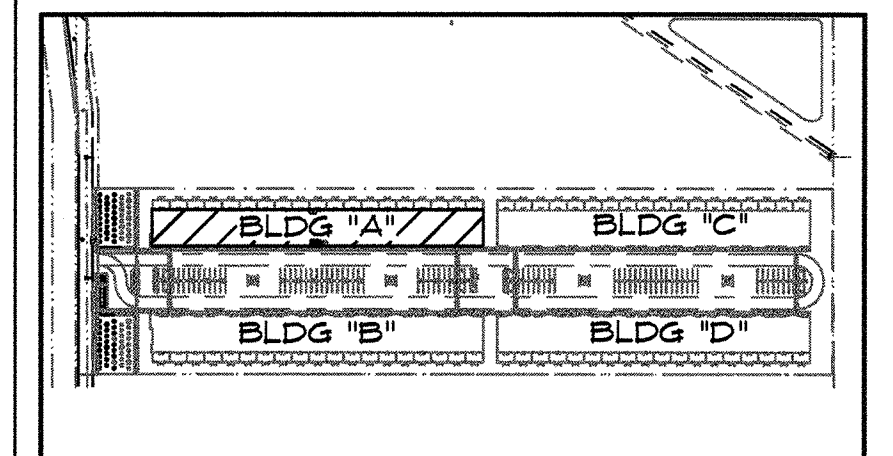

SITE MAP

LEGEND

- WASTE
- VENT
- COLD WATER
- HOT WATER
- C CONDENSATE

SYMBOLS

- SOV SHUT-OFF VALVE
- SOVB SHUT-OFF VALVE IN BOX
- FCO FLOOR CLEAN-OUT
- WCO WALL CLEAN-OUT
- IWH INSTANTANEOUS WATER HEATER
- HB HOSE BIB WITH VAC. BREAKER
- RTHB ROOF TOP HOSE BIB WITH VAC. BREAKER



LICENSURE: #1080771  



BY	
REVISION	CITY OF MADERA PLAN CHECK CORRECTION
DATE	11/1/2021
SEAL	




BLDG. A PLUMBING PLAN  
LEASE FLEX. / WAREHOUSE BUILDINGS  
FOR  
MADERA INDUSTRIAL WHSE, LLC  
325 S. SCHNOOR AVENUE, MADERA, CA

JOB NUMBER	21107
DESIGNED BY	Designer
DRAWN BY	Author
DATE	4/27/2021
SHEET NUMBER	P-2.0A




G:\Shared Drive\BIM\Company\PROJECTS\2019\16. WAREHOUSE, CA\Bldg. C\Bldg. C\DWG\Plumbing\Plumbing.dwg - Madera\HSE, B. DDB, 2021, 03, 17, 04:44 AM  
G:\Shared Drive\BIM\Company\PROJECTS\2019\16. WAREHOUSE, CA\Bldg. C\Bldg. C\DWG\Plumbing\Plumbing.dwg - Madera\HSE, B. DDB, 2021, 03, 17, 04:44 AM  
G:\Shared Drive\BIM\Company\PROJECTS\2019\16. WAREHOUSE, CA\Bldg. C\Bldg. C\DWG\Plumbing\Plumbing.dwg - Madera\HSE, B. DDB, 2021, 03, 17, 04:44 AM

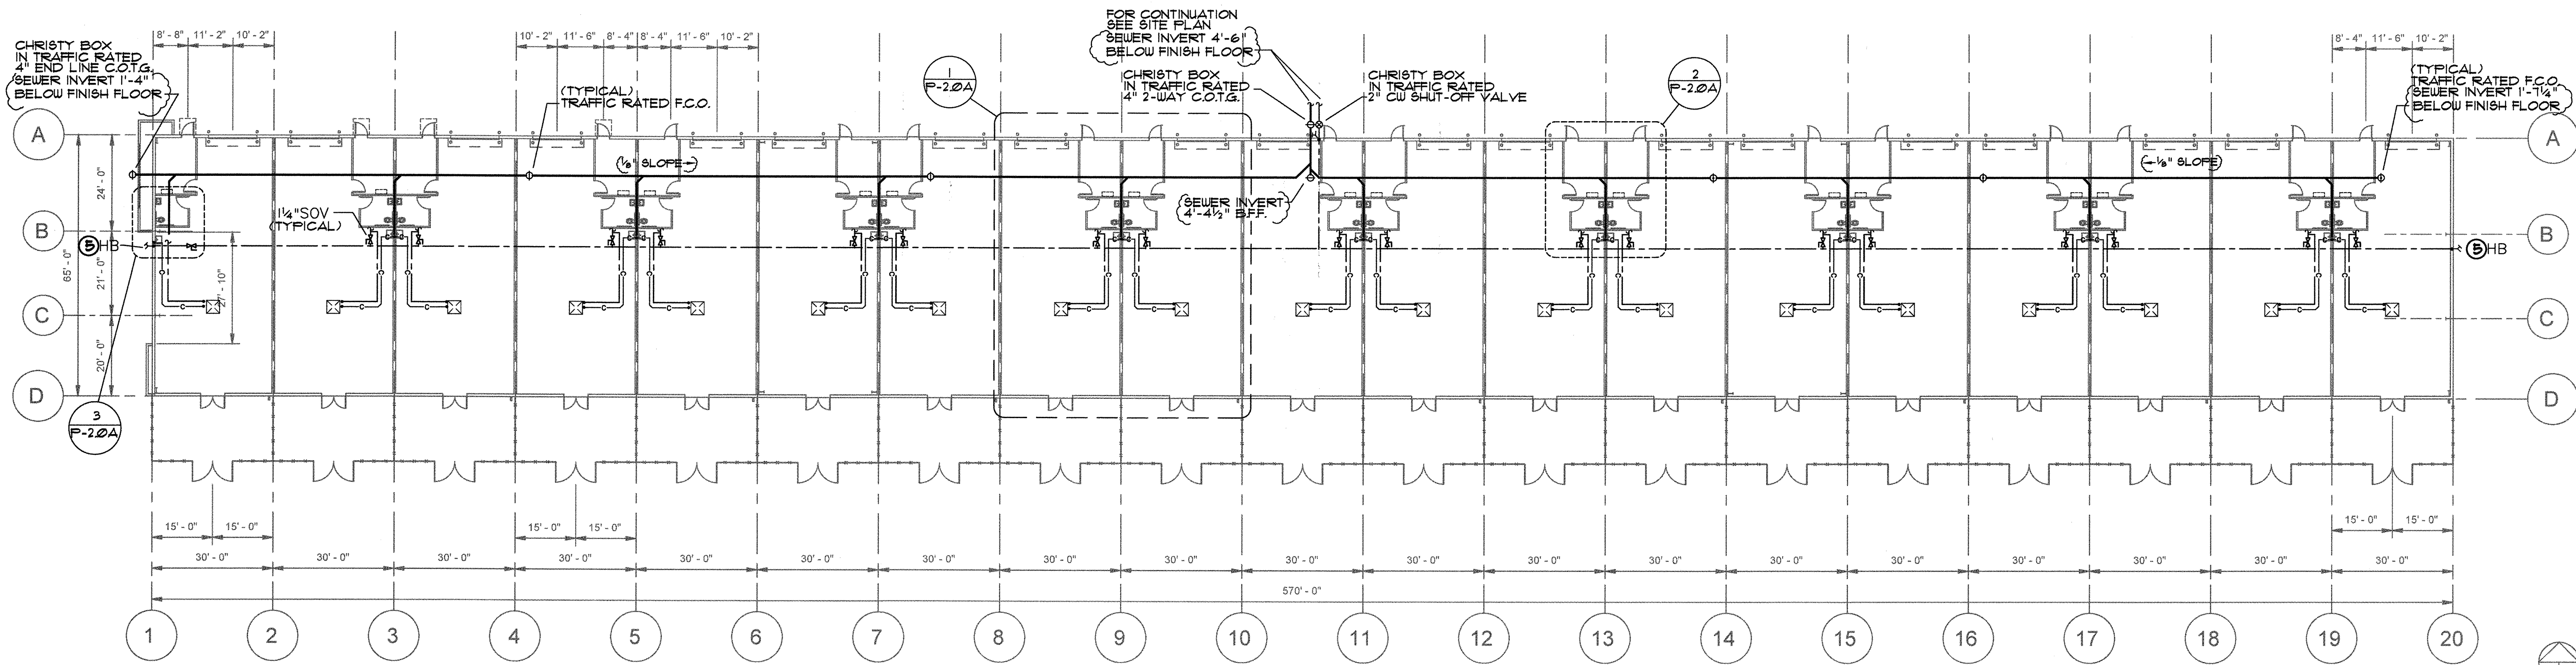

OVERALL PLUMBING PLAN

SCALE: 1" = 20'-0"

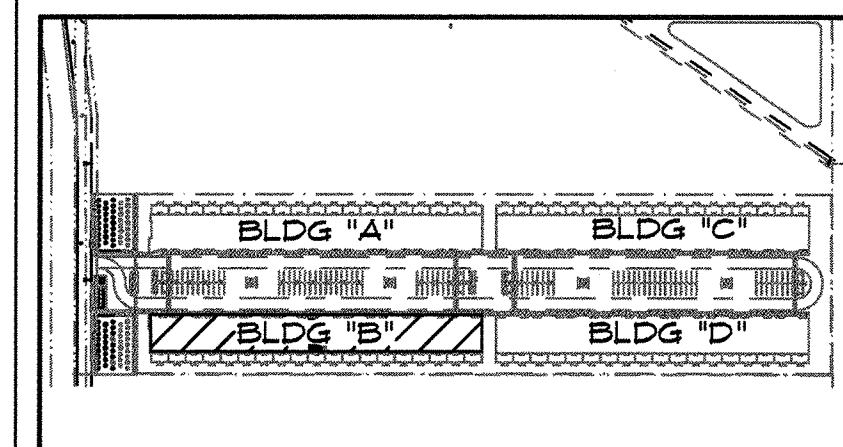

SITE MAP

LEGEND

— WASTE  
- - - VENT  
- - - COLD WATER  
- - - HOT WATER  
— C — CONDENSATE

SYMBOLS

⊗ SOV SHUT-OFF VALVE  
⊗ SOVB SHUT-OFF VALVE IN BOX  
⊕ FCO FLOOR CLEAN-OUT  
⊕ WCO WALL CLEAN-OUT  
⊕ IWH INSTANTANEOUS WATER HEATER  
⊕ HB HOSE BIB WITH VAC. BREAKER  
⊕ RTHB ROOF TOP HOSE BIB WITH VAC. BREAKER

2019CBB  
City of Madera  
Building Department  
The approval of these plans does not prevent the City of Madera from requiring correction of errors or omission of the plans, specifications or construction. Subject to field inspections and approvals, plans, codes and standards.  
APPROVED  
By: [Signature]  
Date: MAR 03 2022



LICENSE: #1080711  
ADDRESS: 8405 E. HAMPTON WAY  
FRESNO, CA 93727  
CELL: (559) 739-8985  
EMAIL: Tony@gtplumbing.com



WHSE  
PARTNERS

REVISION  
CITY OF MADERA PLAN CHECK CORRECTION  
DATE 11/1/2021  
SEAL  
ANY INFORMATION OR DATA ON THIS DRAWING IS NOT INTENDED TO BE SUITABLE FOR REUSE BY ANY PERSON, IN ANY FORM OR BY ANY MEANS, WITHOUT THE WRITTEN PERMISSION OF THE ENGINEER FOR THE SPECIFIC PROJECT. ANY REUSE WITHOUT WRITTEN VERIFICATION AND ADAPTATION BY THE ENGINEER FOR THE SPECIFIC PURPOSE INTENDED WILL BE AT THE USER'S SOLE RISK AND WITHOUT LIABILITY OR LEGAL EXPOSURE TO THE ENGINEER.

BLDG. B PLUMBING PLAN  
FOR  
LEASE FLEX. / WAREHOUSE BUILDINGS  
MADERA INDUSTRIAL WHSE, LLC  
345 S. SCHNOOR AVENUE, MADERA, CA

JOB NUMBER: 21107  
DESIGNED BY: Designer  
DRAWN BY: Author  
DATE: 4/27/2021  
SHEET NUMBER: P-3.0B











1.	Project Address - 325, 345, 335, & 355 S. Schnoor Ave.	
2.	Occupancy Group - S1 / B Sprinklered	
3.	Square Footage of Buildings	
	Building "A" - 325 S. Schnoor Ave.,	37,500 S.F.
	Building "B" - 345 S. Schnoor Ave.	37,500 S.F.
	Building "C" - 335 S. Schnoor Ave.	35,100 S.F.
	Building "D" - 355 S. Schnoor Ave.	35,100 S.F.
	<b>Total S.F.</b>	<b>145,200 S.F.</b>

1. ALL INSTALLATION SHALL BE PER N F P A 13, 2016 EDITION.
2. ALL MATERIALS & INSTALLATIONS OF THIS AUTOMATIC FIRE SPRINKLER SYSTEM TO CONFORM TO N F P A 13 SHALL BE PROVIDED BY THE FIRE PREVENTION HAVING AUTHORITY.
3. EARTHQUAKE BRACING TO BE PER N F P A STANDARD.
4. PROVIDE SPARE HEAD CABINET WITH SPARE HEADS AND WRENCH
5. LOW POINTS SHALL BE INSTALLED TO PREVENT AIR LOCKS
6. SYSTEM SHALL BE HYDROSTATIC TESTED @ 200 P.S.I. FOR 2 HOURS.
7. PIPE SIZES PER HYDROCALCULATION
8. FIRE DEPT CONNECTION SHALL BE COMPATIBLE WITH LOCAL FIRE DEPARTMENT.
9. THREADED PIPING USED 1" TO 2" TO BE EDDY THREAD STEEL WITH THREADED ENDS & DUCTILE IRON FLANGES
10. WELDED PIPES USED TO BE EDDY FLOW WITH GROOVED ENDS.
11. INSTALL PROPER SIGNAGE AS REQUIRED BY N F P A 13.
12. OUTSIDE BELT TO HAVE 8" MIN EMERGENCY STOP
13. 24 HOUR SUPERVISION TO BE PROVIDED BY OTHERS.
14. ALL ELECTRICAL WORK BY OTHERS
15. FIRE ALARMS AND MANUAL PULL STATIONS BY OTHERS.
16. FIRE ALARM DRAWINGS SHALL BE BY OTHERS.
17. ALL PAINTING BY OTHERS.
18. UNDERGROUND SHALL BE FLUSHED BY THE INSTALLING CONTRACTOR AND WRITTEN DOCUMENTATION PRIOR TO THE START OF THE SYSTEM.
19. ALL INVOLVERS TO BE 1" UNLESS NOTED OTHERWISE
20. STORAGE INSTALLED TO 12 FEET WITH MINIMUM 18 INCHES FROM PENDENT SPRINKLER
21. FROM TOP OF CURB TO TOP OF SPRINKLER
22. IT IS THE CONTRACTOR'S RESPONSIBILITY TO MAKE WORK AVAILABLE FOR INSPECTIONS
23. A COPY OF THE PERMANENT AND DURABLE GENERAL INFORMATION SIGN TO BE DISPLAYED PER N F P A 13 SECTION 25.6 SHALL BE PROVIDED TO THE PERMANENT AND DURABLE GENERAL INFORMATION SIGN PER N F P A 13, SECTION 25.6 SHALL BE INSTALLED IN ADDITION TO THE INFORMATION SIGN INFORMATION
24. AN APPROVED PLAN SET SHALL BE ON SITE DURING ANY FIRE DEPARTMENT INSPECTION
25. MECHANICAL TEES TEES SHALL HAVE COUPON HUNG WITHIN 6 INCHES OF TEE
26. COUPON HUNG WITHIN 6 INCHES OF TEE
27. (3) WHERE FLEXIBLE COUPLINGS OR OTHER EASILY SEPARATED CONNECTIONS ARE USED AN NFP 13 AND CAP OR PLUG SHALL BE INSTALLED
28. THE BACK LOGS ON THIS PROJECT HAS 3.69 GALLONS TRAPPED

UNDERGROUND PIPING BY UNDERGROUND CONTRACTOR AND NOT PART OF THIS SUBMITTAL. ALL UNDERGROUND SHOWN ON THIS PLAN IS FOR REFERENCE ONLY.	
1. ALL MATERIALS & INSTALLATIONS TO BE U.L. LISTED & SHALL CONFIRM TO NFPA PAMPHLETS 13 & 24, 2016 EDITION	
2. THURST BLOCKS TO CONFIRM TO NFPA 24	
3. ALL WATER LINES FOR FIRE SPRINKLER SYSTEM SHALL BE TESTED AT 200 P.S.I. FOR 2 HRS.	
4. MINIMUM	
5. DUCTILE IRON PIPE SHALL BE USED WHEN FIRE PASSES UNDER BUILDING FOUNDATION, UNDER FOOTING.	
6. PLASTIC PIPE SHALL BE 8" O.D. DR-18/CLASS 150.	
7. UNDERGROUND SHALL BE FLUSHED PER NFPA 24 BEFORE CONNECTING TO OVERHEAD FIRE SPRINKLER SYSTEM PIPING.	
8. NOT USED.	

SHEET	DISCRPTION
FP-1	GENERAL NOTES, RISER, HANGER AND BRACING DETAILS
FP-2	SITE, UNDERGROUND PIPING & CROOS SECTION PLAN
FP-3	BLDG. A PIPING PLAN
FP-4	BLDG. B PIPING PLAN
FP-5	BLDG. C PIPING PLAN
FP-6	BLDG. D PIPING PLAN




N.T.S.

2019CBC  
City of Madera  
Building Department  
The approval of these plans does not prevent the City of Madera from requiring correction of errors or omissions in the plans, specifications or construction. Subject to field inspection, codes and approvals. Codes and Approvals  
APPROVED  
By: [Signature]  
Date: JAN 05 2022

NC. JOB COPY

**FP-1**  
OF 6 SHEETS

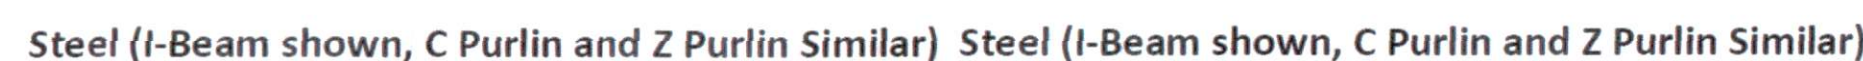

REMOTE AREA #2 BUILDING "B"	
COMPANY PRINT NO. <u>FP-3</u>	DATED <u>11/19/2021</u>
FOR <u>MADES INDUSTRIAL WAREHOUSE BLDG. A, B, C, &amp; D</u>	
AT <u>345 S. SCHINOOR AVE.</u>	CONTRACT NO. <u>21016</u>
IS DESIGNED TO DISCHARGE AT A RATE OF <u>20</u> GPM	
(L/min) PER SQFT (m <sup>2</sup> ) OF FLOOR AREA OVER A MAXIMUM AREA OF <u>1585.90</u>	
<u>343.93</u> GPM (L/min) AT <u>47.73</u> PSI (bars) AT THE BASE OF THE RISE	
HOSE STREAM ALLOWANCE OF <u>250</u>	GPM (L/min)
IS INCLUDED IN THE ABOVE.	
OCCUPANCY CLASSIFICATION	<u>S1 / B - SPRINKLERED</u>
COMMODITY CLASSIFICATION	<u>CLASS I - IV</u>
MAXIMUM STORAGE HEIGHT	<u>12'-0" FT.</u>
MAX. COVERAGE PER HEAD	<u>121.88 SQ. FT.</u>
INSTALLED BY SAN JOAQUIN FIRE PROTECTION, INC.	

REMOTE AREA #4 BUILDING "D"	
COMPANY PRINT NO.	FP-3 DATED 11/13/2021
FOR: <b>MADEIRA INDUSTRIAL WAREHOUSE BLDG. A, B, C &amp; D</b>	
AT 555 S. SCHNOOR AVE.	CONTRACT NO. 21016
IS DESIGNED TO DISCHARGE AT A RATE OF 20 GPM	
(L/min) PER SQFT (m <sup>2</sup> ) OF FLOOR AREA OVER A MAXIMUM AREA OF	
1555.90	
250.27 GPM (L/min) AT 71.761 PSI (bars) AT THE BASE OF THE RISE	
HOSE STREAM ALLOWANCE OF 250 GPM (L/min)	
IS INCLUDED IN THE ABOVE:	
OCCUPANCY CLASSIFICATION	CLASS 1 - B - SPRINKLERED
COMMODITY CLASSIFICATION	CLASS - I - V
MAXIMUM STORAGE HEIGHT	12'-0 FT
MAX. COVERAGE PER HEAD	121.68 SQ. FT.



SCALE 1/4" = 1'-0"

1. 6" FIRE LINE STUB-UP
2. 2" ANNUAL CLEARANCE
3. ASPHALT
4. 6 X 4 RED. WELD FLANGE FLG.
5. 4" FLEX COUPLING
6. MAIN DRAIN BRACE
7. GRV. BUTTERFLY VALVE W/TEMPERATURE SWITCH
8. 4" GRV. SHOT-GUN CHECK VALVE
9. ASSY. (TO PREVENT FDC BACK FLOW)
10. PSI GAUGE-ASSY.
11. 1/2" RELIEF VALVE
12. 2" MAIN DRAIN VALVE
13. 4" FDC LINE
14. 4" FLOW SWITCH
14. ELECT. BELL
15. 4-WAY BRACE (ATTACHED TO CURB INSIDE OF BUILDING)
16. SPARE HEAD BOX (IN RISER ROOM)
17. 4" FDC LINE (UNDERGROUND PLAN)
18. 4" WELD FLANGE
19. 4" GRV. CHECK VALVE (FDC LINE)




[illegible]

5957 E. HARVARD AVE. FRESNO, CA. 93727  
PH. (559) 292-7111 FAX (559) 292-7211 CA. LIC. 775461

DESCRIPTION: GENERAL NOTES, RISER, HANGER AND BRACING DETAILS		
Job No.	21016	<b>MADERA INDUSTRIAL</b> 325, 335, 345, & 355 S. SCHNOOR AVE. MADERA, CA. 93637
Date	11/13/2021	
Engr.	GREGG S.	
Scale	1/8" = 1'-0"	
		<b>FP-1</b> OF 6 SHEET



BOLLARD PROT.

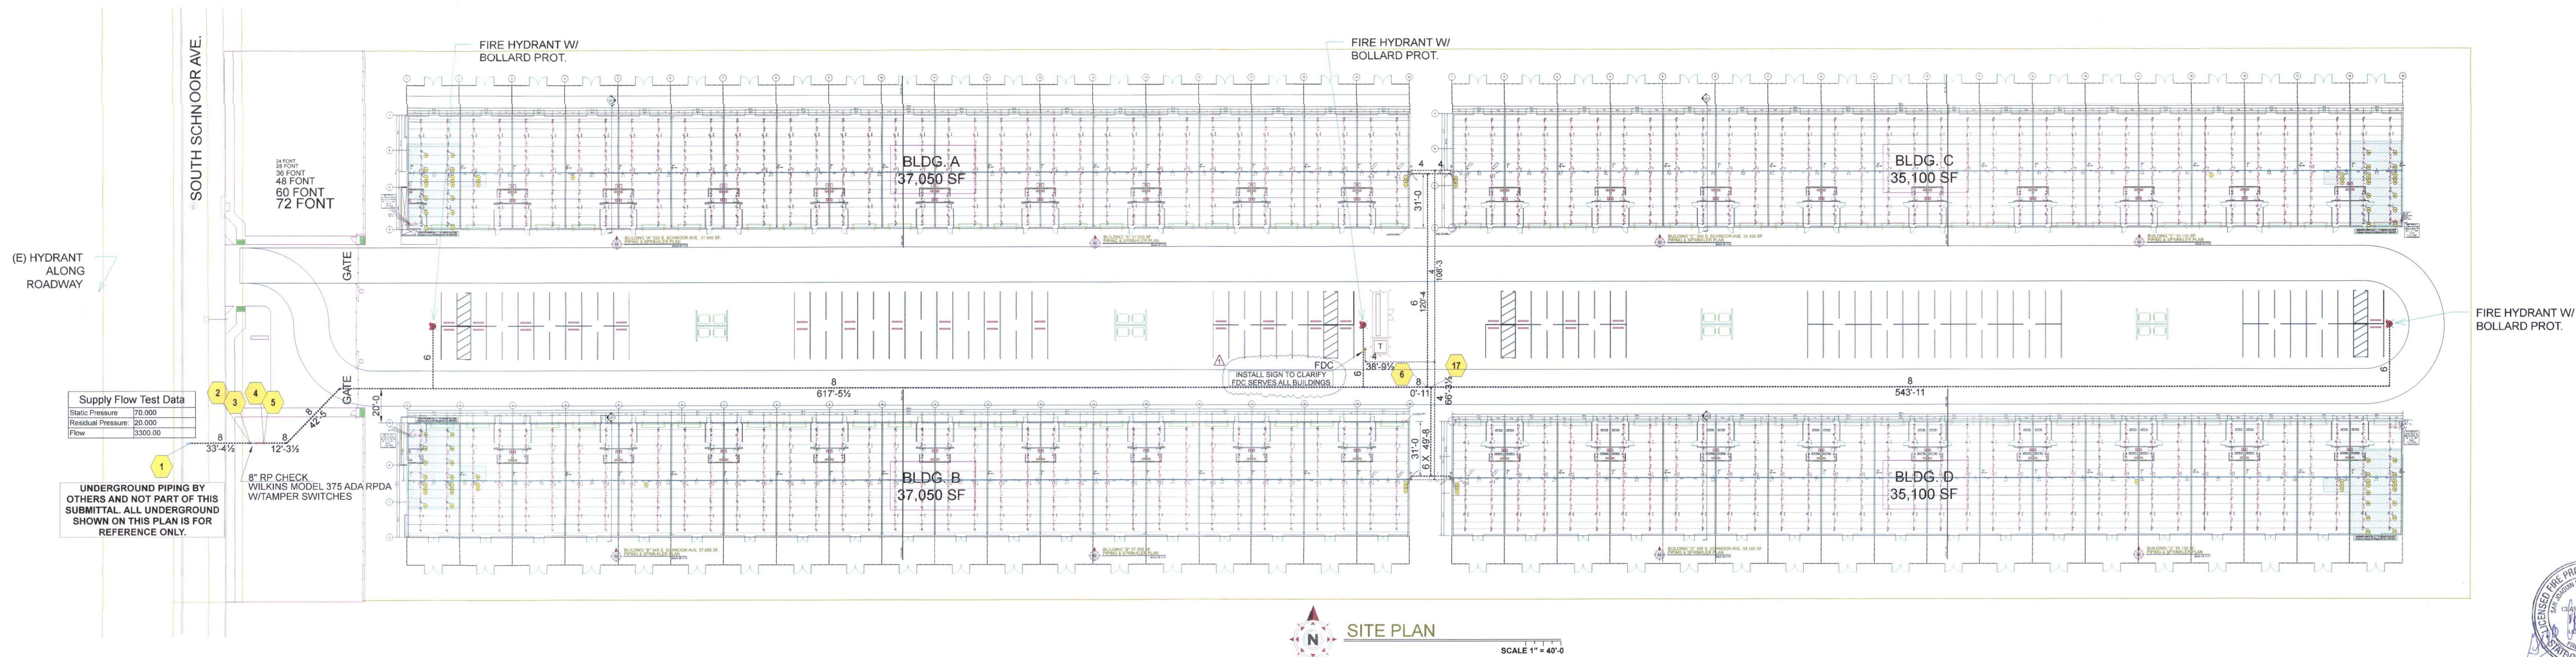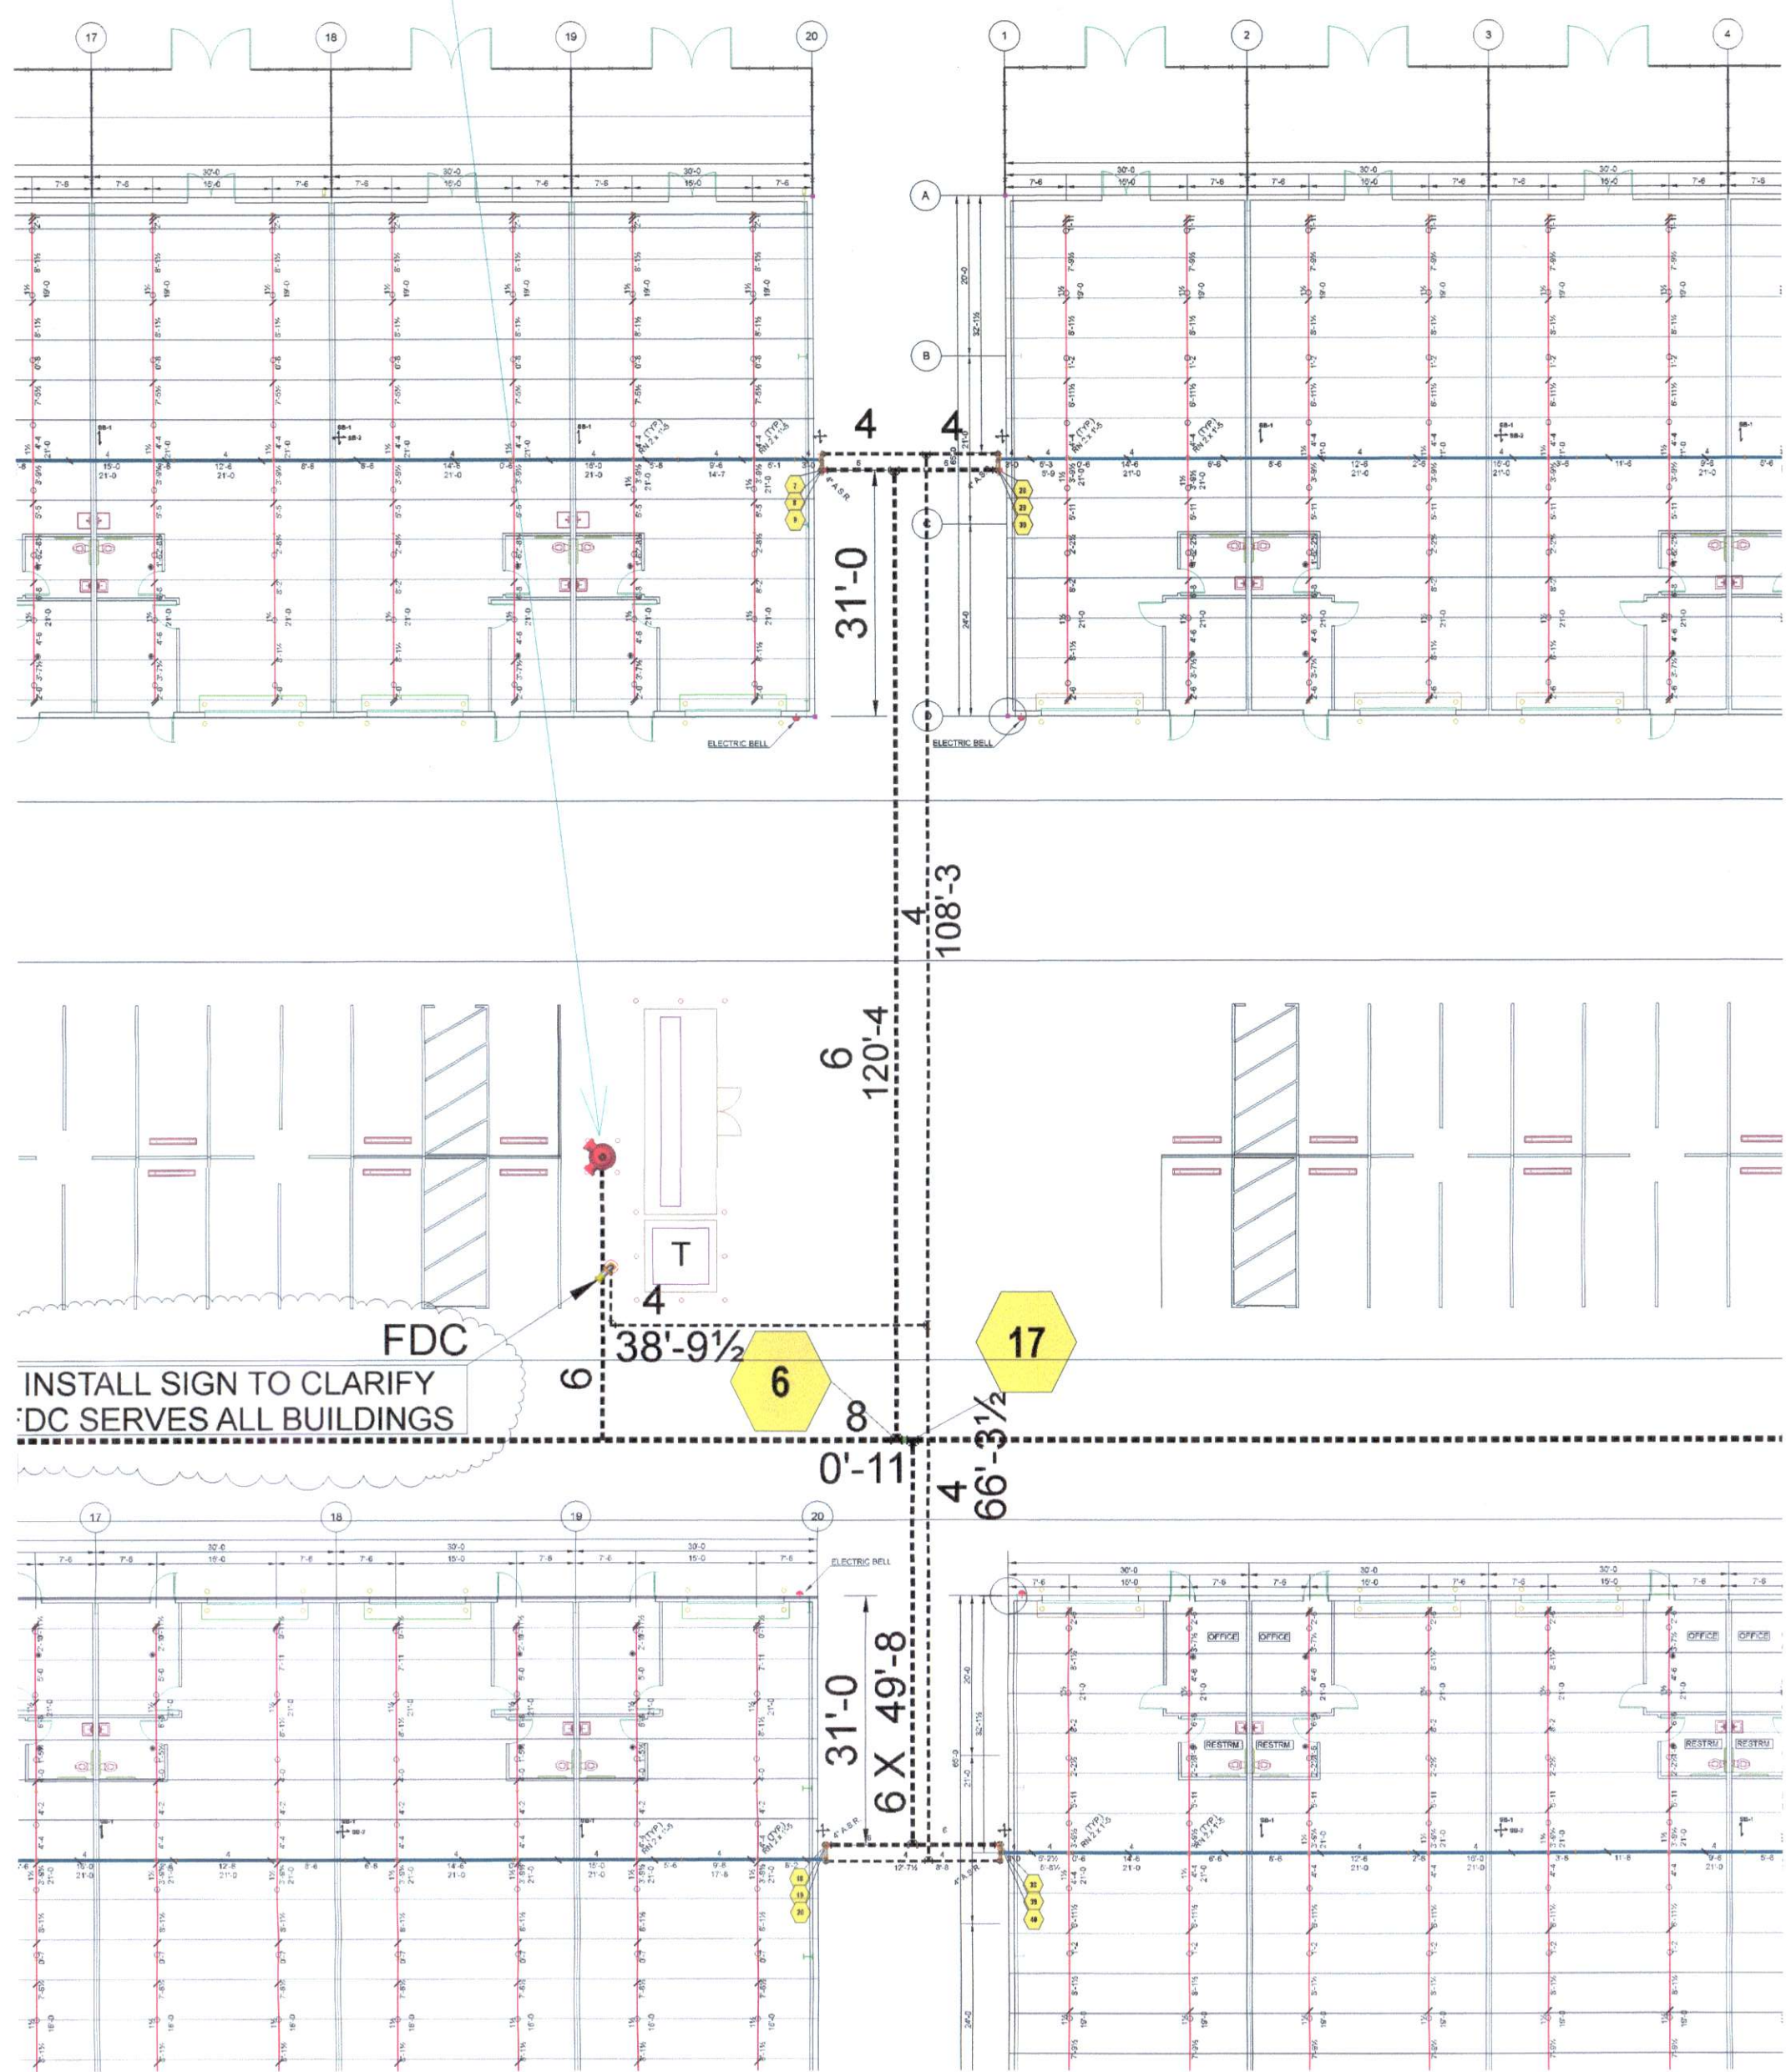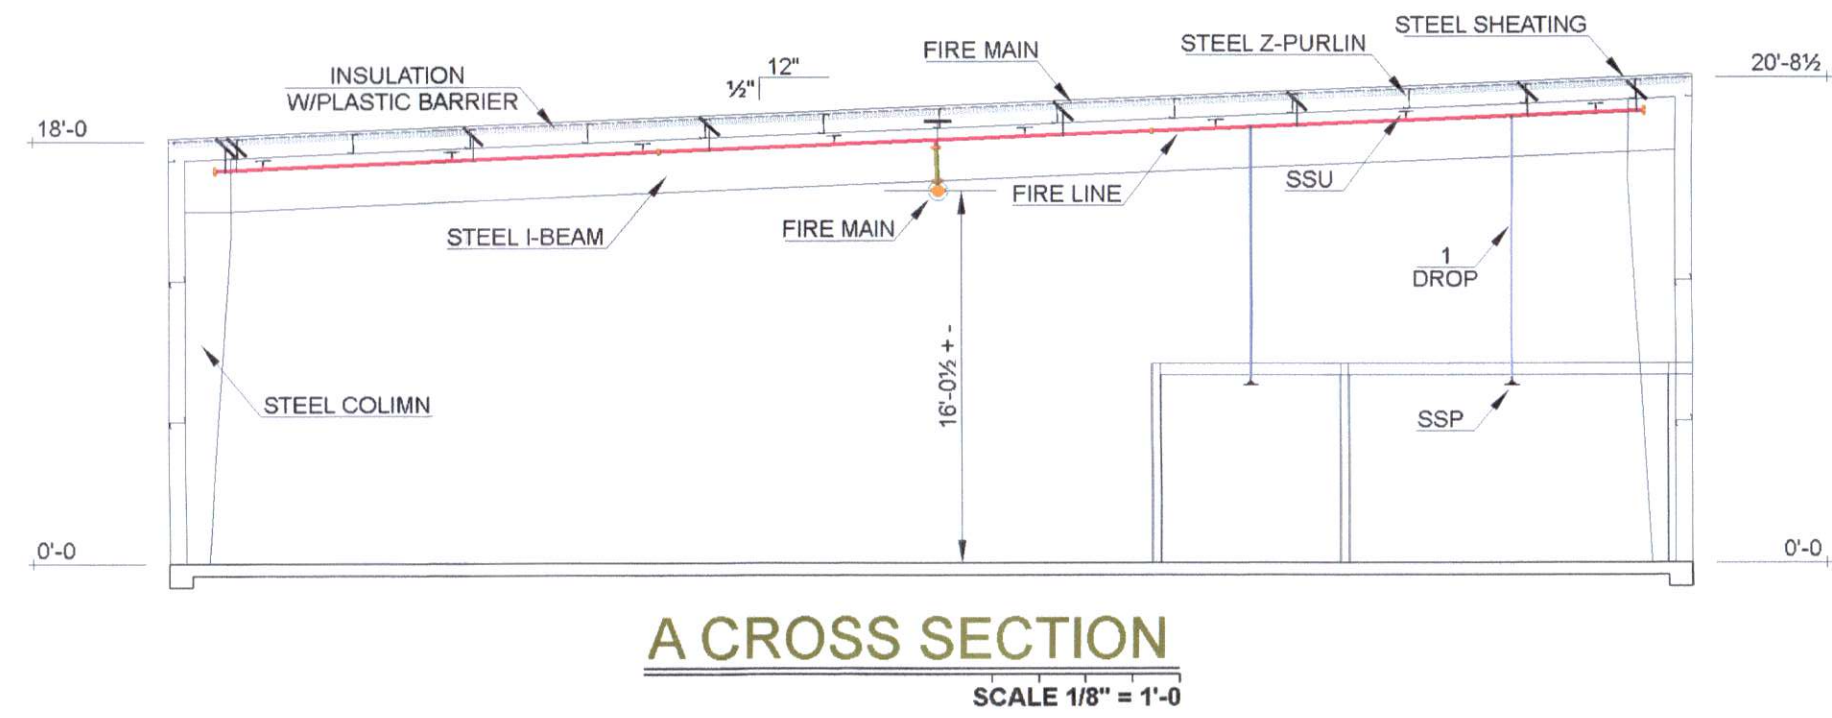

Supply Flow Test Data

Static Pressure	70.000
Residual Pressure	20.000
Flow	5300.00

UNDERGROUND PIPING BY OTHERS AND NOT PART OF THIS SUBMITTAL. ALL UNDERGROUND SHOWN ON THIS PLAN IS FOR REFERENCE ONLY.

THESE DRAWINGS, SPECIFICATIONS, THE IDEAS, DESIGNS, AND ARRANGEMENTS REPRESENTED THEREBY ARE AND SHALL REMAIN THE PROPERTY OF SAN JOAQUIN FIRE PROTECTION, INC. AND NO PART THEREOF SHALL BE COPIED, DISCLOSED TO OTHERS, OR USED IN CONNECTION WITH ANY OTHER WORK OR PROJECT OTHER THAN THE SPECIFIC PROJECT FOR WHICH THEY HAVE BEEN PREPARED AND DEVELOPED WITHOUT THE WRITTEN CONSENT OF SAN JOAQUIN FIRE PROTECTION, INC. VISUAL CONTACT WITH THESE DRAWINGS OR SPECIFICATIONS SHALL CONSTITUTE CONCLUSIVE EVIDENCE OF THESE RESTRICTIONS.

Revisions	Symbols	Symbols	Sprinkler Head Symbols	Sprinkler Head Type & Count
12/03/21 FIRE DEPT COMMENTS	Hanger Location Lateral Brace Longitudinal Brace Four Way Brace Hydraulic Refs. Points Thrust Block	Backflow Preventer Key Operated Valve Post Indicator Valve Check Valve Fire Dept. Connection Hose Valve Hose Station	Pendent on Drop Pendent on Drop w/401 Escutcheon Upright & Pendent on 1" Tee Upright on Outlet Upright on Tee or Cross With 1" Plug Upright on Sprig Up With Tee & 1" Plug Upright on Sprig Up Sidewall on Outlet	Sym. Quantity Manufacturer Model Response K-Factor Orifice Size Type Temp. Finish Escutcheon / Finish
				NO SPRINKLERS THIS SHEET

**SAN JOAQUIN FIRE PROTECTION, INC.**  
5957 E. HARVARD AVE. FRESNO, CA. 93727  
PH. (559) 292-7111 FAX (559) 292-7211 CA. LIC. 775461

**DESCRIPTION: SITE, UNDERGROUND PIPING & CROSS SECTION PLAN**



Job No.	21016
Date	11/13/2021
Engr.	GREG S.
Scale	SEE PLAN

2019CBC  
City of Madera  
Building Department  
The approval of these plans does not prevent the City of Madera from requiring correction of errors or omissions in the plans, specifications or construction. Subject to field inspections and approvals by codes and ordinances.

**APPROVED**  
By: *[Signature]*  
Date: JAN 05 2022

**FP-2**  
OF 6 SHEET



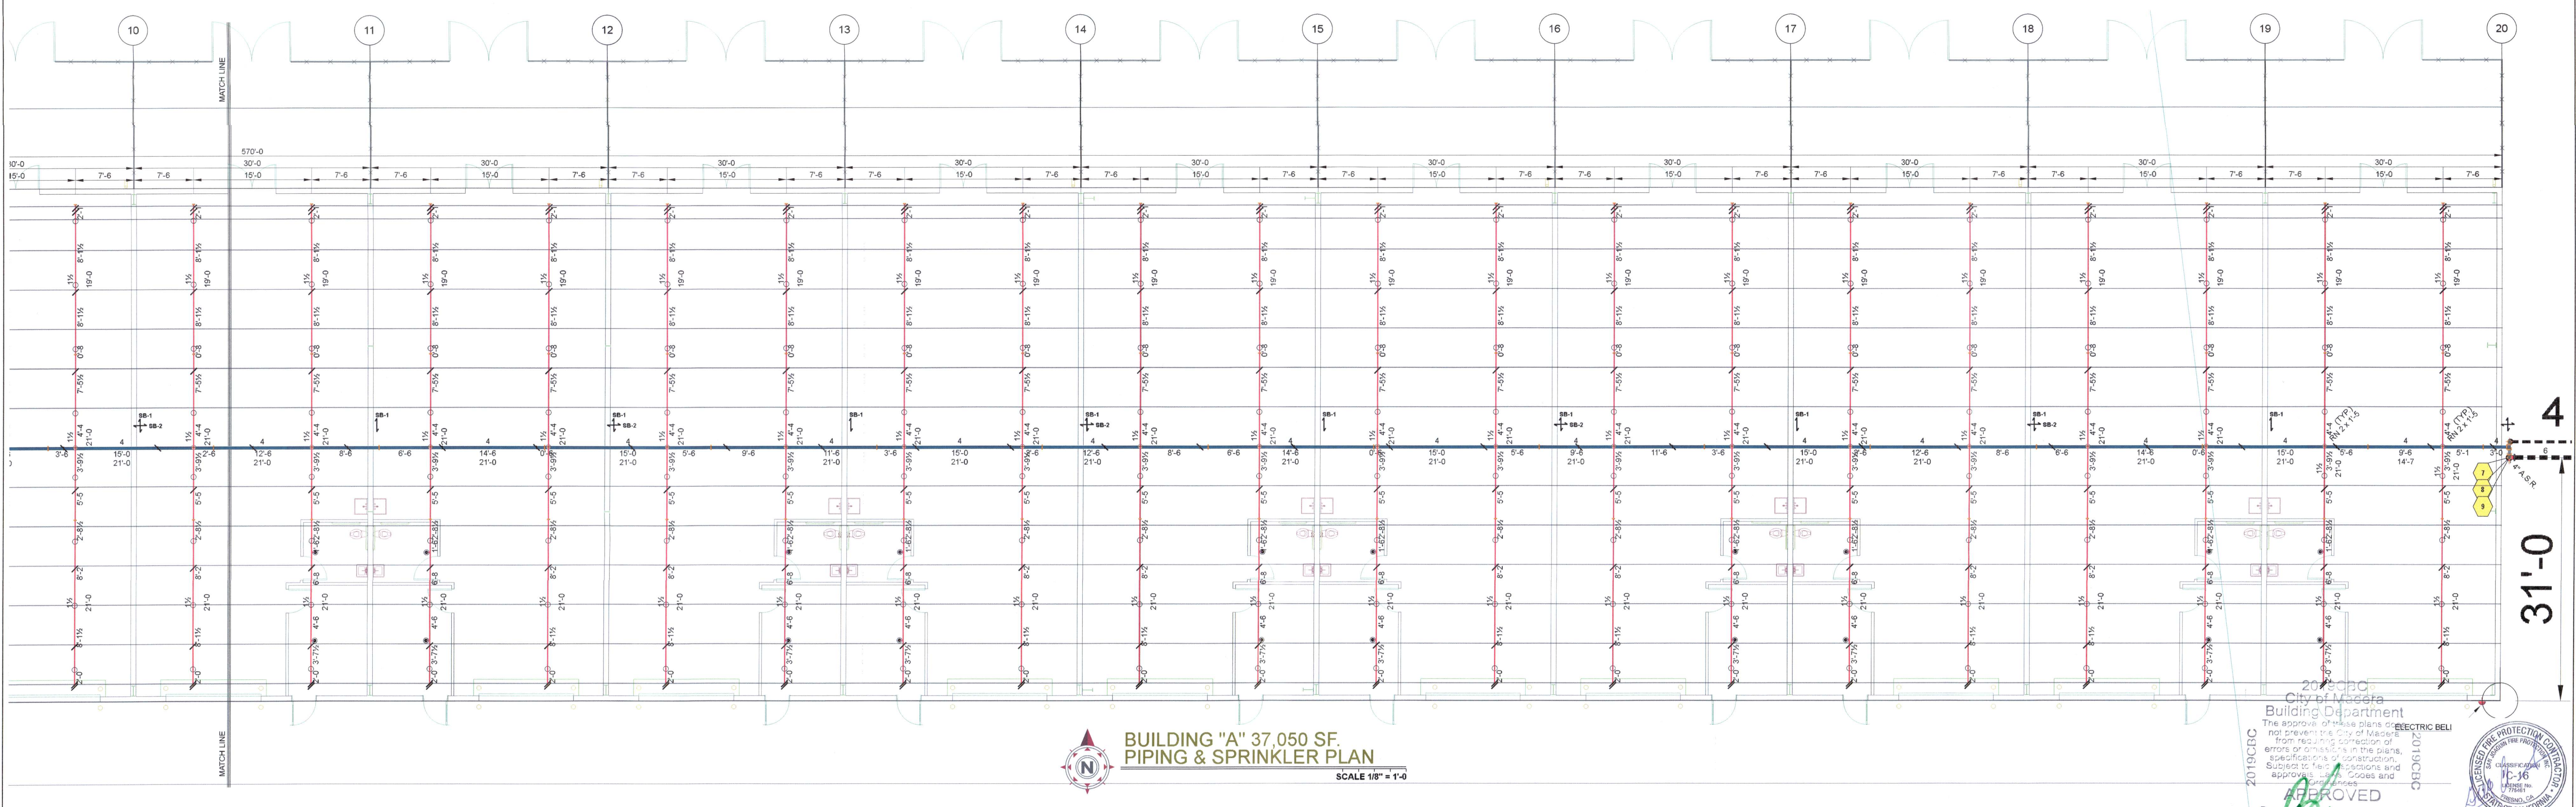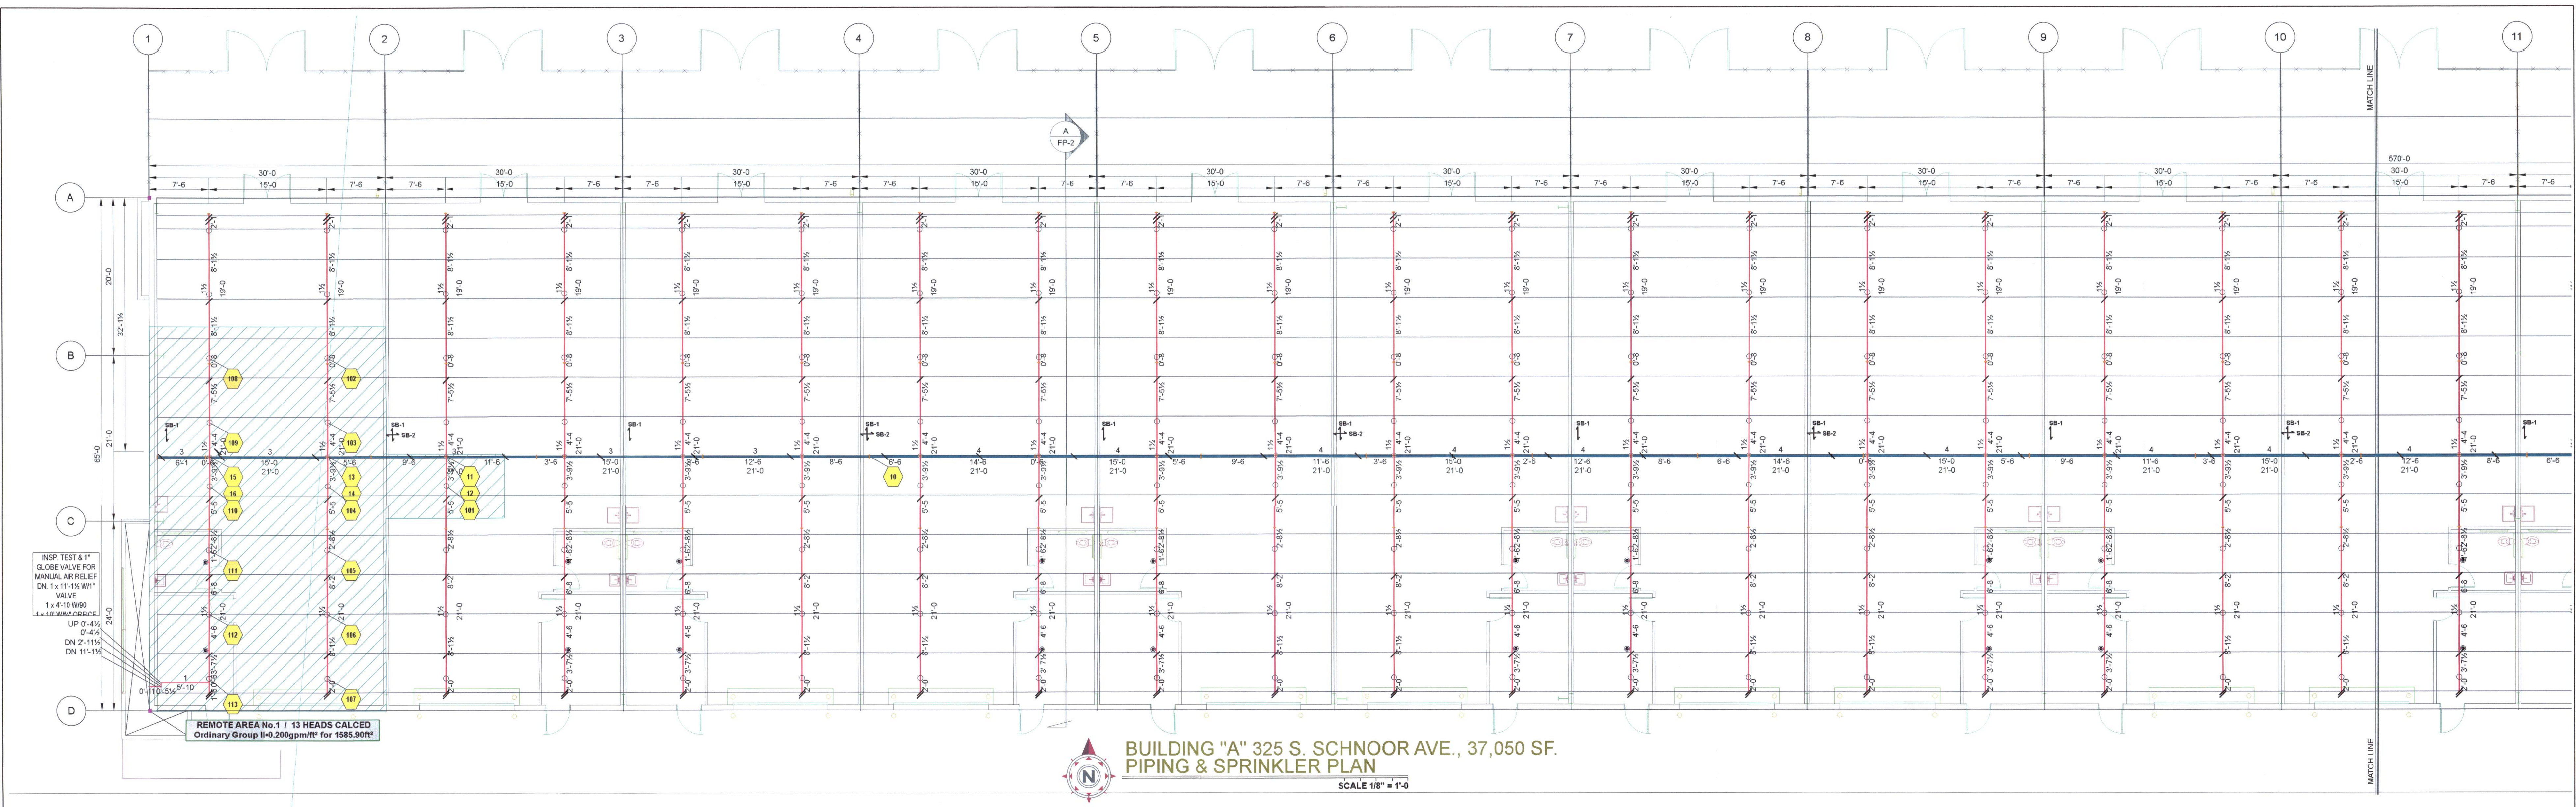

THESE DRAWINGS, SPECIFICATIONS, THE IDEAS, DESIGNS, AND ARRANGEMENTS REPRESENTED THEREBY ARE AND SHALL REMAIN THE PROPERTY OF SAN JOAQUIN FIRE PROTECTION, INC. AND NO PART THEREOF SHALL BE COPIED, DISCLOSED TO OTHERS, OR USED IN CONNECTION WITH ANY OTHER WORK OR PROJECT OTHER THAN THE SPECIFIC PROJECT FOR WHICH THEY HAVE BEEN PREPARED AND DEVELOPED WITHOUT THE WRITTEN CONSENT OF SAN JOAQUIN FIRE PROTECTION, INC. VISUAL CONTACT WITH THESE DRAWINGS OR SPECIFICATIONS SHALL CONSTITUTE CONCLUSIVE EVIDENCE OF THESE RESTRICTIONS.

Revisions
12/03/21 FIRE DEPT. COMMENTS

Symbols
Hanger Location
Lateral Brace
Longitudinal Brace
Four Way Brace
Hydraulic Refs. Points
Thrust Block

Symbols
Backflow Preventer
Key Operated Valve
Post Indicator Valve
Check Valve
Fire Dept. Connection
Hose Valve
Hose Station

Sprinkler Head Symbols
Pendent on Drop
Pendent on Drop w/401 Escutcheon
Upright & Pendent on 1" Tee
Upright on Outlet
Upright on Tee or Cross With 1" Plug
Upright on Sprig Up With Tee & 1" Plug
Upright on Sprig Up
Sidewall on Outlet

Sprinkler Head Type & Count						
Response	K-Factor	Orifice Size	Type	Temp.	Finish	Escutcheon / Finish
Standard	8.0	3/4"	Upright	200°F	Brass	None
Standard	8.0	3/4"	Pendent	155°F	Chrome	401 Adjustable / Chrome

**SAN JOAQUIN FIRE PROTECTION, INC.**  
 5957 E. HARVARD AVE. FRESNO, CA. 93727  
 PH. (559) 292-7111 FAX (559) 292-7211 CA. LIC. 775461



DESCRIPTION: BUILDING "A" SPRINKLER PIPING, & CALCULATION PLAN

Job No. 21016  
 Date 11/13/2021  
 Engr. GREG S.  
 Scale 1/8" = 1'-0"

MADERA INDUSTRIAL  
 325, 335, 345, & 355 S. SCHNOOR AVE.  
 MADERA, CA. 93637

**FP-3**  
 OF 6 SHEET



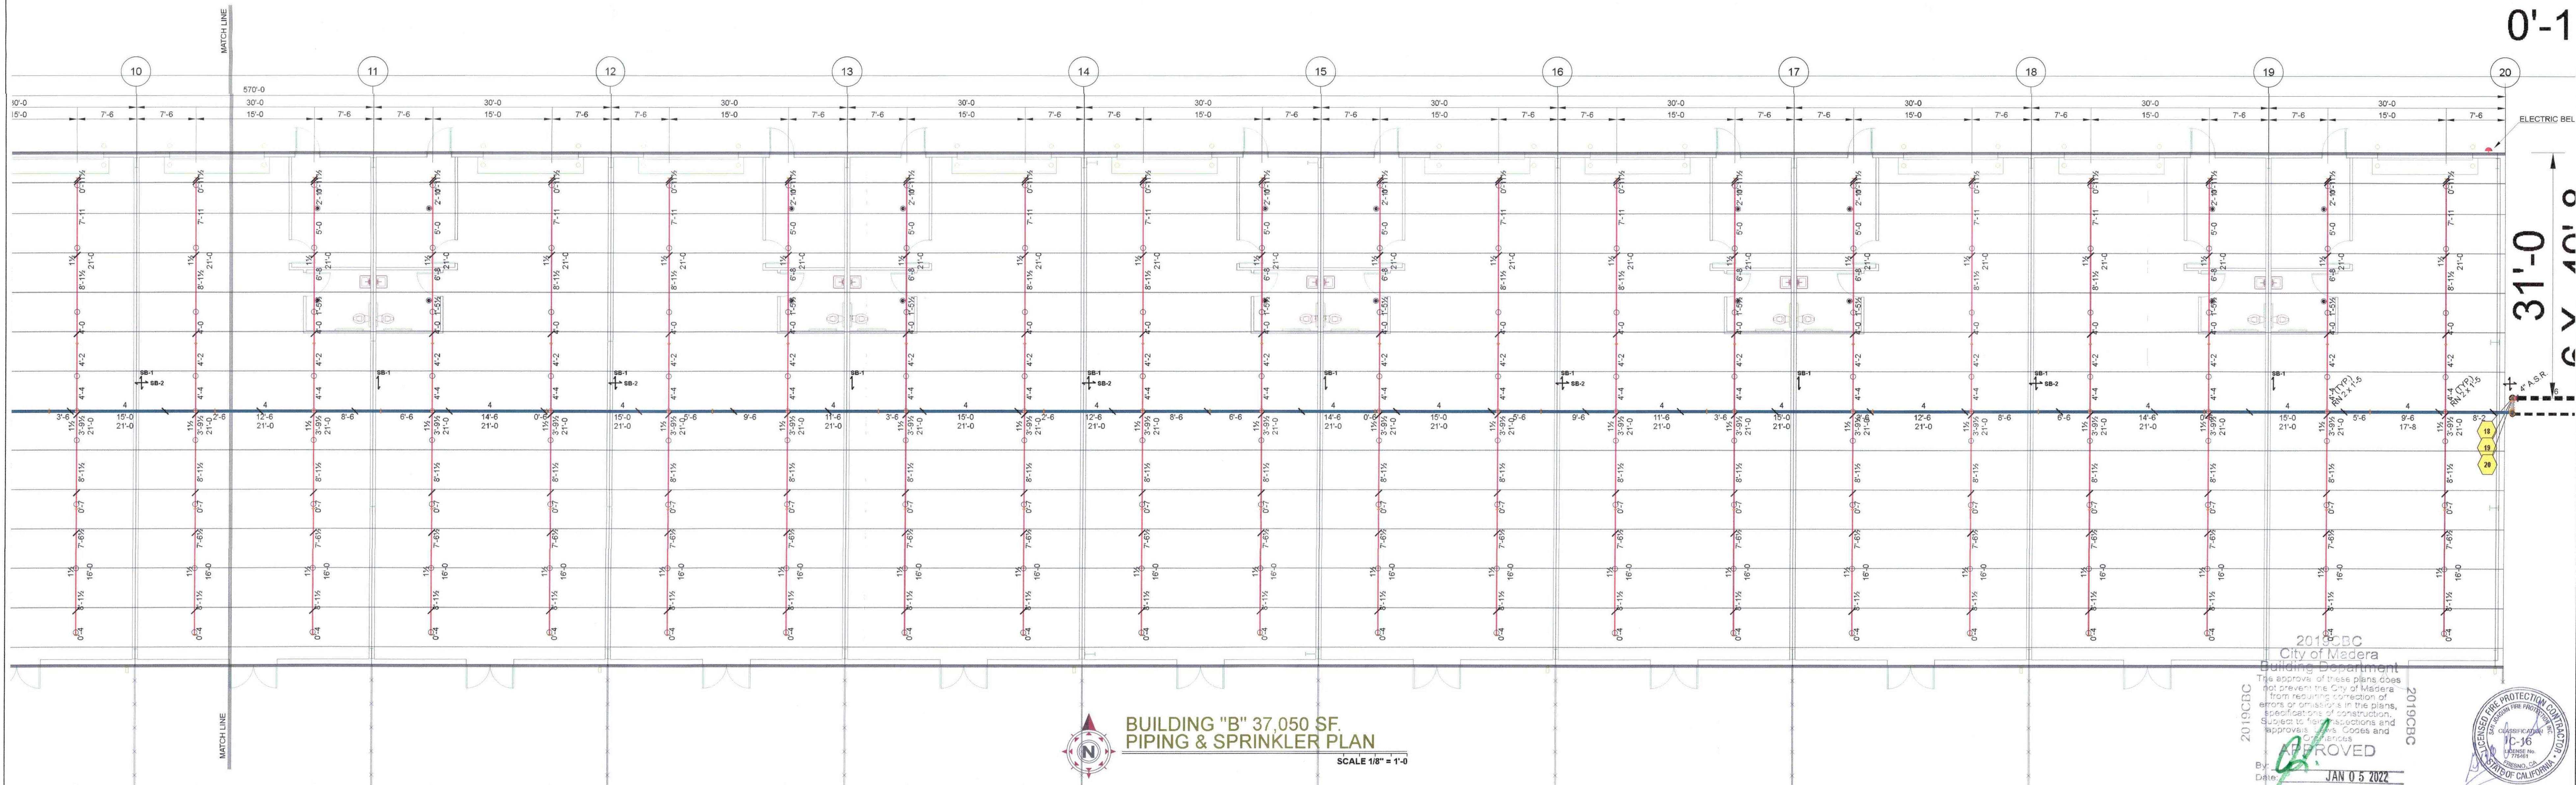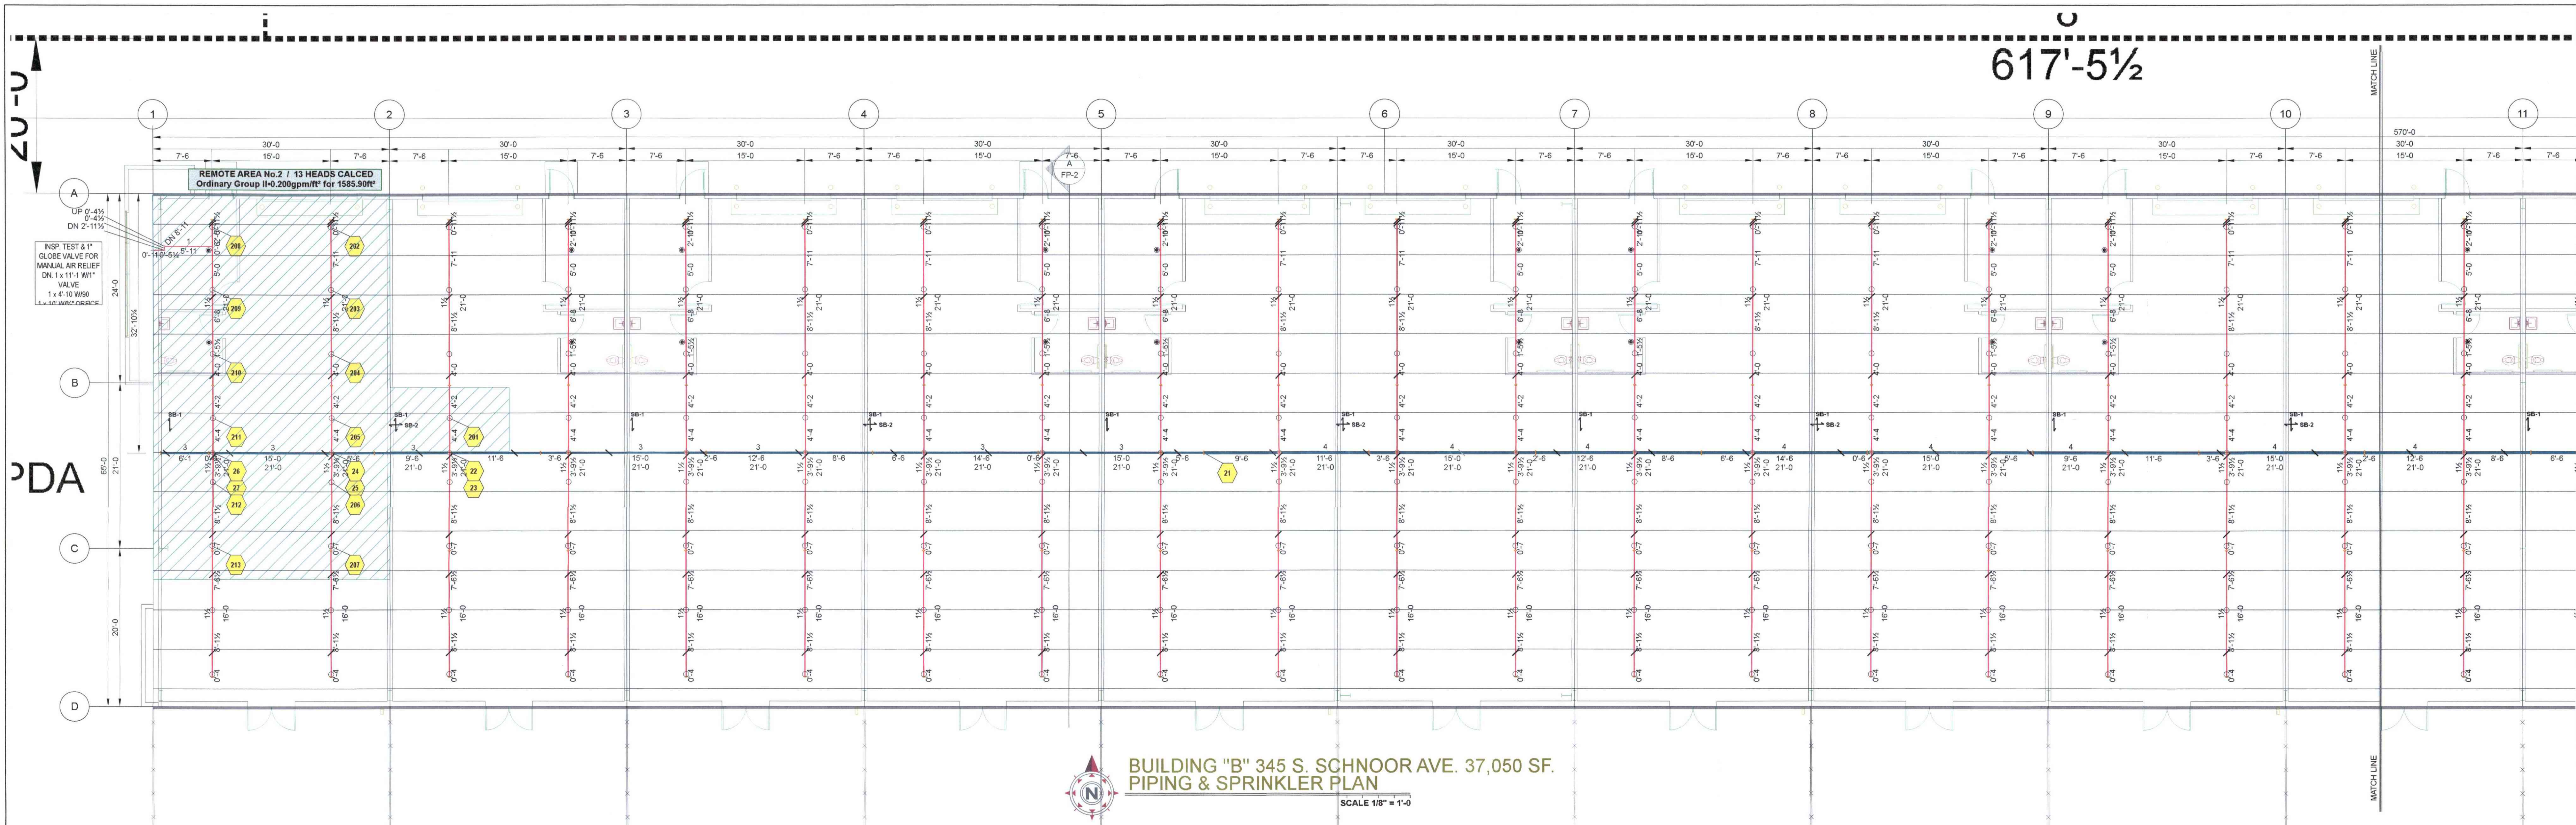

THESE DRAWINGS, SPECIFICATIONS, THE IDEAS, DESIGNS, AND ARRANGEMENTS REPRESENTED THEREBY ARE AND SHALL REMAIN THE PROPERTY OF SAN JOAQUIN FIRE PROTECTION, INC. AND NO PART THEREOF SHALL BE COPIED, DISCLOSED TO OTHERS, OR USED IN CONNECTION WITH ANY OTHER WORK OR PROJECT OTHER THAN THE SPECIFIC PROJECT FOR WHICH THEY HAVE BEEN PREPARED AND DEVELOPED WITHOUT THE WRITTEN CONSENT OF SAN JOAQUIN FIRE PROTECTION, INC. VISUAL CONTACT WITH THESE DRAWINGS OR SPECIFICATIONS SHALL CONSTITUTE CONCLUSIVE EVIDENCE OF THESE RESTRICTIONS.

Revisions		Symbols		Symbols		Sprinkler Head Symbols		Sprinkler Head Type & Count									
12/03/21	FIRE DEPT. COMMENTS	—	Hanger Location	—	Backflow Preventer	●	Pendent on Drop	Sym.	Quantity	Manufacturer	Model	Response	K-Factor	Orifice Size	Type	Temp.	Finish
		—	Lateral Brace	—	Key Operated Valve	●	Pendent on Drop w/401 Escutcheon	○	304	VICTAULIC	V3401	Standard	8.0	3/4"	Upright	200°F	Brass
		—	Longitudinal Brace	—	Post Indicator Valve	●	Upright & Pendent on 1" Tee	●	38	VICTAULIC	V3405	Standard	8.0	3/4"	Pendent	155°F	Chrome
		—	Four Way Brace	—	Check Valve	○	Upright on Outlet	○	.								401 Adjustable / Chrome
		—	Hydraulic Refs. Points	—	Fire Dept. Connection	○	Upright on Tee or Cross With 1" Plug	○	.								
		—	Thrust Block	—	Hose Valve	○	Upright on Sprig Up With Tee & 1" Plug	○	.								
					Hose Station	○	Upright on Sprig Up	○	.								
						▼	Sidewall on Outlet		Total: 342								



**SAN JOAQUIN FIRE PROTECTION, INC.**  
 5957 E. HARVARD AVE. FRESNO, CA. 93727  
 PH. (558) 292-7111 FAX (558) 292-7211 CA. LIC. 77461

DISCUPTION: BUILDING "B" SPRINKLER PIPING, & CALCULATION PLAN

Job No.	21016
Date	11/13/2021
Engr.	GREG S.
Scale	1/8" = 1'-0"

**FP-4**  
OF 6 SHEET



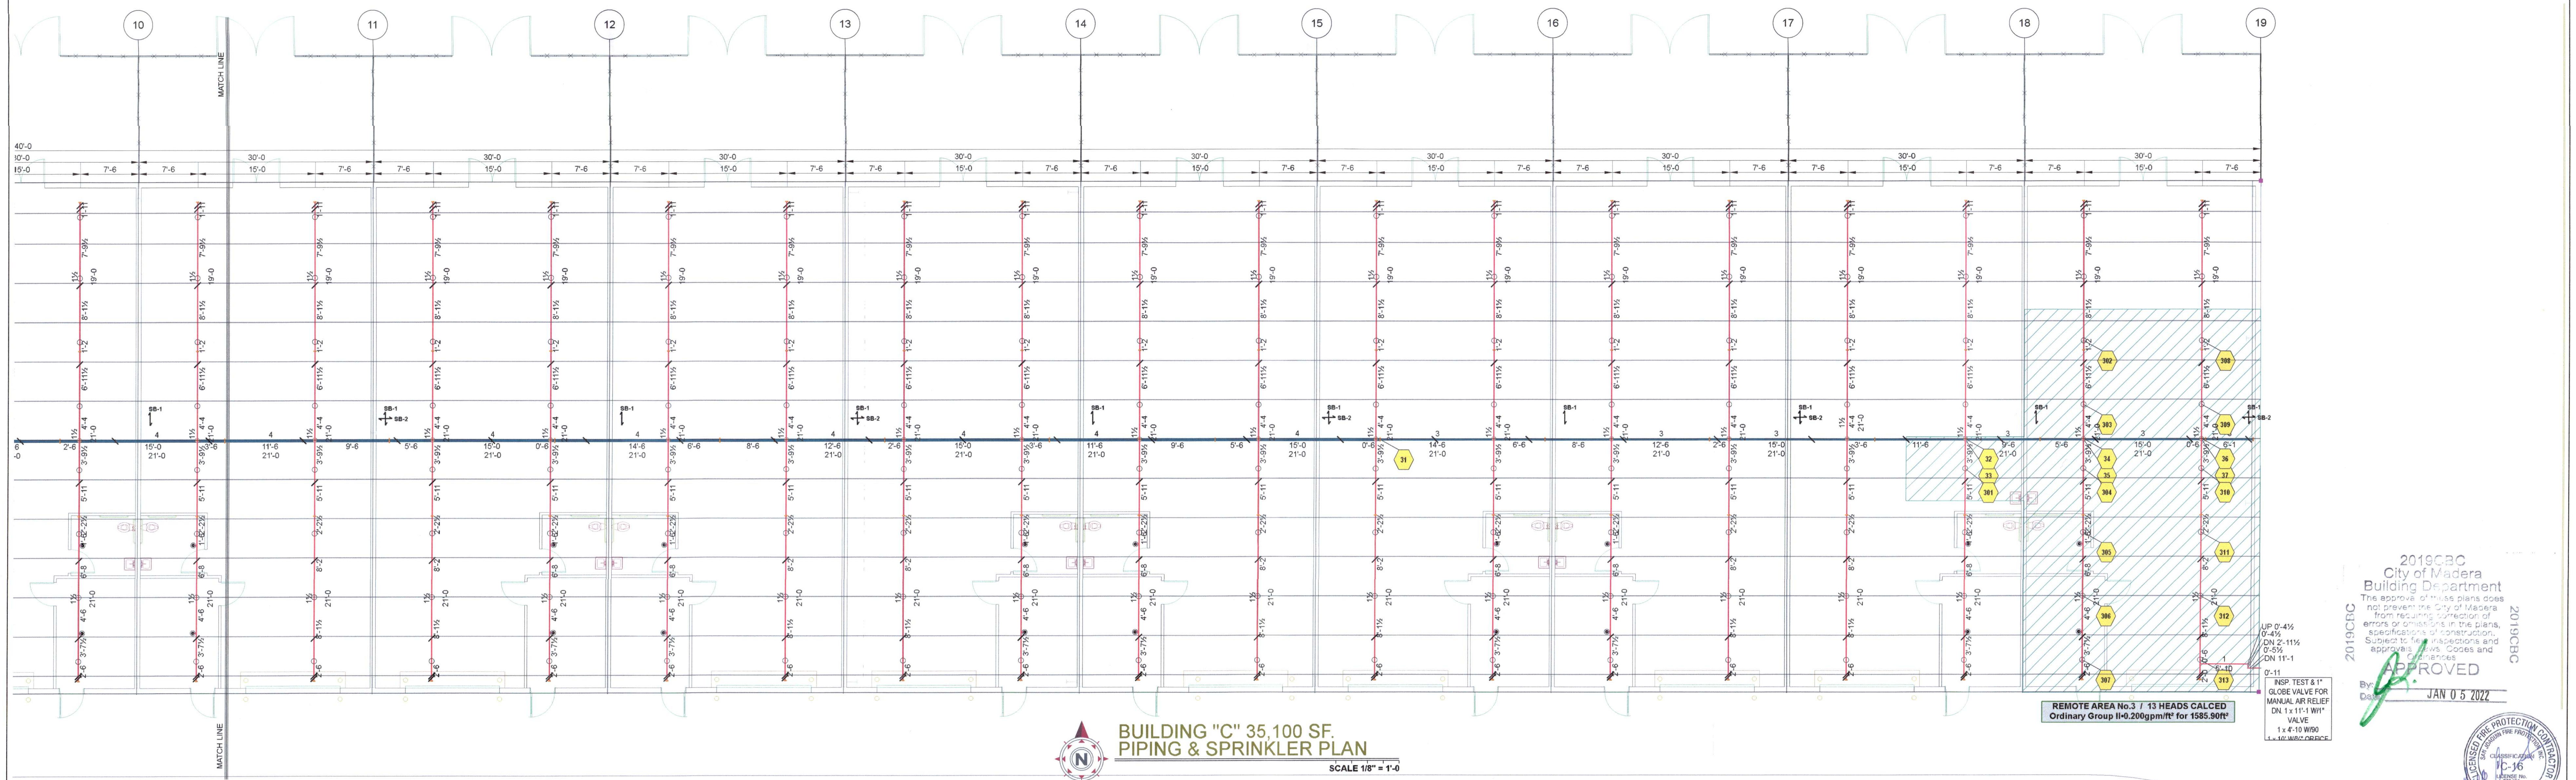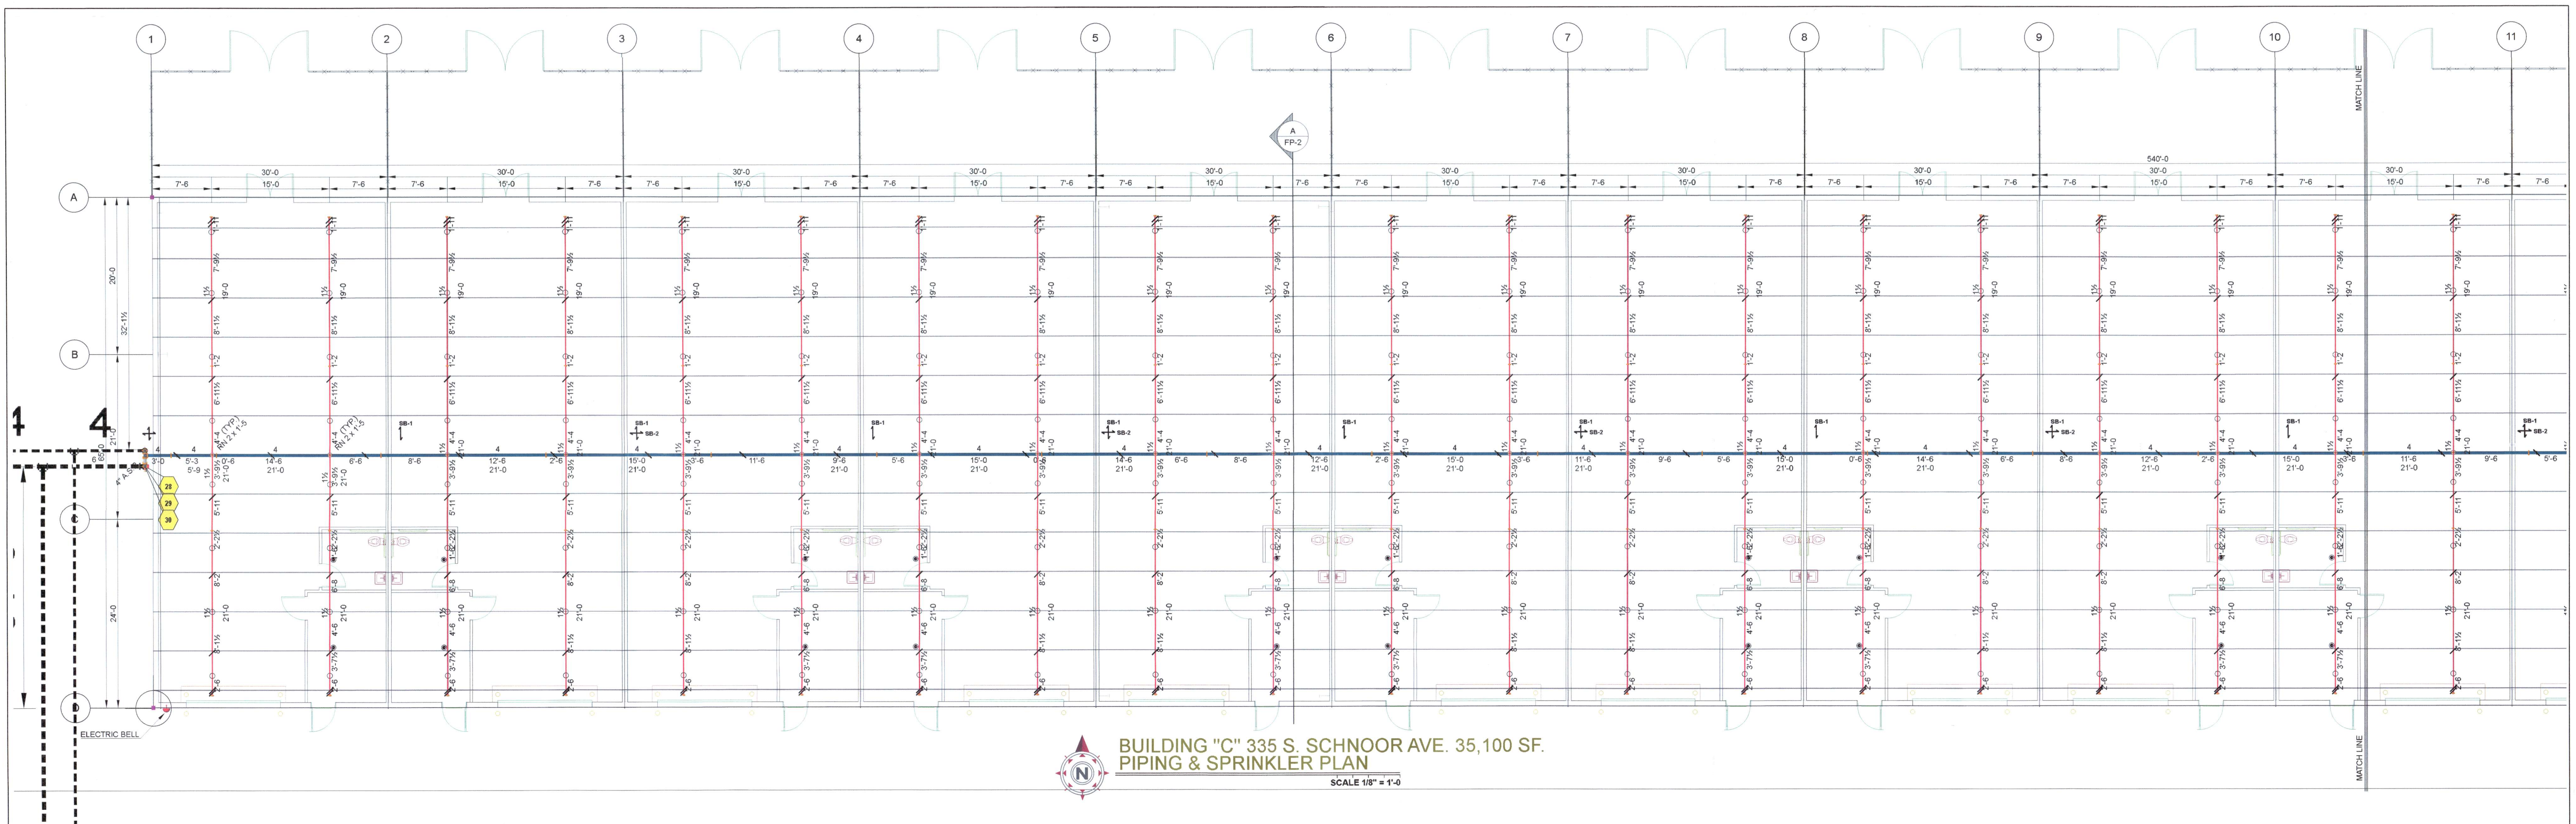

THESE DRAWINGS, SPECIFICATIONS, THE IDEAS, DESIGNS, AND ARRANGEMENTS REPRESENTED THEREBY ARE AND SHALL REMAIN THE PROPERTY OF SAN JOAQUIN FIRE PROTECTION, INC. AND NO PART THEREOF SHALL BE COPIED, DISCLOSED TO OTHERS, OR USED IN CONNECTION WITH ANY OTHER WORK OR PROJECT OTHER THAN THE SPECIFIC PROJECT FOR WHICH THEY HAVE BEEN PREPARED AND DEVELOPED WITHOUT THE WRITTEN CONSENT OF SAN JOAQUIN FIRE PROTECTION, INC. VISUAL CONTACT WITH THESE DRAWINGS OR SPECIFICATIONS SHALL CONSTITUTE CONCLUSIVE EVIDENCE OF THESE RESTRICTIONS.

Revisions
12/03/21 FIRE DEPT. COMMENTS

Symbols
Hanger Location
Lateral Brace
Longitudinal Brace
Four Way Brace
Hydraulic Refs. Points
Thrust Block

Symbols
Backflow Preventer
Key Operated Valve
Post Indicator Valve
Check Valve
Fire Dept. Connection
Hose Valve
Hose Station

Sprinkler Head Symbols
Pendent on Drop
Pendent on Drop w/401 Escutcheon
Upright & Pendent on 1" Tee
Upright on Outlet
Upright on Tee or Cross With 1" Plug
Upright on Sprig Up With Tee & 1" Plug
Upright on Sprig Up
Sidewall on Outlet

Sym.	Quantity	Manufacturer	Model	Response	K-Factor	Orifice Size	Type	Temp.	Finish	Escutcheon / Finish
○	288	VICTAULIC	V3401	Standard	8.0	3/4"	Upright	200°F	Brass	None
●	36	VICTAULIC	V3405	Standard	8.0	3/4"	Pendent	155°F	Chrome	401 Adjustable / Chrome
.	.	.	.	.	.	.	.	.	.	.
.	.	.	.	.	.	.	.	.	.	.
.	.	.	.	.	.	.	.	.	.	.
.	.	.	.	.	.	.	.	.	.	.
Total:	324									



**SAN JOAQUIN FIRE PROTECTION, INC.**  
 5957 E. HARVARD AVE. FRESNO, CA. 93727  
 PH. (559) 282-7111 FAX (559) 282-7211 CA. LIC. 775461

DISCUSSION: BUILDING "C" SPRINKLER PIPING, & CALCULATION PLAN

Job No.	21016	MADERA INDUSTRIAL
Date	11/13/2021	325, 335, 345, & 355 S. SCHNOOR AVE.
Engr.	GREG S.	MADERA, CA. 93637
Scale	1/8" = 1'-0"	

**FP-5**  
OF 6 SHEET



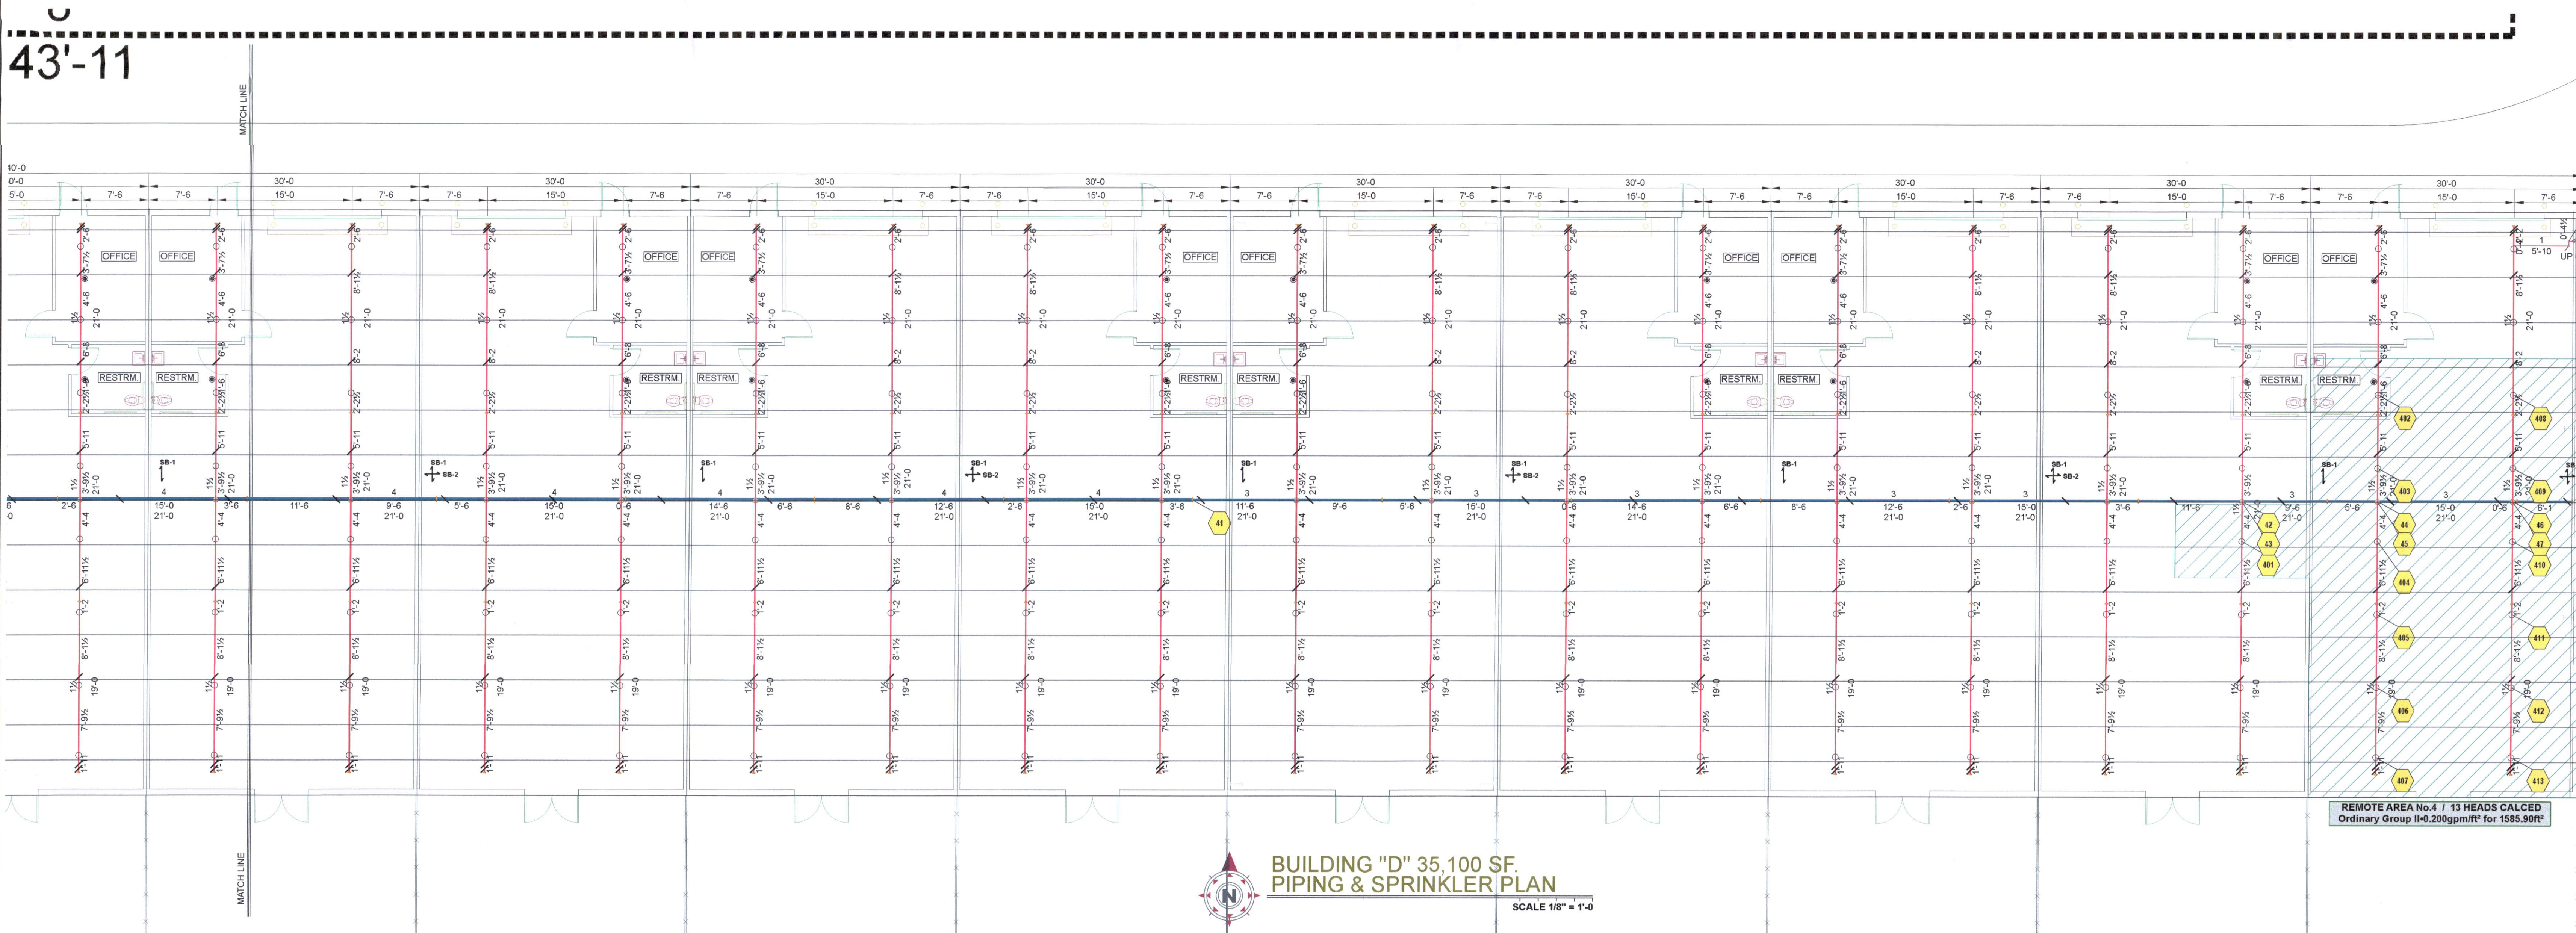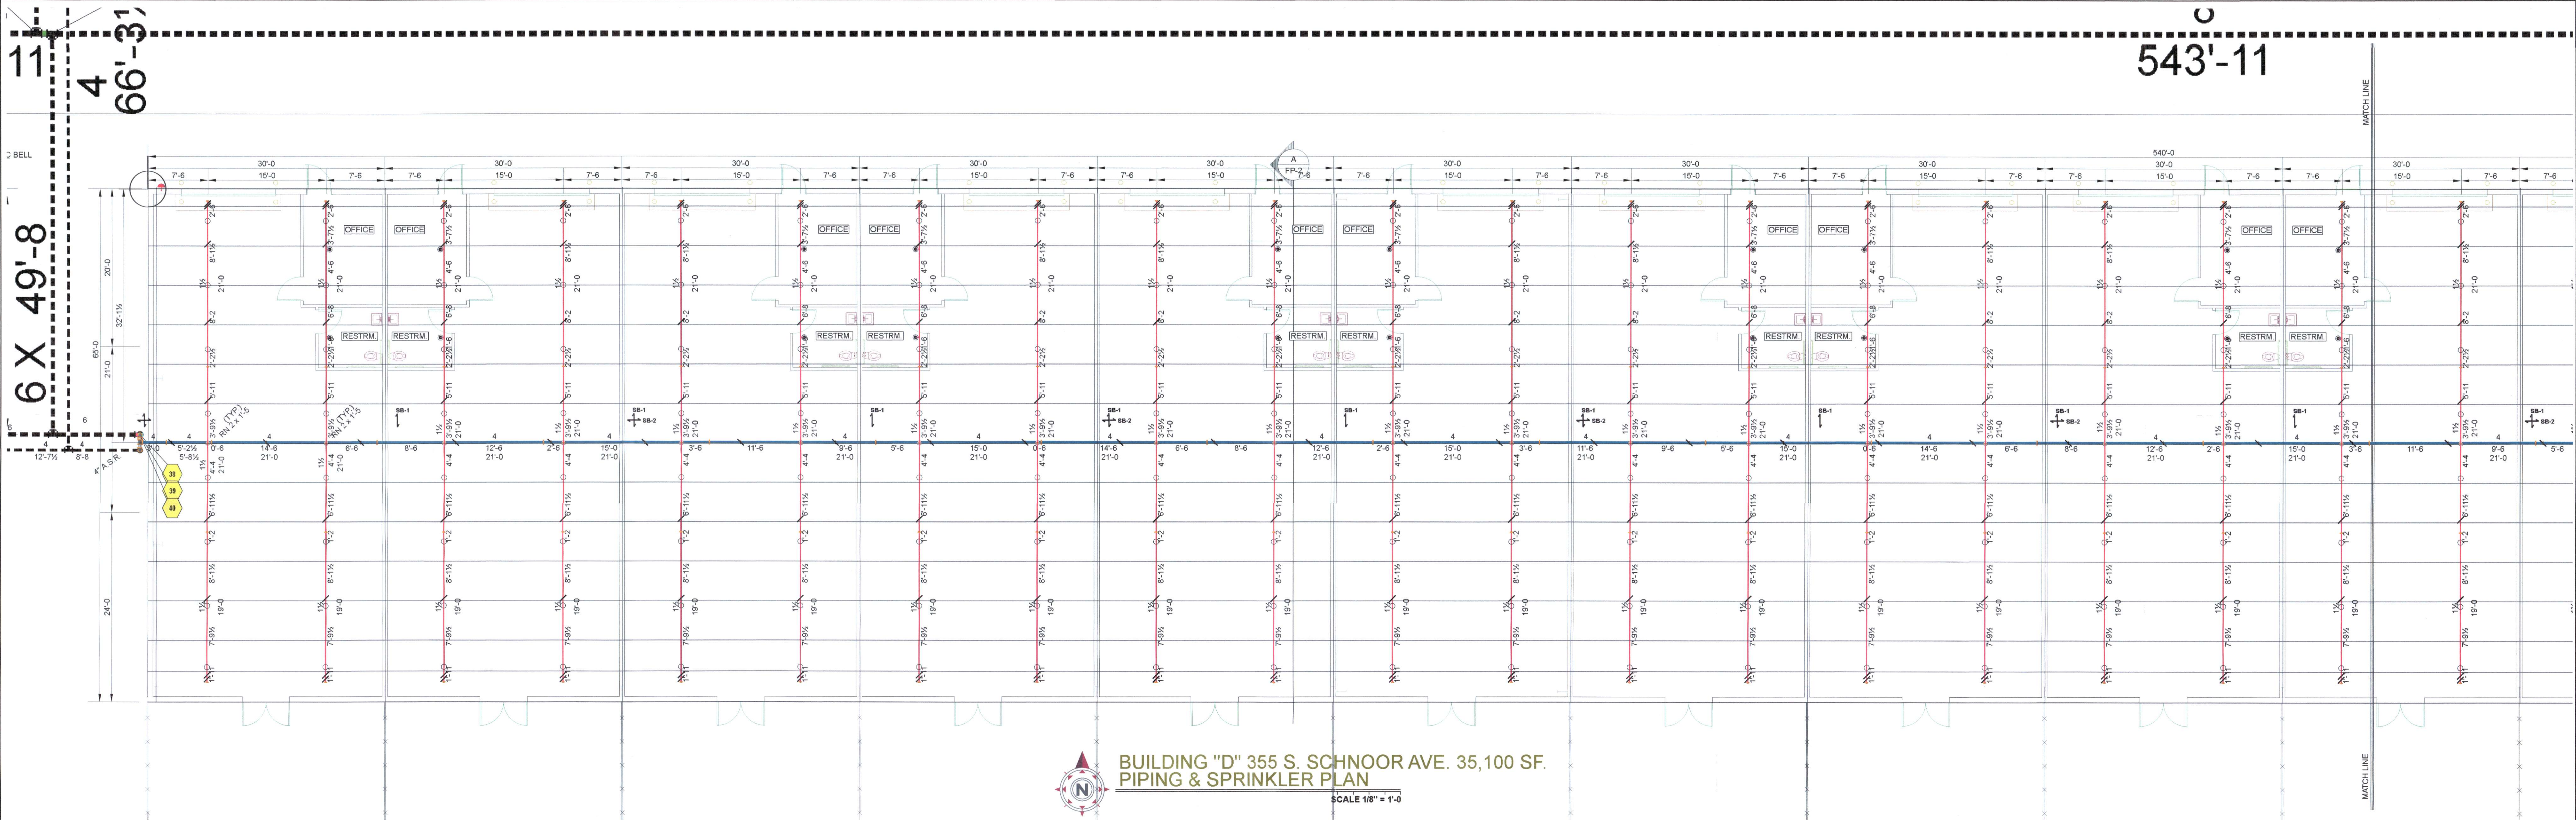

2019CBO  
 City of Madera  
 Building Department  
 The approval of these plans does not constitute a warranty of the City of Madera for any errors or omissions in the plans. Subject to the City of Madera's approval, the City of Madera shall not be liable for any damages or losses resulting from the use of these plans.

APPROVED  
 By: [Signature]  
 Date: JAN 0 5 2022

2019CBO  
 City of Madera  
 Building Department  
 The approval of these plans does not constitute a warranty of the City of Madera for any errors or omissions in the plans. Subject to the City of Madera's approval, the City of Madera shall not be liable for any damages or losses resulting from the use of these plans.

2019CBO  
 City of Madera  
 Building Department  
 The approval of these plans does not constitute a warranty of the City of Madera for any errors or omissions in the plans. Subject to the City of Madera's approval, the City of Madera shall not be liable for any damages or losses resulting from the use of these plans.

THESE DRAWINGS, SPECIFICATIONS, THE IDEAS, DESIGNS AND ARRANGEMENTS REPRESENTED THEREBY ARE AND SHALL REMAIN THE PROPERTY OF SAN JOAQUIN FIRE PROTECTION, INC. AND NO PART THEREOF SHALL BE COPIED, DISCLOSED TO OTHERS, OR USED IN CONNECTION WITH ANY OTHER WORK OR PROJECT OTHER THAN THE SPECIFIC PROJECT FOR WHICH THEY HAVE BEEN PREPARED AND DEVELOPED WITHOUT THE WRITTEN CONSENT OF SAN JOAQUIN FIRE PROTECTION, INC. VISUAL CONTACT WITH THESE DRAWINGS OR SPECIFICATIONS SHALL CONSTITUTE CONCLUSIVE EVIDENCE OF THESE RESTRICTIONS.

Revisions		Symbols		Symbols		Sprinkler Head Symbols		Sprinkler Head Type & Count									SAN JOAQUIN FIRE PROTECTION, INC.															
12/03/21 FIRE DEPT. COMMENTS		Hanger Location Lateral Brace Longitudinal Brace Four Way Brace Hydraulic Refs. Points Thrust Block		Backflow Preventer Key Operated Valve Post Indicator Valve Check Valve Fire Dept. Connection Hose Valve Hose Station		Pendent on Drop Pendent on Drop w/401 Escutcheon Upright & Pendent on 1" Tee Upright on Outlet Upright on Tee or Cross With 1" Plug Upright on Sprig Up With Tee & 1" Plug Upright on Sprig Up Sidewall on Outlet		Sym. Quantity ○ 288 ● 36 . . . . . Total: 324		Manufacturer VICTAULIC VICTAULIC		Model V3401 V3405		Response Standard Standard		K-Factor 8.0 8.0		Orifice Size 3/4" 3/4"		Type Upright Pendent		Temp. 200°F 155°F		Finish Brass Chrome		Escutcheon / Finish None 401 Adjustable / Chrome		9597 E. HARVARD AVE. FRESNO, CA. 93727 PH. (559) 292-7111 FAX (559) 292-7211 CA. LIC. 775461				
																								DISCRPTION: BUILDING "D" SPRINKLER PIPING, & CALCULATION PLAN		Job No. 21016 Date 11/13/2021 Engr. GREG S. Scale 1/8" = 1'-0"		MADERA INDUSTRIAL 325, 335, 345, & 355 S. SCHNOOR AVE. MADERA, CA. 93637		FP-6 OF 6 SHEET		

**SAN JOAQUIN FIRE PROTECTION, INC.**  
 5957 E. HARVARD AVE. FRESNO, CA. 93727  
 PH. (559) 292-7411 FAX (559) 292-7211 CA. LIC. 775461

**DISCUSSION: BUILDING "D" SPRINKLER PIPING, & CALCULATION PLAN**

Job No.	2016	<b>MADERA INDUSTRIAL</b> 325, 335, 345, & 355 S. SCHNOOR AVE. MADERA, CA. 93637	<b>FP-6</b> OF 6 SHEET
Date	11/13/2021		
Engr.	GREG S.		
Scale	1/8" = 1'-0"		





a division of BlueScope Buildings North America, Inc.

DRAWING INDEX	
DRAWING TITLE	PAGES
Cover Sheet	1
Codes and Loads	2
Notes	3
Anchor Rod Plan	4 - 5
Primary Structural	6 - 19
Secondary Structural	20 - 29
Covering	30 - 40
Special Drawings	
Standard Erection Details	
Planograph Details	41 - 45

DRAWING RELEASE HISTORY		
TYPE	DATE	DESCRIPTION
Anchor Rod Drawings	7/9/2021	FOR CONSTRUCTION
Permit Drawings	7/9/2021	PERMIT SET- For Building Dept. Approval
Final Erection Drawings	9/16/2021	FOR CONSTRUCTION

GENERAL NOTES

MATERIALS

3 PLATE WELDED SECTIONS  
COLD FORMED LIGHT GAGE SHAPES  
BRACE RODS  
HOT ROLLED MILL SHAPES  
HOT ROLLED ANGLES  
HOLLOW STRUCTURAL SECTION (HSS)  
CLADDING

ASTM DESIGNATION

A529, A572, A1011, A1018  
A653, A1011  
A572, A510  
A36, A529, A572, A588, A992  
A529, A572, A588, A992  
A500  
A653, A792

GRADE 55  
GRADE 60  
GRADE 50  
GRADE 36 OR 50  
GRADE 50  
GRADE B  
GRADE 50 OR GRADE 80

HIGH STRENGTH BOLT TIGHTENING REQUIREMENTS

IT IS THE RESPONSIBILITY OF THE ERECTOR TO ENSURE PROPER BOLT TIGHTNESS IN ACCORDANCE WITH APPLICABLE REGULATIONS. SEE RCSC SPECIFICATION FOR STRUCTURAL JOINTS USING HIGH STRENGTH BOLTS FOR MORE INFORMATION. SEE ERECTION GUIDE FOR BOLT TIGHTENING INSTRUCTIONS. THE FOLLOWING CRITERIA MAY BE USED TO DETERMINE THE BOLT TIGHTNESS (I.E.-SNUG TIGHT OR PRE-TENSION) UNLESS REQUIRED OTHERWISE BY LOCAL JURISDICTION OR CONTRACT.

ALL A490 BOLTS SHALL BE "PRE-TENSIONED". A325 BOLTS IN PRIMARY FRAMING AND BRACING CONNECTIONS MAY BE "SNUG-TIGHT" EXCEPT AS FOLLOWS;

PRE-TENSION A325 BOLTS IF BUILDING SUPPORTS A CRANE GREATER THAN 5 TON CAPACITY.

PRE-TENSION A325 BOLTS IF BUILDING SUPPORTS MACHINERY THAT CREATES VIBRATION, IMPACT, OR STRESS REVERSALS ON CONNECTIONS.

PRE-TENSION A325 BOLTS IF LOCATED IN HIGH SEISMIC AREAS. FOR IBC BASED CODES; HIGH SEISMIC IS DESIGN CATEGORY D, E OR F. SEE CODES AND LOADS SECTION BELOW FOR DETAILS.


PRE-TENSION ANY CONNECTION WITH DESIGNATION A325-SC. SLIP CRITICAL (SC) CONNECTIONS MUST BE FREE OF PAINT, OIL OR OTHER MATERIALS THAT REDUCE FRICTION AT CONTACT SURFACES. GALVANIZED OR LIGHTLY RUSTED SURFACES ARE ACCEPTABLE.

IN CANADA, ALL A325 AND A490 BOLTS SHALL BE "PRE-TENSIONED", EXCEPT FOR SECONDARY MEMBERS AND FLANGE BRACES.


SECONDARY MEMBERS AND FLANGE BRACE CONNECTIONS ARE ALWAYS "SNUG TIGHT", UNLESS INDICATED OTHERWISE IN ERECTION DRAWING DETAILS.

INSPECTION AND TESTING

SPECIAL INSPECTIONS AND TESTING REQUIRED BY AUTHORITY HAVING JURISDICTION (AHJ) DURING CONSTRUCTION AND/OR STEEL FABRICATION IS THE RESPONSIBILITY OF THE OWNER OR OWNERS AUTHORIZED AGENT. WHEN REQUIRED, THE OWNER SHALL EMPLOY A QUALITY ASSURANCE AGENCY (QAA) APPROVED BY THE AHJ. THE BUILDER IS RESPONSIBLE TO COORDINATE BETWEEN THE QAA FIRM AND BBNA FABRICATION FACILITIES. THE TYPE AND EXTENT OF SPECIAL INSPECTIONS AND NDT WELD TESTING MUST BE SPECIFICALLY STIPULATED IN CONTRACT DOCUMENTS OR BBNA WILL ASSUME SPECIAL INSPECTIONS AND/OR NDT TESTING ARE WAIVED AS PERMITTED BY THE BUILDING CODE BASED ON BBNA FACILITIES IAS AC472 ACCREDITATION.

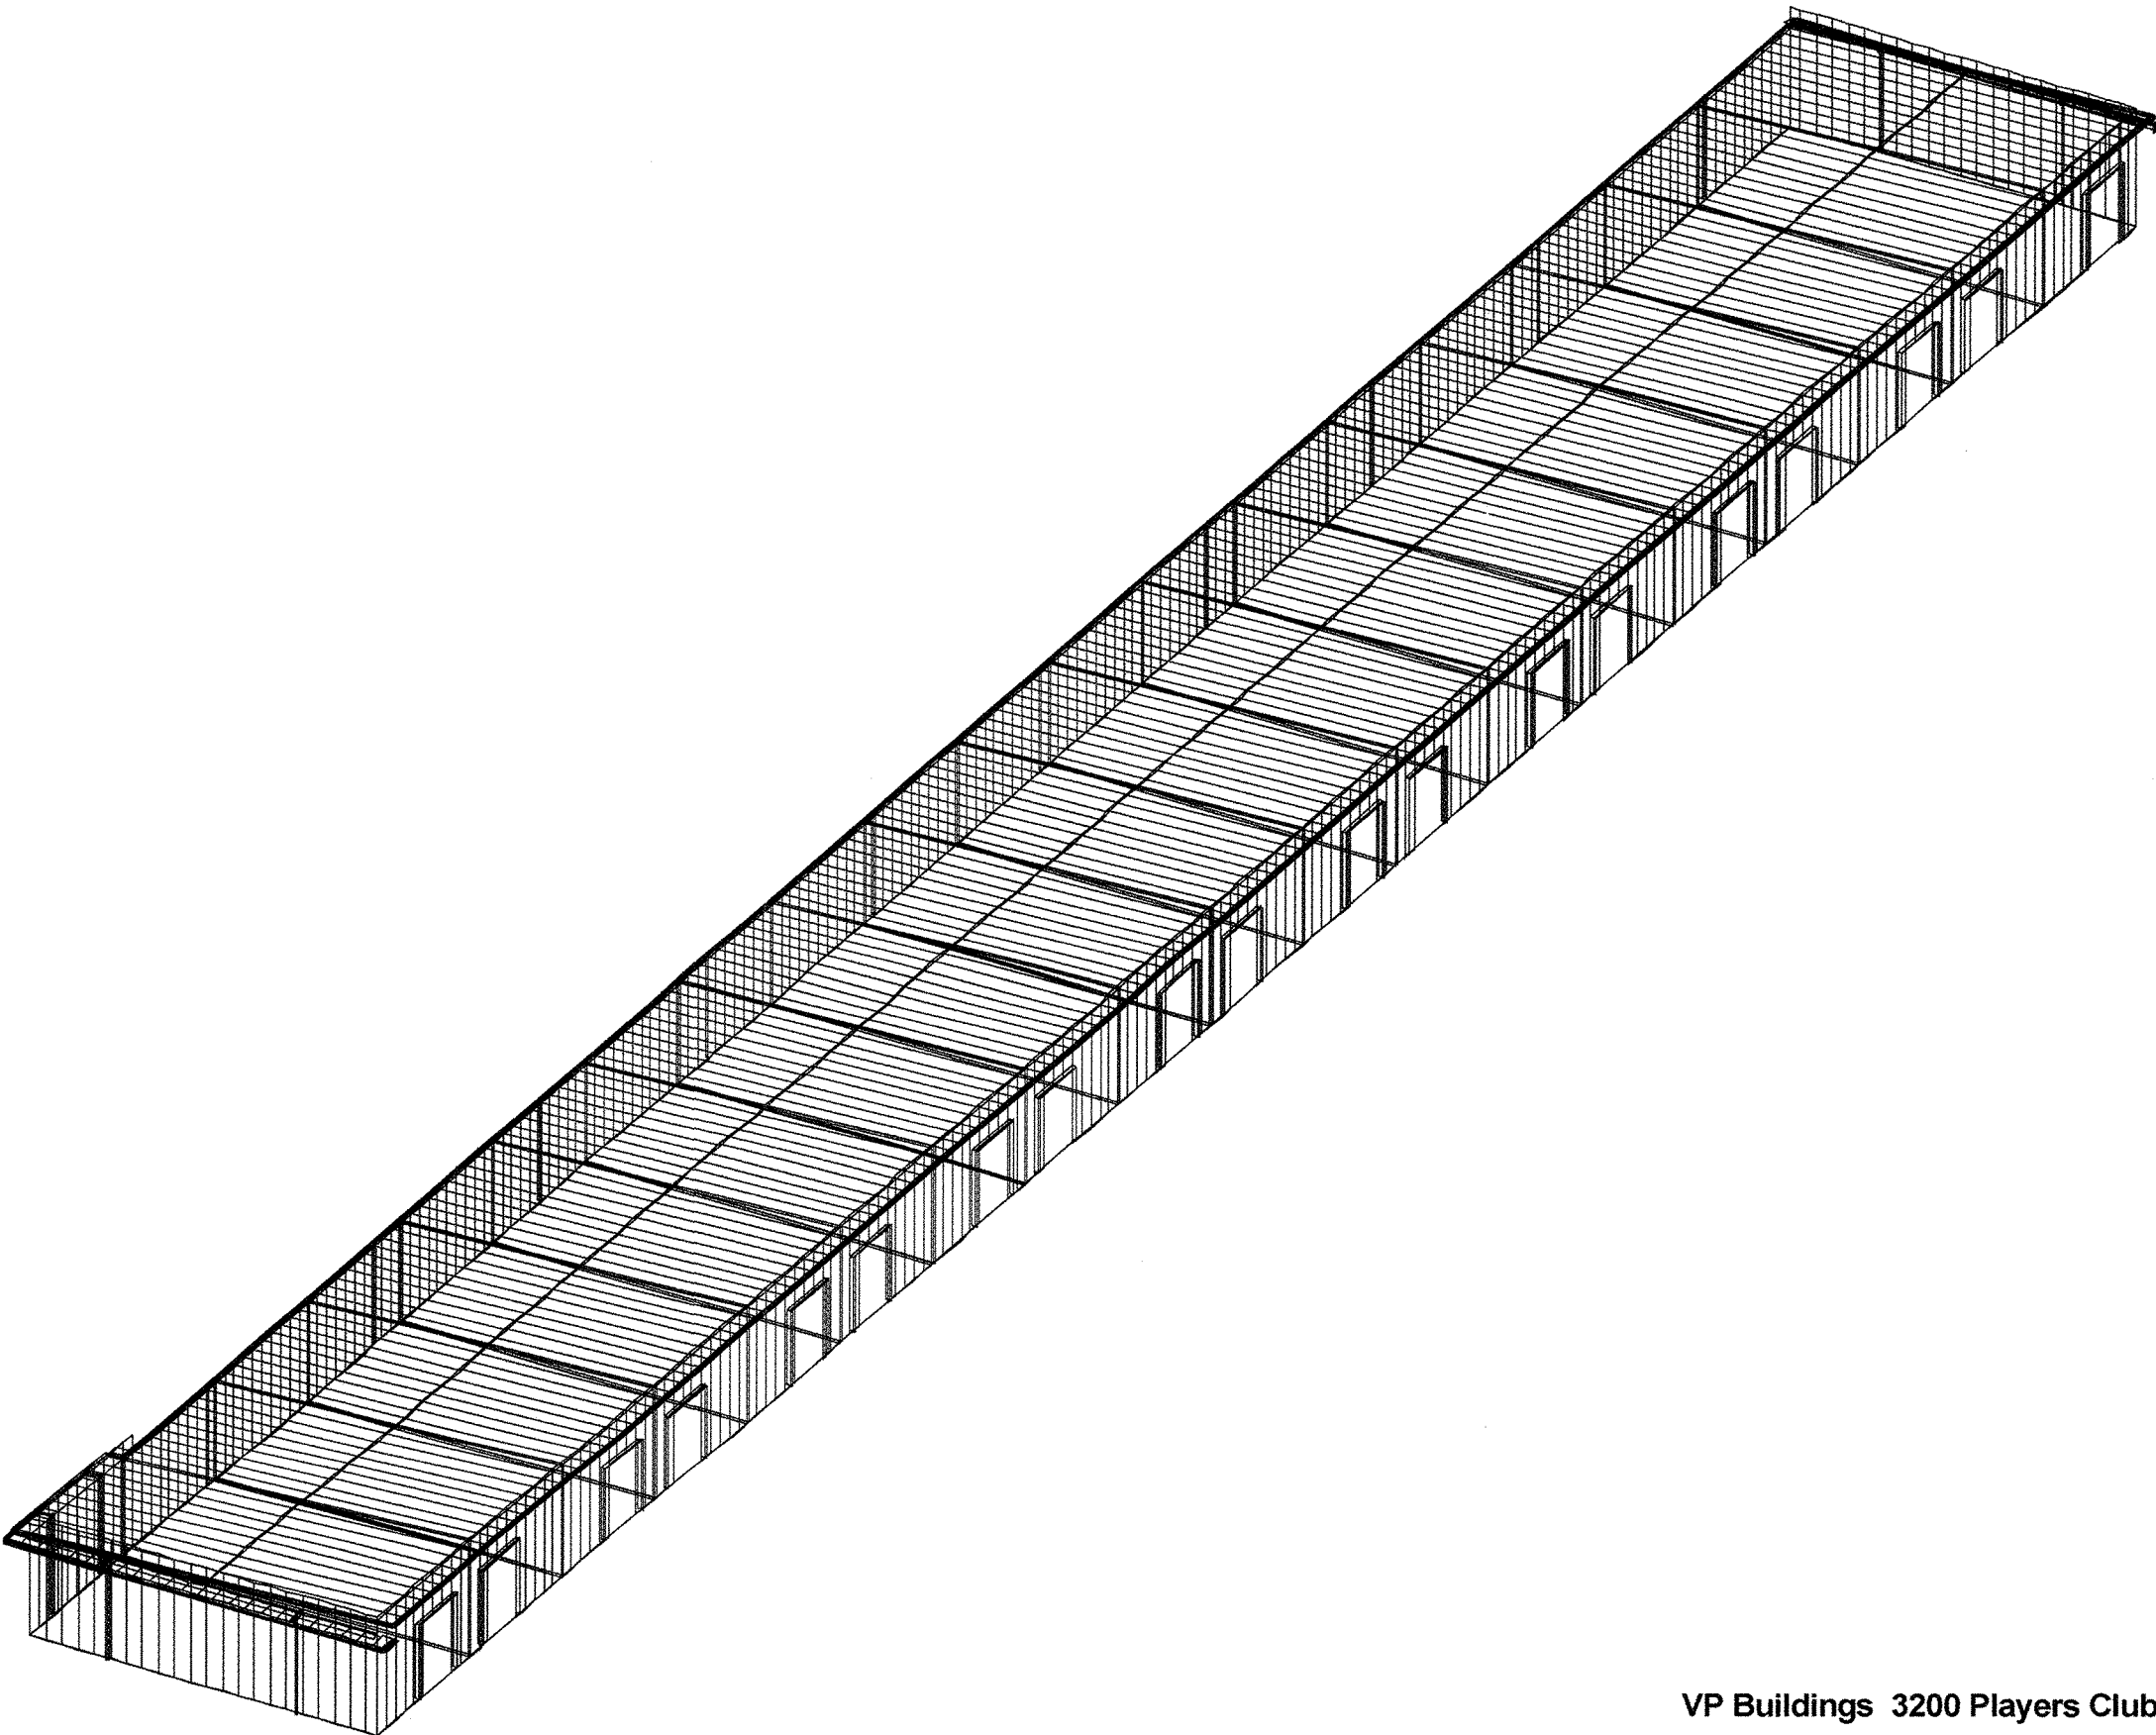

VP Buildings 3200 Players Club Circle Memphis TN 38125

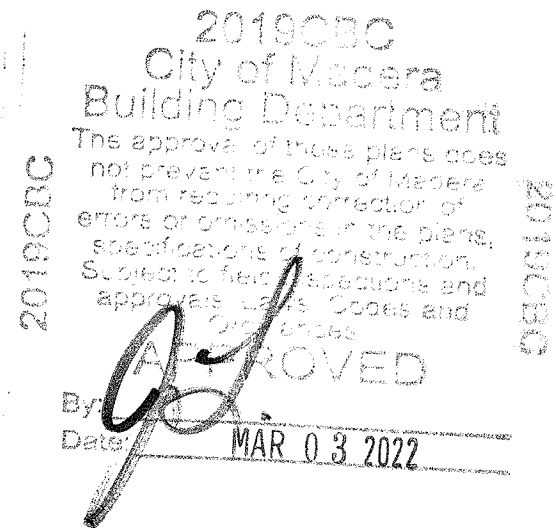

Keith Erick Fix electronically signs and seals this document with his Professional Engineer seal affixed. Printed copies of this document are not signed and sealed. This signature must be verified on an electronic copy.  
2021.09.21 10:10:29-0500



09/21/2021

THE VP ENGINEER'S SEAL APPLIES ONLY TO THE WORK PRODUCT OF VP AND DESIGN AND PERFORMANCE REQUIREMENTS SPECIFIED BY VP. THE VP ENGINEER'S SEAL DOES NOT APPLY TO THE PERFORMANCE OR DESIGN OF ANY OTHER PRODUCT OR COMPONENT FURNISHED BY VP EXCEPT TO ANY DESIGN OR PERFORMANCE REQUIREMENTS SPECIFIED BY VP.

THIS DRAWING, INCLUDING THE INFORMATION HEREON, REMAINS THE PROPERTY OF VP BUILDINGS. IT IS PROVIDED SOLELY FOR ERECTING THE BUILDING DESCRIBED IN THE APPLICABLE PURCHASE ORDER AND MAY BE REPRODUCED ONLY FOR THAT PURPOSE. IT SHALL NOT BE MODIFIED, REPRODUCED OR USED FOR ANY OTHER PURPOSE WITHOUT PRIOR WRITTEN APPROVAL OF VP BUILDINGS.

THE GENERAL CONTRACTOR AND/OR ERECTOR IS SOLELY RESPONSIBLE FOR ACCURATE GOOD QUALITY WORKMANSHIP IN ERECTING THIS BUILDING IN ACCORDANCE WITH THIS DRAWING, DETAILS REFERENCED IN THIS DRAWING, ALL APPLICABLE VP BUILDINGS ERECTION GUIDES, AND INDUSTRY STANDARDS PERTAINING TO PROPER ERECTION, INCLUDING THE CORRECT USE OF TEMPORARY BRACING.



D

COVER SHEET

BUILDER	DBKO Design + Build
CUSTOMER	Madera WH Building A
LOCATION	Madera, California
PROJECT	MT 1 Building A
BUILDERS PO#	



VPC VERSION: 2021.2c

JOBNO	21-008734-01
DATE	9/16/2021
DRAWN / CHECK	ADP ADP
PAGE	1


FILENAME MT 1

a division of BlueScope Buildings North America, Inc.



Codes and Loads  
WHEN MULTIPLE BUILDINGS ARE INVOLVED, SPECIFIC LOAD FACTORS FOR DIFFERING OCCUPANCIES, BUILDING DIMENSIONS, HEIGHTS, FRAMING SYSTEMS, ROOF SLOPES, ETC., MAY RESULT IN DIFFERENT LOAD APPLICATION FACTORS THAN INDICATED BELOW. SEE CALCULATIONS FOR FURTHER DETAILS. WIND LOADS ARE APPLIED TO OVERALL BUILDING ENVELOPE. COMMON WALLS BETWEEN CONNECTED SHAPES ARE NOT SUBJECT TO EXTERNAL WIND LOADS.  
City: Madera County: Madera State: California Country: United States  
Building Code  
Building Code: 2019 California Building Code Structural: 16AISC - ASD Rainfall: 1: 3.00 inches per hour  
Based on Building Code: 2018 International Building Code Cold Form: 16AISI - ASD f'c: 3000.00 psi Concrete  
Building Risk/Occupancy Category: II (Standard Occupancy Structure)


Dead and Collateral Loads  
Collateral Gravity: 5.00 psf  
Collateral Uplift: 0.00 psf  
Material Dead Weight  
Roof Covering + Second. Dead Load: 2.20 psf  
Frame Weight (assumed for seismic): 2.50 psf  
Roof Live Load  
Roof Live Load: 20.00 psf Reducible  
Wind Load  
Wind Speed: Vult: 94.00 (Vasd: 72.81) mph  
The 'Envelope Procedure' is Used  
Primaries Wind Exposure: C - Kz: 0.892  
Parts Wind Exposure Factor: 0.892  
Wind Enclosure: Enclosed  
Topographic Factor: Kzt: 1.0000  
Ground Elevation Factor: Ke: 0.9908  
NOT Windborne Debris Region  
Base Elevation: 0/0/0  
Site Elevation: 256.0 ft  
Primary Zone Strip Width: 2a: 13/0/0  
Parts / Portions Zone Strip Width:  
Walls, a: 6/6/0  
Roof(s), 0.6h: 11/4/13  
Basic Wind Pressure: q: 17.00, (Parts) 17.00 psf  
Snow Load  
Ground Snow Load: pg: 0.00 psf  
Flat Roof Snow: pf: 0.00 psf  
Design Snow (Sloped): ps: 0.00 psf  
Rain Surcharge: 0.00  
Exposure Factor: 2 Partially Exposed - Ce: 1.00  
Snow Importance: Is: 1.000  
Thermal Factor: Heated - Ct: 1.00  
Ground / Roof Conversion: 0.70  
Obstructed or Not Slippery  
Seismic Load  
Lateral Force Resisting Systems using Equivalent Force Procedure  
Mapped MCE Acceleration: Ss: 60.90 %g  
Mapped MCE Acceleration: Sl: 23.70 %g  
Site Class: Stiff soil (D) - Default  
Seismic Importance: Ie: 1.000  
Design Acceleration Parameter: Sds: 0.5330  
Design Acceleration Parameter: Sd1: 0.3359  
Seismic Design Category: D  
Seismic Snow Load: 0.00 psf  
% Snow Used in Seismic: 0.00  
Diaphragm Condition: Rigid  
Fundamental Period Height Used: 20/4/4  
Transverse Direction Parameters  
Ordinary Steel Moment Frames  
Redundancy Factor: Rho: 1.30 - USR  
Fundamental Period: Ta: 0.3119  
R-Factor: 3.50  
Overstrength Factor: Omega: 3.00  
Deflection Amplification Factor: Cd: 3.00  
Base Shear: V: 0.1523 x W  
Longitudinal Direction Parameters  
Ordinary Steel Moment Frames  
Redundancy Factor: Rho: 1.30  
Fundamental Period: Ta: 0.3119  
R-Factor: 3.50  
Overstrength Factor: Omega: 3.00  
Deflection Amplification Factor: Cd: 3.00  
Base Shear: V: 0.1523 x W

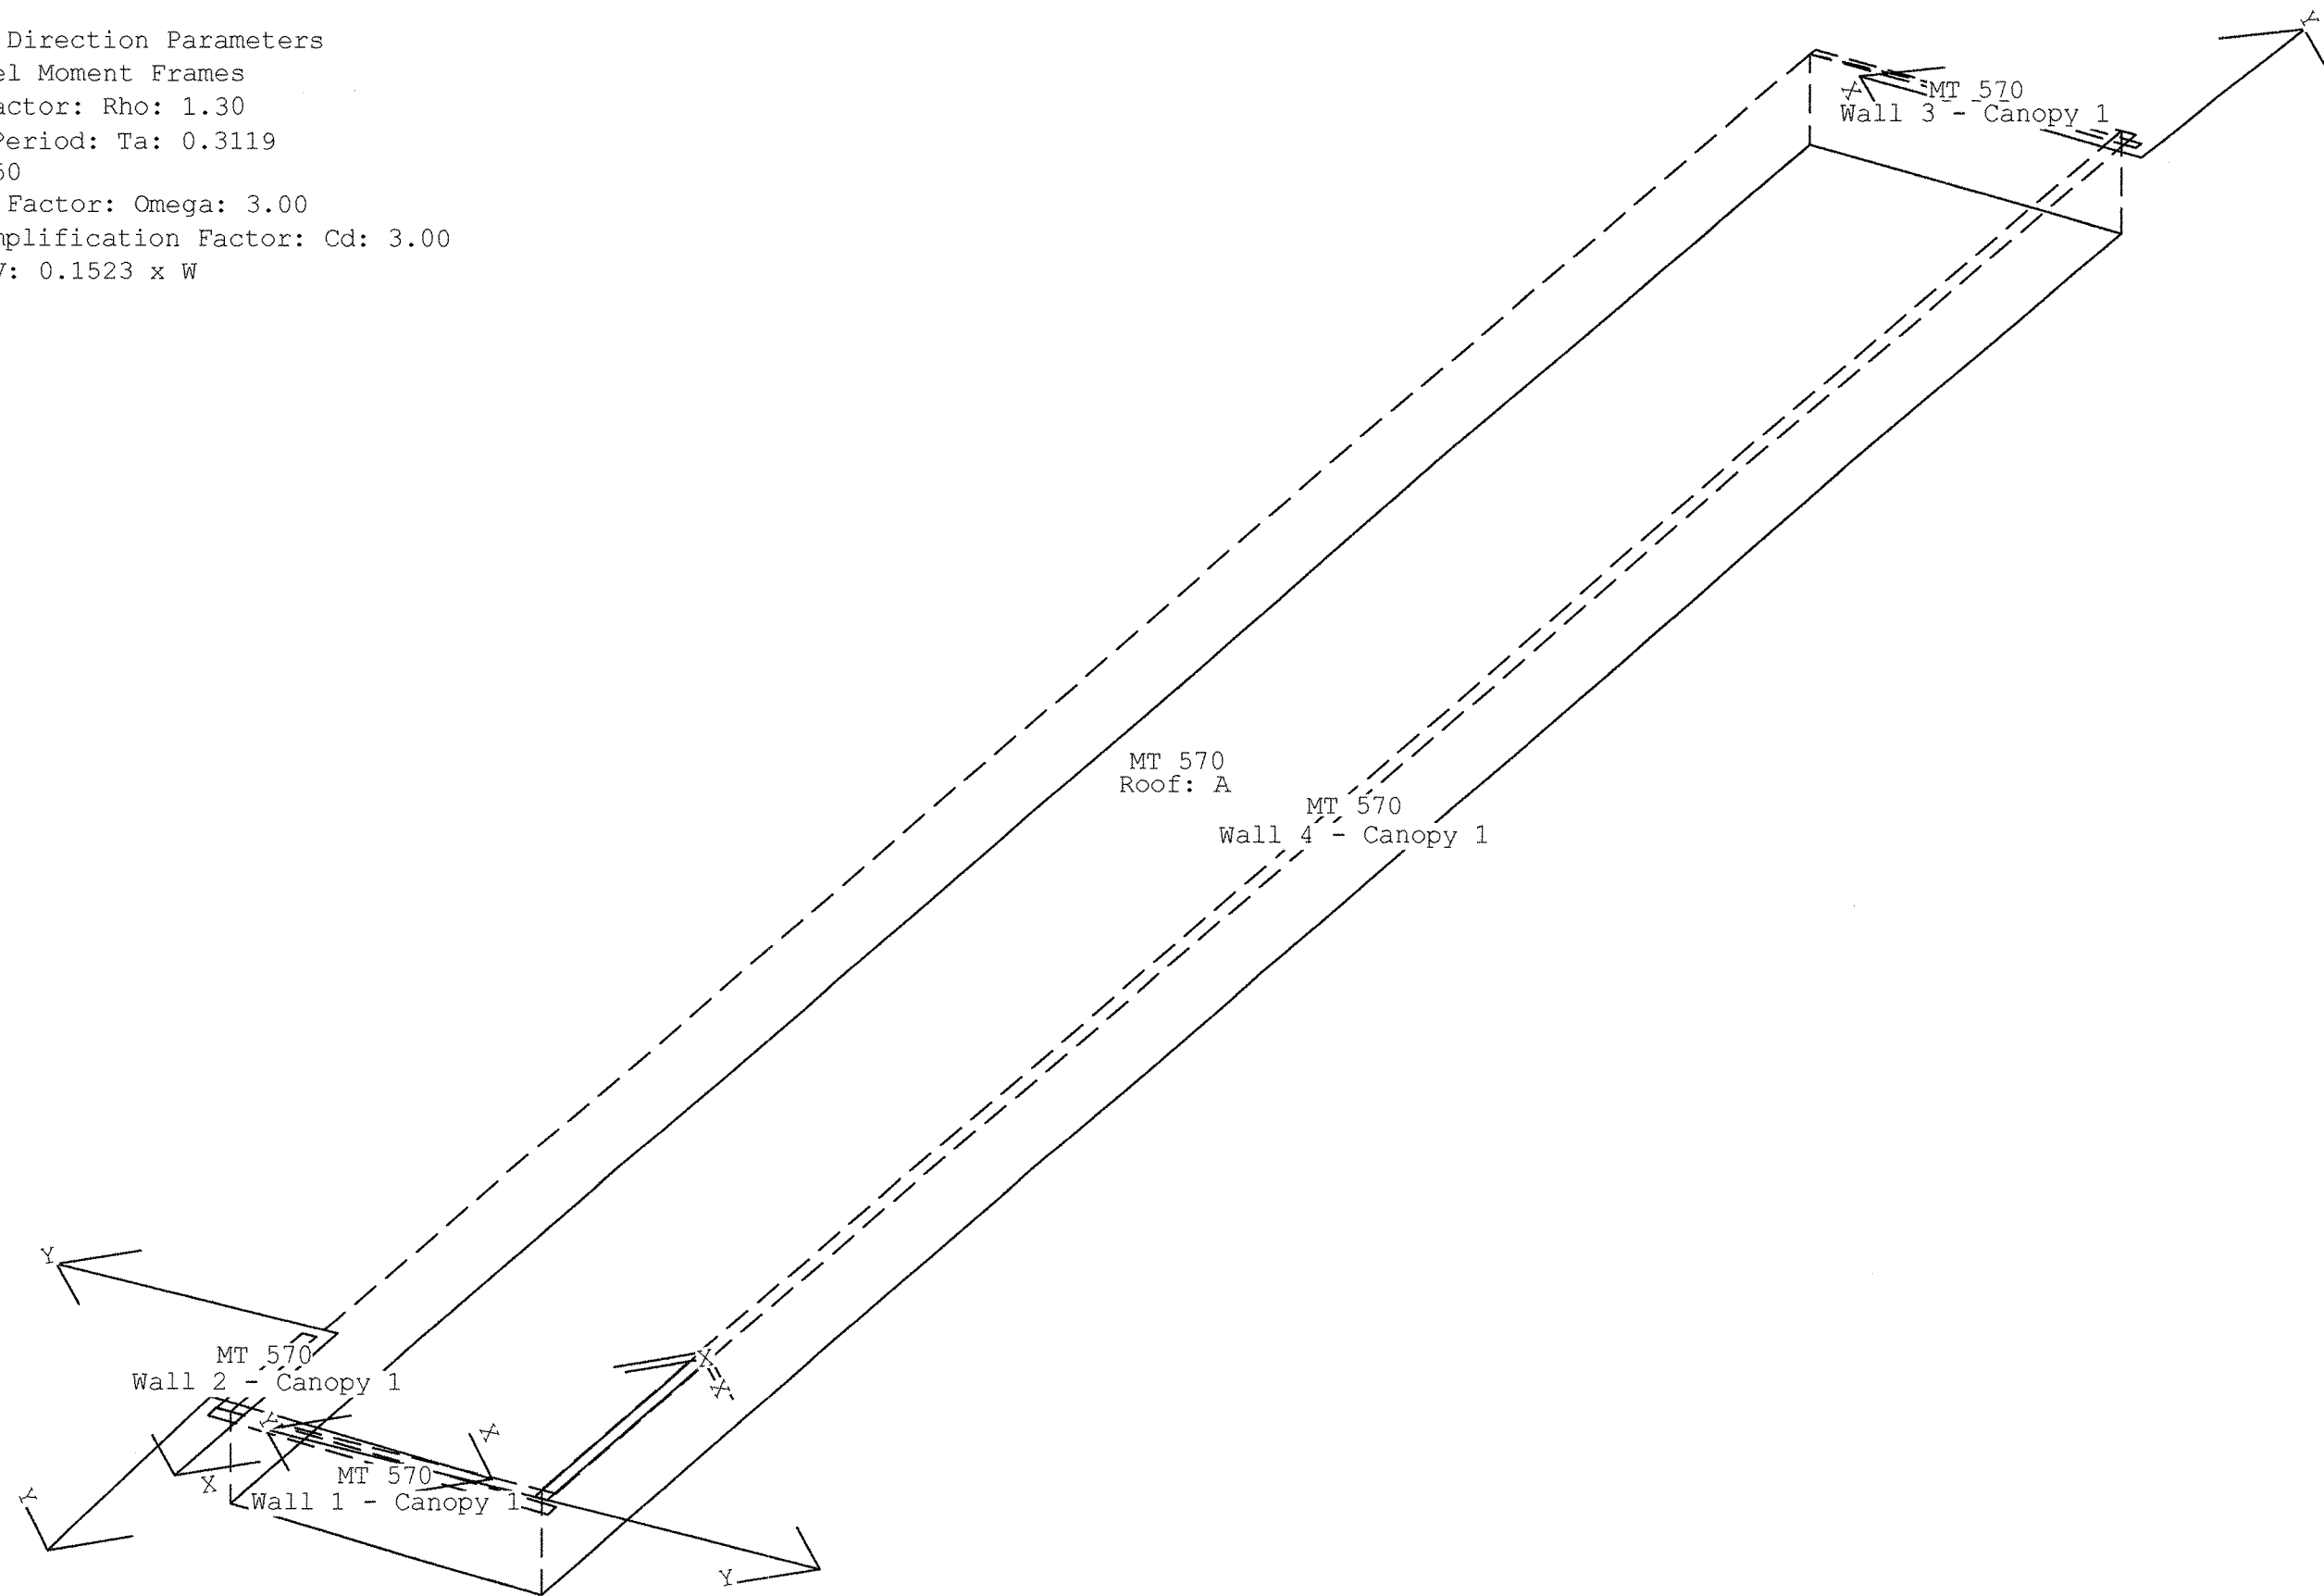

2019CBC  
City of Madera  
Building Department  
By: [Signature]  
Date: MAR 03 2022



FOR CONSTRUCTION 09/21/2021

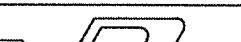MODIFIED IN AUTOCAD	THE VP ENGINEER'S SEAL APPLIES ONLY TO THE WORK PRODUCT OF VP AND DESIGN AND PERFORMANCE REQUIREMENTS SPECIFIED BY VP. THE VP ENGINEER'S SEAL DOES NOT APPLY TO THE PERFORMANCE OR DESIGN OF ANY OTHER PRODUCT OR COMPONENT FURNISHED BY VP EXCEPT TO ANY DESIGN OR PERFORMANCE REQUIREMENTS SPECIFIED BY VP.	THIS DRAWING, INCLUDING THE INFORMATION HEREON, REMAINS THE PROPERTY OF VP BUILDINGS. IT IS PROVIDED SOLELY FOR ERECTING THE BUILDING DESCRIBED IN THE APPLICABLE PURCHASE ORDER AND MAY BE REPRODUCED ONLY FOR THAT PURPOSE. IT SHALL NOT BE MODIFIED, REPRODUCED OR USED FOR ANY OTHER PURPOSE WITHOUT PRIOR WRITTEN APPROVAL OF VP BUILDINGS.	THE GENERAL CONTRACTOR AND/OR ERECTOR IS SOLELY RESPONSIBLE FOR ACCURATE GOOD QUALITY WORKMANSHIP IN ERECTING THIS BUILDING IN ACCORDANCE WITH THIS DRAWING, DETAILS REFERENCED IN THIS DRAWING, ALL APPLICABLE VP BUILDINGS ERECTION GUIDES, AND INDUSTRY STANDARDS PERTAINING TO PROPER ERECTION, INCLUDING THE CORRECT USE OF TEMPORARY BRACING.	D		VP Buildings		CODES AND LOADS			
				3200 Players Club Circle Memphis TN 38125							
				REV	DATE	BY	DESCRIPTION	BUILDER	DBKO Design + Build		
								CUSTOMER	Madera WH Building A		
								LOCATION	Madera, California		
								PROJECT	MT 1 Building A		
				NTS				BUILDERS PO#			
FILENAME: C:\Users\krjones\OneDrive - BlueScope\Building Files\21-008734-01\MT 1_CODES AND LOADS.dwg				SAVE DATE: 7/8/2021		SAVE TIME: 19:38:47		LAST SAVED BY: krjones		<div> VARCO PRUDEN</div> <div>A BlueScope Steel Company VPC VERSION: 2021.2</div>	JOBNO 21-008734-01 DATE 7/8/2021 DRAWN/CHECK KJJ PAGE 2
a division of BlueScope Buildings North America, Inc.											



BUILDER/CONTRACTOR RESPONSIBILITIES

VP Buildings follows the guidelines as outlined in the AISC and MBMA Codes of Standard Practice. VP Buildings standard product specifications, design, fabrication, quality criteria shall govern all work unless stipulated otherwise in the contract documents. In case of discrepancies between VP Buildings structural plans and plans for other trades, VP Buildings structural plans shall govern.

It is the responsibility of the Builder to obtain approvals and permits from all governing agencies and jurisdictions as required. Approval of VP Buildings drawings constitutes the builders acceptance of VP interpretation of the contract purchase order. Unless specific design criteria concerning interface design and details are furnished as part of the contract, VP Buildings design assumptions shall govern.

VP engineers are not Project Engineers or Engineer of Record for the overall project. VP engineering supply sealed engineering design data and drawings for VP supplied material as part of the overall project for use by others to obtain permits, approvals, and coordinate with other trades. All interface and/or compatibility of any materials not furnished by VP are to be considered and coordinated by the builder or A/E firm.

CONSTRUCTION & ERECTION RESPONSIBILITY

The Builder is responsible for construction in strict accordance with VP Buildings "FOR CONSTRUCTION" drawings and all applicable product installation guides. VP is not responsible for work done from any other VP drawings that are not marked "FOR CONSTRUCTION", nor any drawings prepared by others.

As erected field assemblies of members shall be as specified in MBMA Code of Standard Practice (in Canada - CSA S16), which require L/500 tolerance of installed members. Occasional field work including shimming, cutting, coping, and drilling for final fit-up are considered part of erection. Specified field work and field welding conditions indicated on these drawings shall also be included in the erectors scope of work. See Erection Guide for shimming procedure. For building with top riding bridge cranes see Crane Data drawing for column plumb tolerance.

The building erector shall be properly licensed and experienced in erecting metal building systems. The Builder is responsible for having knowledge of, and shall comply with, all OSHA requirements and all other governing site safety criteria. The builder is responsible for designing, supplying, locating and installing temporary supports and bracing during erection of the building. VP bracing is designed for code required loads after building completion and shall not be considered as adequate erection bracing. See Erection Guide.

Shimming of steel buildings during erection may be required to accomodate allowable tolerances during fabrication and erection. Special care should be taken by the building erector to shim connections where key dimensions must be maintained for building performance as even small tolerances can have a significant impact on critical dimensions such as height, clearances and plumbness, especially as the size of the member or building increases. Conditions where shimming should be expected can include but are not limited to large door openings, critical clear height requirements, cranes, buildings greater than 45 feet in height, clear spans greater than 125 feet and adjacent frames with different characteristics (like clear span frames adjacent to an endwall or modular frame). Shims are normally provided by the erector, but may be ordered upon request by contacting your Project Manager.

EXISTING STRUCTURES

VP must be advised of any structure that is within 20 ft. of VP's building. Load effects from snow drifting, wind effects, and seismic separation must be considered for both the new and existing structures. VP has designed the new VP building for these effects. The owner/builder are responsible for employing a Professional Engineer to review and verify the existing structure for all load effects from the adjacent VP building.

BRACING

Tension brace rods work in pairs to balance forces caused by initial tensioning. Care must be taken while tightening brace rods so as not to cause accidental or misalignment of components. All rods must be installed loose and then tightened. Rods should not exhibit excessive sag. For long or heavy rods, or angles it may be necessary to support the rods at mid-bay by suspending them from secondary members.

Bracing for seismic or wind loading of objects or equipment that are not a part of the VP structure must be designed by a qualified professional to deliver lateral loads to primary frames and rod bracing struts. Equipment bracing and suspension connections must not impose torsion or minor axis loads, or cause local distortion in any VP components. VP accepts no responsibility for design or installation of bracing systems not furnished by VP.

FIELD WELDING

All field welding shall be done at the direction of a design professional, and done in accordance with governing requirements (AWS in USA, CWB in Canada) by welders qualified to perform the welding as directed by the applicable welding procedure specification (WPS). A WPS shall be prepared by the contractor for each welding variation specified. The contractor is responsible for any special welding inspection as required by local jurisdiction. Filler metal shall be 70 ksi (480 MPa) tensile strength. For welds in high seismic force resisting system (Seismic Cat D, E or F), minimum Charpy V-Notch toughness shall meet AISC-341 criteria (20 ft-lbs min @ 0Deg F). Interpass temperatures shall not exceed 550Deg F (300Deg C).

DELIVERIES

It is the responsibility of the builder to have adequate equipment available at the job site to unload trucks in a safe and timely manner. The Builder will be responsible for all retention charges from carriers as a result of job site unloading delays.

SIGNAGE

The Builder is responsible for furnishing signs as required by Code and the Building Department, including but not limited to, exits, occupancy limits, floor loading limits, and bulk storage limits. Floor loading signs shall clearly indicate maximum floor live load permitted. Bulk storage facilities shall have signs clearly posted on all loaded walls indicating the type of commodity stored and the maximum storage height. Signs shall be clearly visible when building is fully loaded to design level. Overloading of floors or walls may result in failure.

Claims for damage or shorts MUST be noted on the Bill-of-Lading or delivery receipt and filed against the carrier by the consignee as per VP's Terms of Sales (F.O.B. Plant) under the Uniform Commercial Code. It is critical that damages or shorts be noted on the Bill-of-Lading or you have little recourse with the carrier. Immediately upon delivery of material, material quantities are verified by the Builder against quantities billed on the shipping document. Neither the Manufacturer nor the carrier is responsible for material shortages against quantities billed on the shipping document if such shortages are not noted on the shipping documents upon delivery of material and acknowledged by the carriers agent. For materials concealed in bundles, boxes, or crates, shortages must be reported immediately upon unpacking. Should products get wet, bundled and crated materials must be unpacked and unbundled immediately to provide drainage of trapped moisture. See Erection Guide for proper job site storage procedure.

SEALANTS

Sealants shall be applied in strict accordance with VP details or weather tightness will be compromised. Sealant must be applied in temperatures and weather conditions consistent with labeling.

INDEPENDENT MEZZANINES

Independent mezzanines must be designed by a professional engineer. The engineer must ensure that proper isolation from the VP building has been provided to avoid structural damage due to differential movements, or inadvertently apply loads to the VP structure. VP accepts no responsibility for the design of the independent mezzanine.

FIRE CODE COMPLIANCE

It is the responsibility of the project design professional and builder to comply with local fire code regulations including consideration of, but not limited to, building use and occupancy, all building construction materials, separation requirements, egress requirements, fire protection systems, etc. Builder shall advise VP of any special requirements to be furnished by VP.

FIELD MODIFICATIONS

Modifications to this building from details and instructions contained on these drawings must be approved in writing by VP Buildings engineers, or other licensed structural engineer. This includes, but is not limited to, removal of roof or wall cladding, removing or moving any flange braces or rod braces, cutting of openings for doors, windows or RTU's, correction of fabrication errors, etc. The owner shall not impose loads to this structure beyond what is specified for this building in the contract documents. VP Buildings accepts no responsibility for the consequences of any unauthorized additions, alterations, or added loads to this structure.

If the builder intends to invoice VP Buildings for modifications in excess of \$1000, The builder must notify VP Buildings immediately, and obtain a Work Authorization from VP Buildings prior to proceeding. All final claims must be submitted to VP Buildings with all supporting documentation within 30 days of the building completion. Claims submitted without work authorizations, or after 30 days will not be accepted. Correction of minor misfits, shimming and plumbing, moderate amount of reaming, drilling, chipping / cutting and minor welding are considered by Code of Standard Practice to be part of erection are not subject to claim reimbursement.

CONCRETE/MASONRY/CONVENTIONAL STUD WALLS

The engineer responsible for the design of the wall system is responsible for coordinating with, or specifying to VP Buildings, any wall to steel compatibility issues such as drift and deflection compatibility, special base details, and wall to VP steel connections. All fasteners, sealant and counter flashing of wall systems are to be provided by contractor. The engineer responsible for the wall shall design the anchorage to VP supporting elements consistent with Code required forces.

PANELS

Oil canning is an inherent characteristic of cold formed steel panels. It is the result of several factors that include induced stresses in the raw material delivered to VP, fabrication methods, installation procedures, and post installation thermal forces. Thru fastened panels will exhibit some dimpling when installed, especially when insulation is installed between panels and secondary supports. Dimpling can be minimized by careful installation, taking care not to over drive fasteners.

Roof rumble is a phenomenon that is caused by wind gusts lifting up on the roof panels and then springing back into place. All panels experience this action to some degree, especially with concealed clip Standing Seam panels. Roof rumble noise may be minimized by providing a layer of blanket insulation between the panels and any hard support surface such as steel secondary members, substrates such as plywood, steel decking, or rigid board insulation. A minimum of 3 inch thick blanket is recommended over steel secondary members, or 2 inch over substrates.

Oil canning, dimpling, and roof rumble do not affect the structural integrity or weather tightness of the panels and is not grounds for rejection of panels.

The Standing Seam joint detail is designed with an interlocking feature for ease of installation. However, it is imperative that installed Standing Seam panels be secured to the secondary structural members and properly seamed prior to departure from the job site each day.

SKYLIGHTS

Local building departments may require added fall restraint due to conditions that may affect the skylight structural integrity. It is the responsibility of the builder to determine and provide any added fall restraint under the skylight as may be required by your building department.

RAIN WATER RUNOFF

Drainage systems must be designed by the project professional to comply with code requirements. VP is not responsible for drainage designs, overflow scuppers, down piping, etc. The project professional and contractor are responsible to ensure that primary drains and overflow devices such as scuppers and auxiliary drains are provided as required for the required rain intensity at the building perimeter and at valley conditions to prevent ponding.

STEEL SHOP COAT

The purpose of VP's shop coat is to provide protection for the steel members during transportation, during temporary job site storage and during erection. Standard shop formulation is not designed to perform as a finish coat when exposed to environmental conditions. Members shall be kept free of the ground and properly drained during job site storage. It is the Builder's responsibility to ensure that if a finish coat is being applied over VP shop coat that the painting contractor verifies compatibility between his finish coat and VP's shop coat.

VP BUILDINGS ACCREDITATIONS AND APPROVALS

Fabricator Approvals

IAS AC472 Approvals: ([www.iasonline.org/services/metal-building-inspection](http://www.iasonline.org/services/metal-building-inspection))  
Listed under BlueScope Buildings North America, Inc.  
City of Los Angeles, CA #FB00031; City of Houston, TX 767 & 429;  
City of Phoenix, AZ C19-02008; Clark County, NV 43 & 833, San Bernardino County, CA 289  
State of Utah, City of Richmond, CA.

Design Approvals

IAS AC472 Approvals: ([www.iasonline.org/services/metal-building-inspection](http://www.iasonline.org/services/metal-building-inspection))  
Listed under Varco Pruden Buildings, a Division of BlueScope Buildings North America, Inc.

Canadian CSA A660 Certifications

([www.cwbggroup.org](http://www.cwbggroup.org))  
Listed under BlueScope Buildings North America, Inc.

Engineering Certifications of Authorization

USA--AR#576; FL#30427; ID#C-2470; IL#184-002649; KS#E-29; MS#E-0592;  
MO#E-2010007736; NC#F-0998; OK#CA4170PE; SD#C-1787; TX#F4828; WV#C03059-00;  
CAN--AB#P08900; NS#30123; ON#100148796; and YT#PP134

ICC Evaluation Reports ([www.icc-es.org](http://www.icc-es.org))

SSR Roof System - #ESR-2527

State of Florida Product Approvals ([www.floridabuilding.org](http://www.floridabuilding.org))

Approved Products Listed Under VP Buildings, Inc.  
VP TextureClad - See Transamerican Structuroc, Inc.

Dade Co. Product Approval ([www.miamidade.gov/buildingcode](http://www.miamidade.gov/buildingcode))


Approved Products Listed Under Varco Pruden Buildings, Inc.  
VP TextureClad - See Transamerican Structuroc, Inc.

Underwriter's Laboratory Approvals (Available only when specified in contract)

SSR Roof-UL#TGKX-113; SSR Composite Roof Class 90-UL#TGKX-113A;  
SSR Roof w/Super Block; Class 90-UL#TGKX-328;  
Panel Rib Roof UL Class 60-UL#TGKX-60; Panel Rib Roof UL Class 90-UL#TGKX-64;  
VP SLR II Roof Class 90-UL#TGKX-90, -180, -435, -435A, -176, -238, -238A, -238B

Factory Mutual Approved Assemblies (Available only when specified in contract)

SSR Roof Systems are approved in various type applications and listed in FM Approval Guide.  
24 Ga SSR (0.0227" Nominal), is available in Class 1-60, 1-75, 1-90. 22Ga SSR (0.0277" Nominal), is available in Class 1-75, 1-90-, 1-120.  
SLR II Roof Systems are approved in various type applications and listed in FM Approval Guide.  
24 Ga SLR II (0.0227" Nominal), is available in Class 1-75 and 1-120.

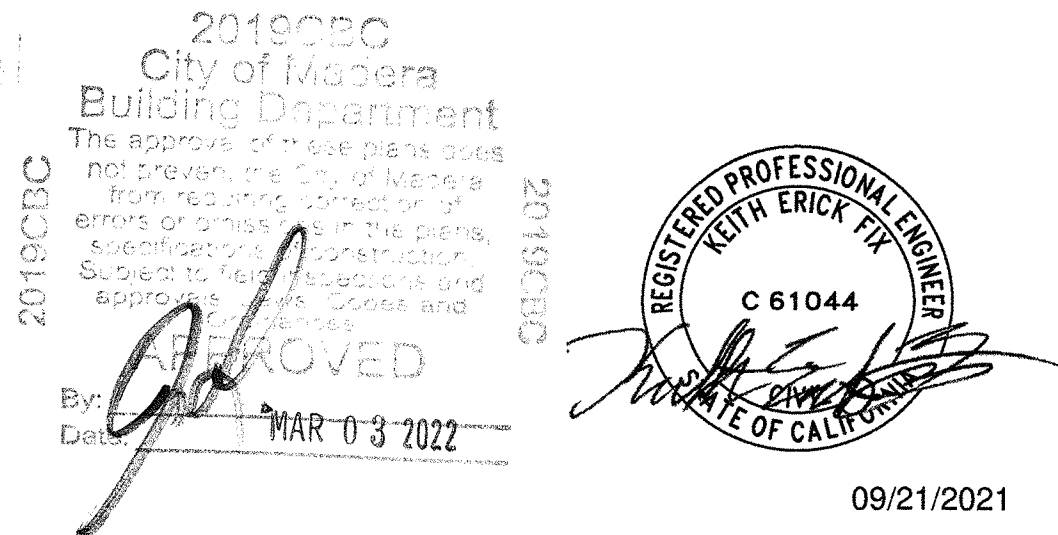


FOR CONSTRUCTION

09/21/2021

	THE VP ENGINEER'S SEAL APPLIES ONLY TO THE WORK PRODUCT OF VP AND DESIGN AND PERFORMANCE REQUIREMENTS SPECIFIED BY VP. THE VP ENGINEER'S SEAL DOES NOT APPLY TO THE PERFORMANCE OR DESIGN OF ANY OTHER PRODUCT OR COMPONENT FURNISHED BY VP EXCEPT TO ANY DESIGN OR PERFORMANCE REQUIREMENTS SPECIFIED BY VP.	THIS DRAWING, INCLUDING THE INFORMATION HEREON, REMAINS THE PROPERTY OF VP BUILDINGS. IT IS PROVIDED SOLELY FOR ERECTING THE BUILDING DESCRIBED IN THE APPLICABLE PURCHASE ORDER AND MAY BE REPRODUCED ONLY FOR THAT PURPOSE. IT SHALL NOT BE MODIFIED, REPRODUCED OR USED FOR ANY OTHER PURPOSE WITHOUT PRIOR WRITTEN APPROVAL OF VP BUILDINGS.  THE GENERAL CONTRACTOR AND/OR ERECTOR IS SOLELY RESPONSIBLE FOR ACCURATE GOOD QUALITY WORKMANSHIP IN ERECTING THIS BUILDING IN ACCORDANCE WITH THIS DRAWING, DETAILS REFERENCED IN THIS DRAWING, ALL APPLICABLE VP BUILDINGS ERECTION GUIDES, AND INDUSTRY STANDARDS PERTAINING TO PROPER ERECTION, INCLUDING THE CORRECT USE OF TEMPORARY BRACING.	<div>D</div> <div>VP Buildings</div> <div>3200 Players Club Circle Memphis TN 38125</div>	ERECTION NOTES				<div><div><div><div>VP BUILDINGS</div><div>VARCO PRUDEN</div><div>A BlueScope Steel Company</div><div>VP VERSION: 2021.2</div></div><div><div>JOBN0</div><div>21-008734-01</div><div>DATE</div><div>7/8/2021</div><div>DRAWN/CHECK</div><div>KJJ</div><div>PAGE</div><div>3</div></div></div><div>a division of BlueScope Buildings North America, Inc.</div></div>		
				REV	DATE	BY	DESCRIPTION		BUILDER	DBKO Design + Build
									CUSTOMER	Madera WH Building A
									LOCATION	Madera, California
									PROJECT	MT 1 Building A
									BUILDERS POW	
				NTS					FILENAME:	MT 1
				7/8/2021					19:29:04	



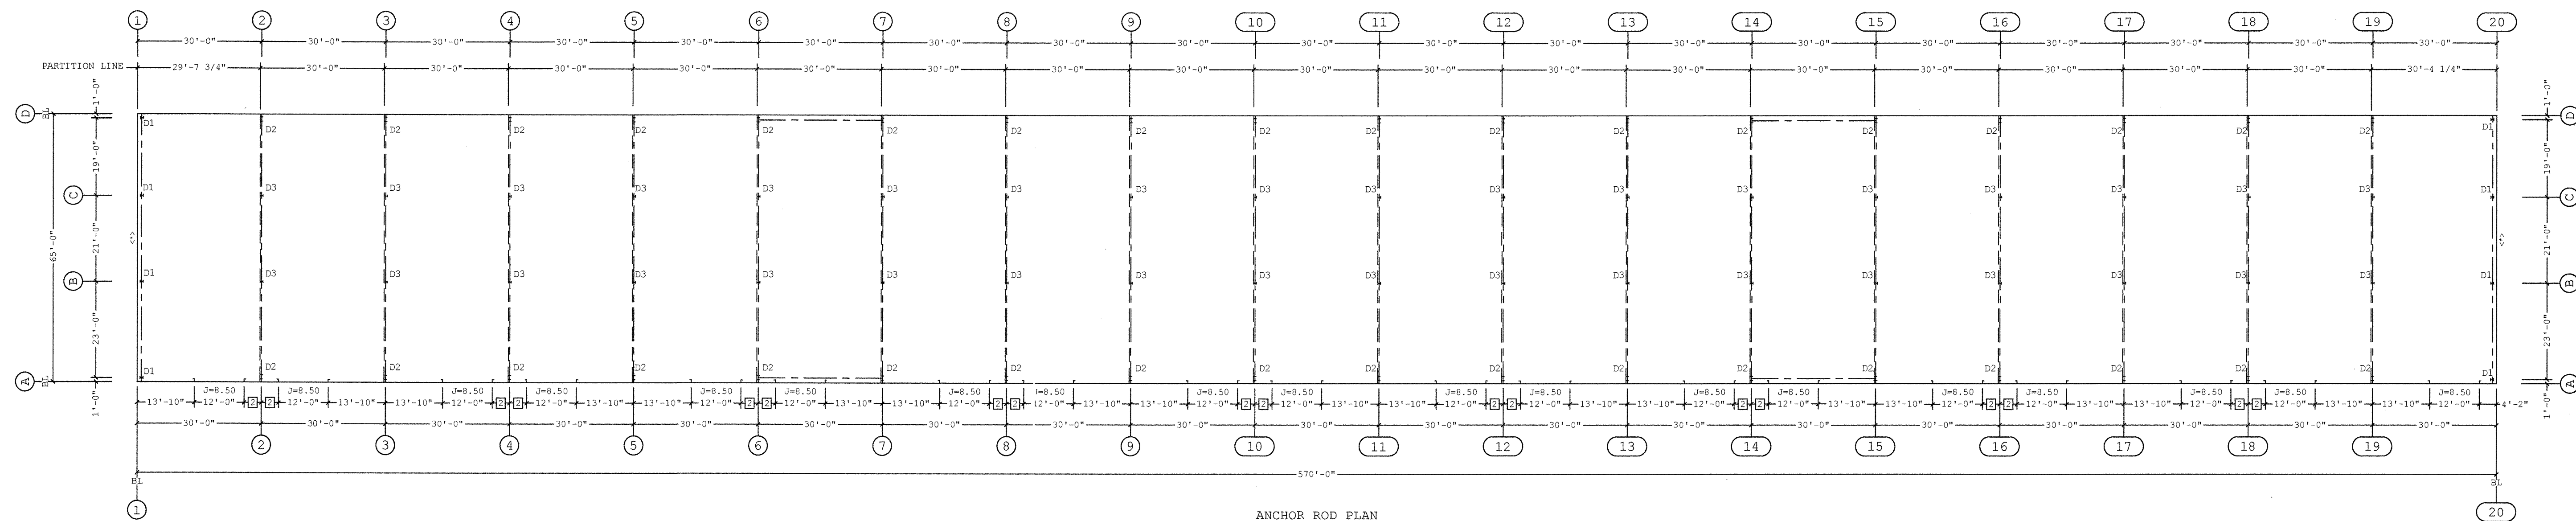

2 4'-2"  
Dimension Key

Finished Floor Elevation = 100'-0" (Unless Noted Otherwise)

<=> THE BUILDING IS DESIGNED WITH BRACING DIAGONALS IN THE DESIGNATED BAYS. COLUMN BASE REACTIONS, BASE PLATES AND ANCHOR RODS ARE AFFECTED BY THIS BRACING AND DIAGONALS MAY NOT BE RELOCATED WITHOUT CONSULTING THE BUILDING SUPPLIERS ENGINEER.

THE VP ENGINEER'S SEAL APPLIES ONLY TO THE WORK PRODUCT OF VP AND DESIGN AND PERFORMANCE REQUIREMENTS SPECIFIED BY VP. THE VP ENGINEER'S SEAL DOES NOT APPLY TO THE PERFORMANCE OR DESIGN OF ANY OTHER PRODUCT OR COMPONENT FURNISHED BY VP EXCEPT TO ANY DESIGN OR PERFORMANCE REQUIREMENTS SPECIFIED BY VP.


THIS DRAWING, INCLUDING THE INFORMATION HEREON, REMAINS THE PROPERTY OF VP BUILDINGS. IT IS PROVIDED SOLELY FOR ERECTING THE BUILDING DESCRIBED IN THE APPLICABLE PURCHASE ORDER AND MAY BE REPRODUCED ONLY FOR THAT PURPOSE. IT SHALL NOT BE MODIFIED, REPRODUCED OR USED FOR ANY OTHER PURPOSE WITHOUT PRIOR WRITTEN APPROVAL OF VP BUILDINGS.

THE GENERAL CONTRACTOR AND/OR ERECTOR IS SOLELY RESPONSIBLE FOR ACCURATE GOOD QUALITY WORKMANSHIP IN ERECTING THIS BUILDING IN ACCORDANCE WITH THIS DRAWING, DETAILS REFERENCED IN THIS DRAWING, ALL APPLICABLE VP BUILDINGS ERECTION GUIDES, AND INDUSTRY STANDARDS PERTAINING TO PROPER ERECTION, INCLUDING THE CORRECT USE OF TEMPORARY BRACING.

VP Buildings		
3200 Players Club Circle Memphis TN 38125		
REV	DATE	DESCRIPTION
NTS		

### ANCHOR ROD PLAN

BUILDER	DBKO Design + Build
CUSTOMER	Madera VWH Building A
LOCATION	Madera, California
PROJECT	MT 1 Building A
BUILDERS PO#	

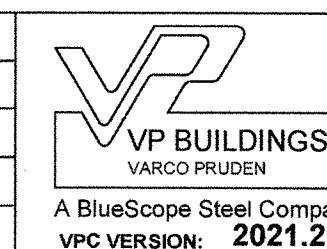

JOBNO	21-008734-01
DATE	7/8/2021
DRAWN/CHECK	KJJ
PAGE	4


2019CDC  
City of Madera  
Building Department  
The approval of these plans does not prevent the City of Madera from requiring correction of errors or omission in the plans, specifications or construction. Subject to field inspections and approvals of the City Engineer.  
APPROVED  
By: [Signature]  
Date: MAR 03 2022




FOR CONSTRUCTION

09/21/2021




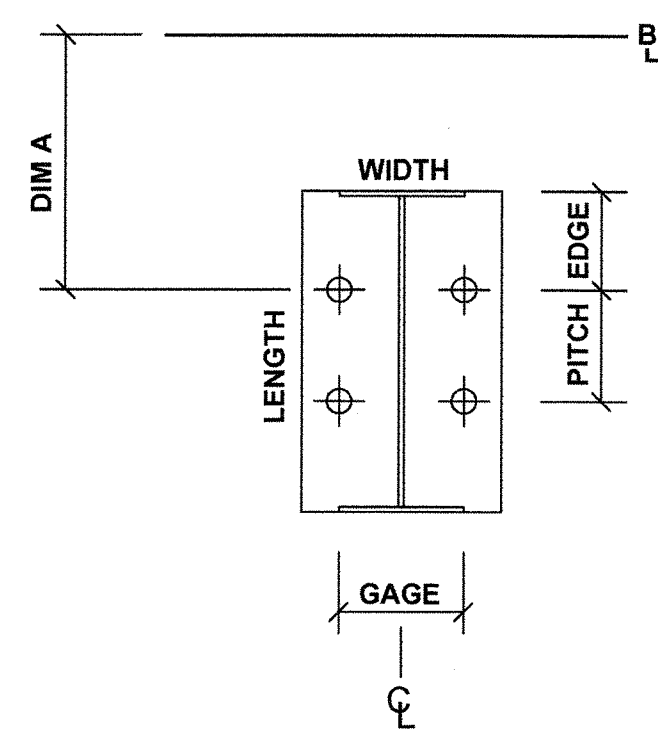


D1 (4)3/4" Dia. GR36 Anchor Rods  
Plate W=8" L=8 1/2"  
Dim: A=10 1/4"  
Gage=5" Pitch=5" Edge Out=1 3/4"  
Elev.=100'-0"

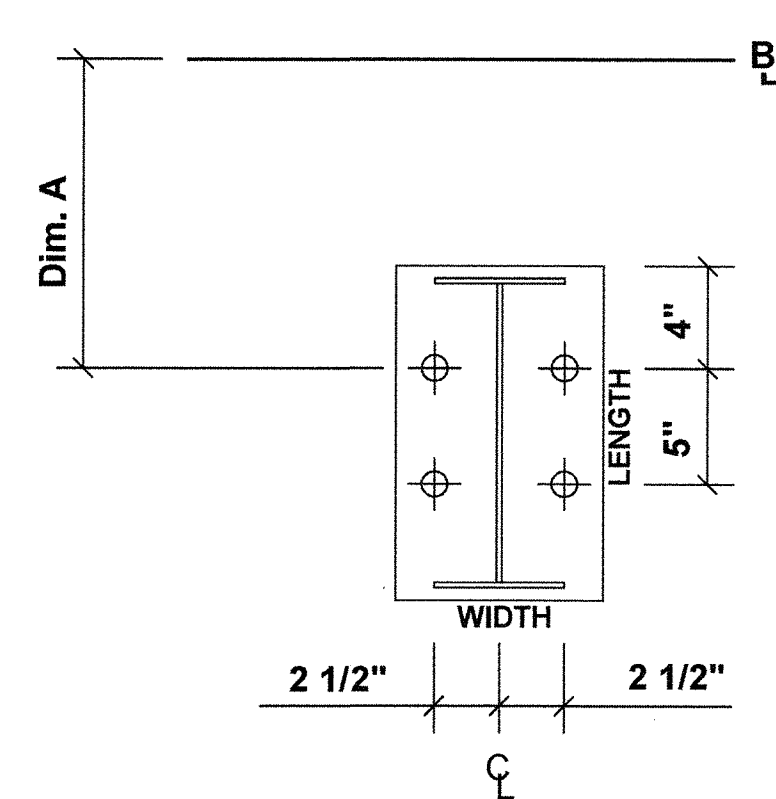

D2 (4)3/4" Dia. GR36 Anchor Rods  
Plate W=8" L=1'-1"  
Dim: A=1'-0"  
Elev.=100'-0"

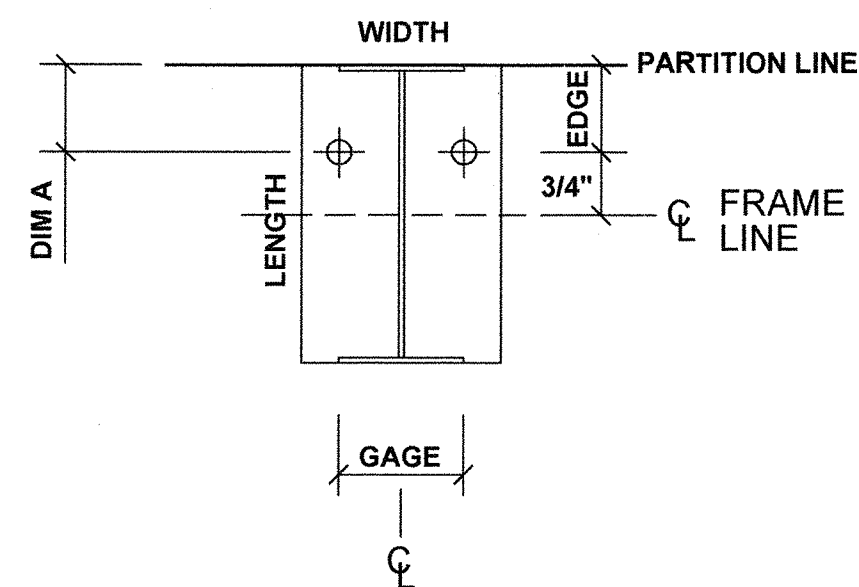


D3 (2)3/4" Dia. GR36 Anchor Rods  
Plate W=8" L=8 1/2"  
Dim: A=3 1/2"  
Gage=5" Edge Out=3 1/2"  
Elev.=100'-0"

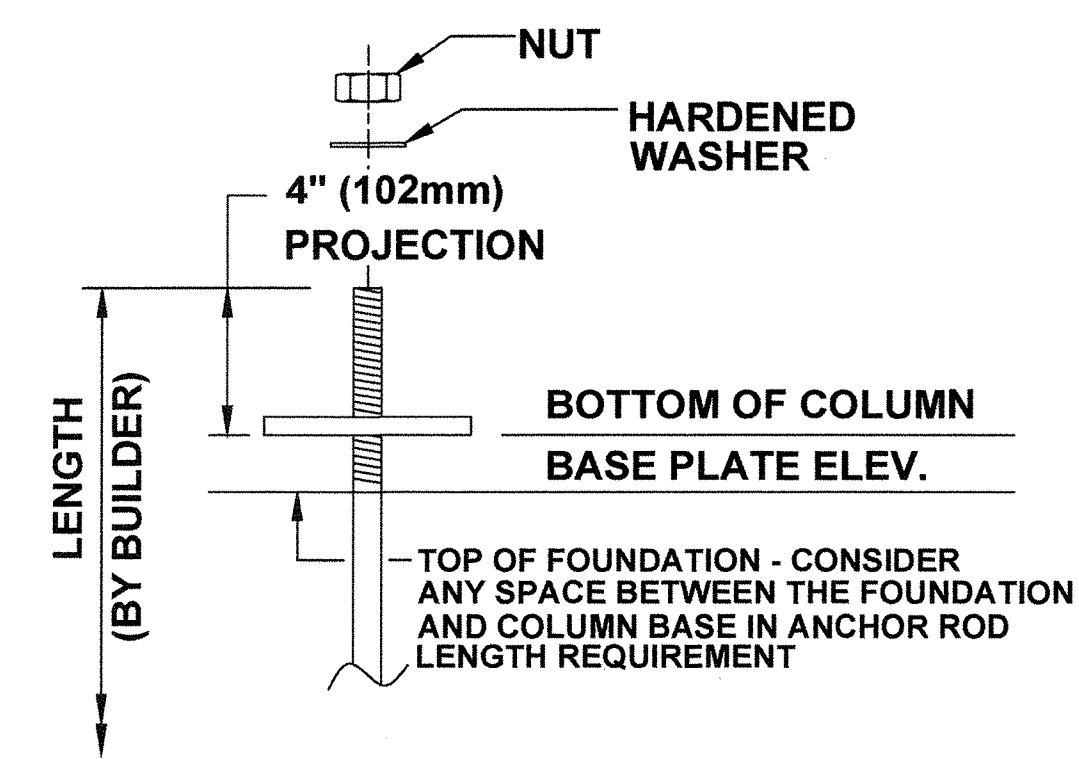

THE 4" PROJECTION ABOVE THE BOTTOM OF THE BASE PLATE IS A SUGGESTED MINIMUM TO ENSURE ADEQUATE ANCHOR ROD LENGTH. A DIFFERENT PROJECTION MAY BE REQUIRED BY THE FOUNDATION DESIGNER.

THE ANCHOR ROD PROJECTION MAY NEED TO BE CUT OFF IF THERE IS INTERFERENCE WITH OTHER PARTS.

### SUGGESTED ANCHOR ROD PROJECTION

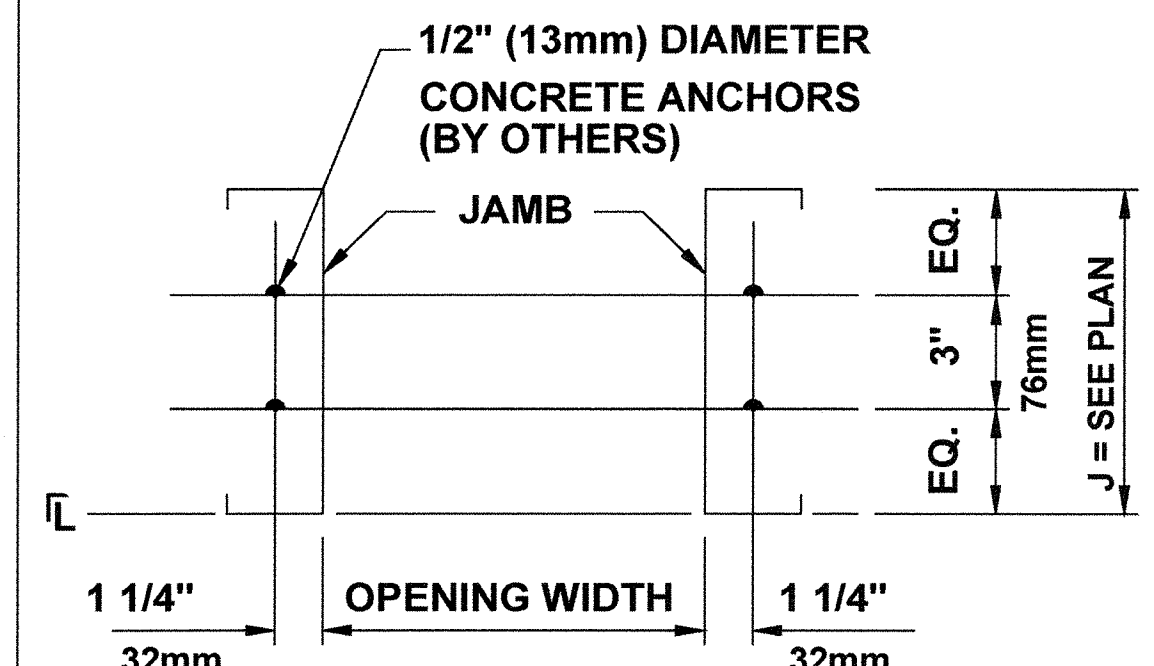

**NOTE: 1" (25mm) PROJECTION ABOVE**


**BOTTOM OF JAMB CLIP**  
SEE PLAN FOR JAMB SIZES : J = SIZE

**JAMB 'EQ.' VALUES:**

7 EQ = 2" 51mm, 8.5 EQ = 2 3/4" 70mm

10 EQ = 3 1/2" 89mm, 11.5 EQ = 4 1/4" 108mm

## FRAMED OPENING DETAIL

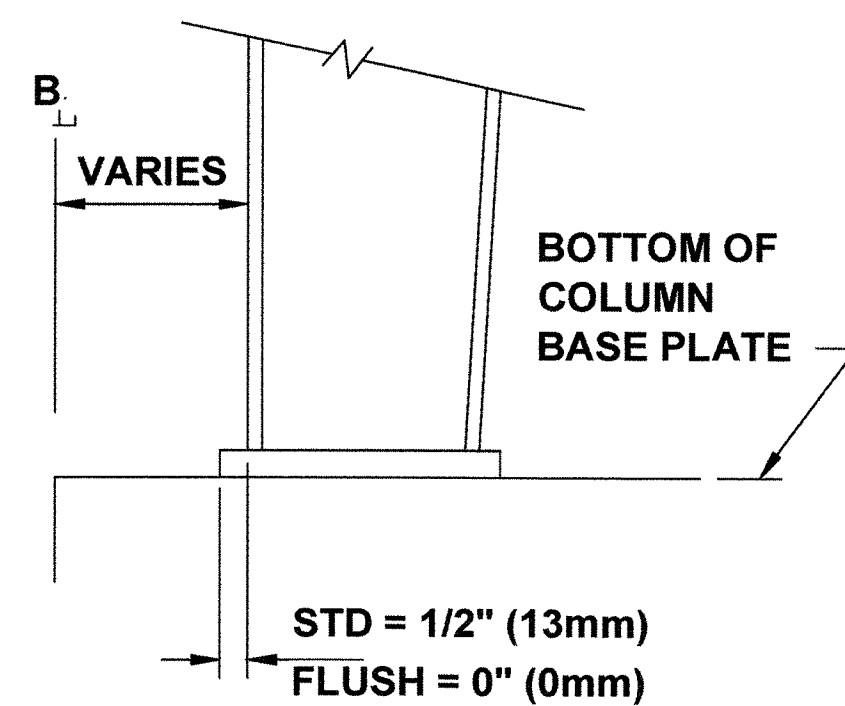

### TYPICAL COLUMN BASE PLATE DETAIL

1. ANCHOR RODS, NUTS, HARDENED WASHERS AND ANY OTHER EMBEDDED ITEMS ARE TO BE FURNISHED BY CONTRACTOR.
2. ANCHOR ROD DIAMETERS WERE DETERMINED BY ALLOWABLE SHEAR AND TENSION PER AISC SPECIFICATIONS (FY=36KSI). (ASTM F1554 Grade 36) ANCHOR ROD LENGTH, EFFECTS OF EMBEDDED ANCHOR ROD EDGE DIMENSIONS AND METHOD OF TRANSFERRING FORCES FROM ANCHOR RODS TO FOOTINGS ARE TO BE DETERMINED BY OTHERS.
3. UNLESS OTHERWISE SPECIFIED, ANCHOR RODS ARE DESIGNED AND DETAILED AS "CAST-IN-PLACE" ANCHOR RODS WITH "SNUG TIGHT" CONNECTIONS.
4. FOUNDATION MUST BE LEVEL, SQUARE AND SMOOTH. ANCHOR RODS MUST BE ACCURATELY PLACED AS SHOWN ON THIS DRAWING OR STEEL WILL NOT FIT. THE BUILDER IS RESPONSIBLE FOR ACCURATE SETTING OF ANCHOR RODS PER AISC CODE OF STANDARD PRACTICE, SEC 7.5 VARIATIONS ARE SUMMARIZED BELOW;
  - a. CENTERS OF ANY TWO AR'S WITHIN A COLUMN BASE GROUP;  $\pm 1/8"$
  - b. CENTERS OF ADJACENT AR GROUPS;  $\pm 1/4"$
  - c. TOPS OF AR'S;  $\pm 1/2"$
5. ACCUMULATED DIM BETWEEN CENTERS OF AR GROUPS ALONG COLUMN LINE;  $\pm 1/4"$  PER 100FT., NOT TO EXCEED 1" TOTAL.
6. DIM FROM CENTER OF ANY AR GROUP FROM COLUMN LINE;  $\pm 1/4"$
5. DESIGN LOADS AND REACTIONS ARE FURNISHED IN THE REACTIONS REPORT.

**Finished Floor Elevation = 100'-0" (Unless Noted Otherwise)**

<> THE BUILDING IS DESIGNED WITH BRACING DIAGONALS IN THE DESIGNATED BAYS. COLUMN BASE REACTIONS, BASE PLATES AND ANCHOR RODS ARE AFFECTED BY THIS BRACING AND DIAGONALS MAY NOT BE RELOCATED WITHOUT CONSULTING THE BUILDING SUPPLIERS ENGINEER.

THE VP ENGINEER'S SEAL APPLIES ONLY TO THE WORK PRODUCT OF VP AND DESIGN AND PERFORMANCE REQUIREMENTS SPECIFIED BY VP. THE VP ENGINEER'S SEAL DOES NOT APPLY TO THE PERFORMANCE OR DESIGN OF ANY OTHER PRODUCT OR COMPONENT FURNISHED BY VP EXCEPT TO ANY DESIGN OR PERFORMANCE REQUIREMENTS SPECIFIED BY VP.

THIS DRAWING, INCLUDING THE INFORMATION HEREON, REMAINS THE PROPERTY OF VP BUILDINGS. IT IS PROVIDED SOLELY FOR ERECTING THE BUILDING DESCRIBED IN THE APPLICABLE PURCHASE ORDER AND MAY BE REPRODUCED ONLY FOR THAT PURPOSE. IT SHALL NOT BE MODIFIED, REPRODUCED OR USED FOR ANY OTHER PURPOSE WITHOUT PRIOR WRITTEN APPROVAL OF VP BUILDINGS.

THE GENERAL CONTRACTOR AND/OR ERECTOR IS SOLELY RESPONSIBLE FOR ACCURATE GOOD QUALITY WORKMANSHIP IN ERECTING THIS BUILDING IN ACCORDANCE WITH THIS DRAWING, DETAILS REFERENCED IN THIS DRAWING, ALL APPLICABLE VP BUILDINGS ERECTION GUIDES, AND INDUSTRY STANDARDS PERTAINING TO PROPER ERECTION, INCLUDING THE CORRECT USE OF TEMPORARY BRACING.

<b>D</b>	<b>VP Buildings</b>		
	<b>3200 Players Club Circle Memphis TN 38125</b>		
	<b>REV</b>	<b>DATE</b>	<b>BY</b>
<b>NTS</b>			

### ANCHOR ROD PLAN

20180303

City of Medford  
Building Department

The approval of these plans does not prevent the City of Medford from requiring correction of errors or omissions in the plans, specifications or instructions. Subject to these instructions and approval, the City of Medford

APPROVED

By: [Signature]  
Date: MAR 03 2022

20180303

**FOR CONSTRUCTION**

09/21/2021

**MODIFIED IN AUTOCAD**

FILENAME: C:\Users\krjones\OneDrive - BlueScope\Building Files\21-008734-01\MT 1\_ANCHOR ROD PLAN DETAILS.dwg

SAVE DATE: 7/9/2021

SAVE TIME: 14:17:52

LAST SAVED BY: krjones

a division of BlueScope Buildings North America, Inc.

DBNO  
-008734-01  
DATE 7/8/2021  
DRAWN/CHECK  
KJJ  
PAGE 5



